


0 8' 16' 32'
SCALE: 1/16" = 1'-0"

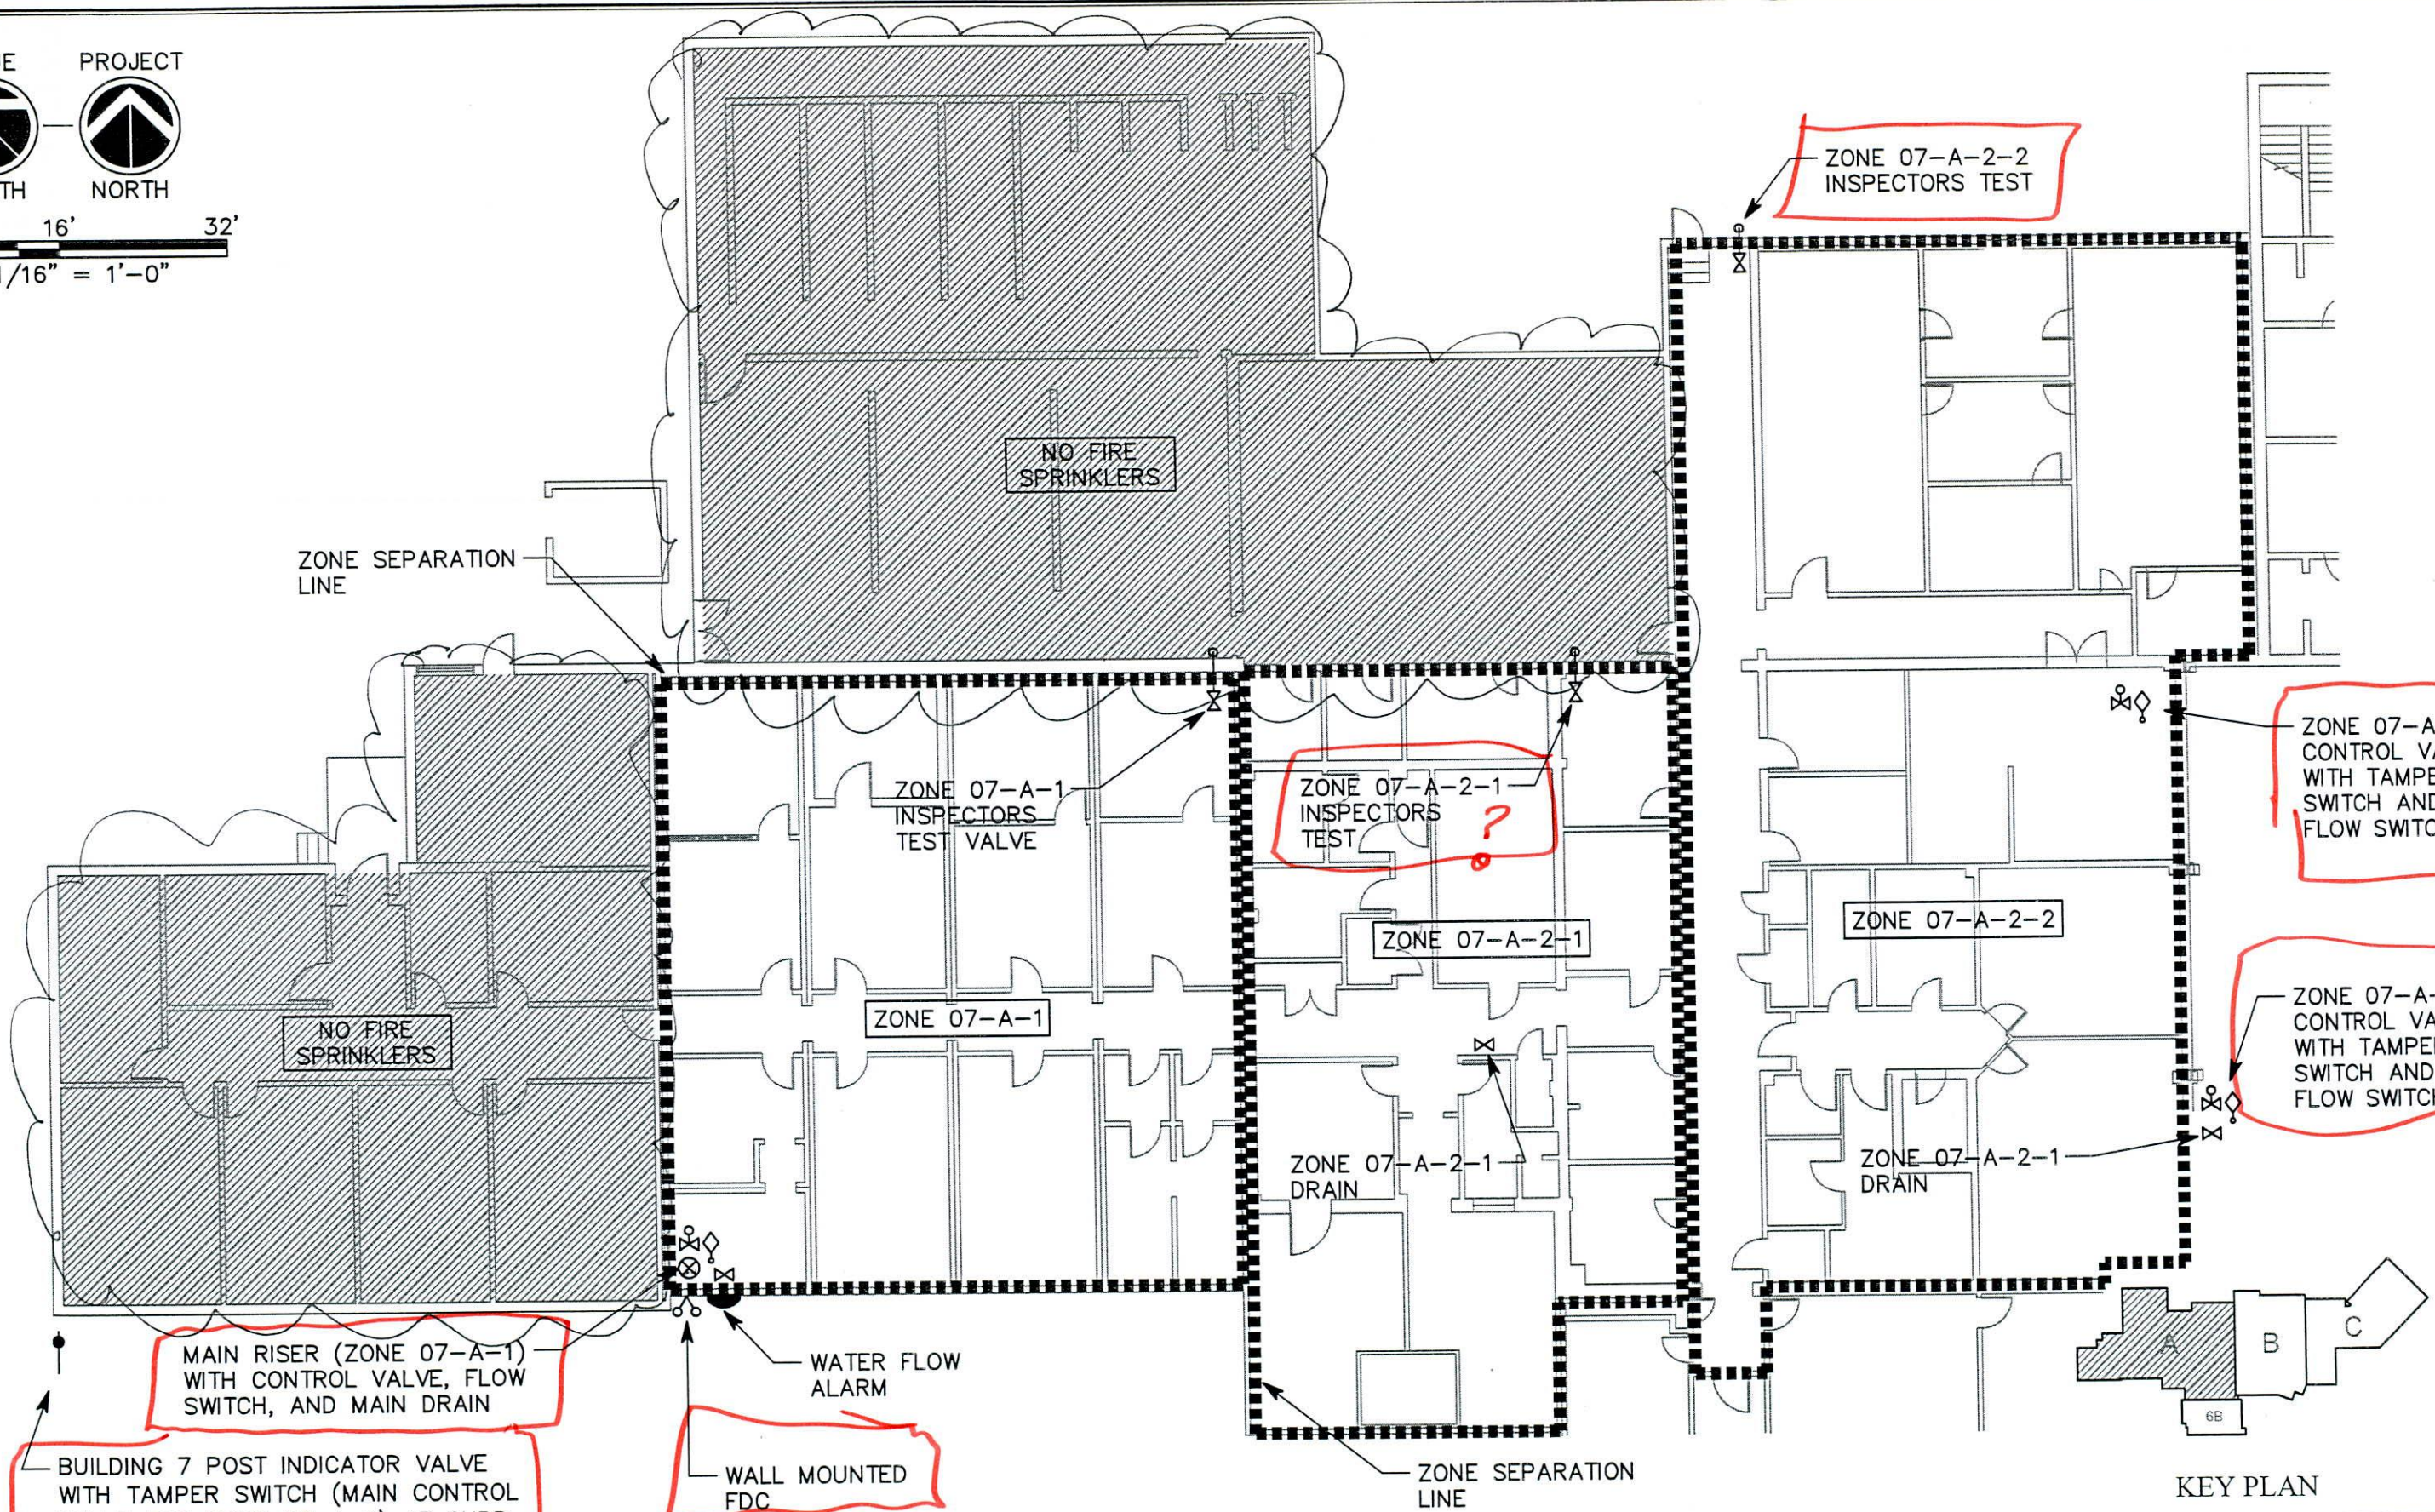

KEY PLAN

Revisions	Date

Consultant

SPECTRUM ENGINEERS
324 South State Street, Suite 400
Salt Lake City, Utah 84111
801.328.5151
800.678.7077
FAX 801.328.5155
www.spectrum-engineers.com

Project Title
CAMPUS WIDE FIRE SPRINKLING TEST STATION
MODIFICATION AND DEFICIENCIES STUDY
Consultant Project No. 20100195
Drawn BXW
Checked JDD

Drawing Title
BUILDING 7
FIRST LEVEL
ZONE A

Date 08.03.2010
Project No. 660-10-110
Building No. 7

Drawing No. F.07.1A
Dep. of XX


AS-BUILT RECORD DRAWINGS
Department of Veterans Affairs