
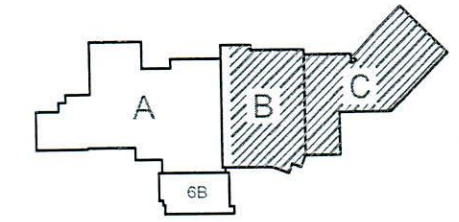
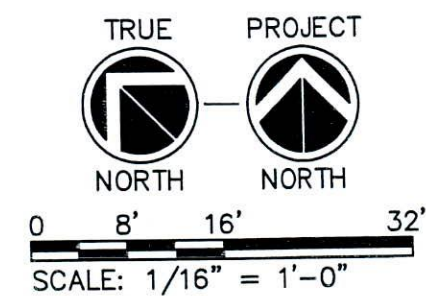


File Name: P:\2010\20100195\Drawings\Bldg 7\Sheet\95F.07.1C.dwg Last Plotted: 2010/11/01 12:21 PM By: jdd

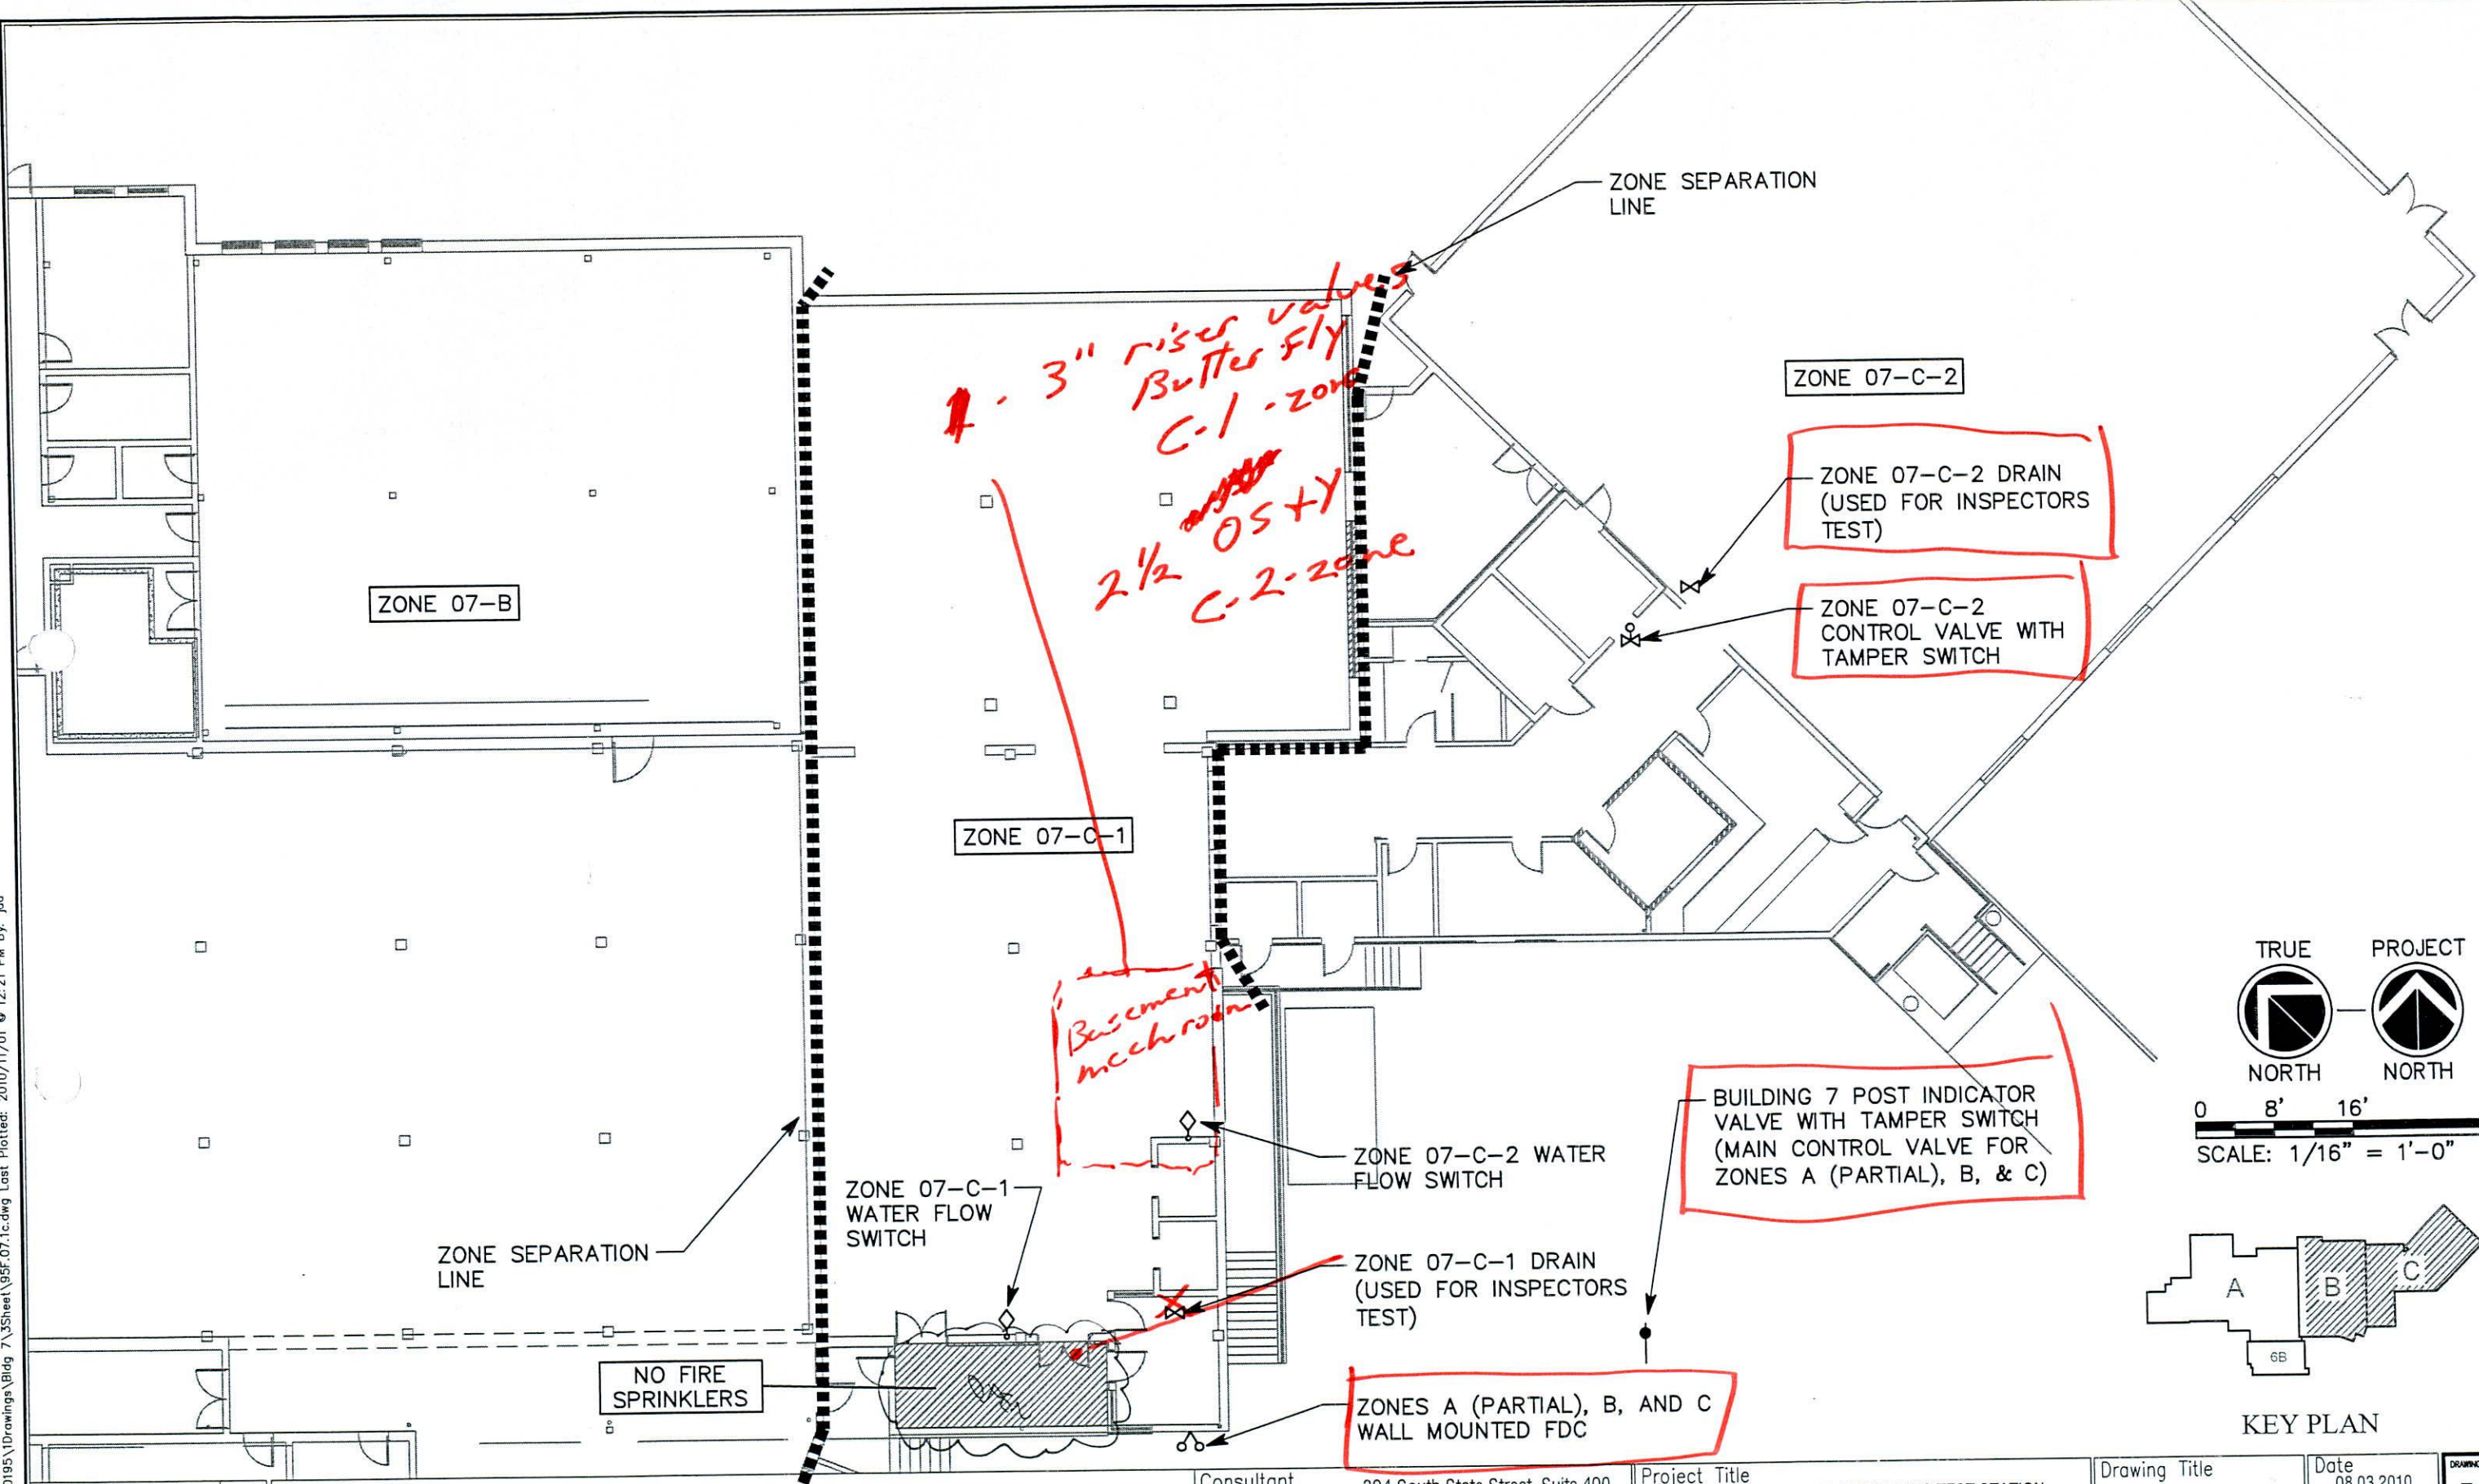

KEY PLAN

Revisions	Date

Consultant
**SPECTRUM ENGINEERS**
324 South State Street, Suite 400
Salt Lake City, Utah 84111
801.328.5151
800.678.7077
FAX 801.328.5155
www.spectrum-engineers.com

Project Title CAMPUS WIDE FIRE SPRINKLING TEST STATION MODIFICATION AND DEFICIENCIES STUDY	
Consultant Project No. 20100195	
Drawn BXW	Checked JDD

Drawing Title BUILDING 7 FIRST LEVEL ZONE C
--

Date 08.03.2010
Project No. 660-10-110
Building No. 7

DRAWING No.
F.07.1C
Dep. of XX
**VAMC**
TO QUALITY
Department of

AS-BUILT RECORD DRAWINGS