
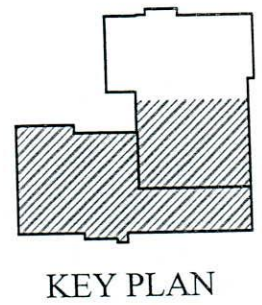
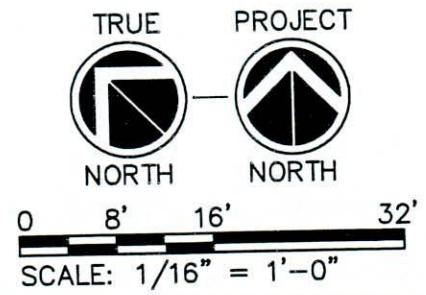


File Name: P:\2010\20100195\Drawings\Bldg 8\Sheet\95F.08.1b.dwg Last Plotted: 2010/11/01 @ 12:21 PM By: jdd

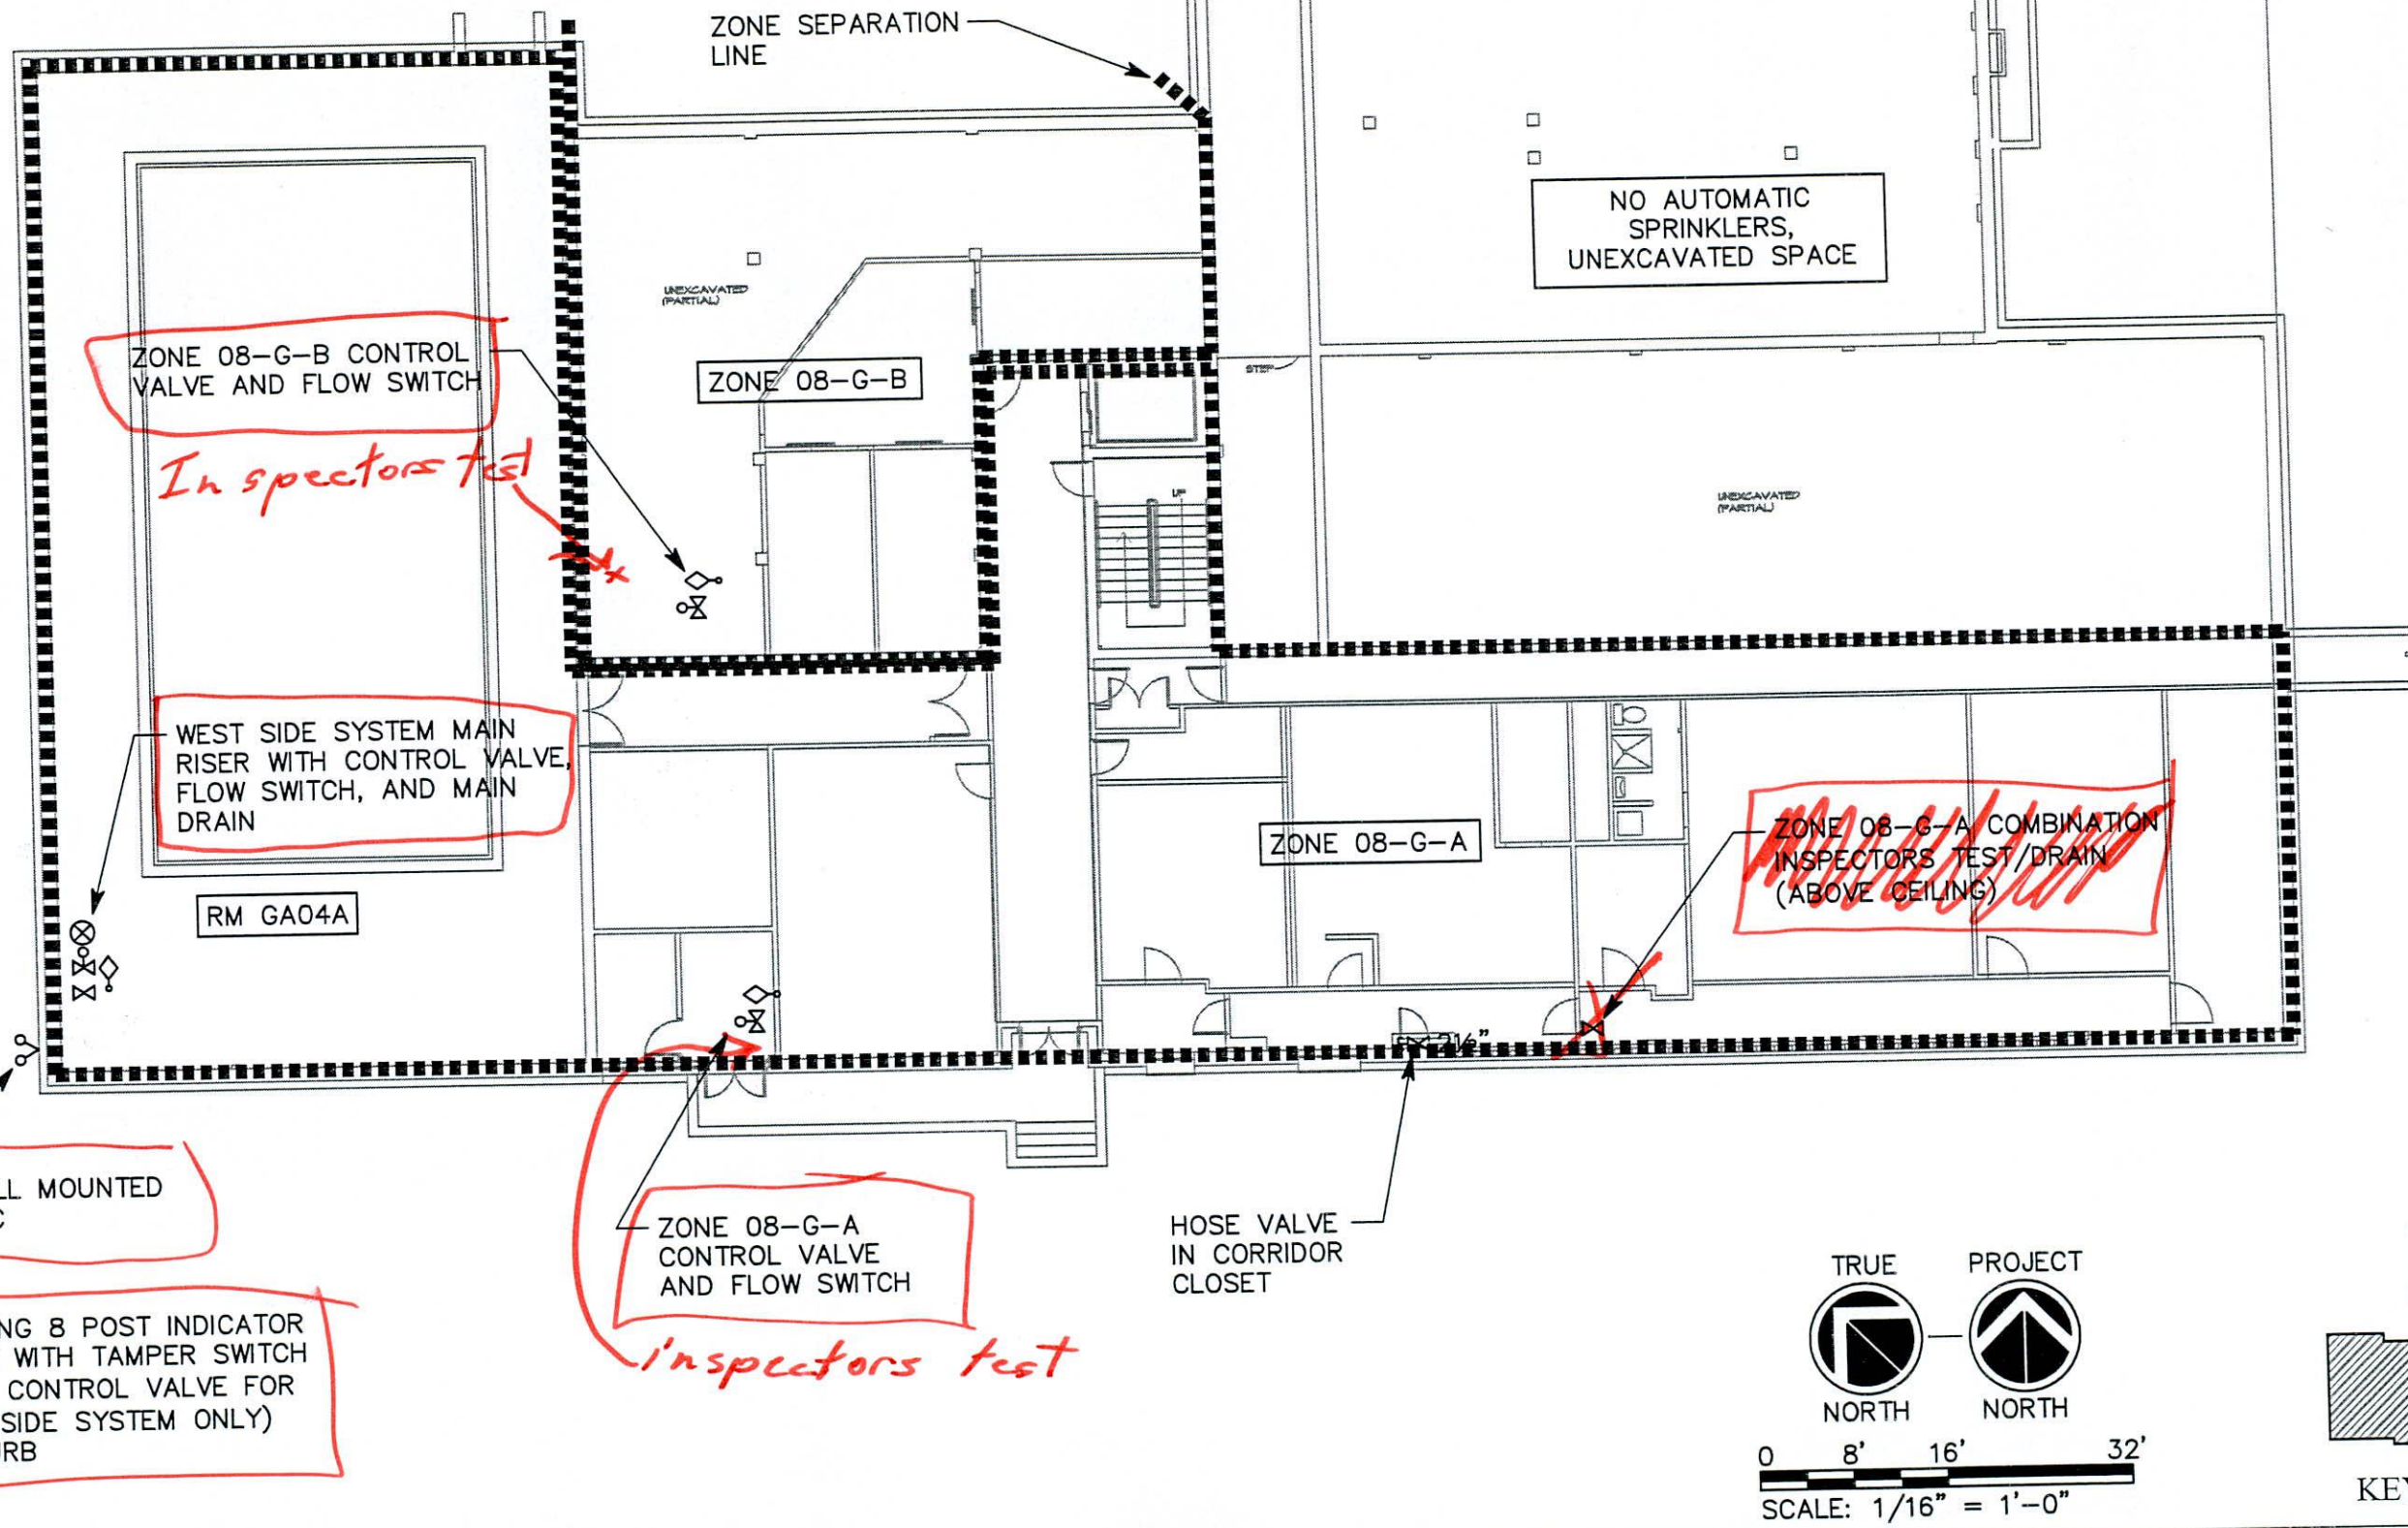

Revisions	Date

Consultant

SPECTRUM ENGINEERS
324 South State Street, Suite 400
Salt Lake City, Utah 84111
801.328.5151
800.678.7077
FAX 801.328.5155
www.spectrum-engineers.com

Project Title
CAMPUS WIDE FIRE SPRINKLING TEST STATION
MODIFICATION AND DEFICIENCIES STUDY
Consultant Project No. 20100195
Drawn BXW
Checked JDD

Drawing Title
BUILDING 8
GROUND LEVEL -
SOUTH

Date
08.03.2010
Project No.
660-10-110
Building No.
8

DRAWING No.
F.08.1B
Des. OF XX

Department of

AS-R111 T RECORD DRAWINGS