

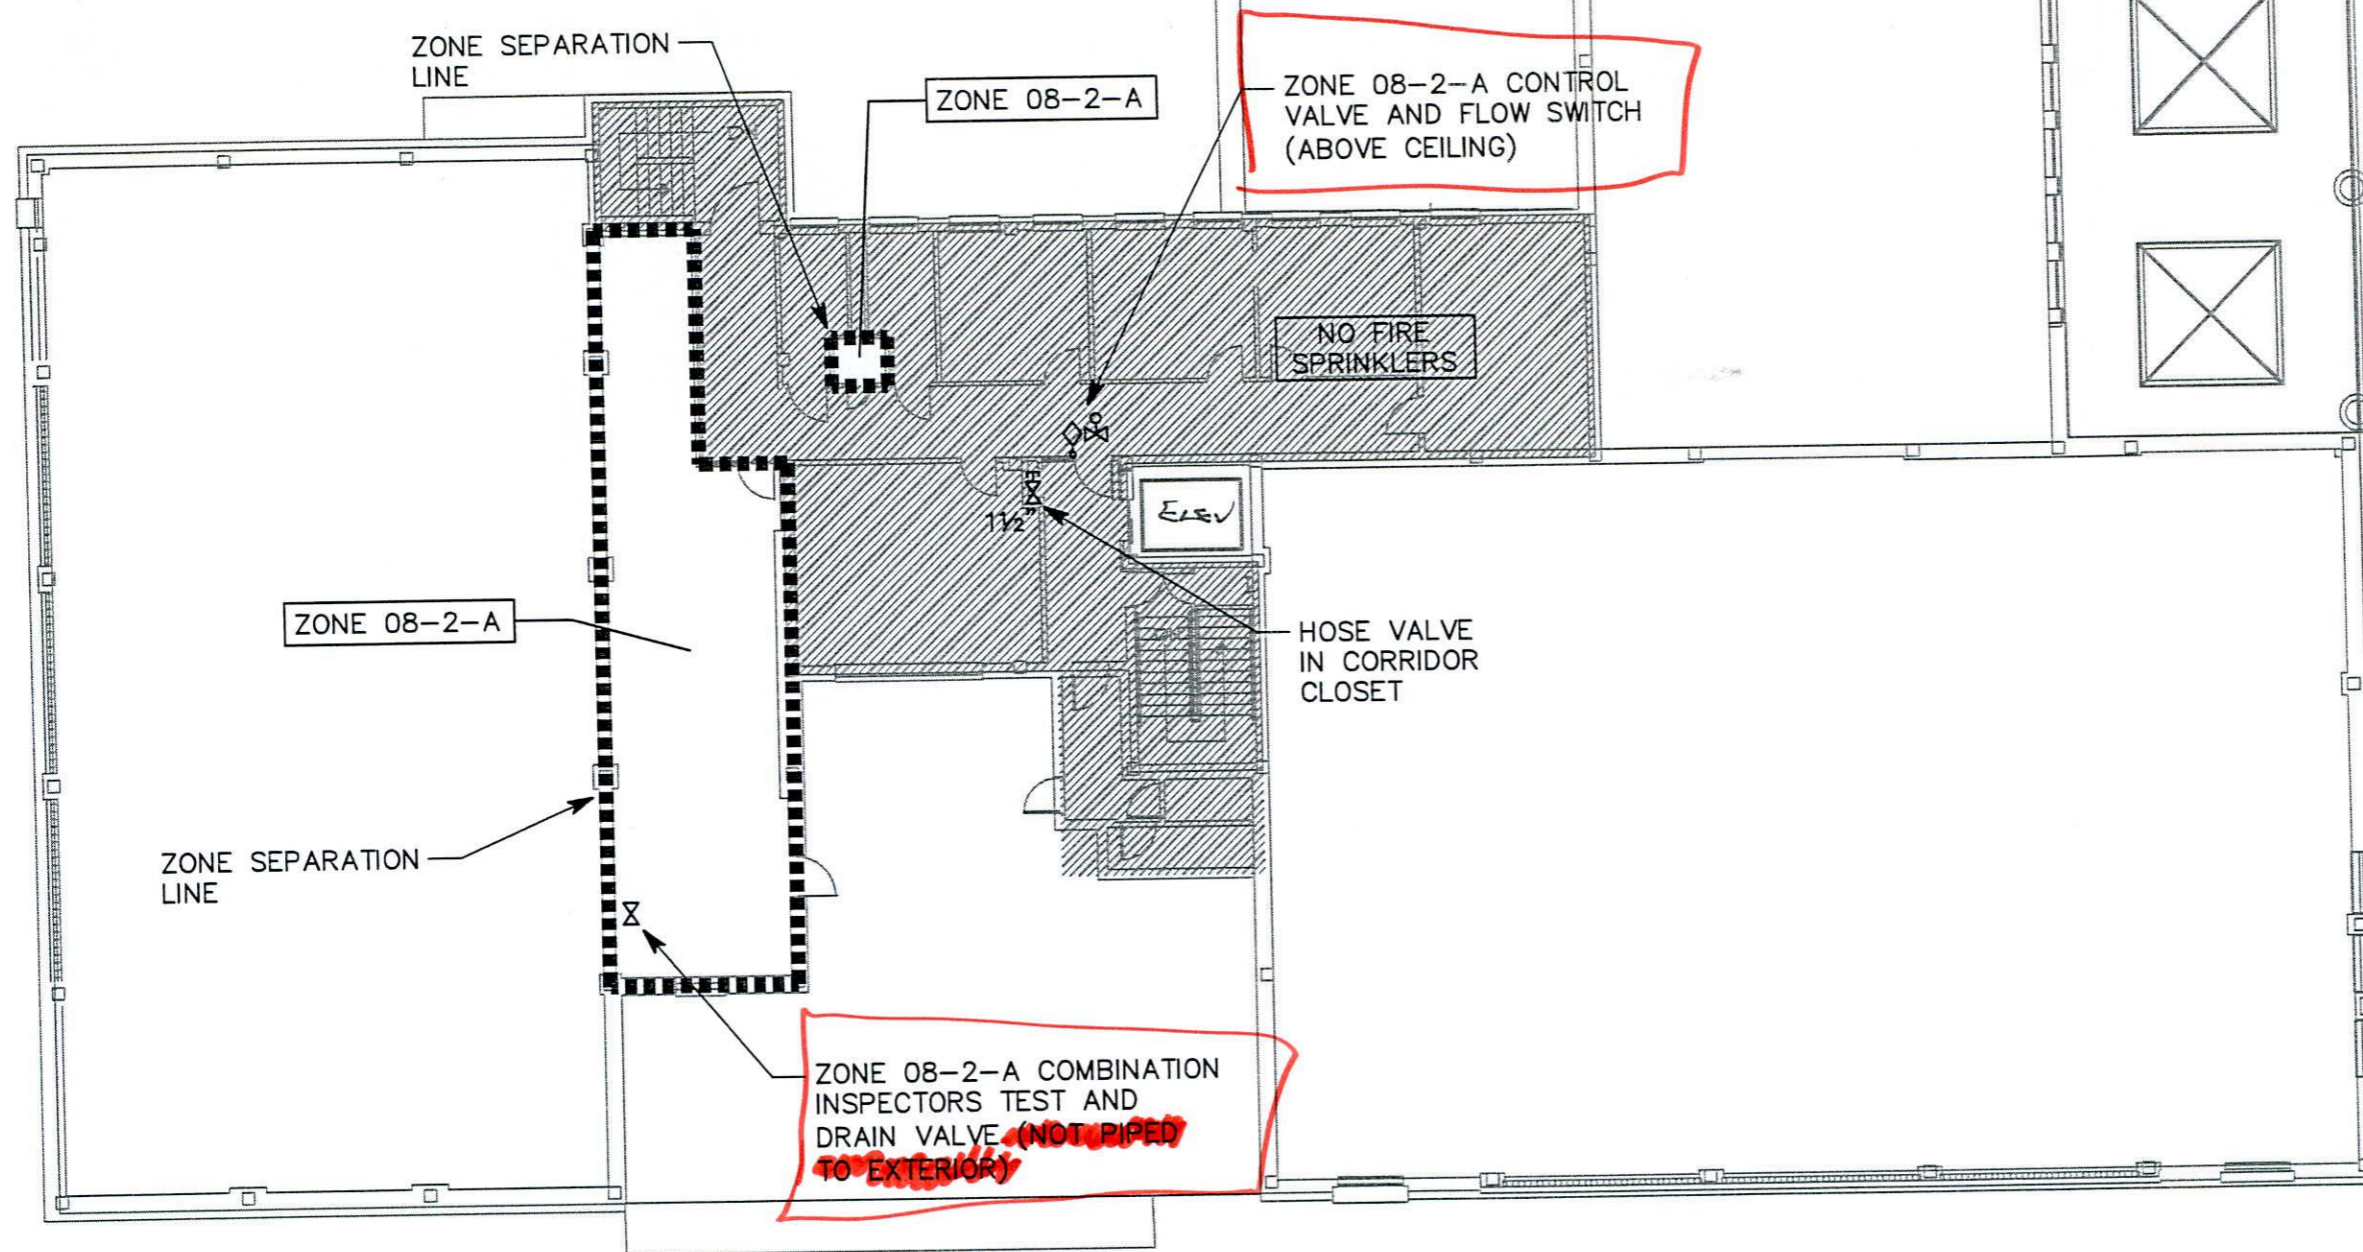


File Name: P:\2010\20100195\Drawings\Bldg 8\Sheet\95F.08.3b.dwg Last Plotted: 2010/11/01 12:21 PM By: jdd

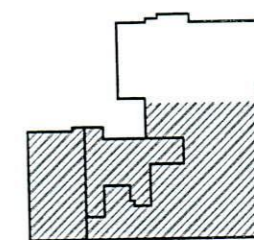

LEGEND	
	CONTROL VALVE
	FLOW SWITCH
	IT AND/OR DRAIN VALVE
	HOSE VALVE
	IT AND/OR DRAIN OUTLET
	POST INDICATOR VALVE

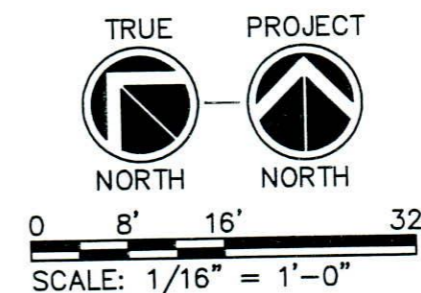

KEY PLAN

Revisions	Date



Consultant
324 South State Street, Suite 400
Salt Lake City, Utah 84111
801.328.5151
800.678.7077
FAX 801.328.5155
www.spectrum-engineers.com

Project Title CAMPUS WIDE FIRE SPRINKLING TEST STATION MODIFICATION AND DEFICIENCIES STUDY	
Consultant Project No. 20100195	
Drawn BXW	Checked JDD

Drawing Title
BUILDING 8
SECOND LEVEL

Date
08.03.2010
Project No.
660-10-110
Building No.
8

Drawing No.
F.08.3A
Dep. of XX

AS-BUILT RECORD DRAWINGS

Department of