


File Name: P:\2010\20100195\Drawings\Bldg 9\3Sheet\95F.09.1b.dwg Last Plotted: 2010/11/01 @ 12:21 PM By: jdd

~~ZONE B INSPECTORS TEST  
(VALVE BEHIND WALL, NOT  
PIPED TO EXTERIOR, NO  
ACCESS)~~

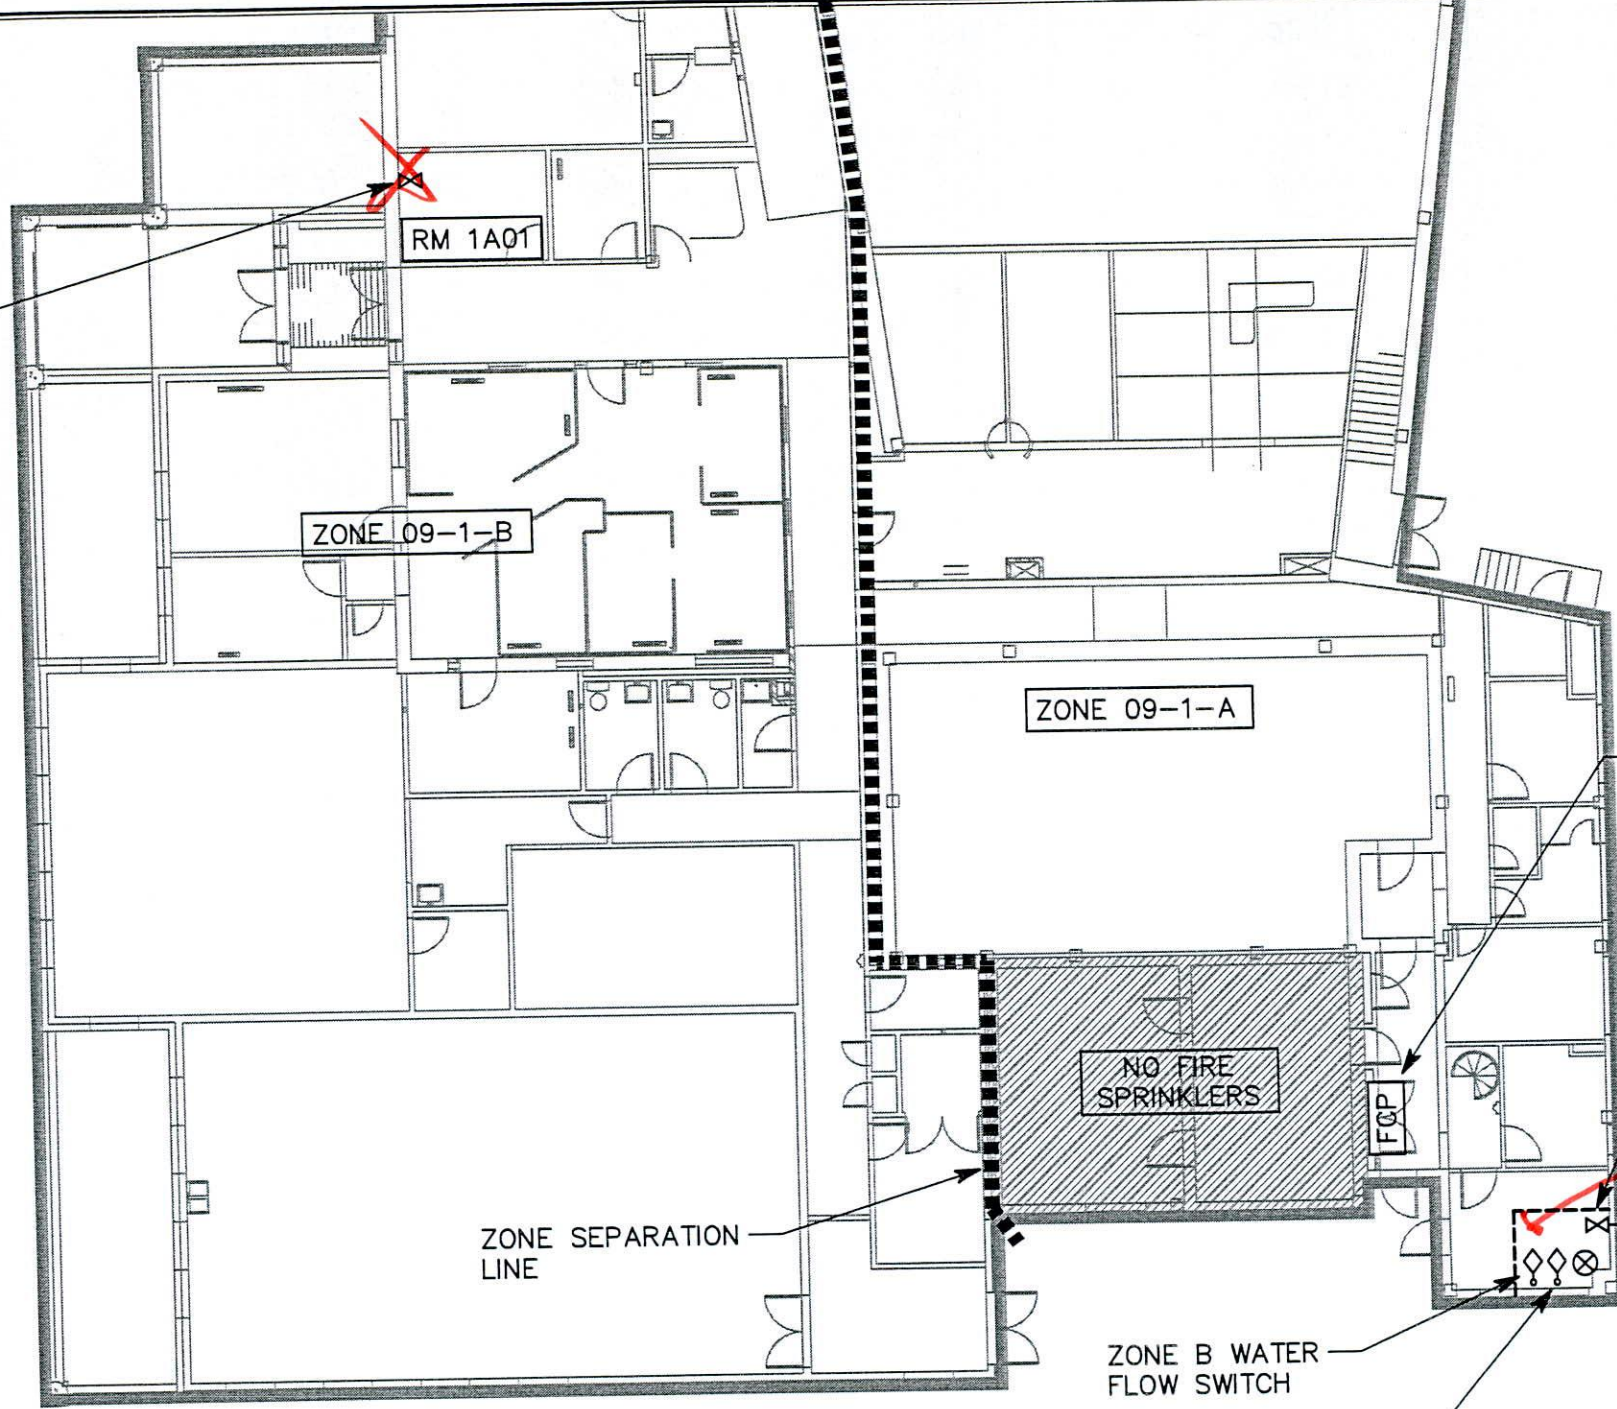

FIRE ALARM CONTROL  
PANEL IN CLOSET

MAIN RISER (IN CRAWL  
SPACE BELOW, DASHED  
LINE) WITH TWO FLOW  
SWITCHES

**ZONE B INSPECTORS TEST**


ZONE A INSPECTORS  
TEST (IN CRAWL  
SPACE, PIPED TO  
EXTERIOR)

WALL MOUNTED  
FDC


ZONE B WATER  
FLOW SWITCH

ZONE A WATER  
FLOW SWITCH

BUILDING 9 POST INDICATOR  
VALVE WITH TAMPER SWITCH  
(MAIN CONTROL VALVE)

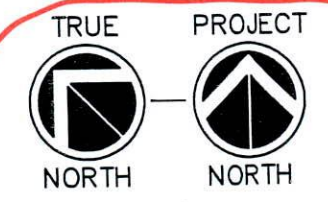

SCALE: 1/16" = 1'-0"

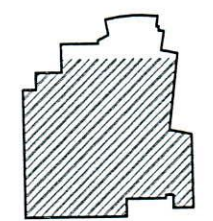

KEY PLAN


Revisions	Date

Consultant  
  
324 South State Street, Suite 400  
Salt Lake City, Utah 84111  
801.328.5151  
800.678.7077  
FAX 801.328.5155  
www.spectrum-engineers.com

Project Title  
CAMPUS WIDE FIRE SPRINKLING TEST STATION  
MODIFICATION AND DEFICIENCIES STUDY  
Consultant Project No. 20100195  
Drawn BXW Checked JDD

Drawing Title  
BUILDING 9  
GROUND LEVEL  
ZONE A &  
ZONE B - SOUTH

Date 08.03.2010  
Project No. 660-10-110  
Building No. 9

DRAWING No. F.09.1B  
Dep. of XX  
  
Department of

AS-BUILT RECORD DRAWINGS