
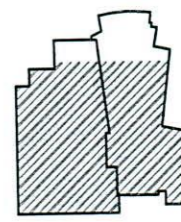
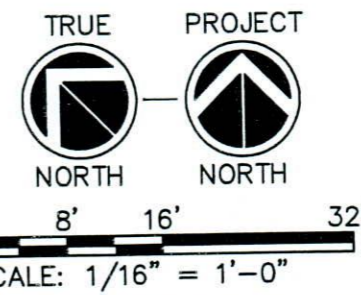


File Name: P:\2010\20100195\1Drawings\Bldg 9\3Sheet\95F.09.2b.dwg Lost Plotted: 2010/11/01 @ 12:21 PM By: jdd

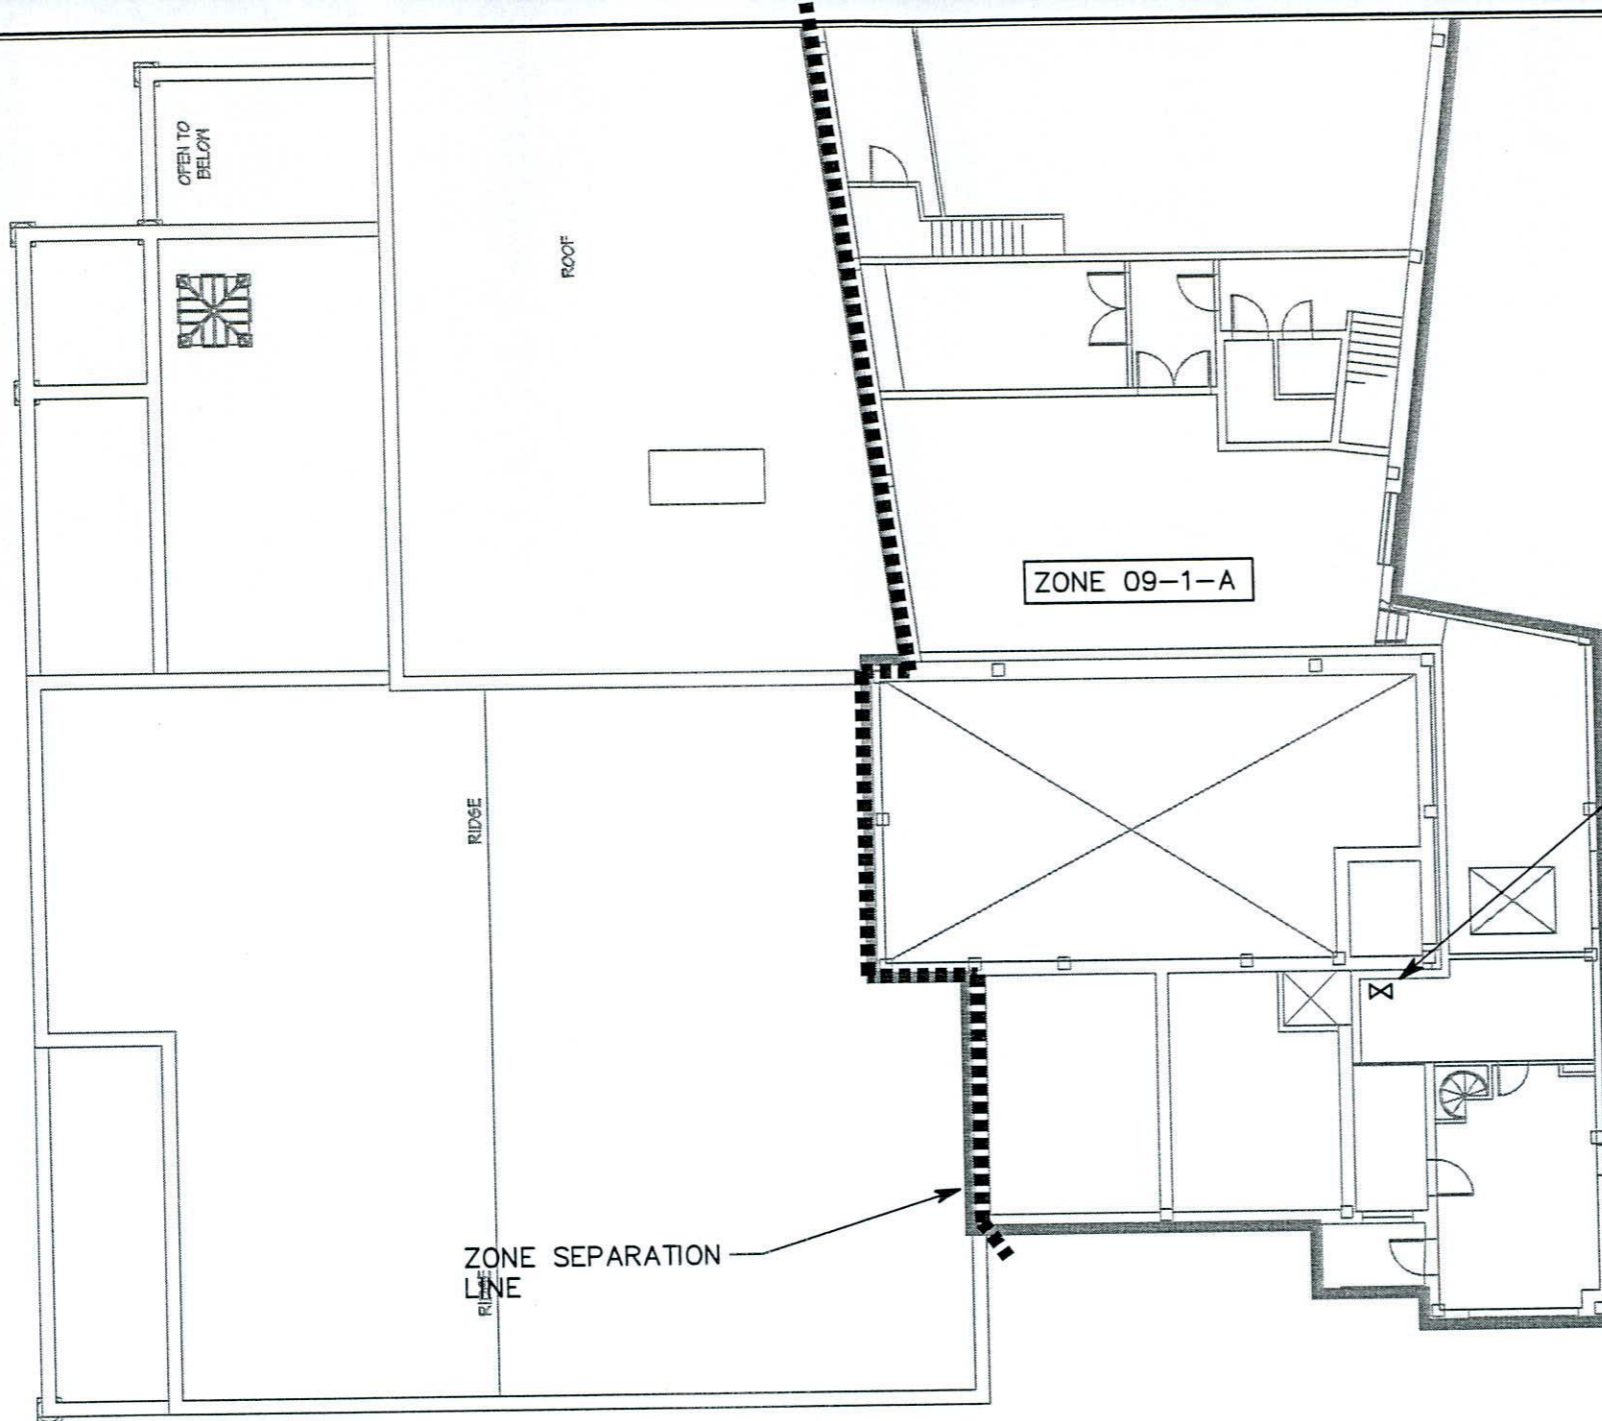

KEY PLAN

Revisions	Date


Consultant

SPECTRUM ENGINEERS
324 South State Street, Suite 400
Salt Lake City, Utah 84111
801.328.5151
800.678.7077
FAX 801.328.5155
www.spectrum-engineers.com

Project Title
CAMPUS WIDE FIRE SPRINKLING TEST STATION
MODIFICATION AND DEFICIENCIES STUDY
Consultant Project No. 20100195
Drawn BXW
Checked JDD

Drawing Title
BUILDING 9
SECOND FLOOR
ZONE A - SOUTH

Date 08.03.2010
Project No. 660-10-110
Building No. 9

Drawing No. F.09.2B
Dep. of XX

Department of Veterans Affairs

AS-BUILT RECORD DRAWINGS