
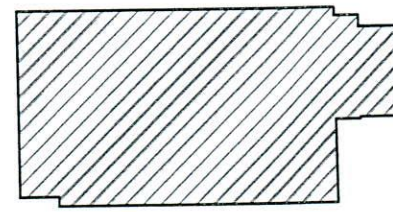
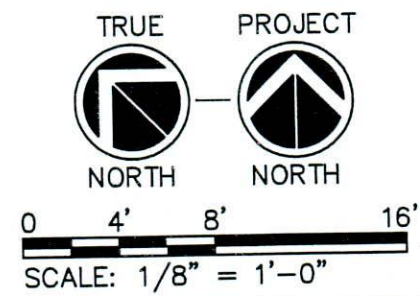


File Name: P:\2010\20100195\10Drawings\Bldg 13\3Sheet\95F.13.1.dwg Last Plotted: 2010/11/01 12:20 PM By: jdd

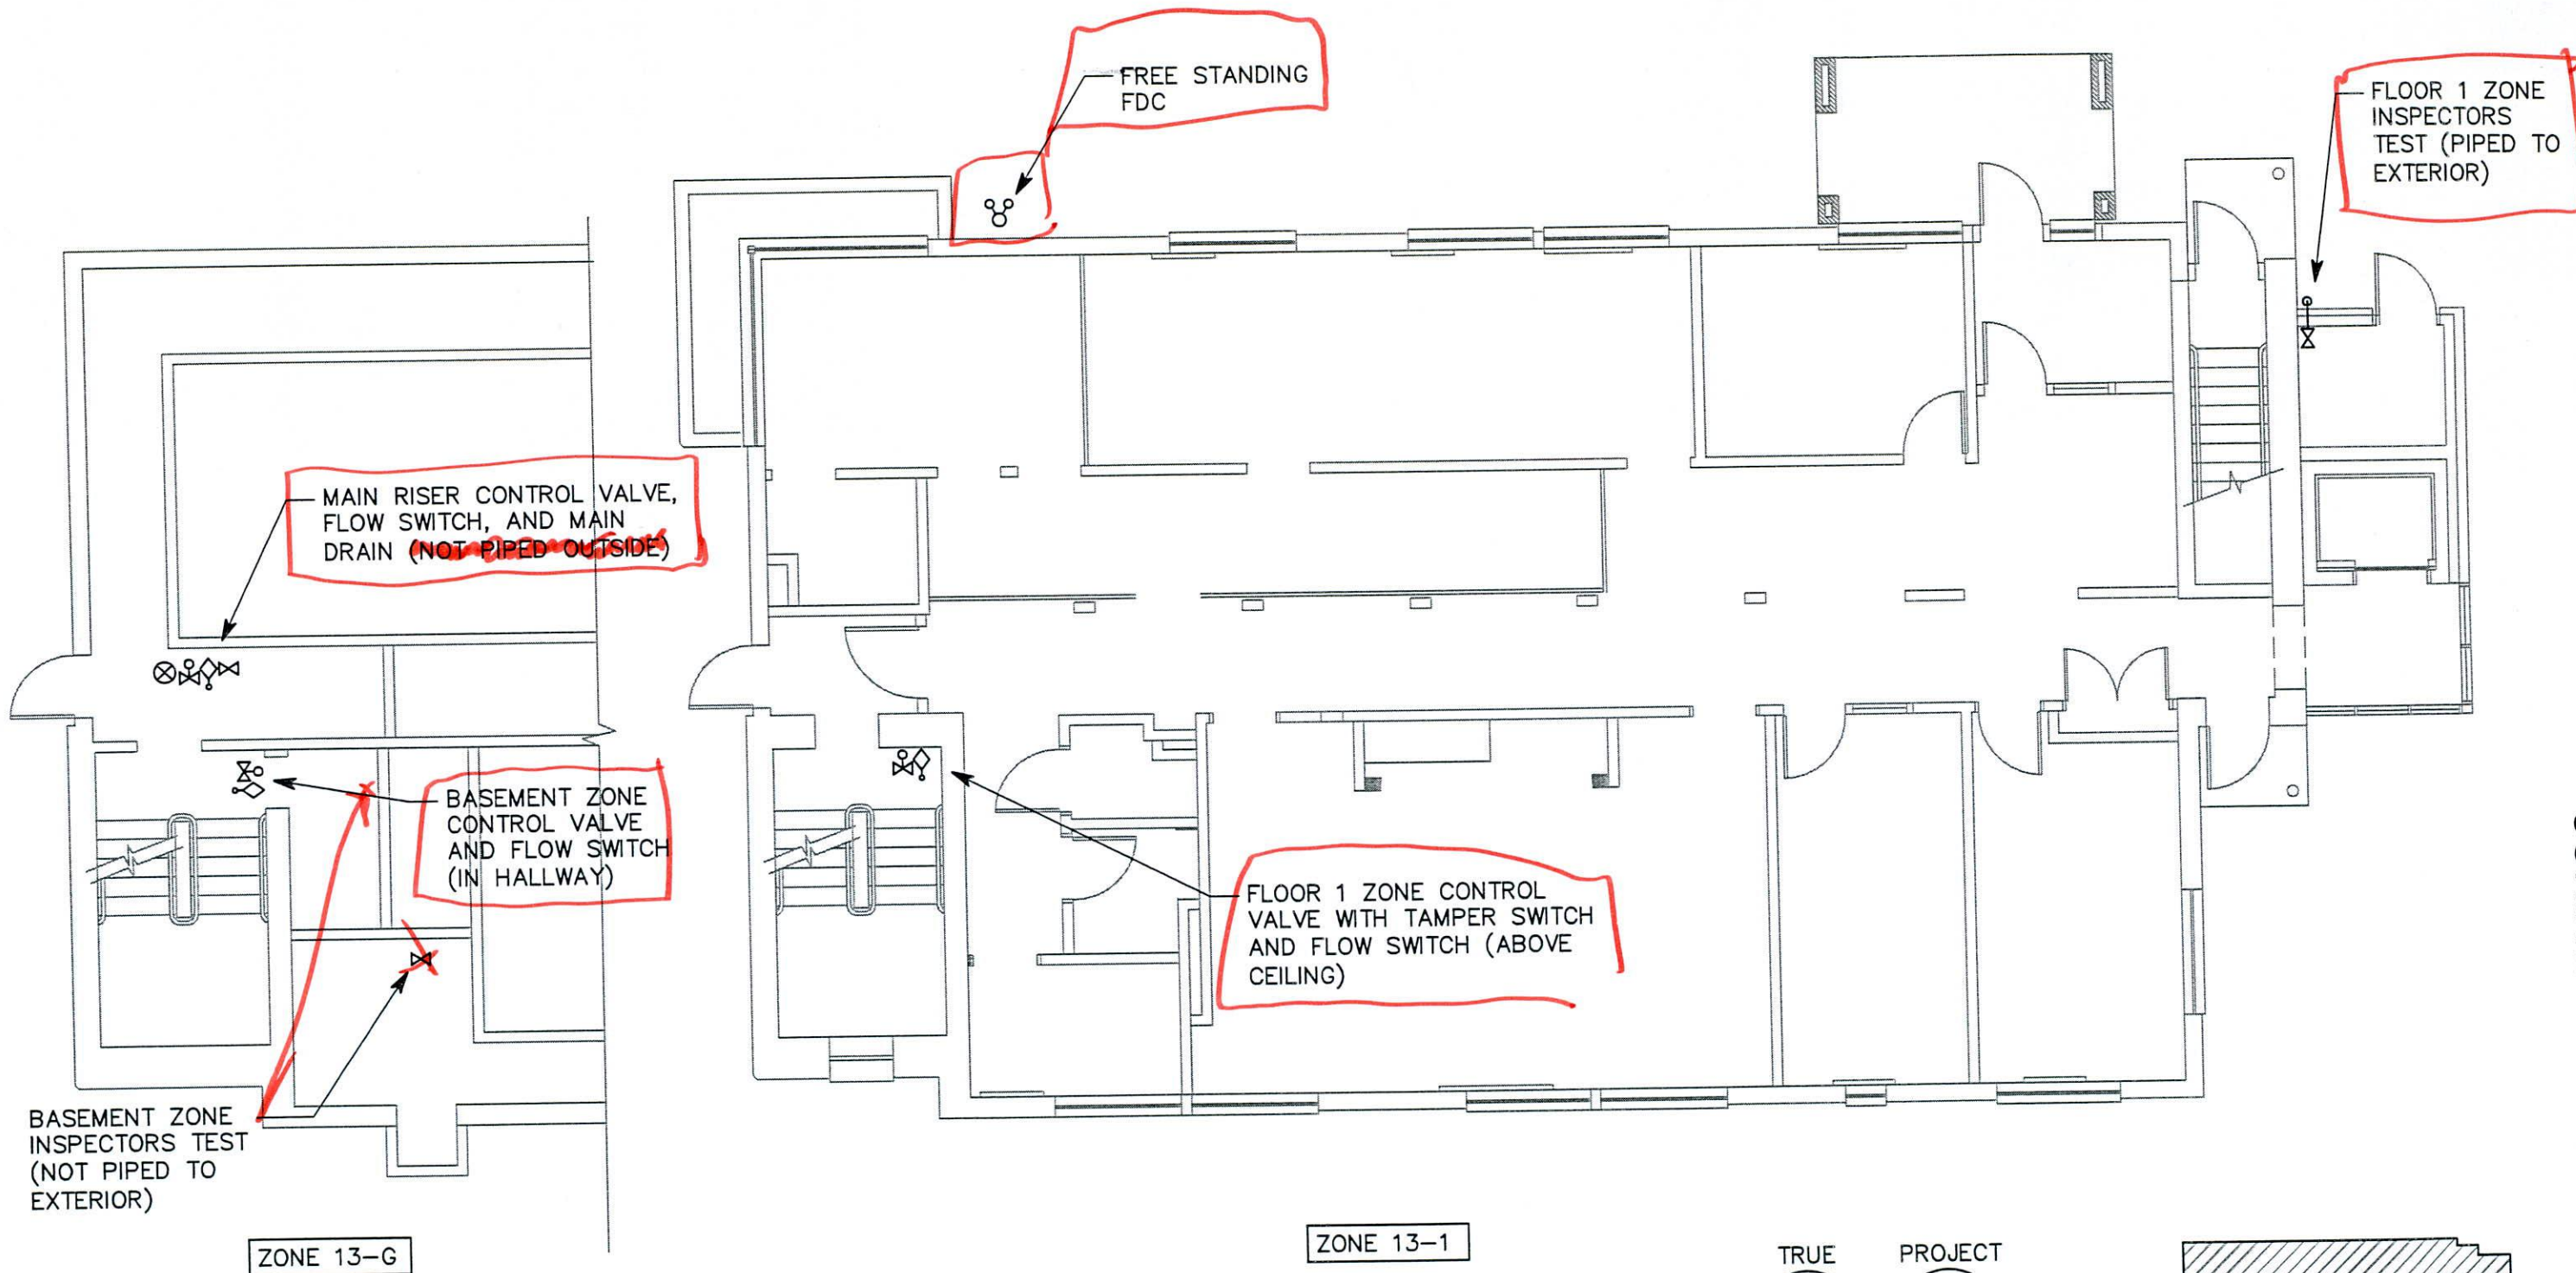

KEY PLAN

| | | | | | | | | | | | | |
|-----------|------|--|---|---|--|--|---|------------|---------------------------|--------------------|---|--|
| Revisions | | |  SPECTRUM ENGINEERS | Consultant 324 South State Street, Suite 400 Salt Lake City, Utah 84111 801.328.5151 800.678.7077 FAX 801.328.5155 www.spectrum-engineers.com | Project Title CAMPUS WIDE FIRE SPRINKLING TEST STATION MODIFICATION AND DEFICIENCIES STUDY | | Drawing Title BUILDING 13 BASEMENT AND FIRST LEVEL | 08.03.2010 | Project No. 660-10-110 | Building No. 13 | F.13.1 Dep. of XX  VAMC TO QUALITY | Department of Public Works Affairs |
| | | | | | Consultant Project No. 20100195 | | | Drawn BXW | | | | |
| | Date | | | | | | | | | | | |
| | Date | | | | | | | | | | | |

AS-BUILT RECORD DRAWINGS