



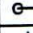

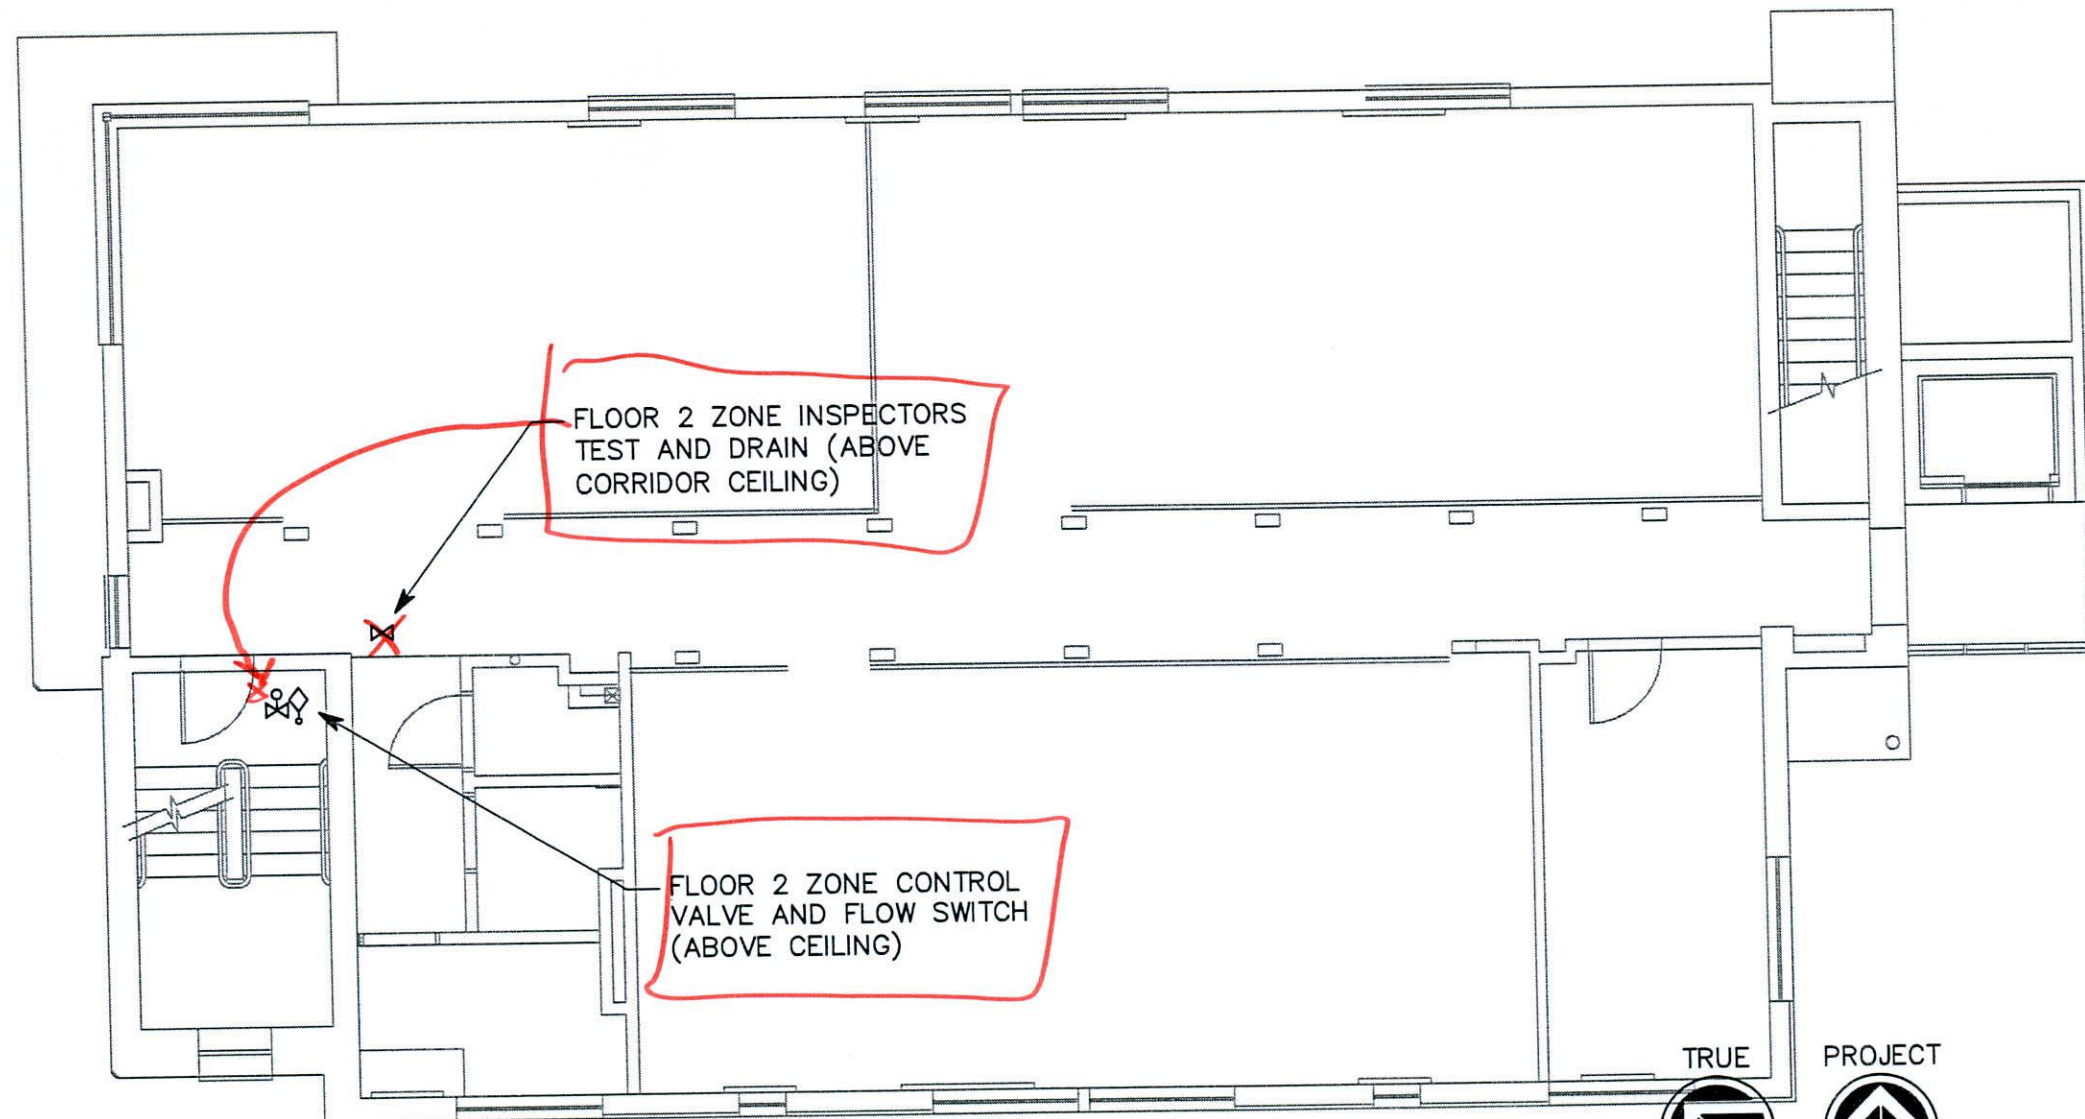
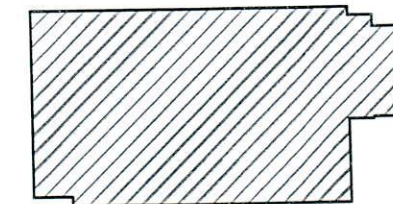
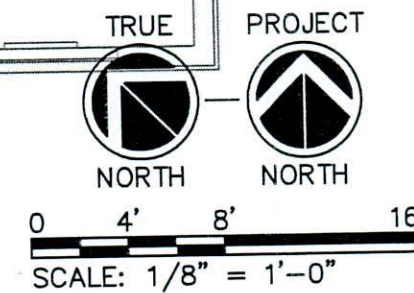


File Name: P:\2010\20100195\Drawings\Bldg 13\3Sheet\95F.13.2.dwg Last Plotted: 2010/11/01 12:20 PM By: jdd

| LEGEND | |
|---|------------------------|
|  | CONTROL VALVE |
|  | FLOW SWITCH |
|  | IT AND/OR DRAIN VALVE |
|  | HOSE VALVE |
|  | IT AND/OR DRAIN OUTLET |
|  | POST INDICATOR VALVE |



ZONE 13-2



KEY PLAN

Revisions

Date
Date

Consultant



324 South State Street, Suite 400
Salt Lake City, Utah 84111
801.328.5151
800.678.7077
FAX 801.328.5155
www.spectrum-engineers.com

Project Title
CAMPUS WIDE FIRE SPRINKLING TEST STATION
MODIFICATION AND DEFICIENCIES STUDY

Consultant Project No. 20100195

Drawn BXW

Checked JDD

Drawing Title
BUILDING 13
SECOND LEVEL

Date
08.03.2010
Project No.
660-10-110
Building No.
13

DRAWING No.
F.13.2
Dep. of
or XX
VAMC
TO QUALITY

Department of
Veterans Affairs

AS-BUILT RECORD DRAWINGS