
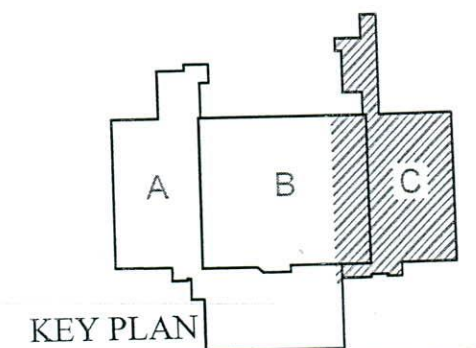
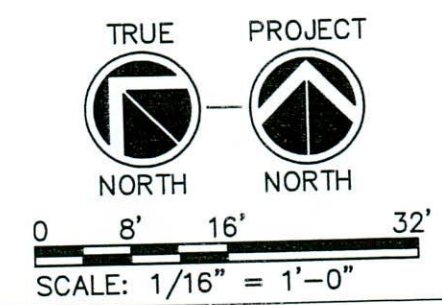
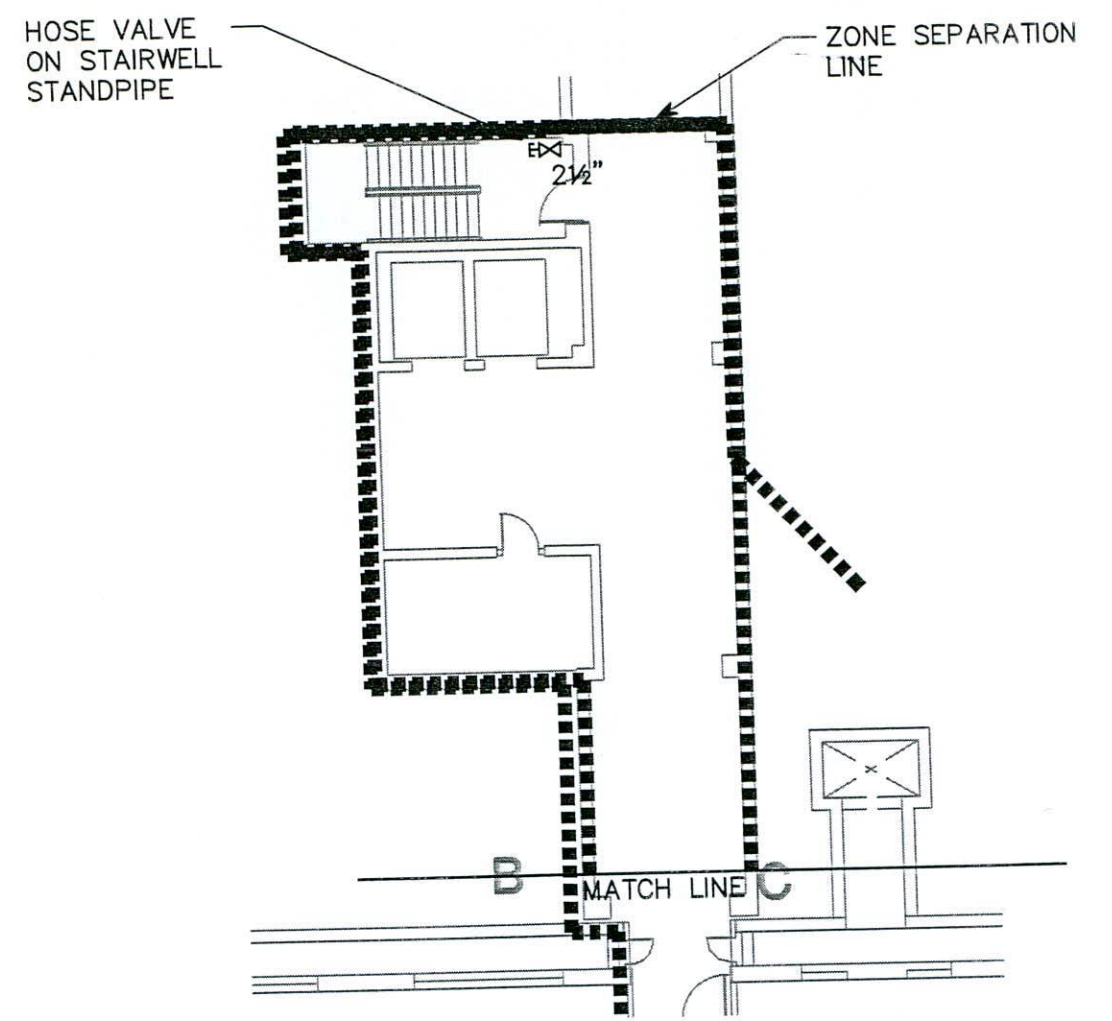


D:\Drawings\Bldg 14\3Sheet\95F.14.1c.dwg Last Plotted: 2010/11/01 12:20 PM By: jdd

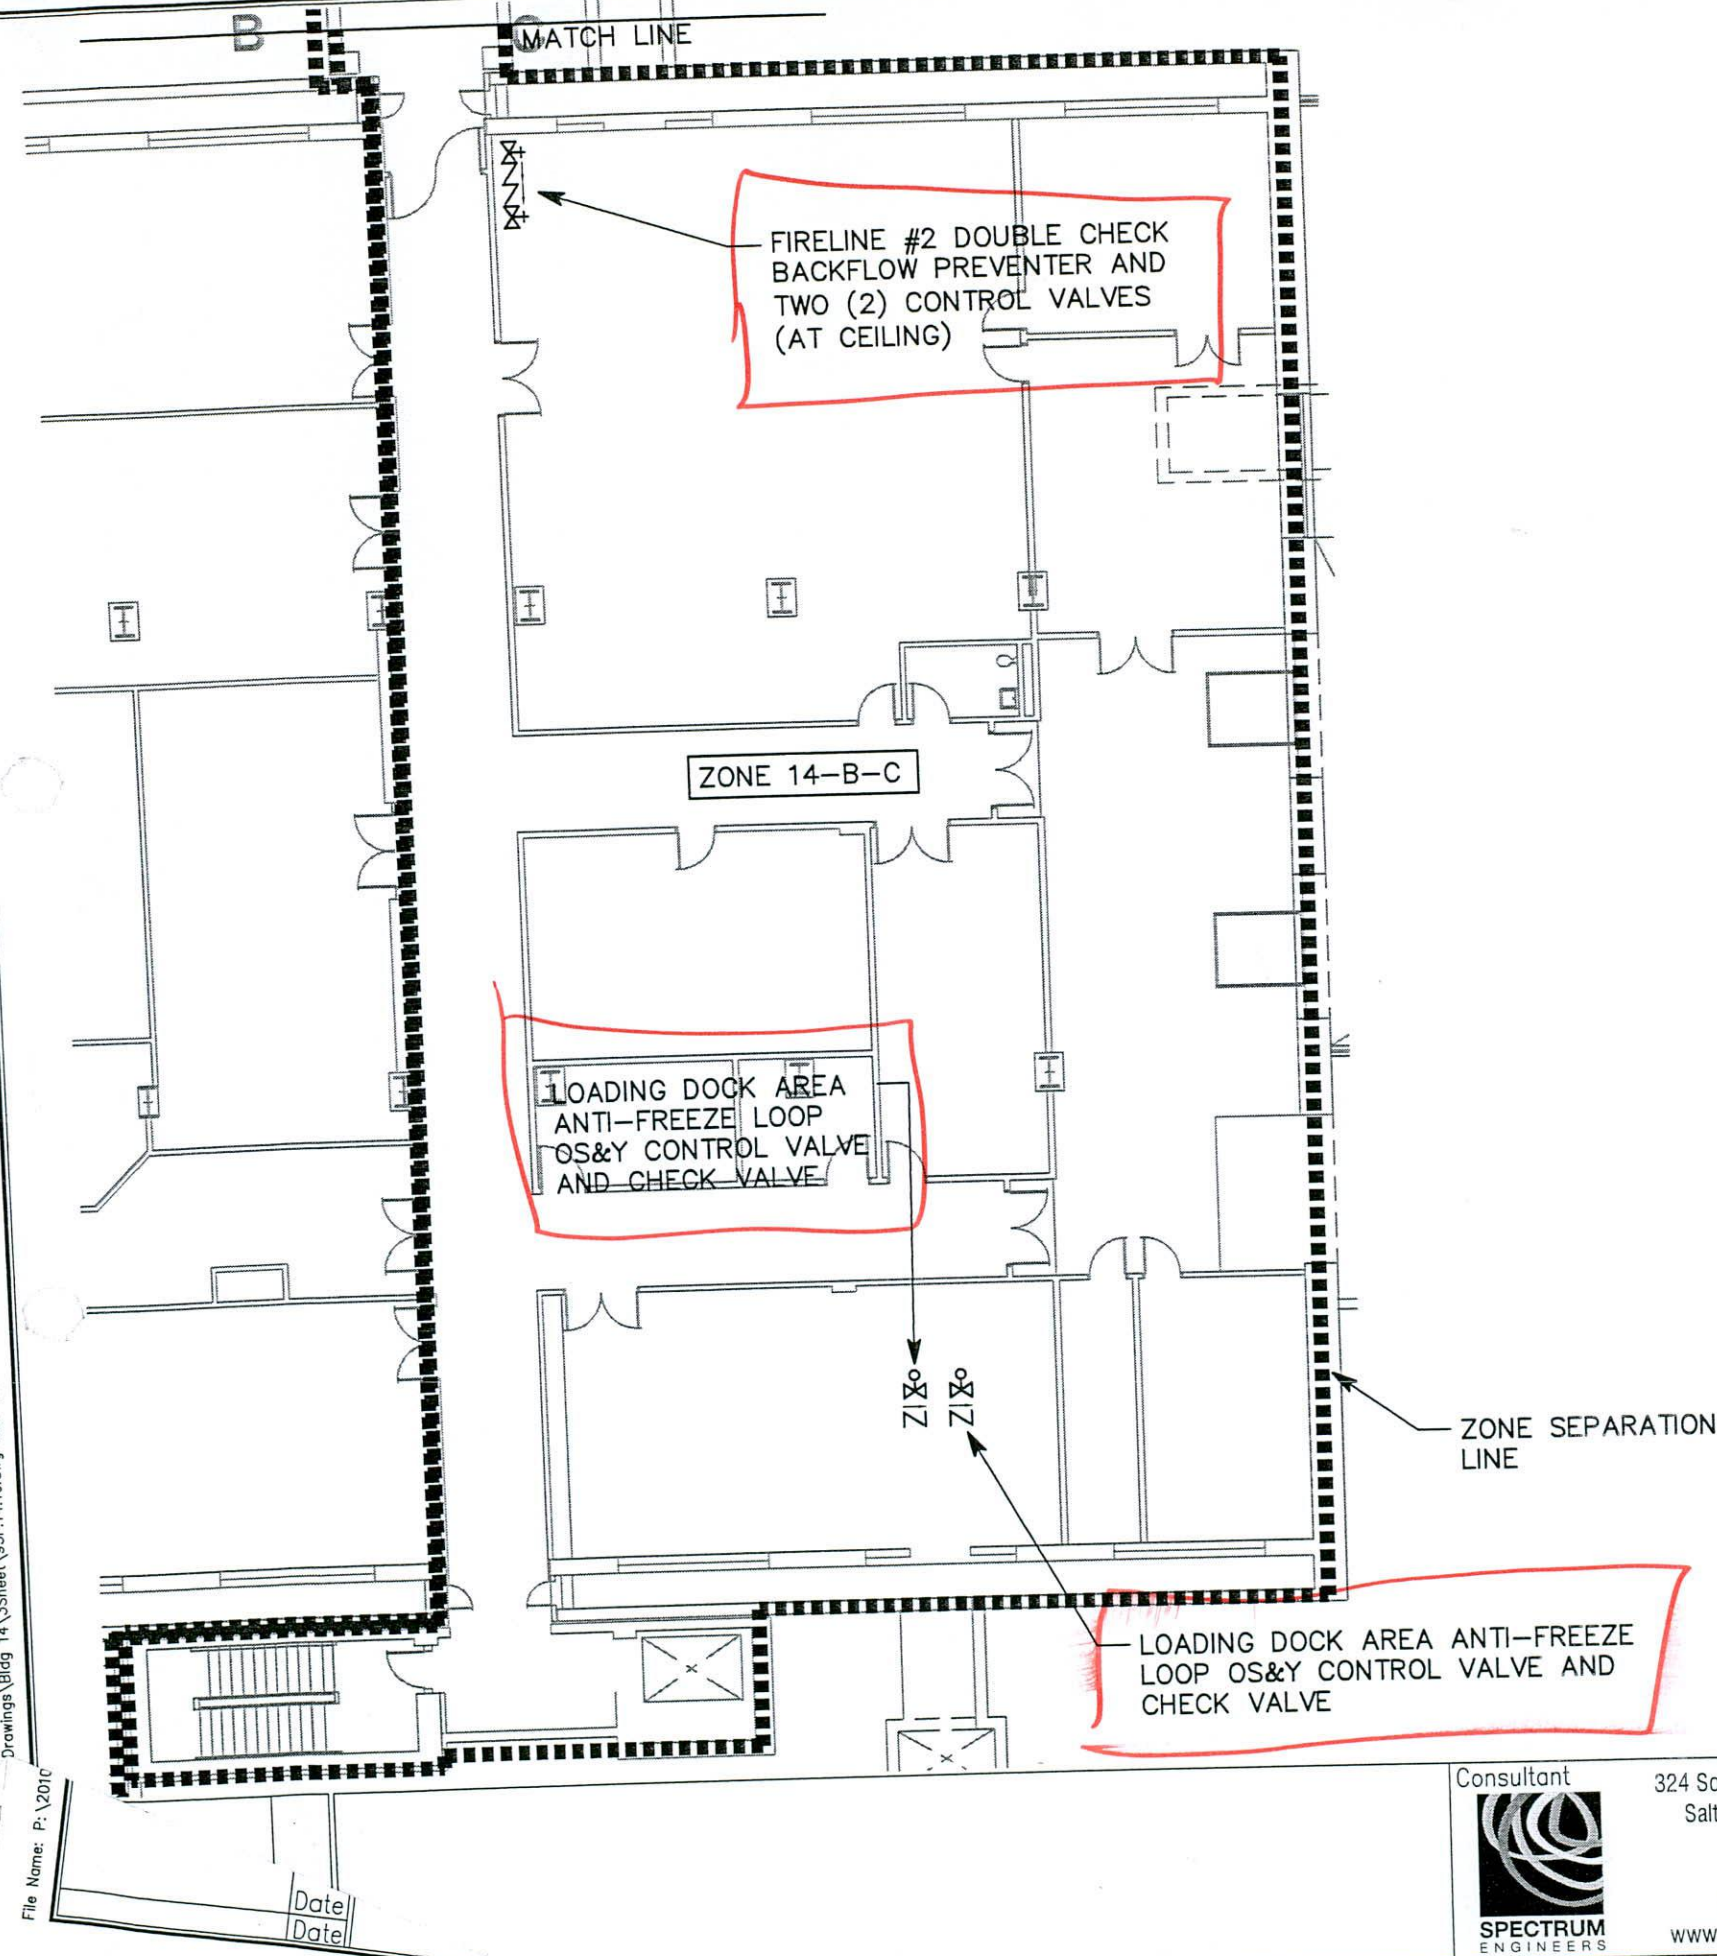

Consultant  
324 South State Street, Suite 400  
Salt Lake City, Utah 84111  
801.328.5151  
800.678.7077  
FAX 801.328.5155  
www.spectrum-engineers.com

Project Title  
CAMPUS WIDE FIRE SPRINKLING TEST STATION  
MODIFICATION AND DEFICIENCIES STUDY  
Consultant Project No. 20100195  
Drawn BXW  
Checked JDD

Drawing Title  
BUILDING 14  
BASEMENT LEVEL  
ZONE C

Date 08.03.2010  
Project No. 660-10-110  
Building No. 14

DRAWING No. F.14.1C  
Dep. of XX  
VAMC  
TO QUALITY

AS-R1111 T RECORD DRAWINGS