



File Name: P:\2010\20100195\10Drawings\Bldg 14\3Sheet\95F.14.2a.dwg Last Plotted: 2010/11/01 12:20 PM By: jdd

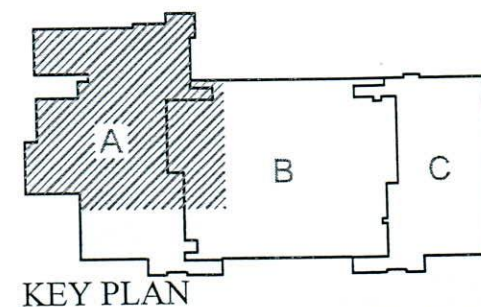

Revisions	Date
	Date

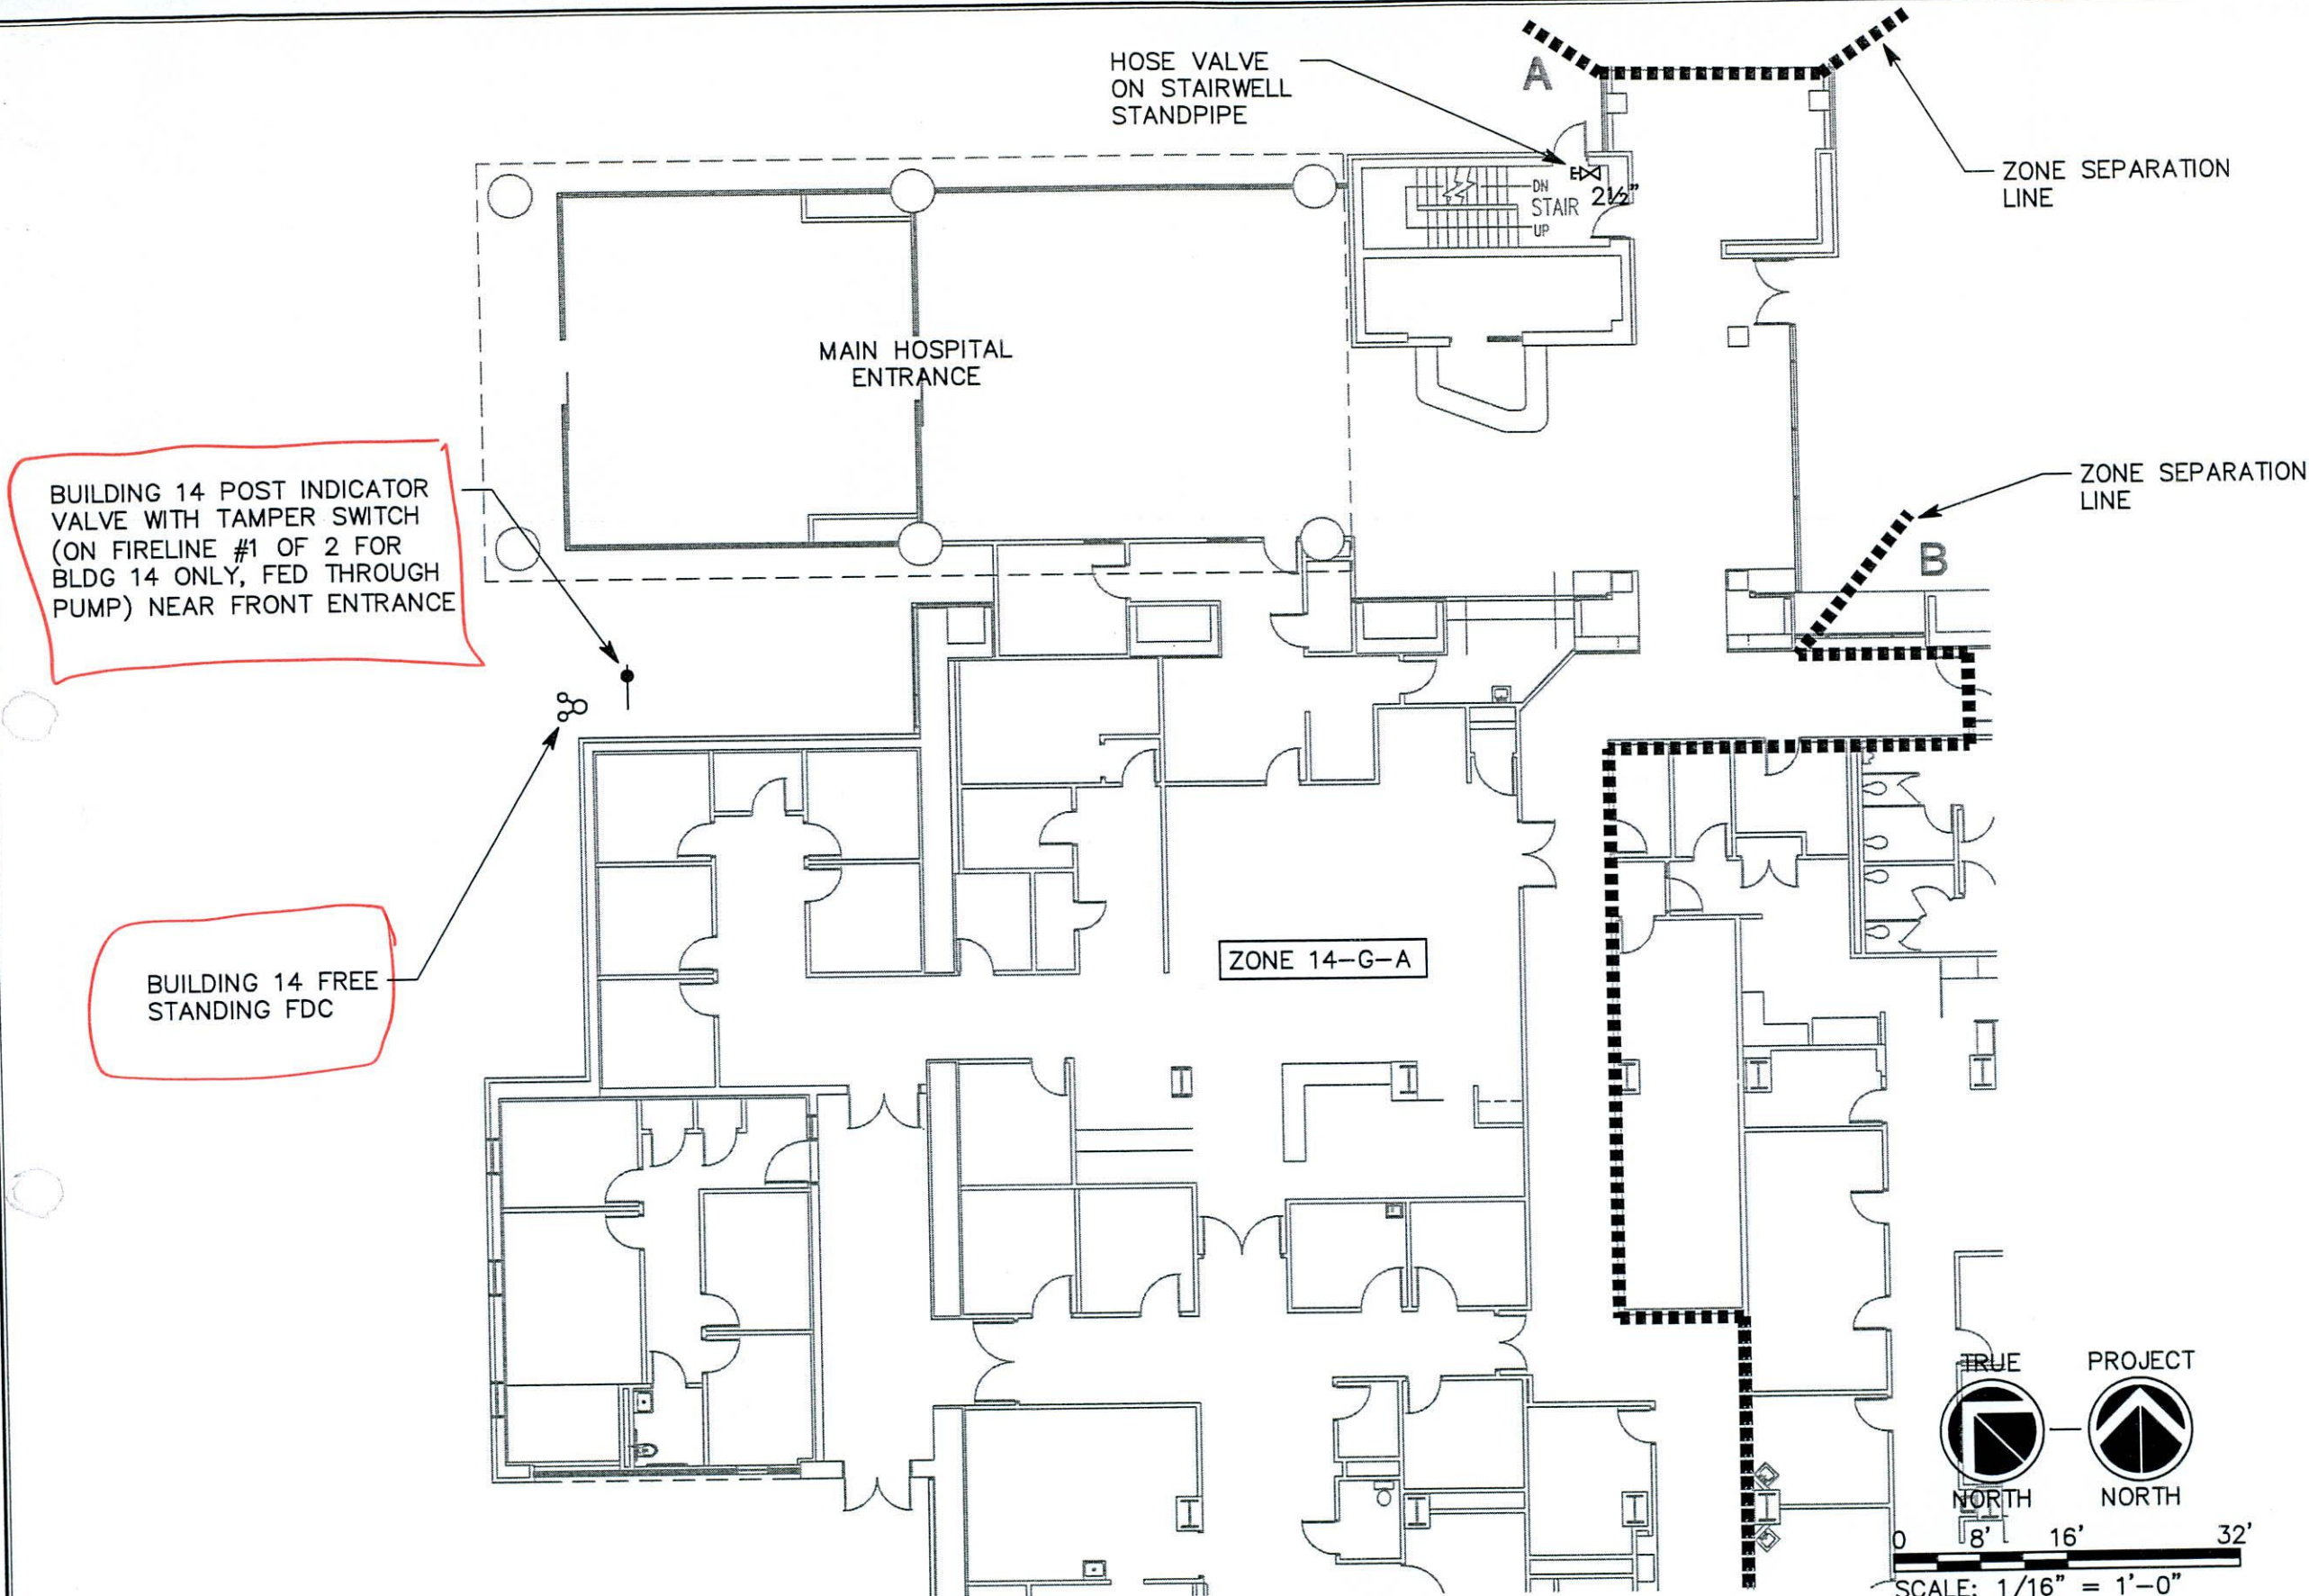

Consultant  
324 South State Street, Suite 400  
Salt Lake City, Utah 84111  
801.328.5151  
800.678.7077  
FAX 801.328.5155  
www.spectrum-engineers.com

Project Title  
CAMPUS WIDE FIRE SPRINKLING TEST STATION  
MODIFICATION AND DEFICIENCIES STUDY

Consultant Project No. 20100195

Drawn BXW Checked JDD

Drawing Title  
BUILDING 14  
GROUND LEVEL  
ZONE A

Date  
08.03.2010

Project No.  
660-10-110

Building No.  
14

DRAWING No.  
F.14.2A

Dep. of XX

VAMC  
TO QUALITY

AS-BUILT RECORD DRAWINGS

Department of