



File Name: P:\2010\20100195\Drawings\Bldg 14\3Sheet\95F14.5c.dwg Last Plotted: 2010/11/01 12:19 PM By: jdd

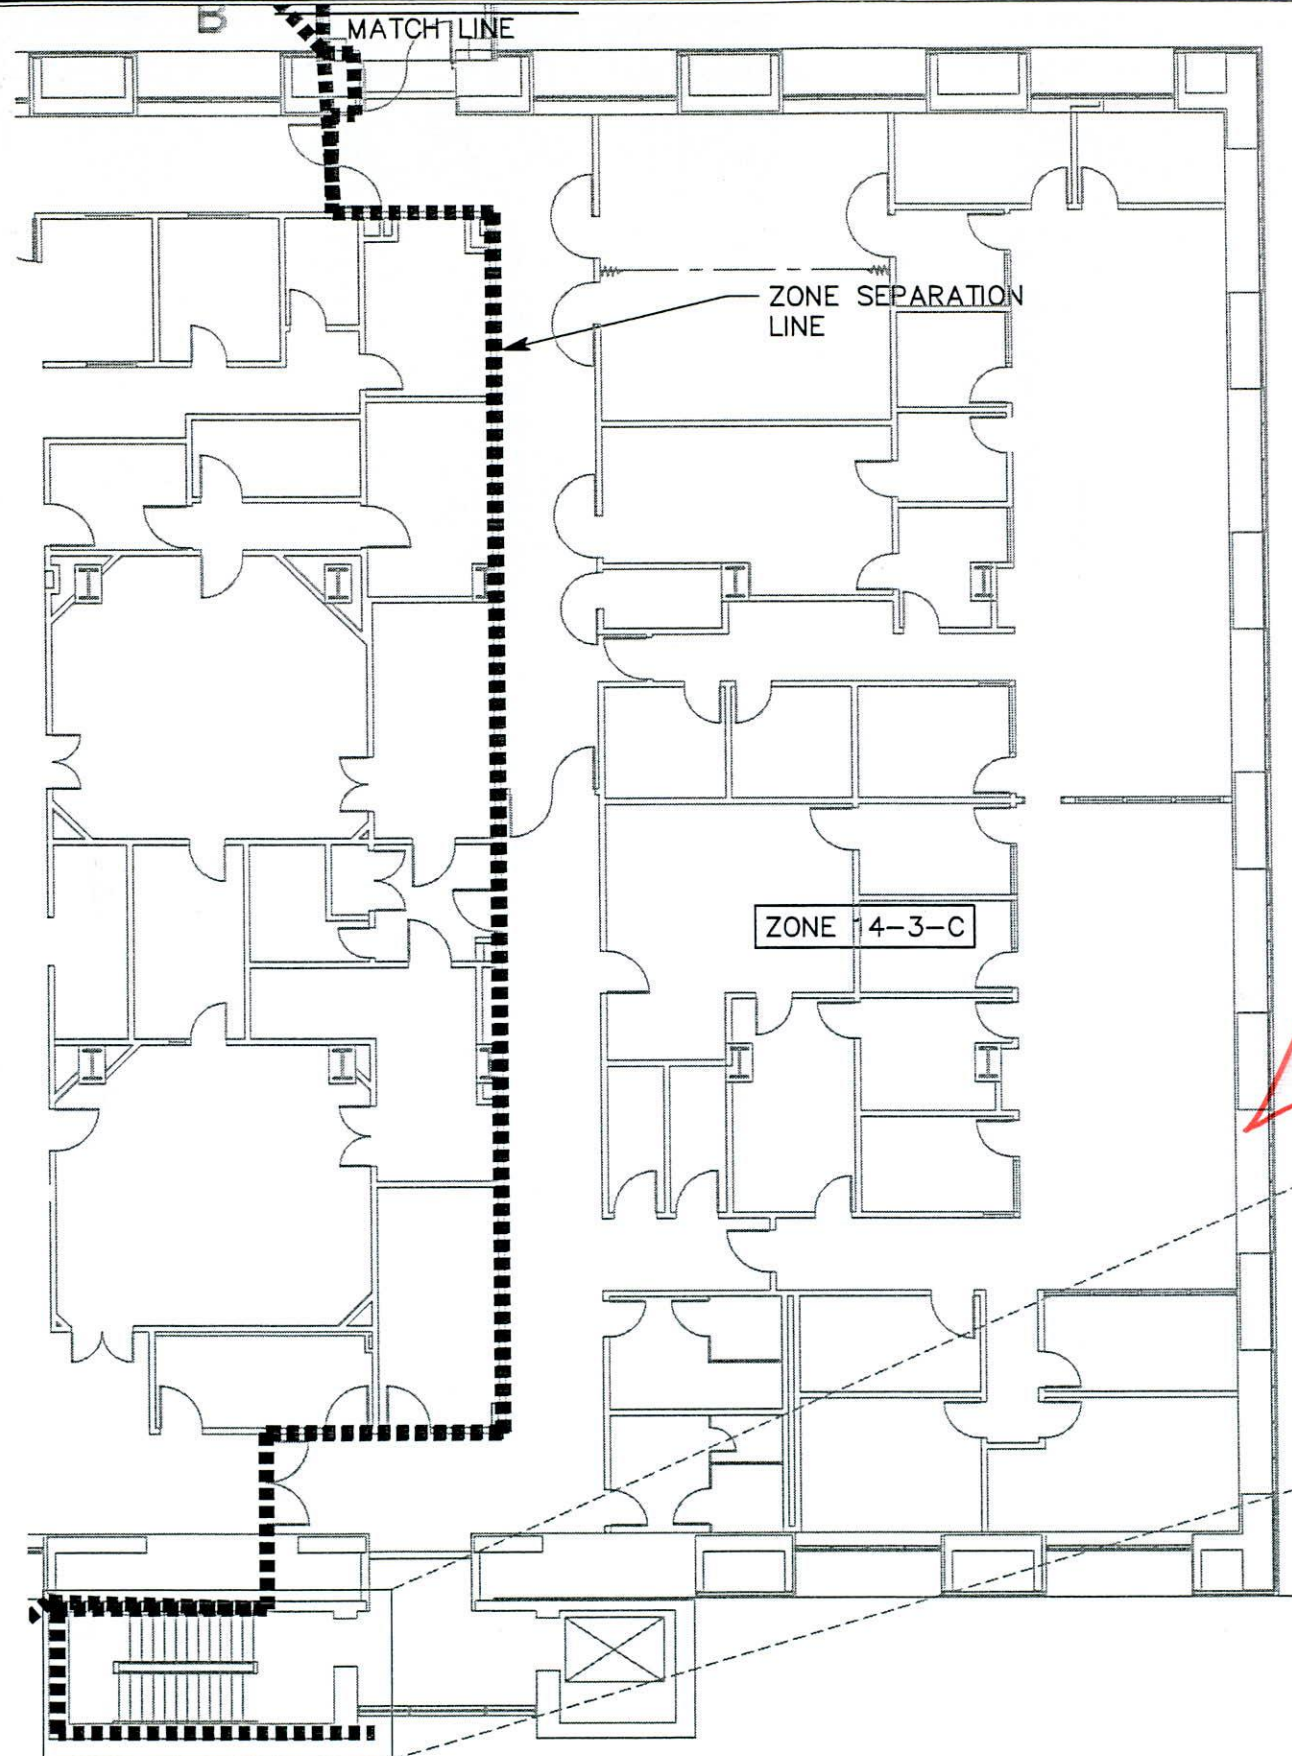

HOSE VALVE ON STAIRWELL  
STANDPIPE (CONSIDERED  
PART OF BLDG 14)


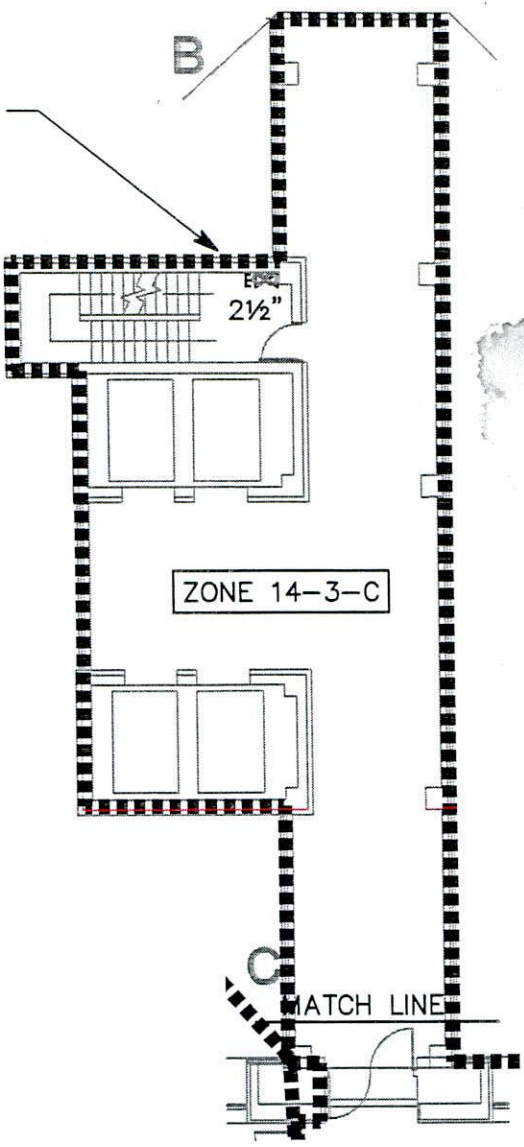


ZONE 14-3-A CONTROL VALVE,  
FLOW SWITCH, AND COMBINATION  
INSPECTORS TEST/DRAIN  
(ABOVE CEILING)

ZONE 14-3-B CONTROL VALVE,  
FLOW SWITCH, AND COMBINATION  
INSPECTORS TEST/DRAIN  
(ABOVE CEILING)

ZONE 14-3-C CONTROL VALVE,  
FLOW SWITCH, AND COMBINATION  
INSPECTORS TEST/DRAIN  
(ABOVE CEILING)

ZONE 14-4-A CONTROL VALVE,  
FLOW SWITCH, AND COMBINATION  
INSPECTORS TEST/DRAIN  
(ABOVE CEILING, PENTHOUSE  
SYSTEM)

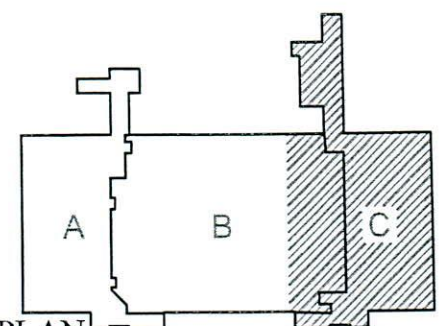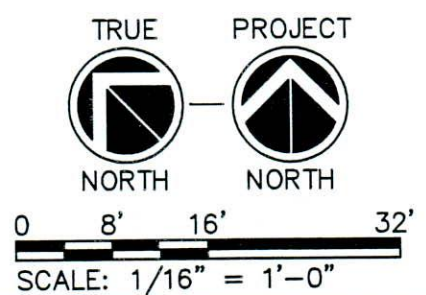

Revisions	Date

Consultant  
  
**SPECTRUM  
ENGINEERS**  
324 South State Street, Suite 400  
Salt Lake City, Utah 84111  
801.328.5151  
800.678.7077  
FAX 801.328.5155  
www.spectrum-engineers.com

Project Title  
CAMPUS WIDE FIRE SPRINKLING TEST STATION  
MODIFICATION AND DEFICIENCIES STUDY

Consultant Project No. 20100195

Drawn BXW Checked JDD

Drawing Title  
BUILDING 14  
THIRD LEVEL  
ZONE C

Date  
08.03.2010

Project No.  
660-10-110

Building No.  
14

DRAWING No.  
F14.5C

Dep. OF XX

  
TO QUALITY

AS-BUILT RECORD DRAWINGS

Department of  
Veterans Affairs