


File Name: P:\2010\20100195\Drawings\Bldg 38\3Sheet\95F.38.1.dwg Last Plotted: 2010/11/01 12:18 PM By: jdd

Revisions	Date
	Date



**SPECTRUM**  
ENGINEERS

324 South State Street, Suite 400  
Salt Lake City, Utah 84111  
801.328.5151  
800.678.7077  
FAX 801.328.5155  
www.spectrum-engineers.com

Project Title  
CAMPUS WIDE FIRE SPRINKLING TEST STATION  
MODIFICATION AND DEFICIENCIES STUDY

Consultant Project No. 20100195

Drawn BXW      Checked JDD


Drawing Title  
BUILDING 38  
FIRST LEVEL

Date  
08.03.2010

Project No.  
660-10-110


Building No.  
38





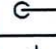

DRAWING No.  
**F.38.1**  
Dep. of XX



  
TO QUALITY

Department of  
Veterans Affairs

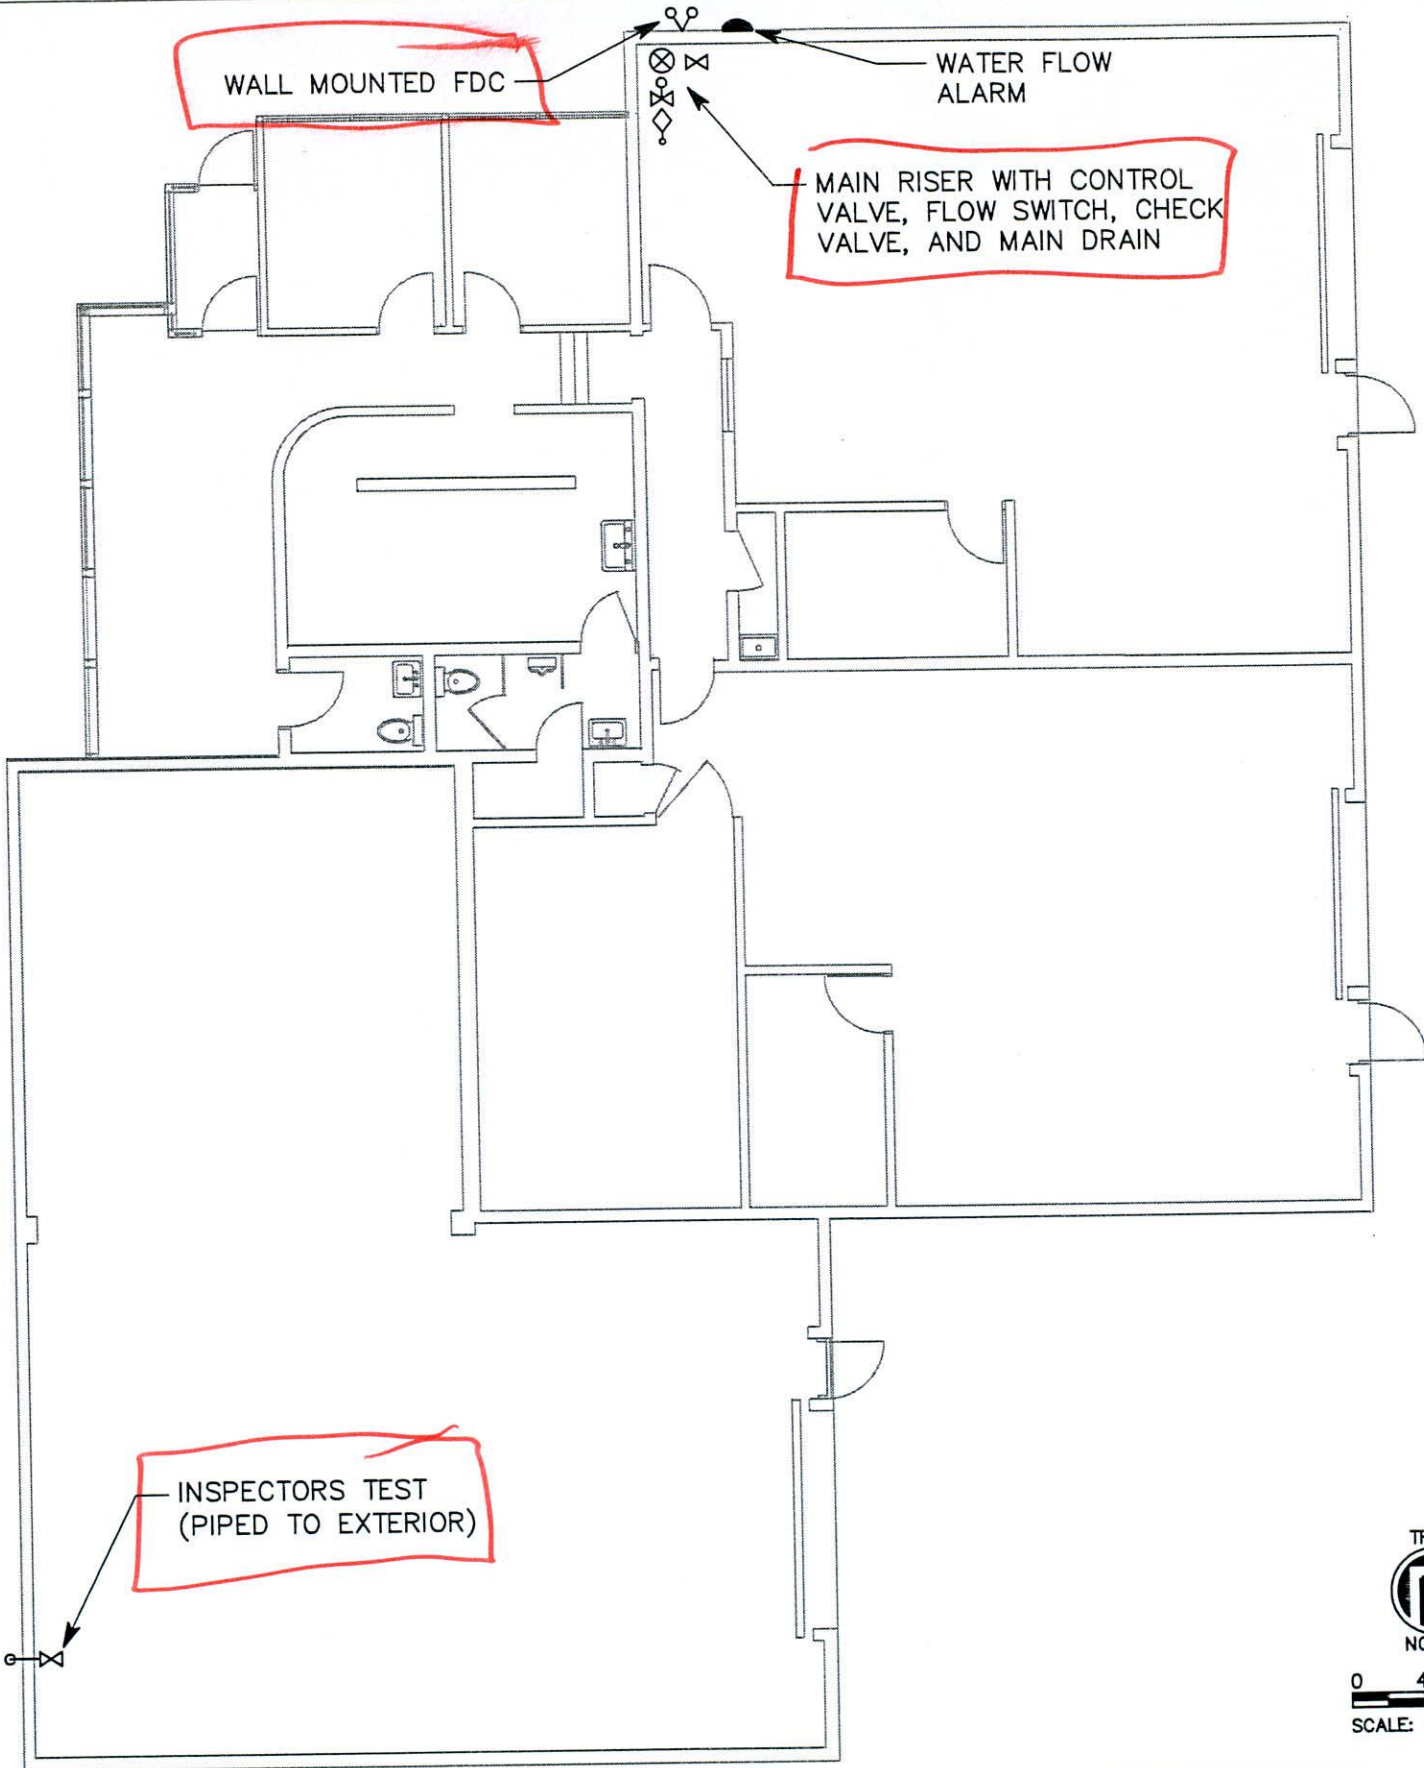BUILDING 38 POST INDICATOR  
VALVE (MAIN CONTROL VALVE)  
ACROSS DRIVEWAY  
(NO TAMPER SWITCH)

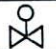

LEGEND	
	CONTROL VALVE
	FLOW SWITCH
	IT AND/OR DRAIN VALVE
	HOSE VALVE
	IT AND/OR DRAIN OUTLET
	POST INDICATOR VALVE

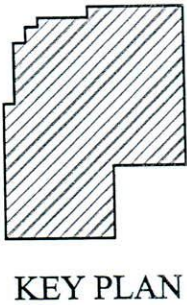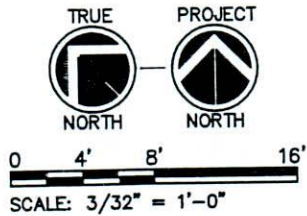

AS-BUILT RECORD DRAWINGS