

VICINITY MAP  
NOT TO SCALE

VISN 19 RECORD FILE DRAWINGS  
GRAND JUNCTION VAMC - BUILDING 20 - NURSING HOME/TCU  
DEPARTMENT OF VETERANS AFFAIRS  
2121 NORTH AVENUE  
GRAND JUNCTION, CO 81501




LOCATION MAP  
NOT TO SCALE




| SHEET INDEX            |   |
|------------------------|---|
| SHEET NUMBER           | SHEET NAME                                |
| GENERAL SHEETS         |   |
| GI001                  | COVER SHEET/SHEET INDEX                   |
| ARCHITECTURAL SHEETS   |   |
| AE100                  | 1ST FLOOR PLAN – OVERALL                  |
| AE101                  | 1ST FLOOR PLAN – AREA A                   |
| AE102                  | 1ST FLOOR PLAN – AREA B                   |
| AE103                  | 1ST FLOOR PLAN – AREA C                   |
| AE104                  | 1ST FLOOR PLAN – AREA D                   |
| FIRE PROTECTION SHEETS |   |
| FX100                  | 1ST FLOOR FIRE SUPPRESSION PLAN – OVERALL |
| FX101                  | 1ST FLOOR FIRE SUPPRESSION PLAN – AREA A  |
| FX102                  | 1ST FLOOR FIRE SUPPRESSION PLAN – AREA B  |

|                   |  |
|-------------------|--|
| FX103             | 1ST FLOOR FIRE SUPPRESSION PLAN – AREA C |
| FX104             | 1ST FLOOR FIRE SUPPRESSION PLAN – AREA D |
| MECHANICAL SHEETS |  |
| MD100             | 1ST FLOOR HVAC DUCT PLAN – OVERALL       |
| MD101             | 1ST FLOOR HVAC DUCT PLAN – AREA A        |
| MD102             | 1ST FLOOR HVAC DUCT PLAN – AREA B        |
| MD103             | 1ST FLOOR HVAC DUCT PLAN – AREA C        |
| MD104             | 1ST FLOOR HVAC DUCT PLAN – AREA D        |
| MP100             | 1ST FLOOR HVAC PIPING PLAN – OVERALL     |
| MP101             | 1ST FLOOR HVAC PIPING PLAN – AREA A      |
| MP102             | 1ST FLOOR HVAC PIPING PLAN – AREA B      |
| MP103             | 1ST FLOOR HVAC PIPING PLAN – AREA C      |
| MP104             | 1ST FLOOR HVAC PIPING PLAN – AREA D      |
| ELECTRICAL SHEETS |  |
| MG100             | 1ST FLOOR MEDICAL GAS PLAN – OVERALL     |
| MG101             | 1ST FLOOR MEDICAL GAS PLAN – AREA A      |

|                   |                                     |
|-------------------|-------------------------------------|
| MG102             | 1ST FLOOR MEDICAL GAS PLAN – AREA B |
| MG103             | 1ST FLOOR MEDICAL GAS PLAN – AREA C |
| MG104             | 1ST FLOOR MEDICAL GAS PLAN – AREA D |
| PLUMBING SHEETS   |                                     |
| PL100             | 1ST FLOOR PLUMBING PLAN – OVERALL   |
| PL101             | 1ST FLOOR PLUMBING PLAN – AREA A    |
| PL102             | 1ST FLOOR PLUMBING PLAN – AREA B    |
| PL103             | 1ST FLOOR PLUMBING PLAN – AREA C    |
| PL104             | 1ST FLOOR PLUMBING PLAN – AREA D    |
| ELECTRICAL SHEETS |                                     |
| EP100             | 1ST FLOOR ELECTRICAL PLAN – OVERALL |
| EP101             | 1ST FLOOR ELECTRICAL PLAN – AREA A  |
| EP102             | 1ST FLOOR ELECTRICAL PLAN – AREA B  |
| EP103             | 1ST FLOOR ELECTRICAL PLAN – AREA C  |
| EP104             | 1ST FLOOR ELECTRICAL PLAN – AREA D  |

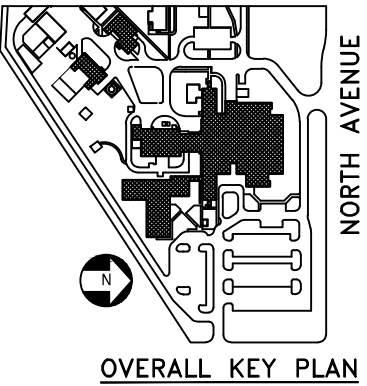

|   |  |              |  |                      |   |  |              |  |  |                                   |  |  |
|---|--|--------------|--|----------------------|---|--|--------------|--|--|-----------------------------------|--|--|
|   |  | CONSULTANTS: |  | ARCHITECT/ENGINEERS: | <div><div>AES</div><div>11031 SOUTH PIKES PEAK DRIVE #202<br/>PARKER, COLORADO 80138<br/>PH: 303.841.3922<br/>WWW.AES-GRP.COM</div><div>Group, Inc.</div></div> | Drawing Title<br>COVER SHEET/SHEET INDEX |              | Project Title<br>VISN 19<br>RECORD FILE DRAWINGS |  | Project Number<br>VA259-12-F-1989 |  | Office of<br>Construction<br>and Facilities<br>Management<br><br>Department of<br>Veterans Affairs |
| Approved Project Director<br>DAVID EYRE, PE<br>PHONE: 303-691-6553<br>FAX: 303-639-4001 |  |              |  |                      |   | Location<br>GRAND JUNCTION, CO           |              | Building Number<br>20                            |  |                                   |  |  |
| Date<br>JULY 2013   |  |              |  |                      |   | Checked<br>ALK                           | Drawn<br>ALK | Drawing Number<br>GI001                          |  |                                   |  |  |
|   |  |              |  |                      |   |  |              | Dwg. of  |  |                                   |  |  |
|   |  |              |  |                      |   |  |              |  |  |                                   |  |  |
| Revisions:  |  | Date         |  |                      |   |  |              |  |  |                                   |  |  |

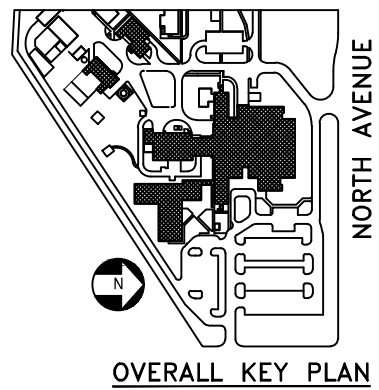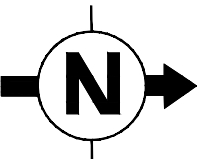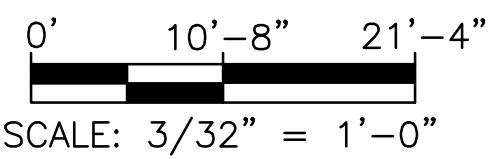

OVERALL KEY PLAN

RECORD SET

| Revisions | Date |
|-----------|------|
|           |      |
|           |      |
| CONSULTANTS: |
|--------------|
|              |
|              |
|  |
|--|
|  |
|  |
ARCHITECT/ENGINEERS:

11031 SOUTH PIKES PEAK DRIVE #202  
PARKER, COLORADO 80138  
PH: 303.841.3922  
WWW.AES-GRP.COM

|   |
|---|
| Drawing Title<br>1ST FLOOR PLAN<br>OVERALL  |
| Approved Project Director<br>DAVID EYRE, PE<br>PHONE: 303-691-6553<br>FAX: 303-639-4001 |

|  |
|--|
| Project Title<br>VISN 19<br>RECORD FILE DRAWINGS |
| Location<br>GRAND JUNCTION, CO                   |
| Date<br>JULY 2013                                |
| Checked<br>ALK                                   |
| Drawn  |

|                                   |
|-----------------------------------|
| Project Number<br>VA259-12-F-1989 |
| Building Number<br>20             |
| Drawing Number<br>AE100           |
| Dwg. of                           |

Office of  
Construction  
and Facilities  
Management

Department of  
Veterans Affairs