




3A

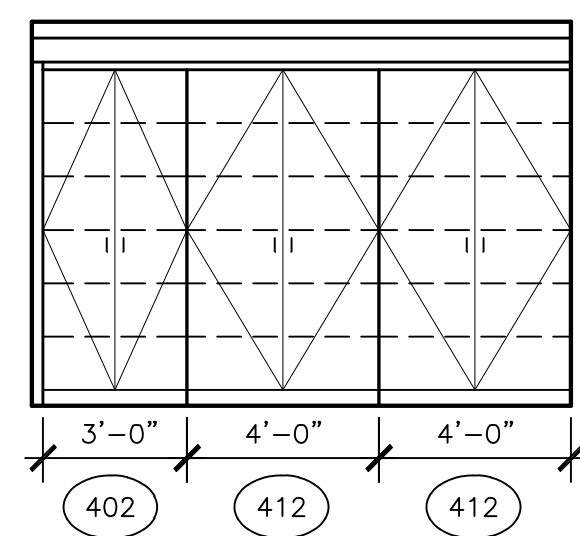

38

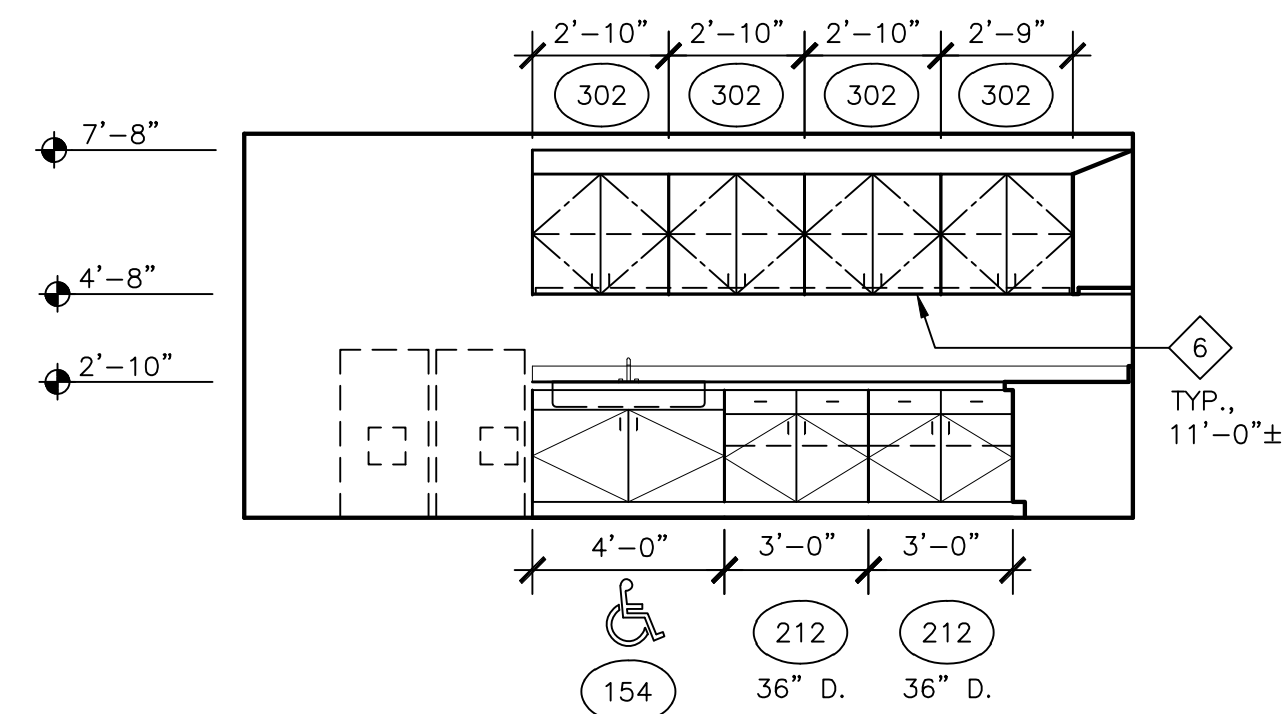


WOOD CASEWORK, SEE SPECIFICATION SECTION 06400, TYP.

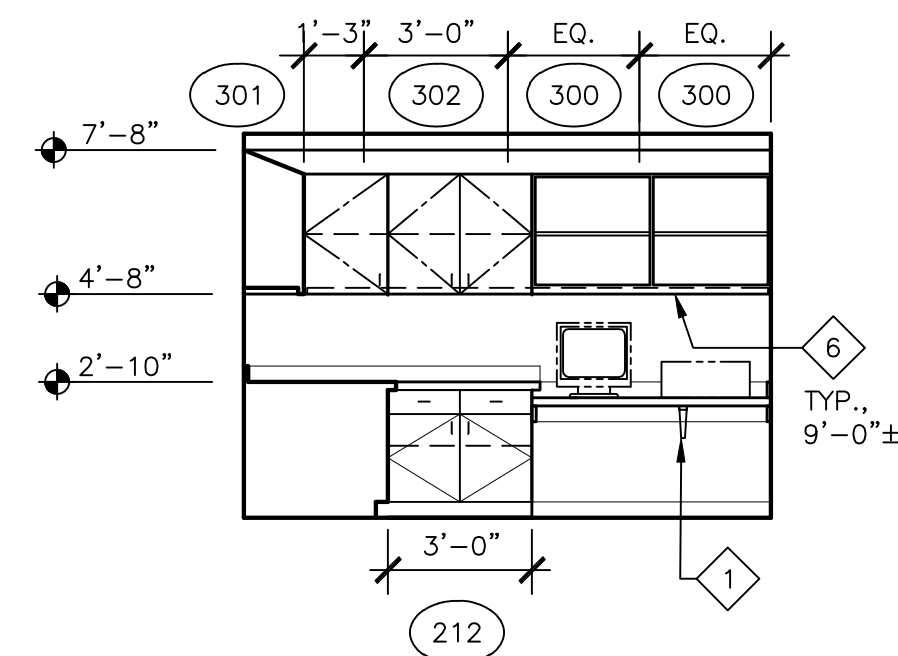


30

DIALYSIS AREA


SCALE: 1/4" = 1'-0"

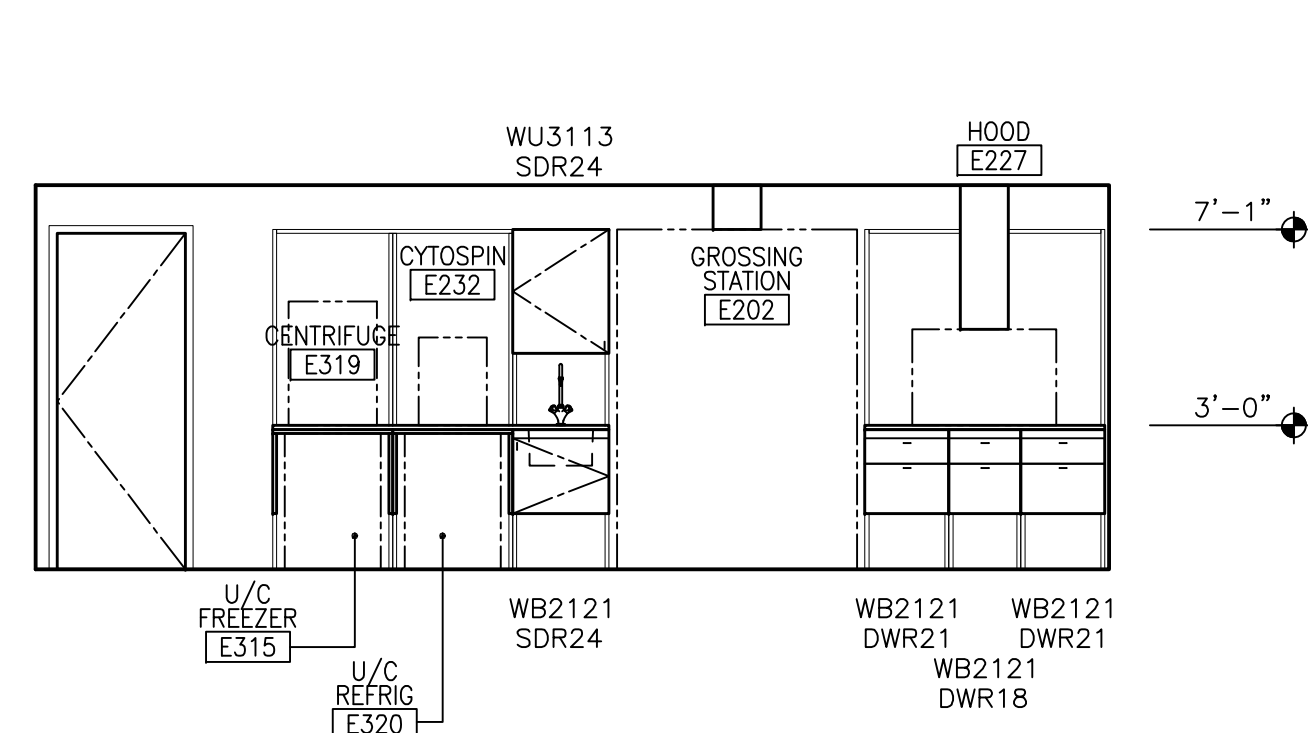


1A - NORTH
LABORATORY CASEWORK (NOTE: SUPPORT BASE AND UPPER CASEWORK WITH
WALL RAIL SYSTEM TYP.)

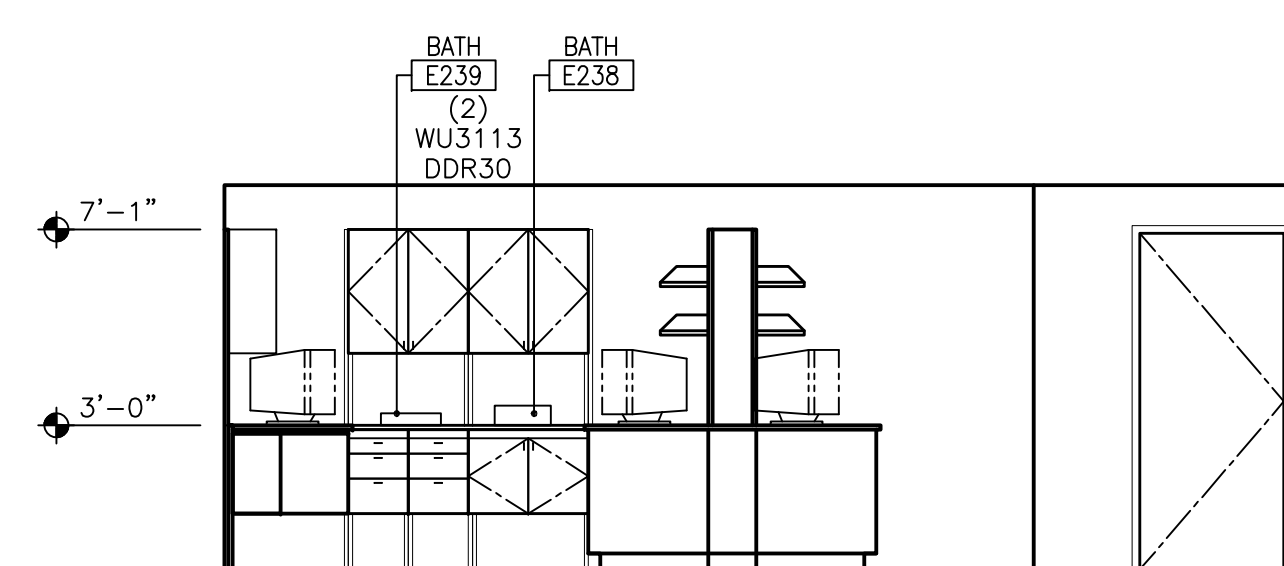

1B - SOUTH

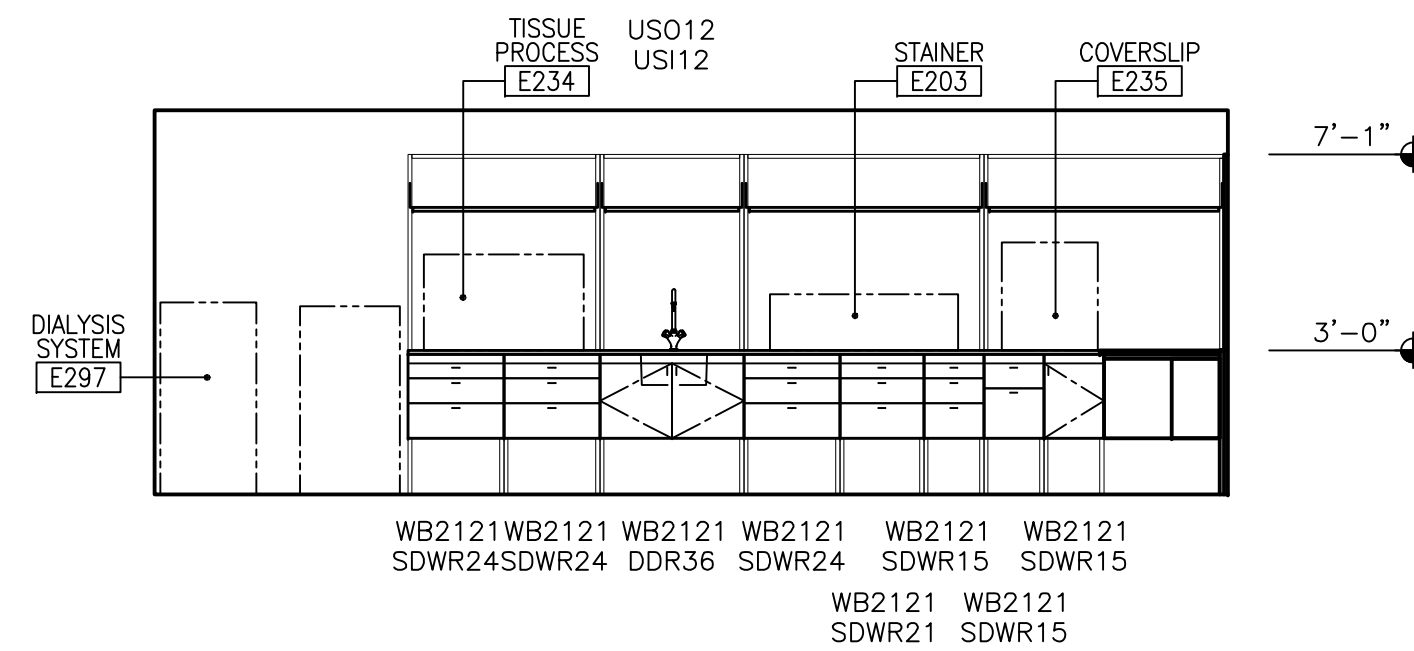


2A - NORTH

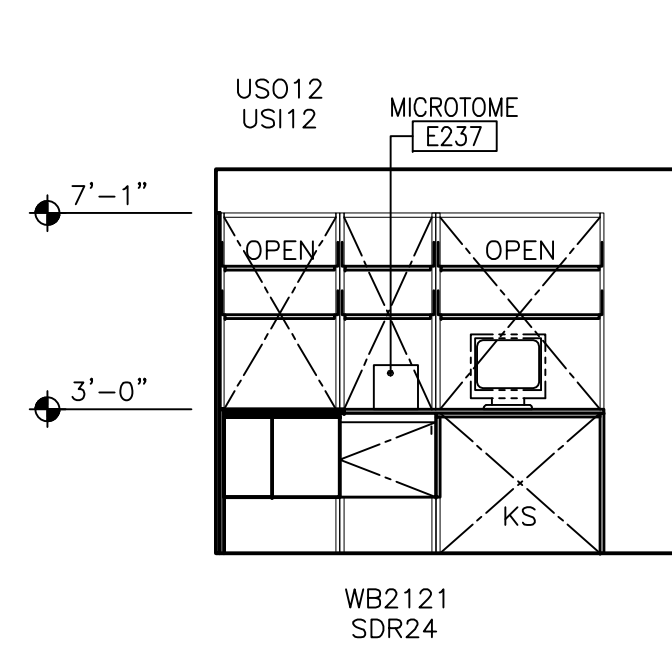


LABORATORY CASEWORK (NOTE: SUPPORT BASE AND UPPER CASEWORK WITH ISLAND CORE SYSTEM)

HISTOLOGY


SCALE: 1/4" = 1'-0"

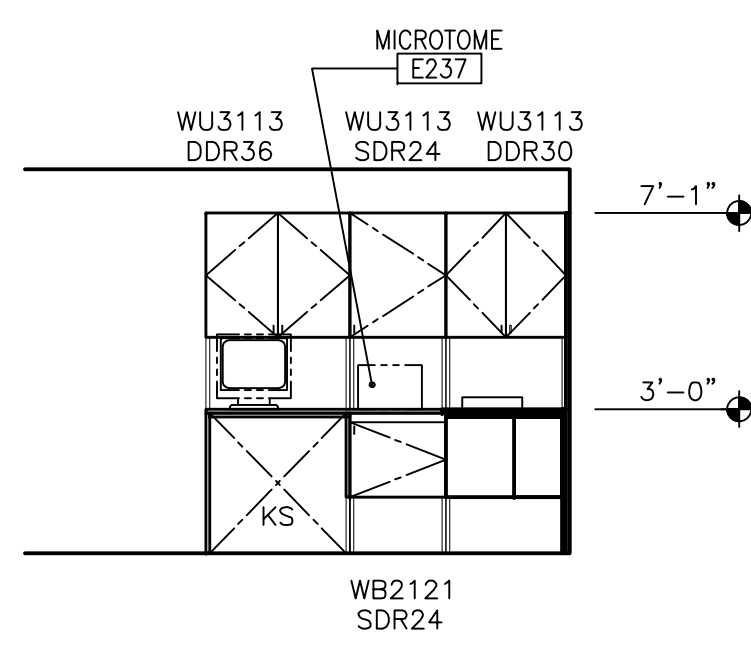


10 - EAST

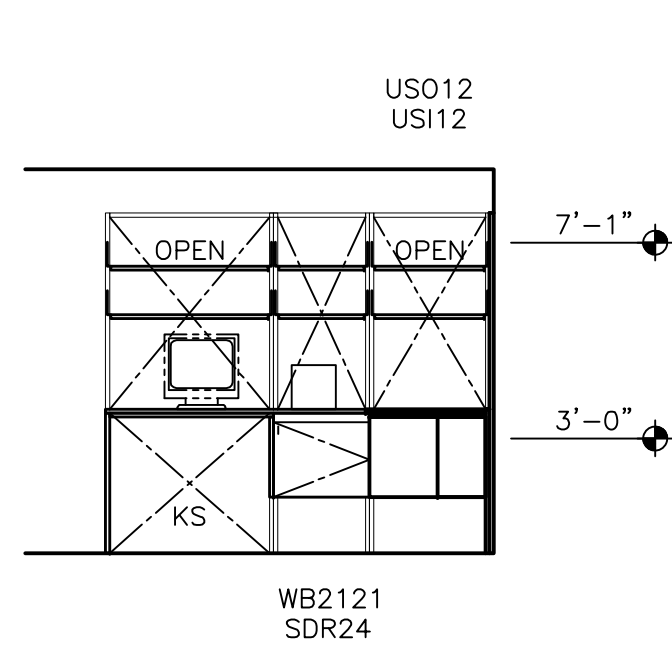

1E - EAST

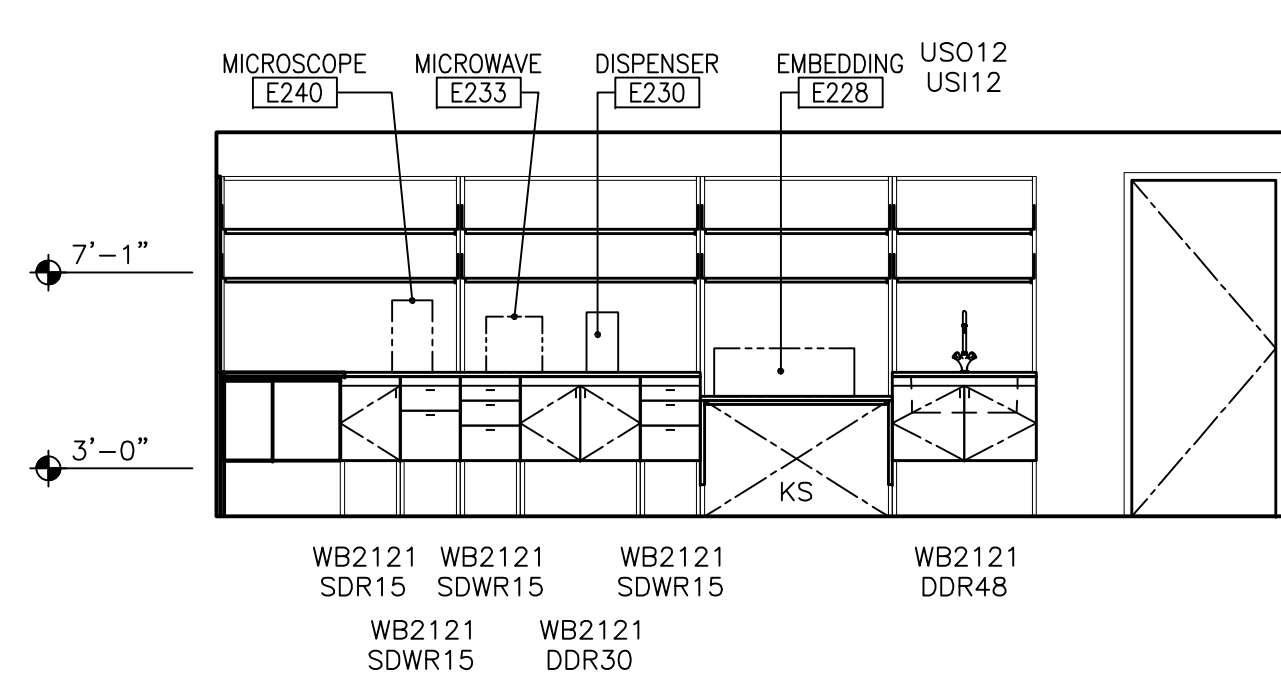

2B - SOUTH
LABORATORY CASEWORK (NOTE: SUPPORT BASE AND UPPER CASEWORK WITH
WALL RAIL SYSTEM TYP.)

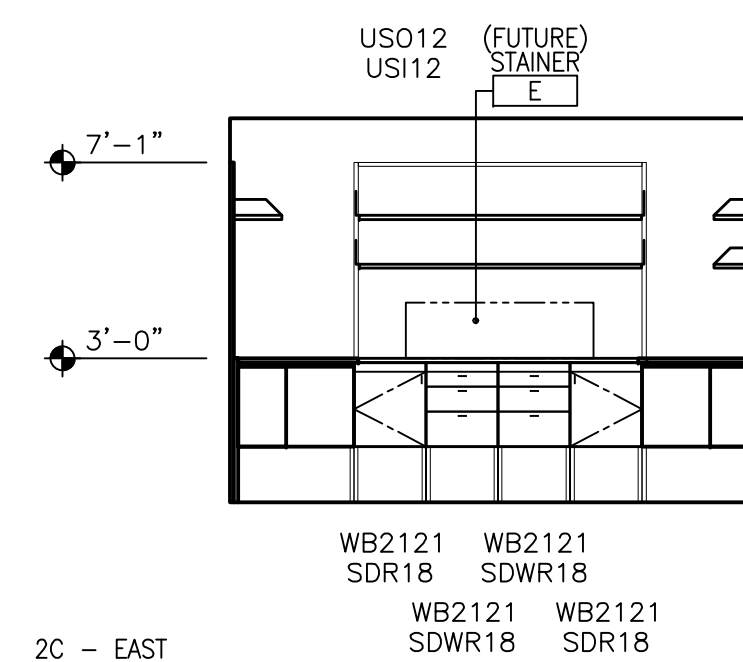


2C - EAST

STAINING


SCALE: 1/4" = 1'-0"

CLINICAL LABORATORY / DIALYSIS AREA


Revisions		Date											Design Consultant						Keyplan		Drawing Title		Project Title		Project Number		Office of Facilities Management	
			<div><div>N L A</div><div>nacht & lewis</div><div>ARCHITECTS</div><div>600 Q Street, Suite 100</div><div>Sacramento, CA 95814</div><div>(916) 329-4000 • www.nlach.com</div></div>																INTERIOR ELEVATIONS		VA/NCHCS SACRAMENTO MEDICAL CENTER MATHER, CALIFORNIA PHASE 2 - BUILDING 650 RENOVATION		612-101D					
																			Scale		Approved		Location		Building Name		Department of Veterans Affairs	
																			MILAN SRSKIC		PETER MCCUEN BLVD. MATHER, CALIFORNIA		650					
																			FULLY SPRINKLERED		Approved		Date		Checked		Drawn	
																					11/7/08							
																							753					
																							Scale					

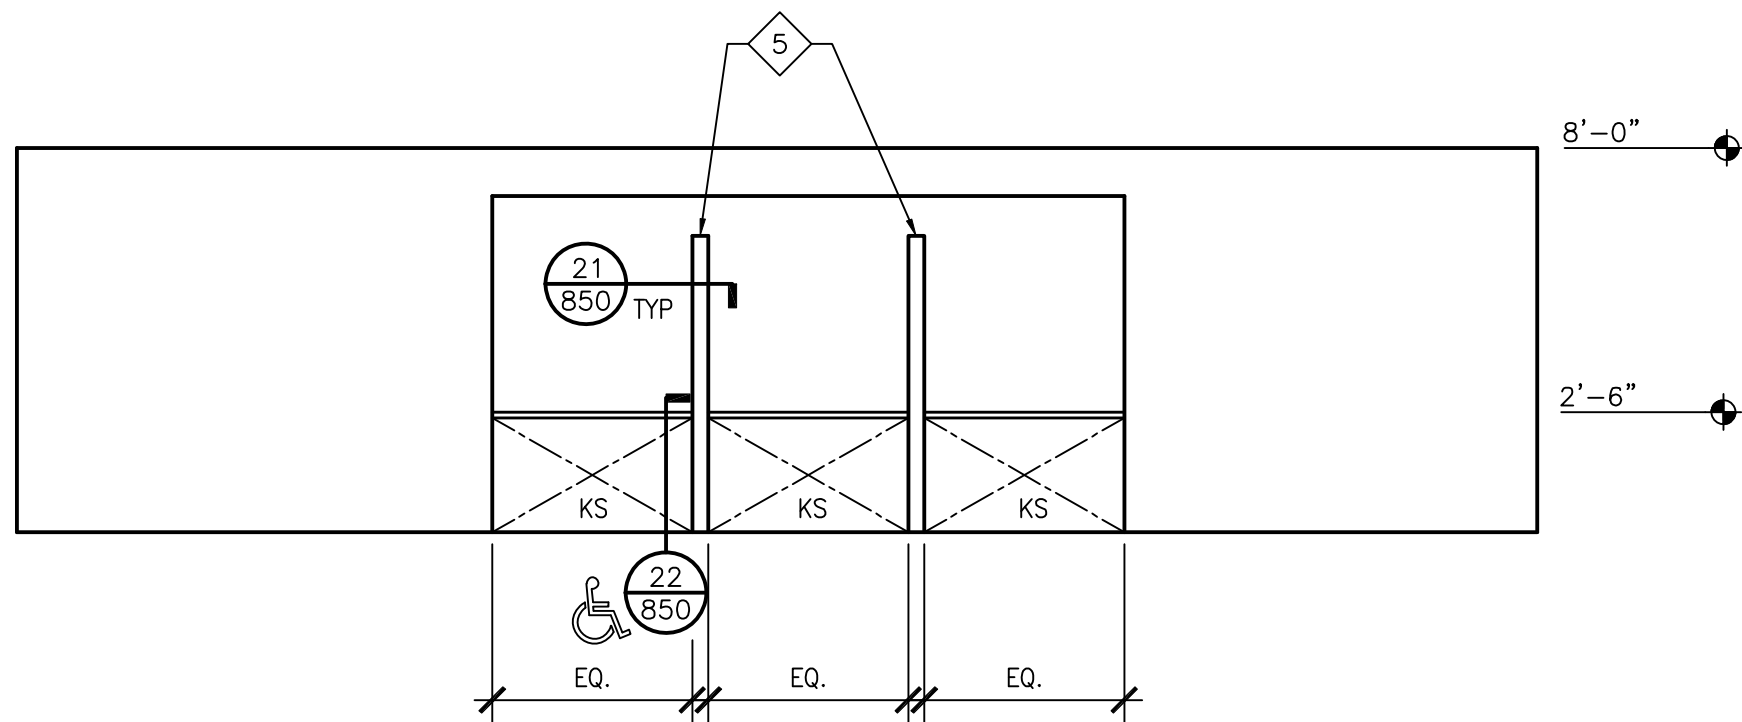

1A
WOOD CASEWORK, SEE SPECIFICATION SECTION 06400, TYP.

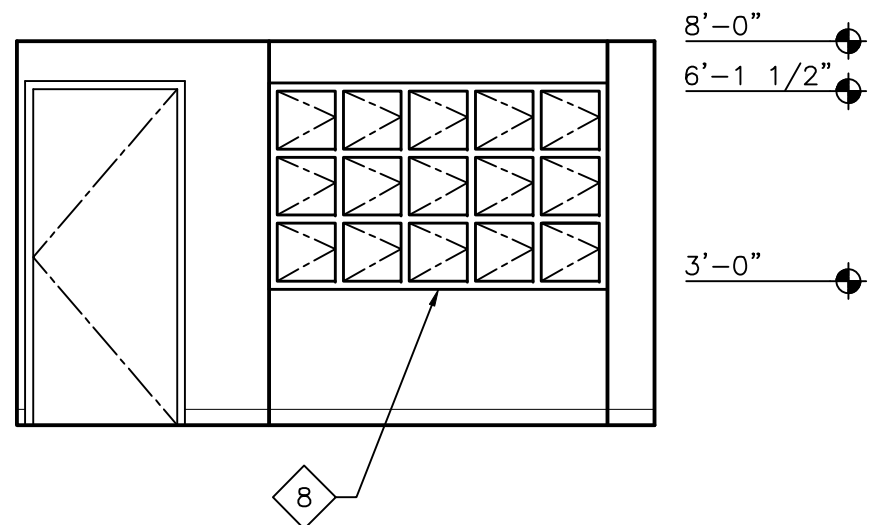


1C

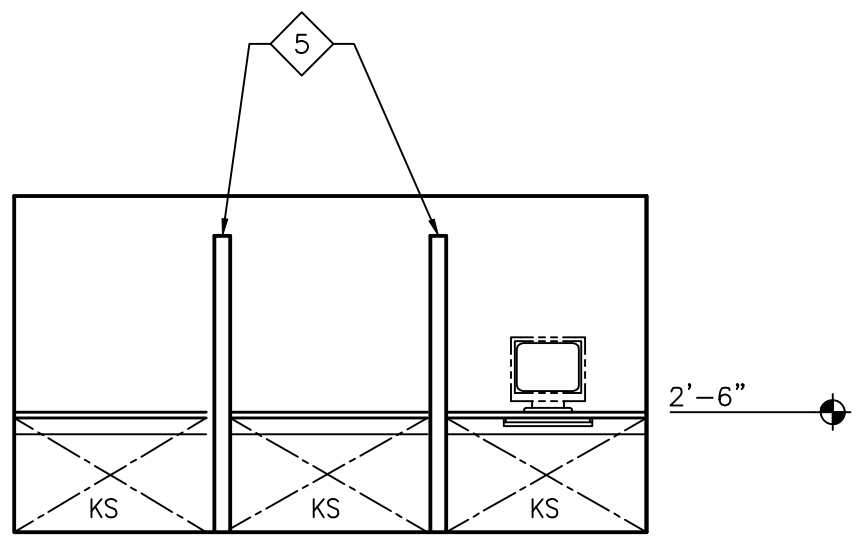

1B

1 INTAKE & PICK-UP


SCALE: 1/4" = 1'-0"

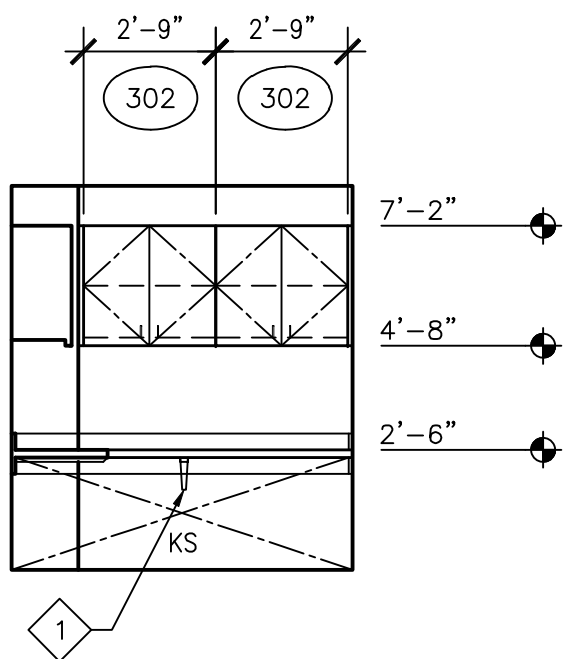


2A
WOOD CASEWORK, SEE SPECIFICATION SECTION 06400, TYP.

2 FIREARM STORAGE

SCALE: 1/4" = 1'-0"

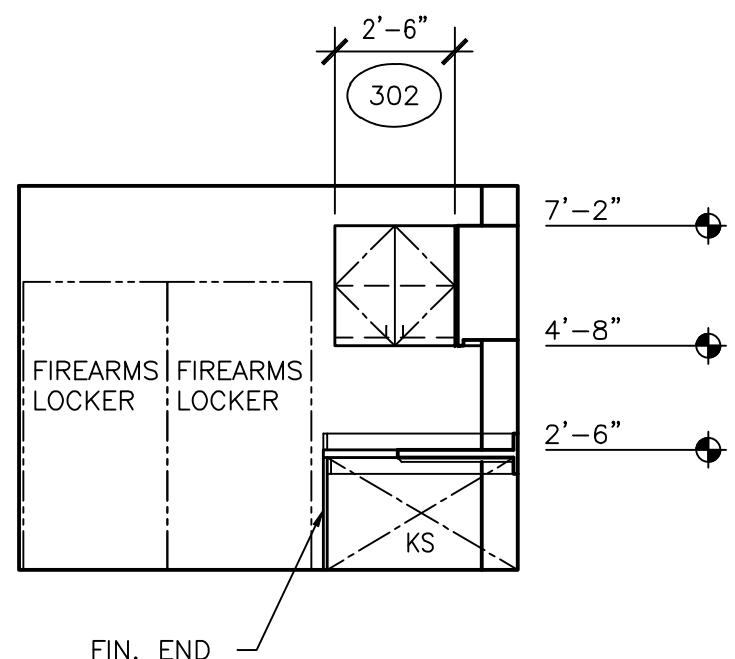

2B

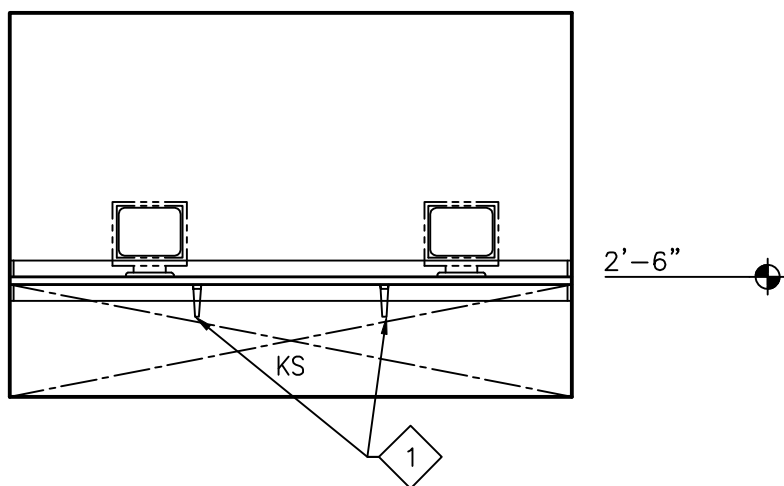


3A
WOOD CASEWORK, SEE SPECIFICATION SECTION 06400, TYP.

3 OPERATIONS

SCALE: 1/4" = 1'-0"


PHARMACY/ POLICE

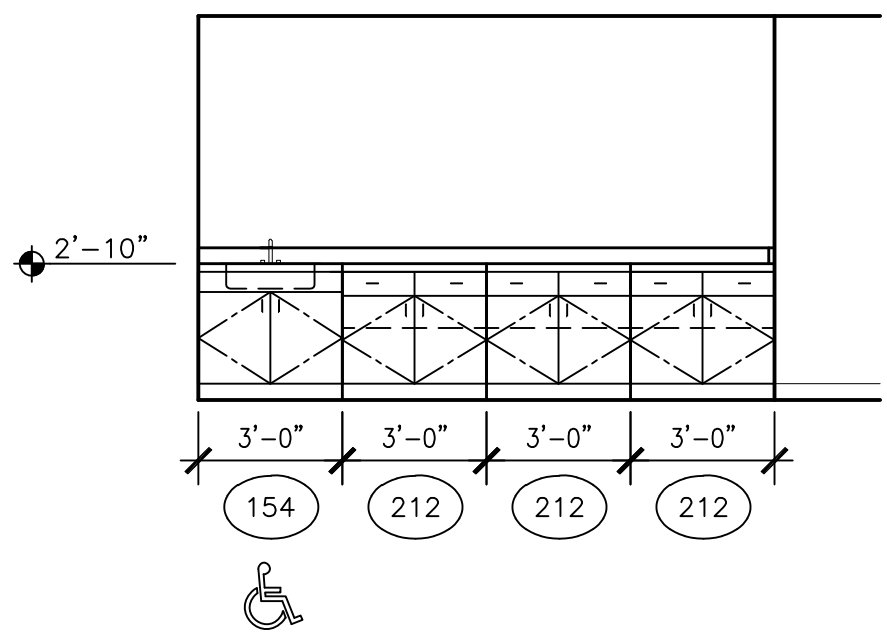

4A
WOOD CASEWORK, SEE SPECIFICATION SECTION 06400, TYP.

4 TREATMENT


SCALE: 1/4" = 1'-0"

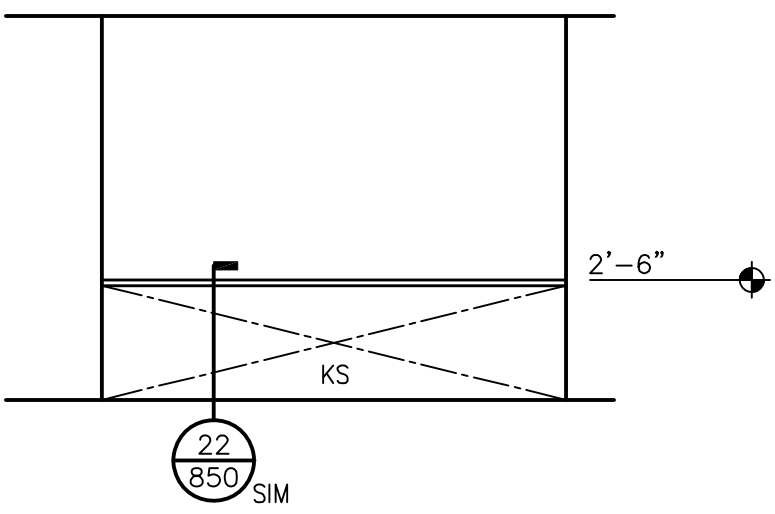

5A
WOOD CASEWORK, SEE SPECIFICATION SECTION 06400, TYP.

5 OFFICE

SCALE: 1/4" = 1'-0"

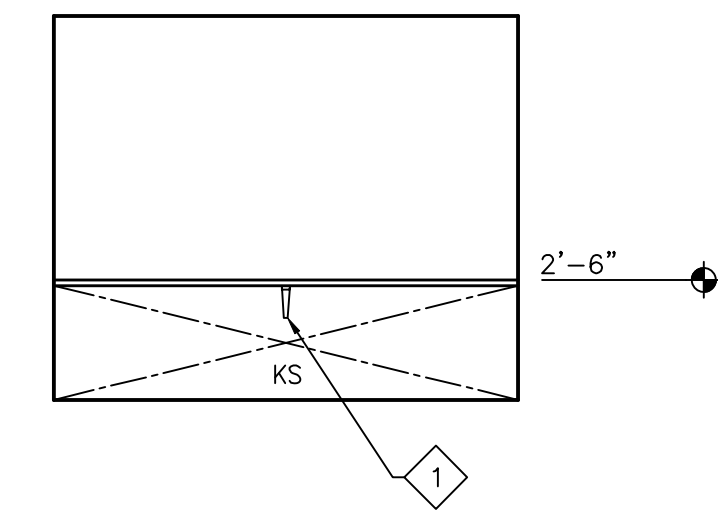

5B

CASEWORK GENERAL NOTES:

THESE NOTES APPLY TO ALL INTERIOR ELEVATIONS U.O.N.

1. WIC NUMBERS ARE SHOWN FOR REFERENCE ((100) WIC IDENTIFICATION) 24" DEEP U.O.N.
2. SEE SPECIFICATION SECTION 06400 FOR WOOD CASEWORK & SECTION 12346 FOR LABORATORY CASEWORK. COUNTERTOPS FOR WOOD CASEWORK ARE TYPICALLY P-LAM, U.O.N. COUNTERTOPS FOR LABORATORY CASEWORK ARE TYPICALLY EPOXY RESIN, U.O.N.
3. BACKSPASHES ARE 4" H., U.O.N.
4. SEE DETAILS 1, 2 & 3/850 FOR ANCHORAGE
5. SEE DETAIL 4/850 FOR COUNTERTOP SUPPORT ARM
6. PROVIDE LOCKS FOR ALL DOORS AND DRAWERS. PROVIDE ELBOW CATCHES AS REQUIRED.
7. PROVIDE CANTILEVER TABLES AT LABORATORY CASEWORK, TYP U.O.N.

KEYNOTES:

- 1 COUNTERTOP SUPPORT ARM, SEE 4/850
- 2 SERVICE COLUMN
- 3 DIVIDER INSERT PANEL WITH FABRIC-COVERED ACOUSTICAL FACING INSERT
- 4 EYE WASH/SHOWER
- 5 ACOUSTIC FABRIC COVER PARTITION, SEE DTL. 21/850
- 6 UNDERCOUNTER LIGHT, SEE ELECT DWGS.
- 7 MOBILE CART
- 8 PACKAGE RECEIVER (V-V), COORDINATE FRAMING REQUIREMENT

NUCLEAR MEDICINE

Revisions	Date



Design Consultant

Keyplan

Drawing Title

INTERIOR ELEVATIONS

Scale

Approved

MILAN SRSKIC

Approved

Project Title

VA/MCHCS
SACRAMENTO MEDICAL CENTER
MATHER, CALIFORNIA
PHASE 2 - BUILDING 650 RENOVATION

Location

PETER MCCUEN BLVD.
MATHER, CALIFORNIA

Date

11/7/08

Checked

Drawn

Project Number

612-1010

Building Name

650

Drawing Number

754

Scale


RECORD SET

Office of
Facilities
Management



Department of
Veterans Affairs


FULLY SPRINKLERED

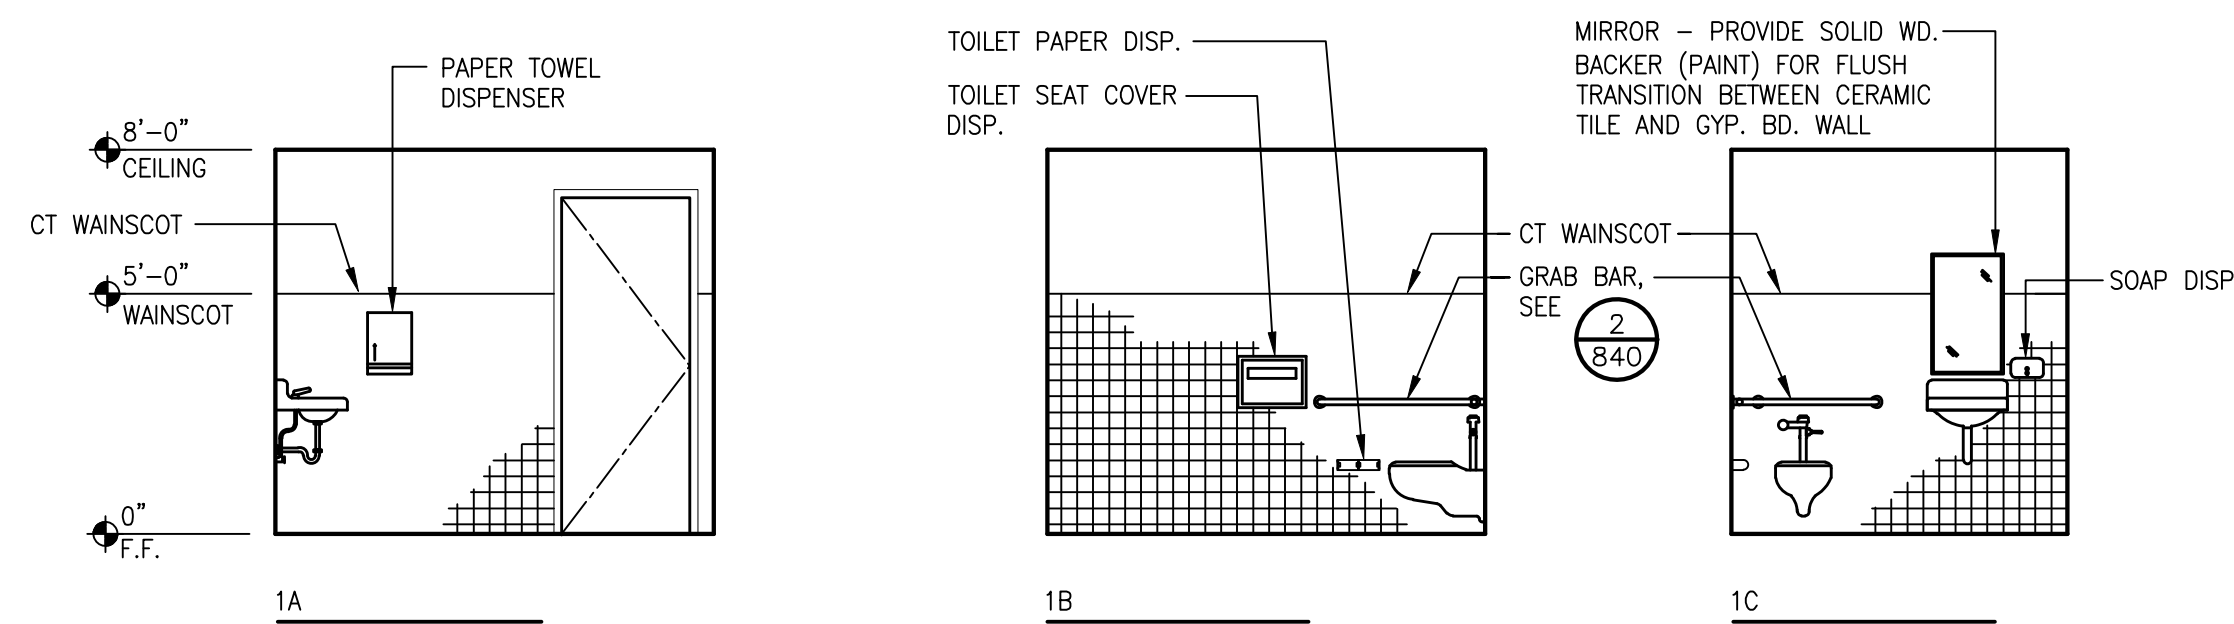

1 TOILET (1D515)

SCALE: 1/4" = 1'-0"


NOTE: SEE SHEET 15/840 FOR MOUNTING HEIGHTS OF TOILET ACCESSORIES. SEE SHEET A700 FOR REQUIRED ACCESSIBILITY REQUIREMENTS

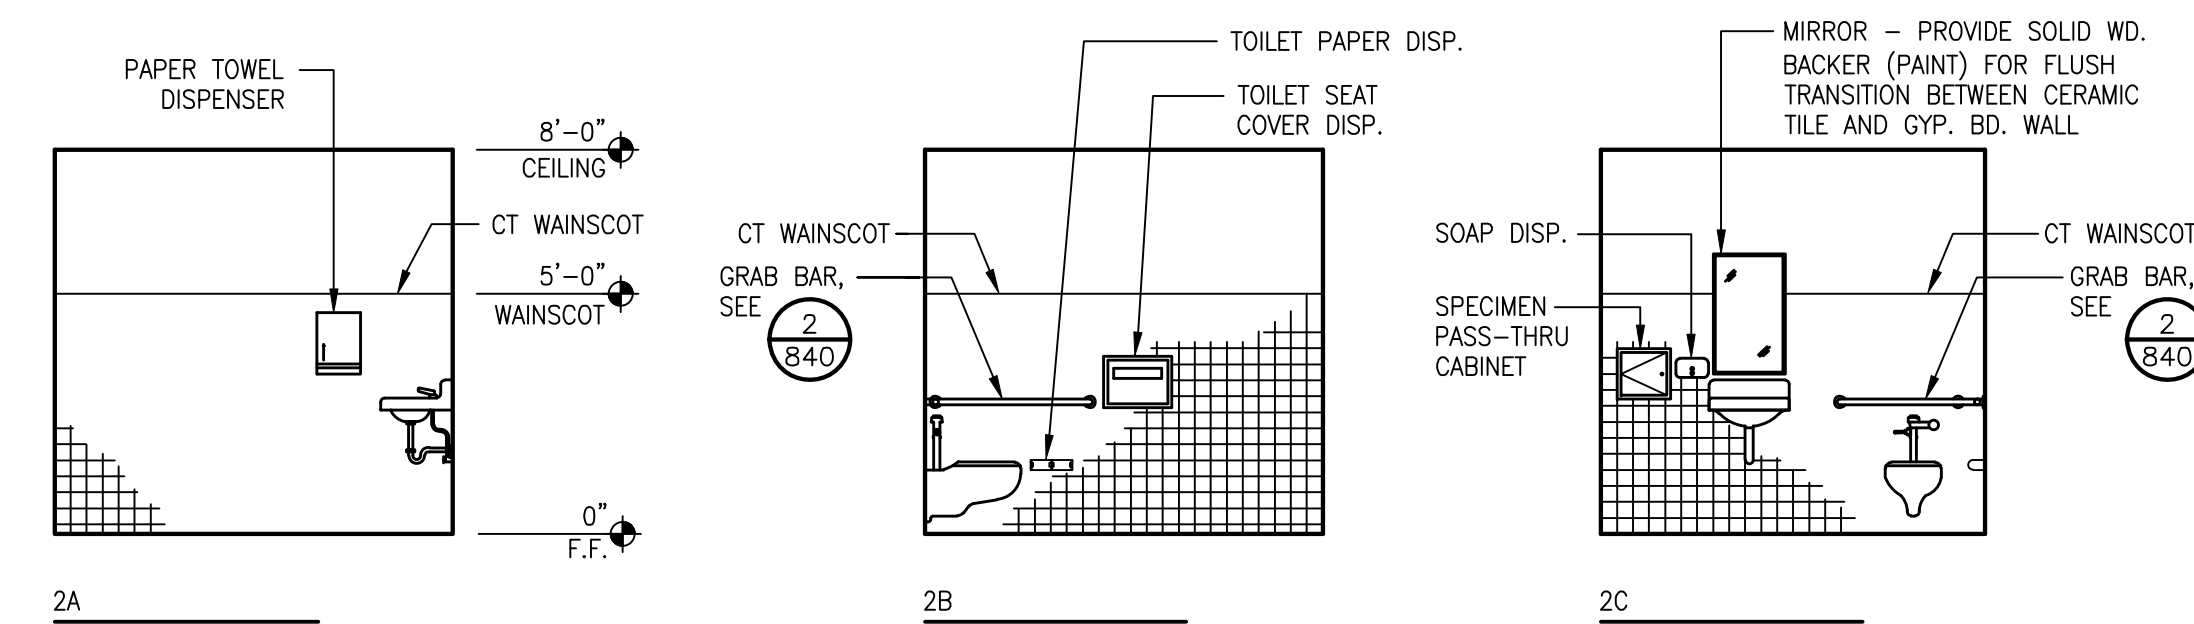

2 TOILET (1D507)

SCALE: 1/4" = 1'-0"


NOTE: SEE SHEET 15/840 FOR MOUNTING HEIGHTS OF TOILET ACCESSORIES. SEE SHEET A700 FOR REQUIRED ACCESSIBILITY REQUIREMENTS

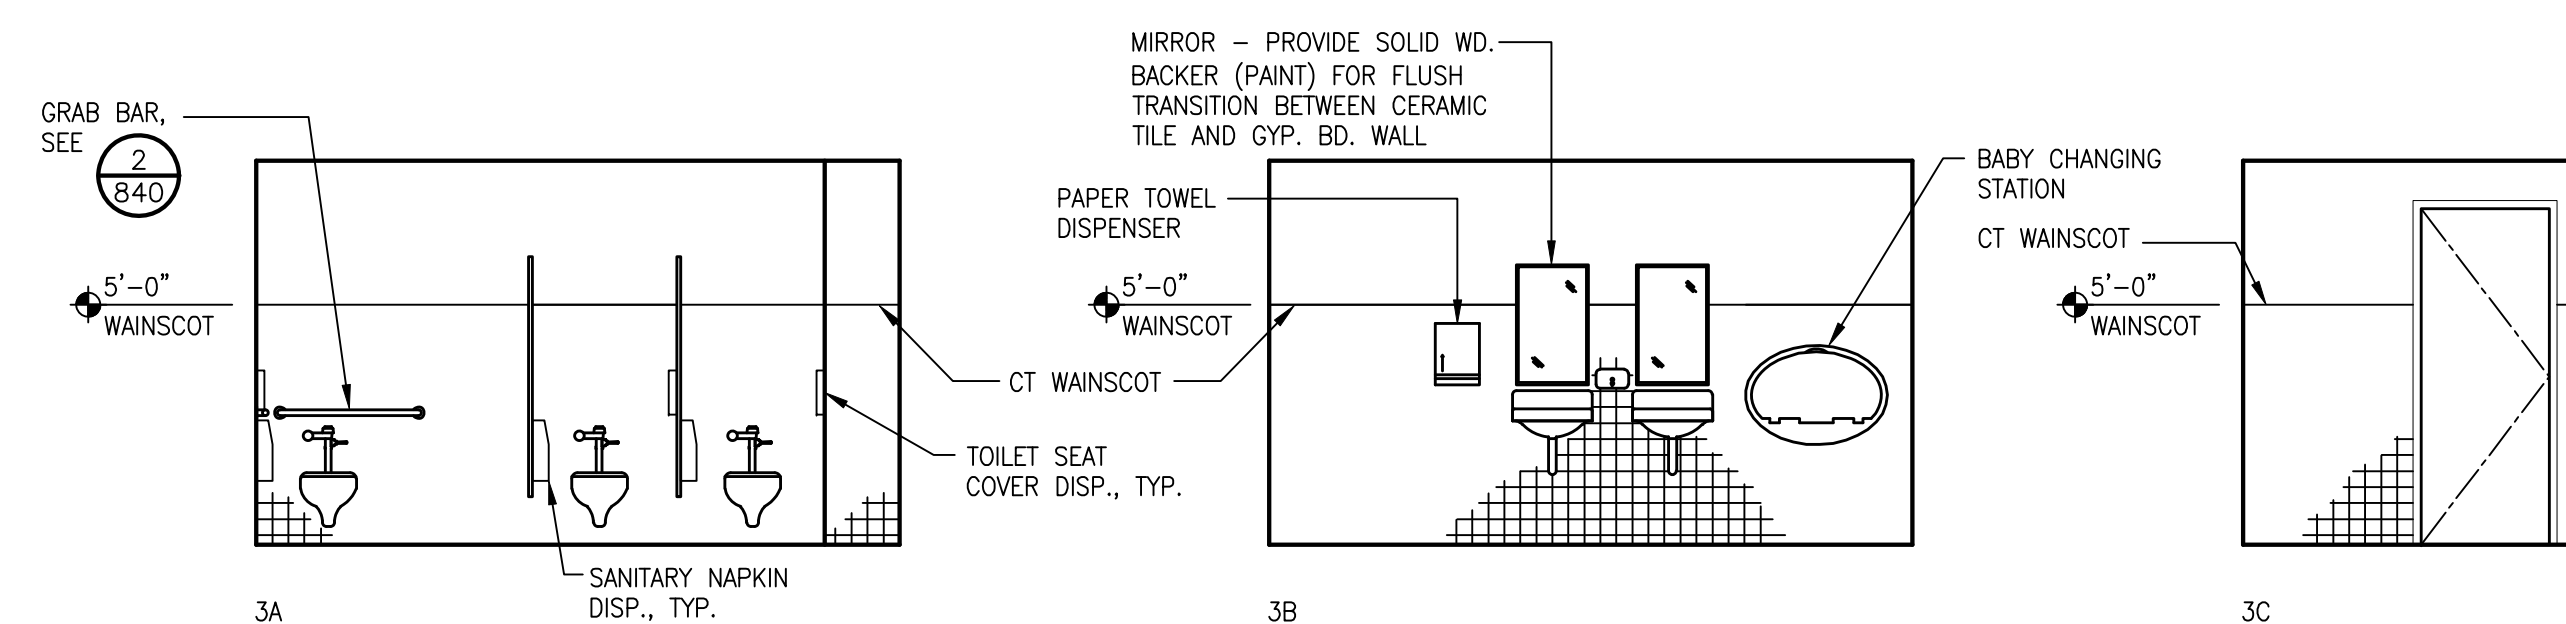

3 WOMEN'S TOILET @ CANTEEN (1E002)

SCALE: 1/4" = 1'-0"


NOTE: SEE SHEET 15/840 FOR MOUNTING HEIGHTS OF TOILET ACCESSORIES. SEE SHEET A700 FOR REQUIRED ACCESSIBILITY REQUIREMENTS

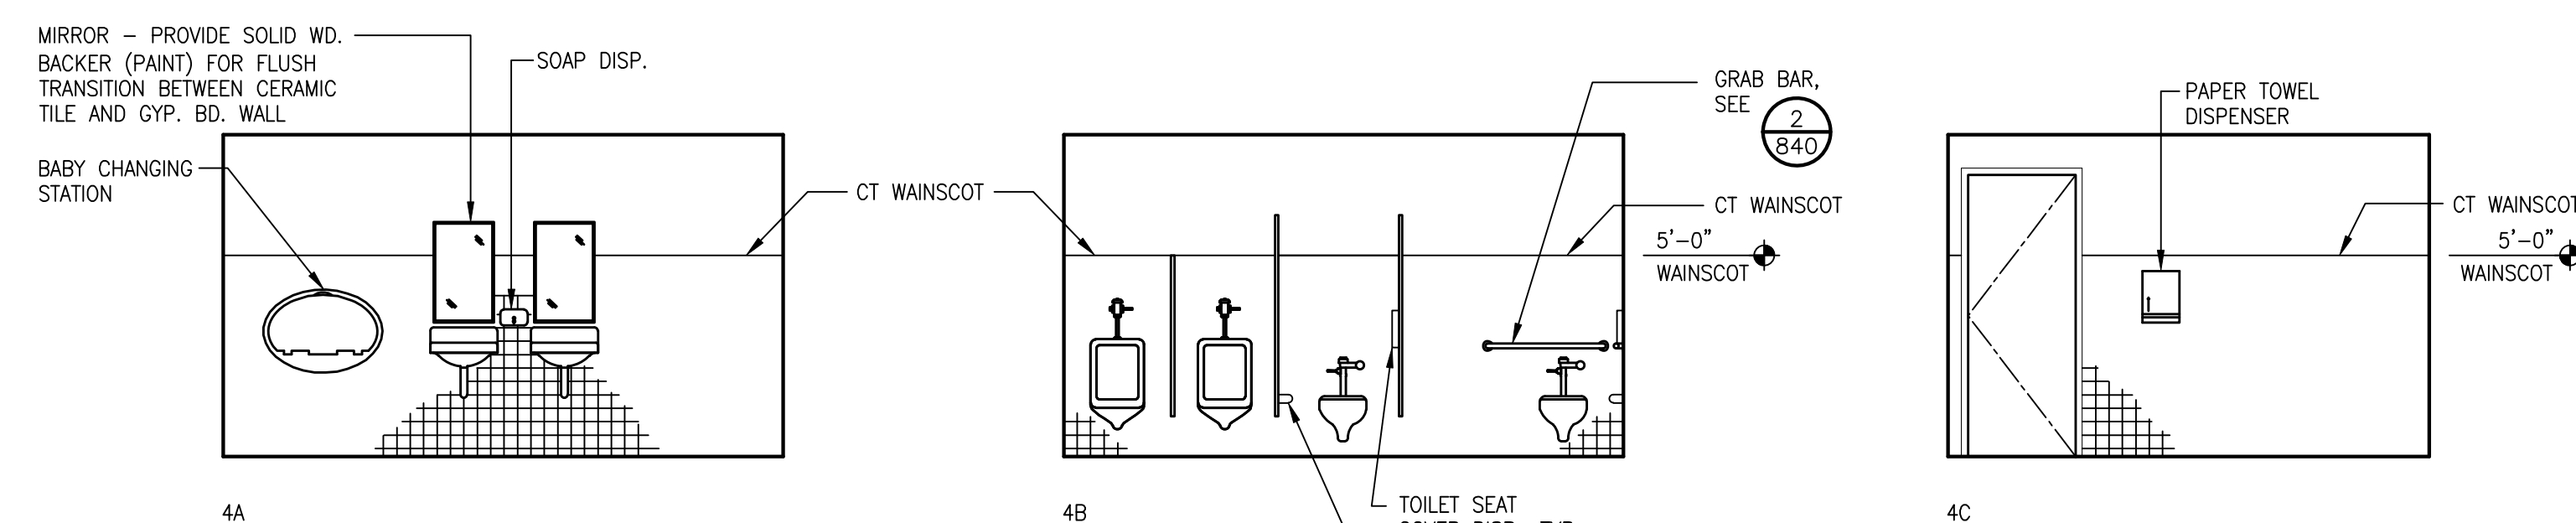

4 MEN'S TOILET @ CANTEEN (1E005)

SCALE: 1/4" = 1'-0"



NOTE: SEE SHEET 15/840 FOR MOUNTING HEIGHTS OF TOILET ACCESSORIES. SEE SHEET A700 FOR REQUIRED ACCESSIBILITY REQUIREMENTS

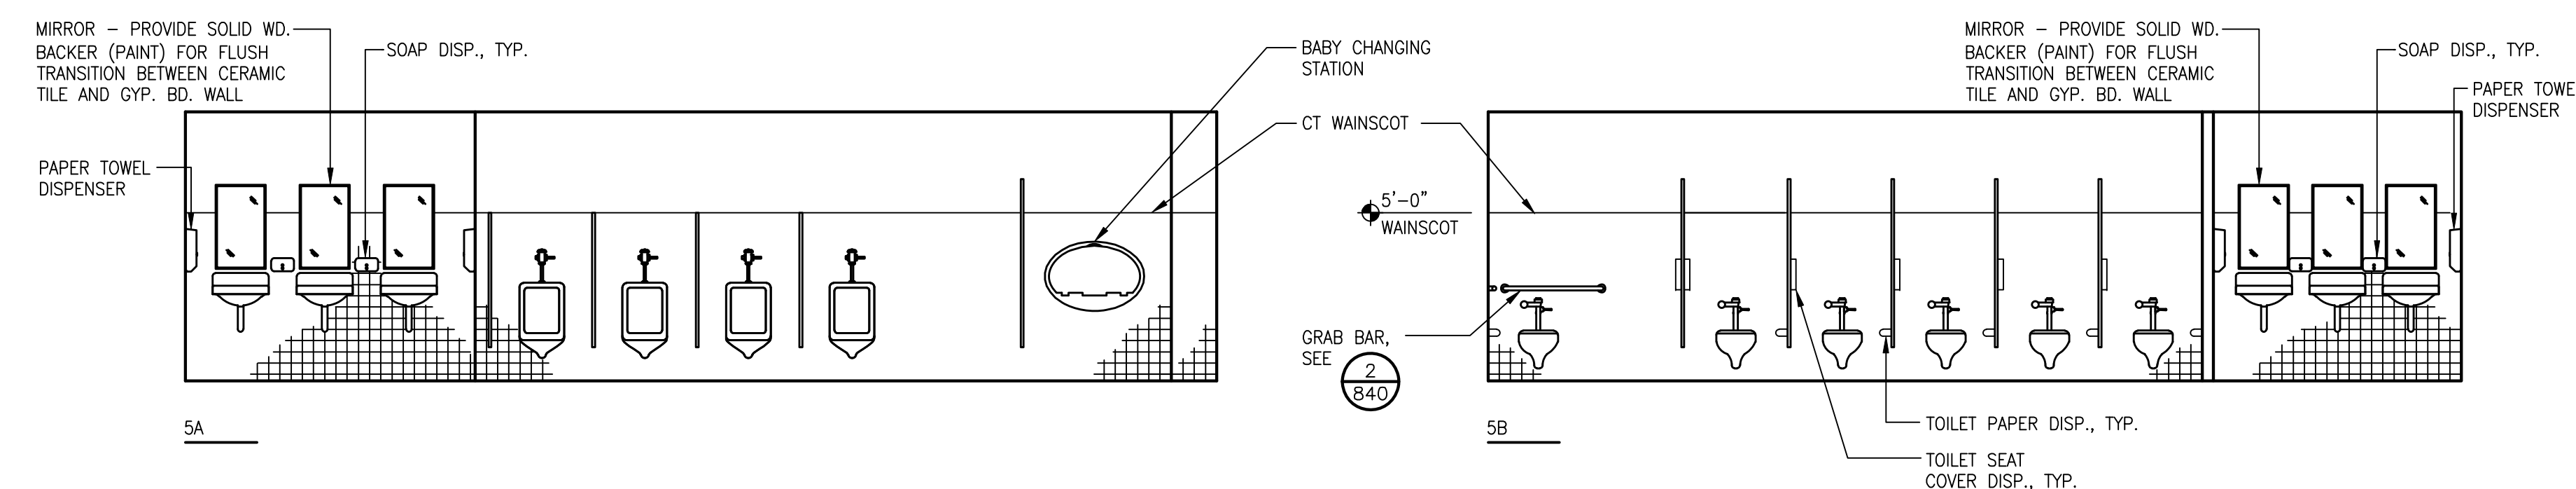

5 MEN'S TOILET (1B006)

SCALE: 1/4" = 1'-0"



NOTE: SEE SHEET 15/840 FOR MOUNTING HEIGHTS OF TOILET ACCESSORIES. SEE SHEET A700 FOR REQUIRED ACCESSIBILITY REQUIREMENTS

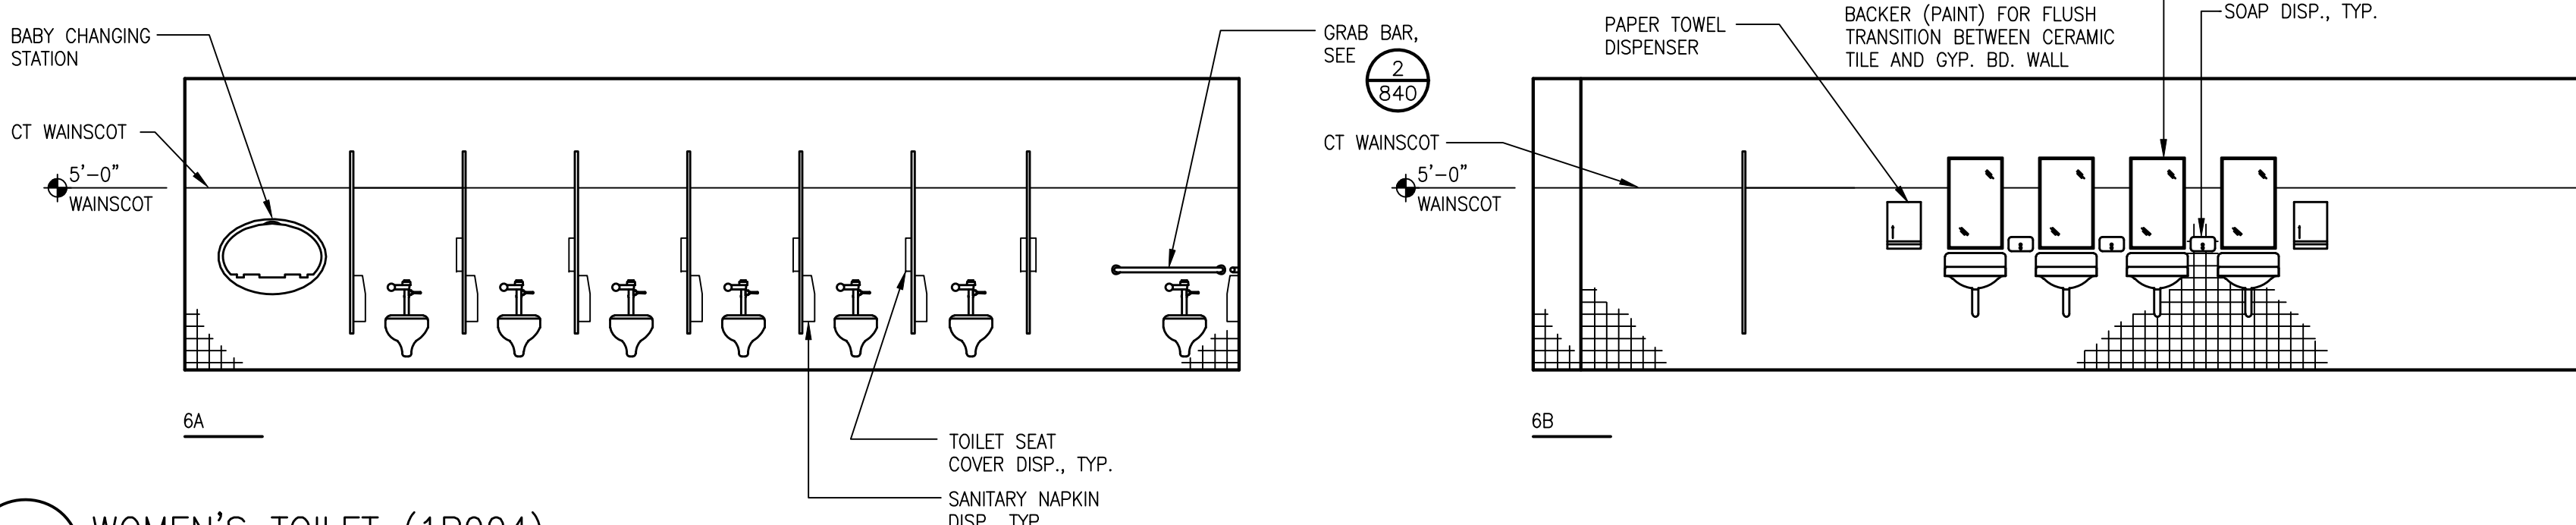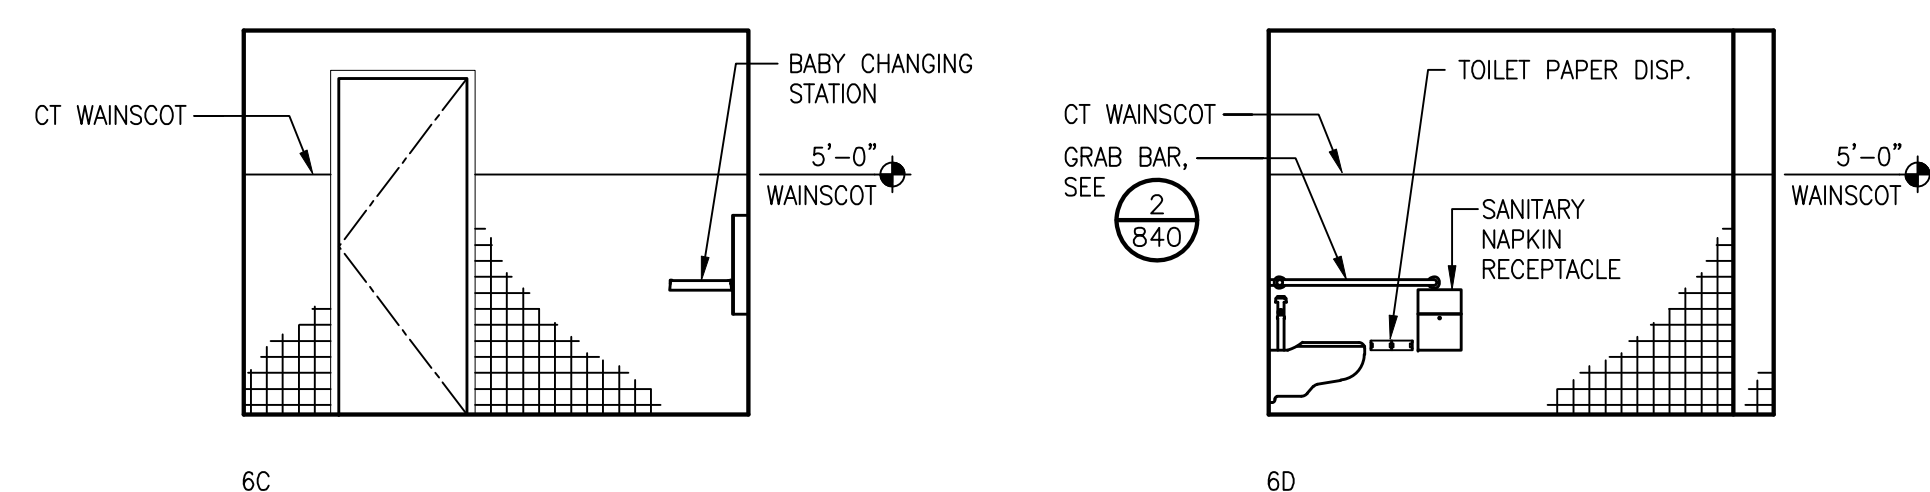

6 WOMEN'S TOILET (1B004)

SCALE: 1/4" = 1'-0"

NOTE: SEE SHEET 15/840 FOR MOUNTING HEIGHTS OF TOILET ACCESSORIES. SEE SHEET A700 FOR REQUIRED ACCESSIBILITY REQUIREMENTS

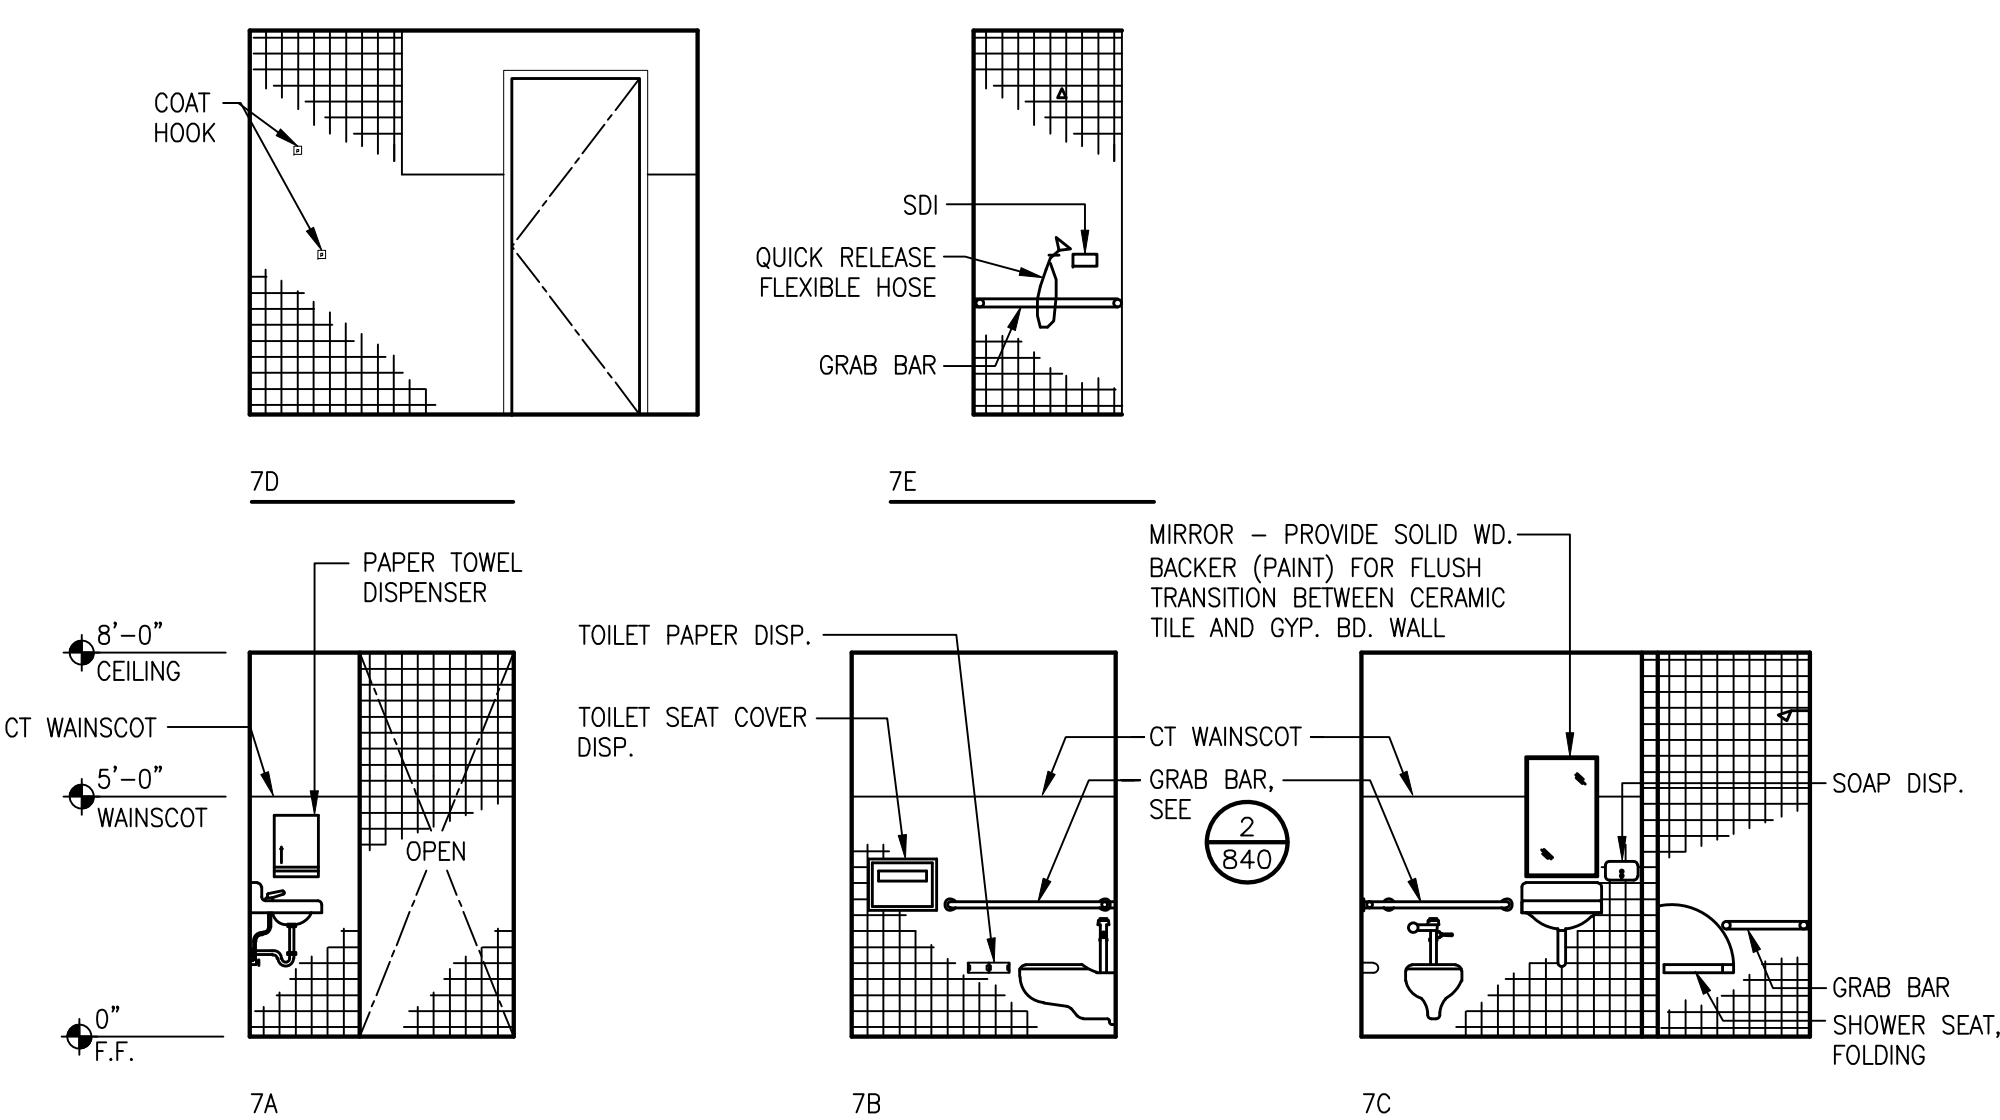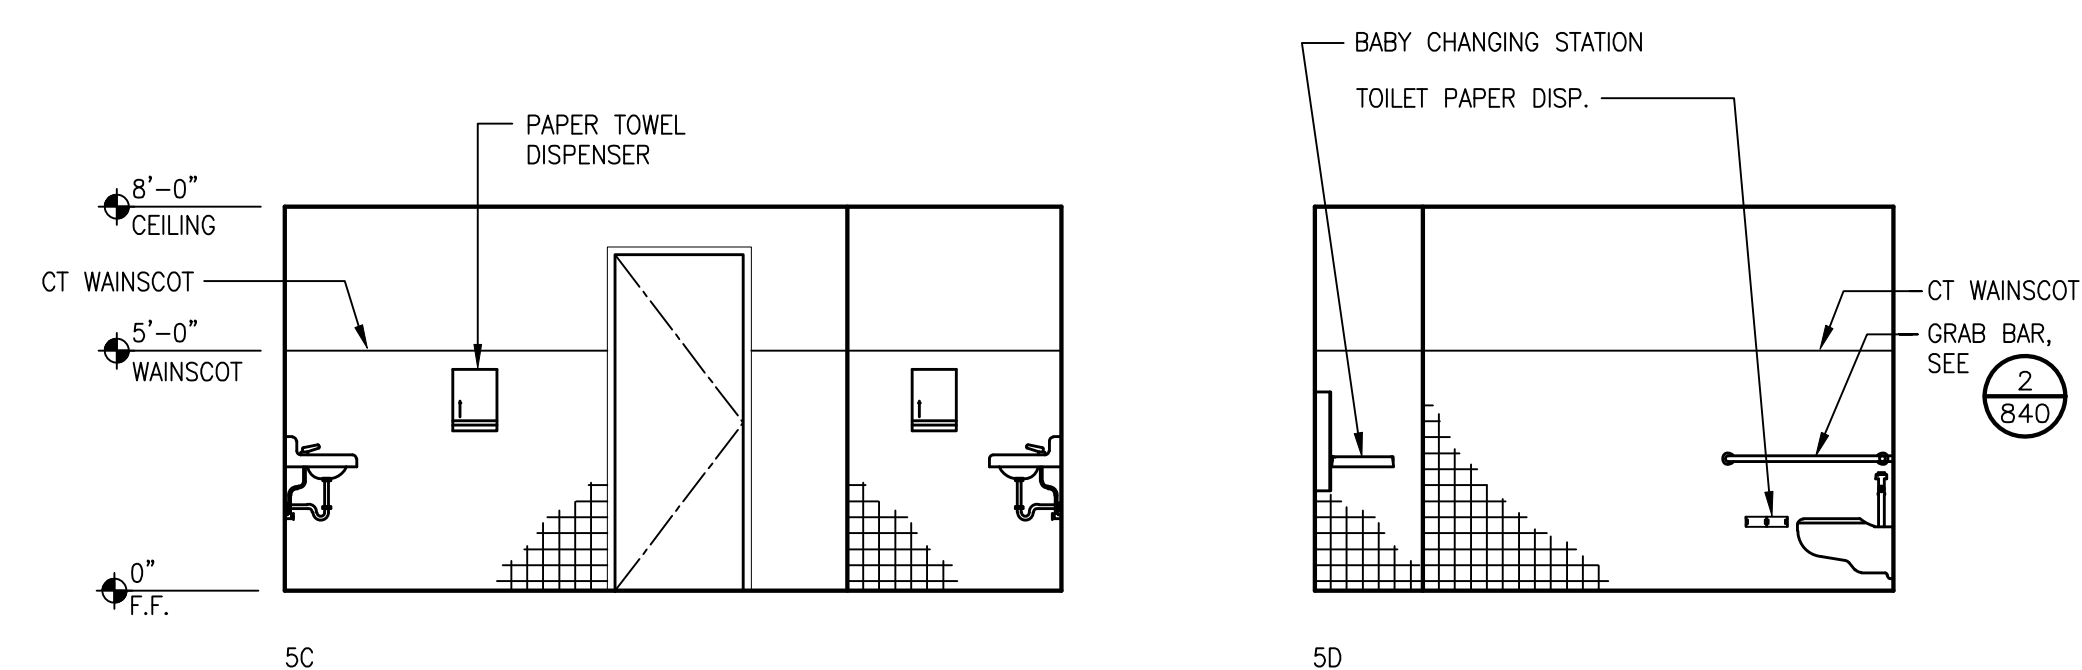

7 TYPICAL TOILET /SHOWER ROOM (1E260A & 1E260B)

SCALE: 1/4" = 1'-0"

NOTE: SEE SHEET 15/840 FOR MOUNTING HEIGHTS OF TOILET ACCESSORIES. SEE SHEET A700 FOR REQUIRED ACCESSIBILITY REQUIREMENTS




















Revisions	Date	Design Consultant	Keyplan	Drawing Title	Project Title	Project Number	Building Name	Drawing Number	Scale
				INTERIOR ELEVATIONS	VA/MCHCS SACRAMENTO MEDICAL CENTER MATHER, CALIFORNIA PHASE 2 - BUILDING 650 RENOVATION	612-1010	650	755	
				FULLY SPRINKLERED					
					Location PETER McCUEN BLVD. MATHER, CALIFORNIA				
					Date 11/7/08				
					Checked				
					Drawn				



RECORD SET

Office of
Facilities
Management

Department of
Veterans Affairs

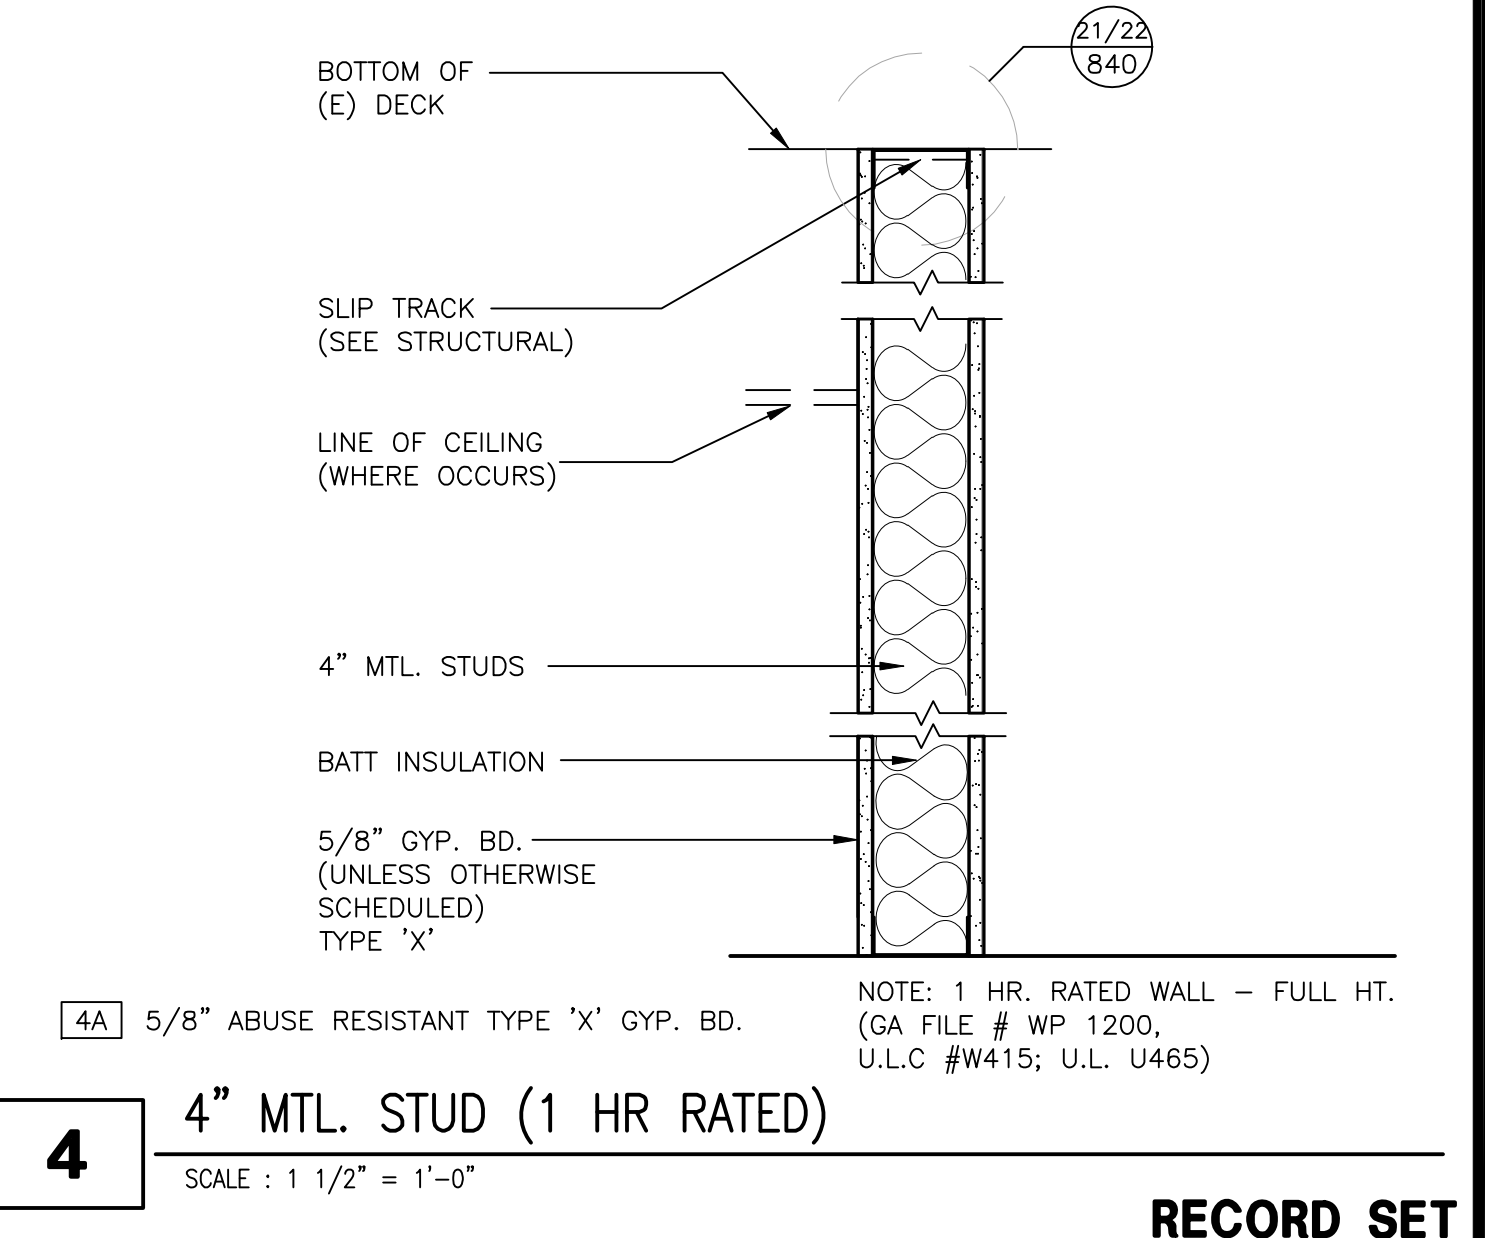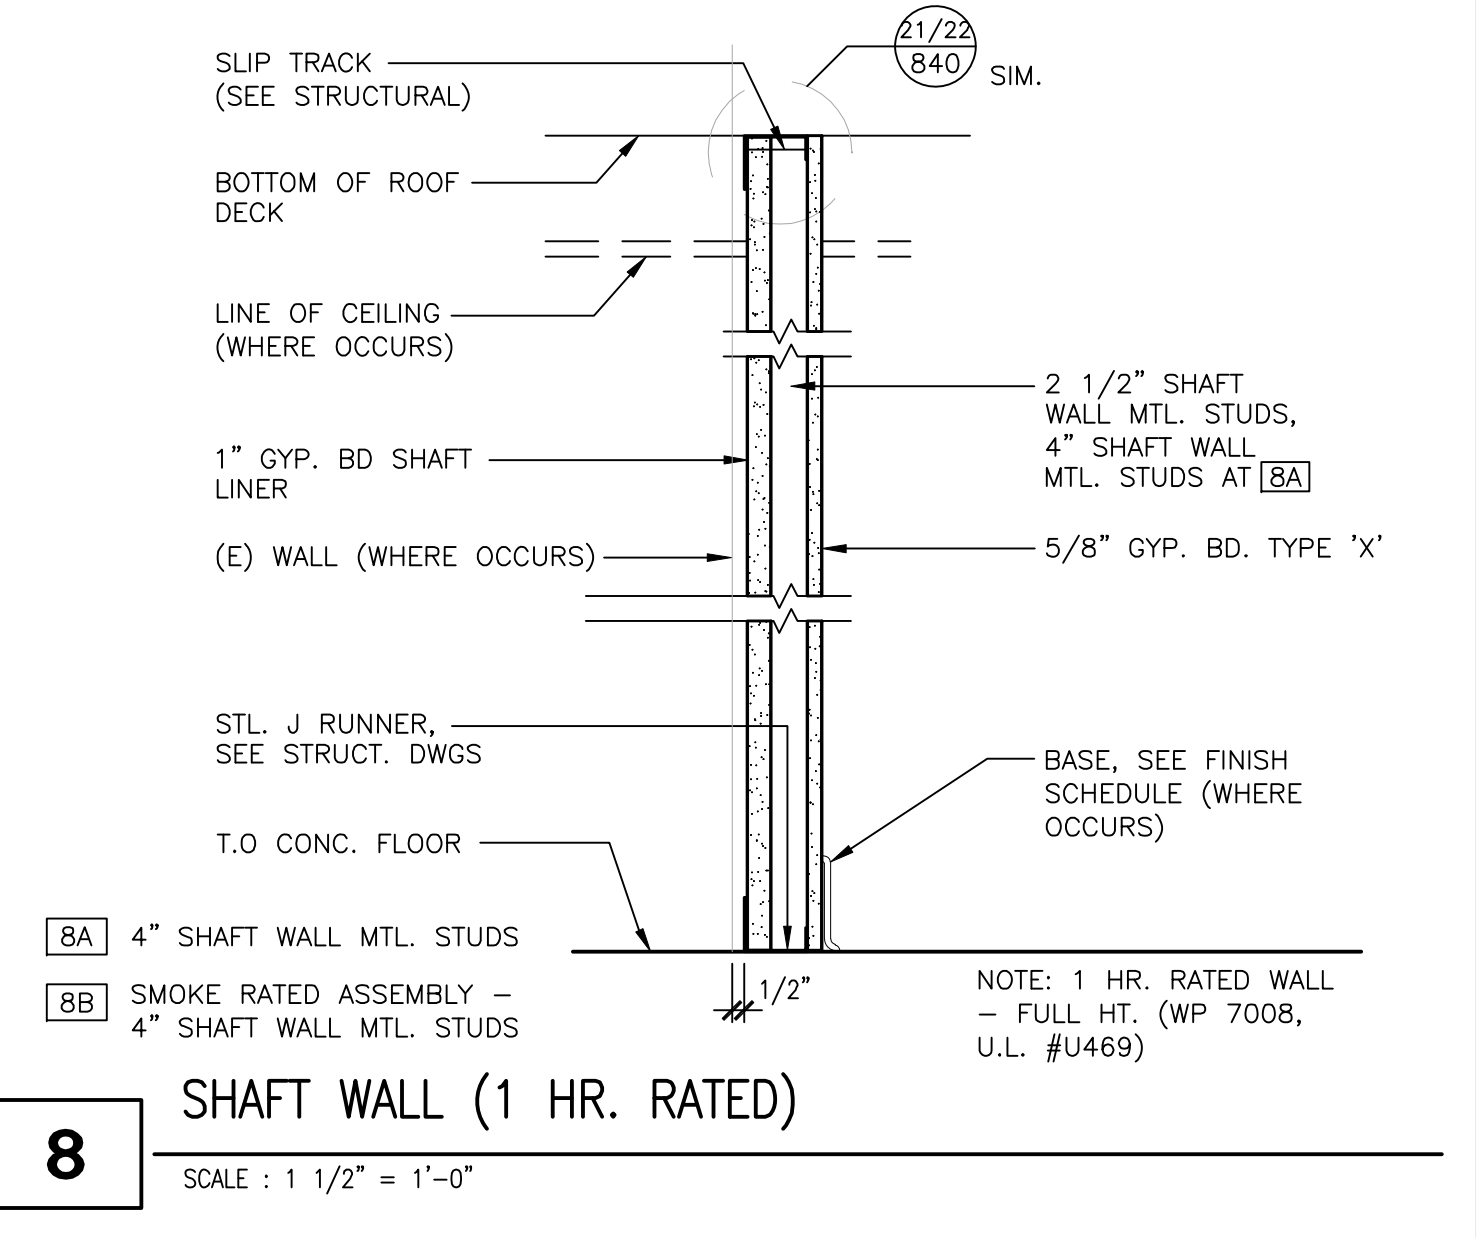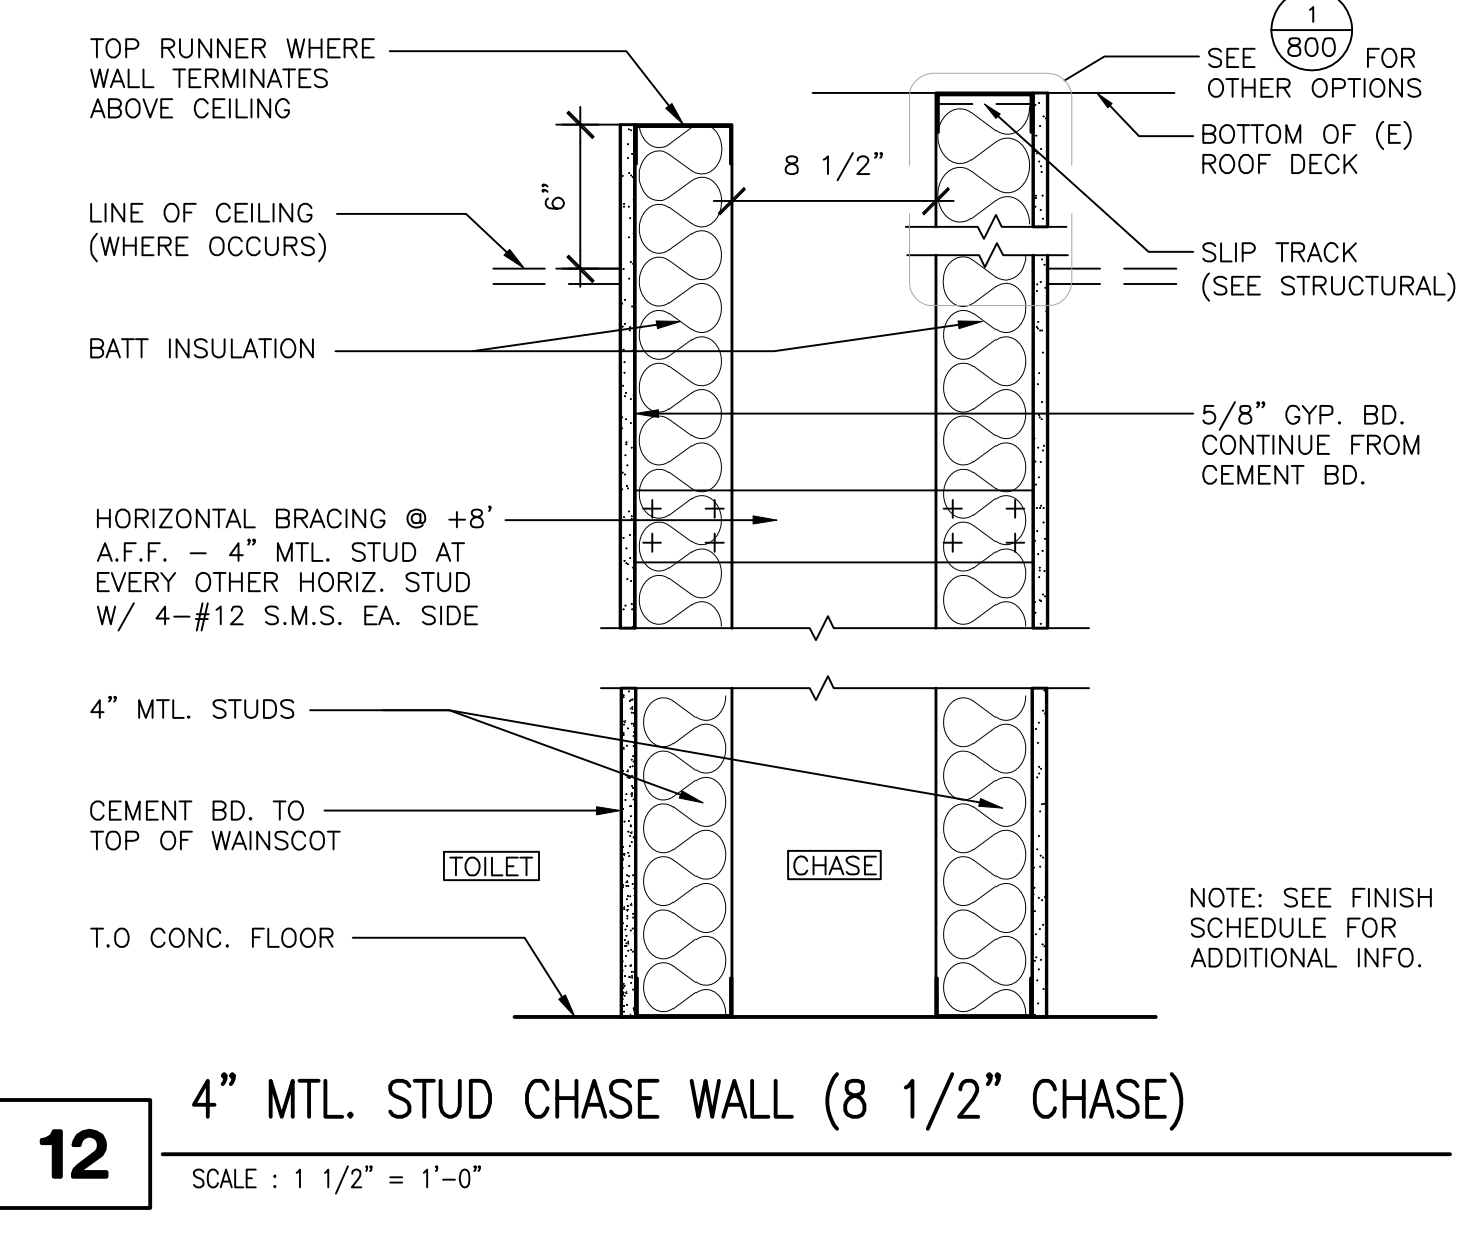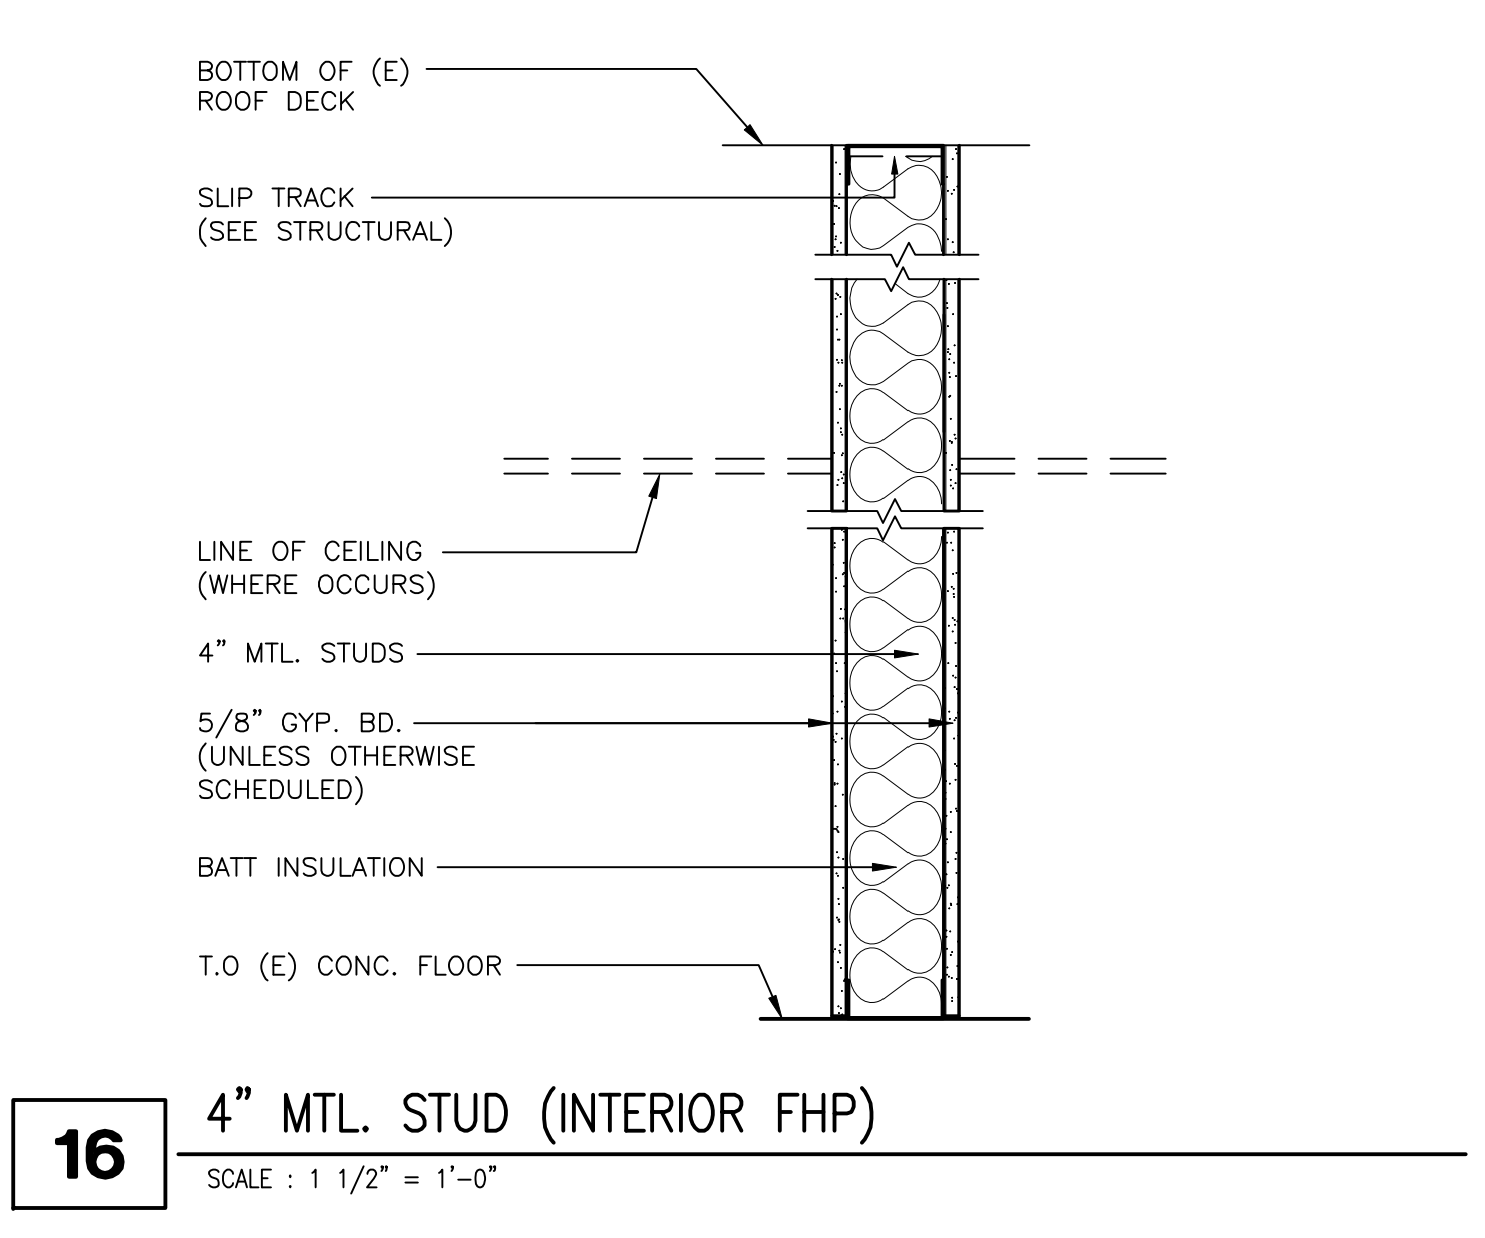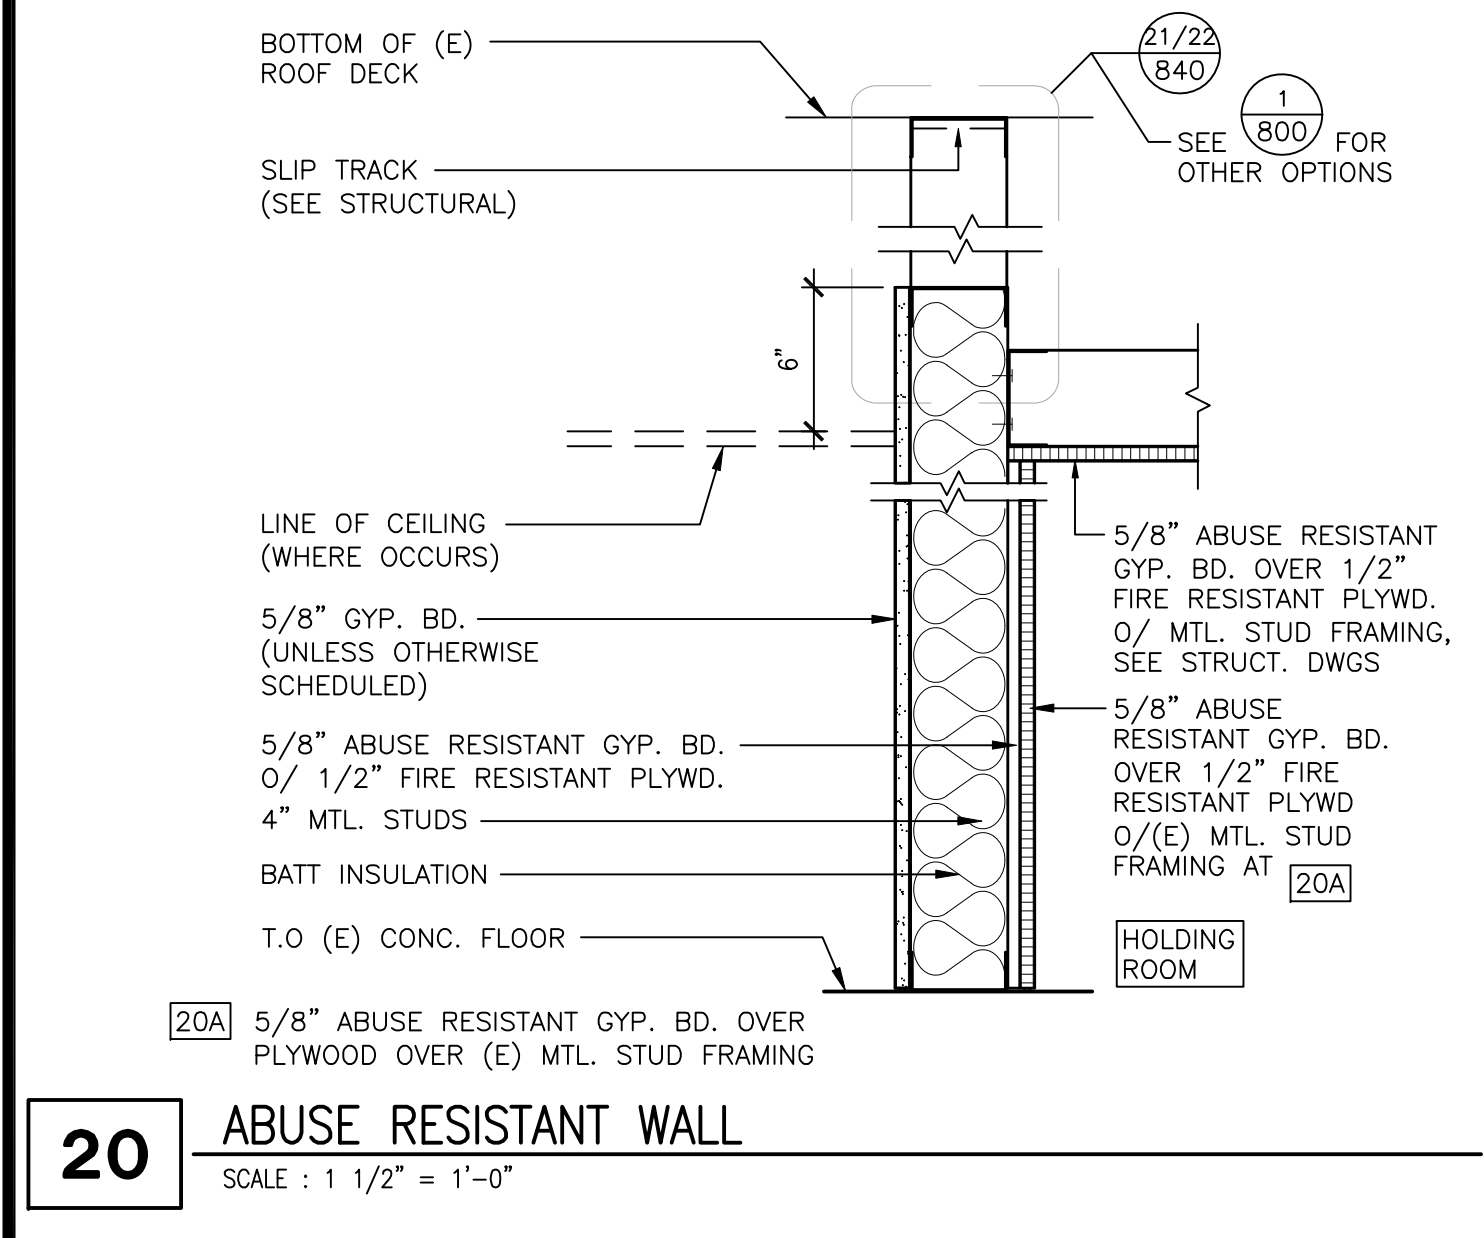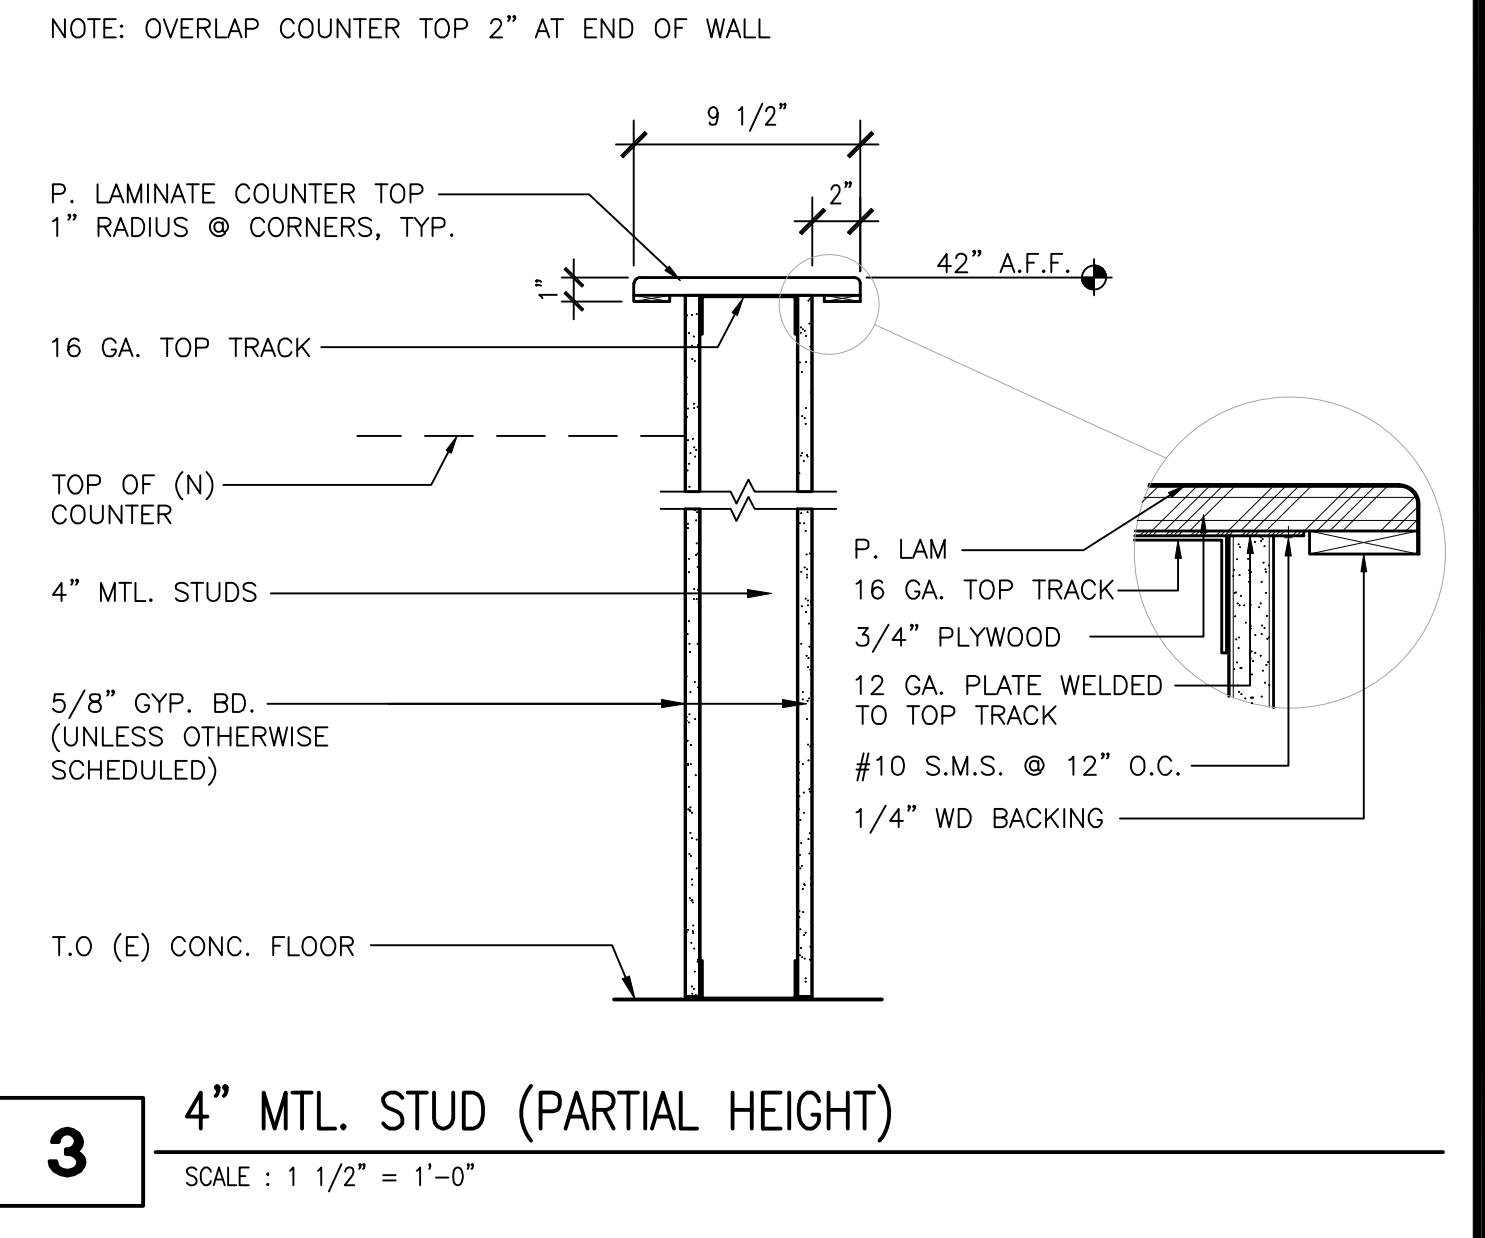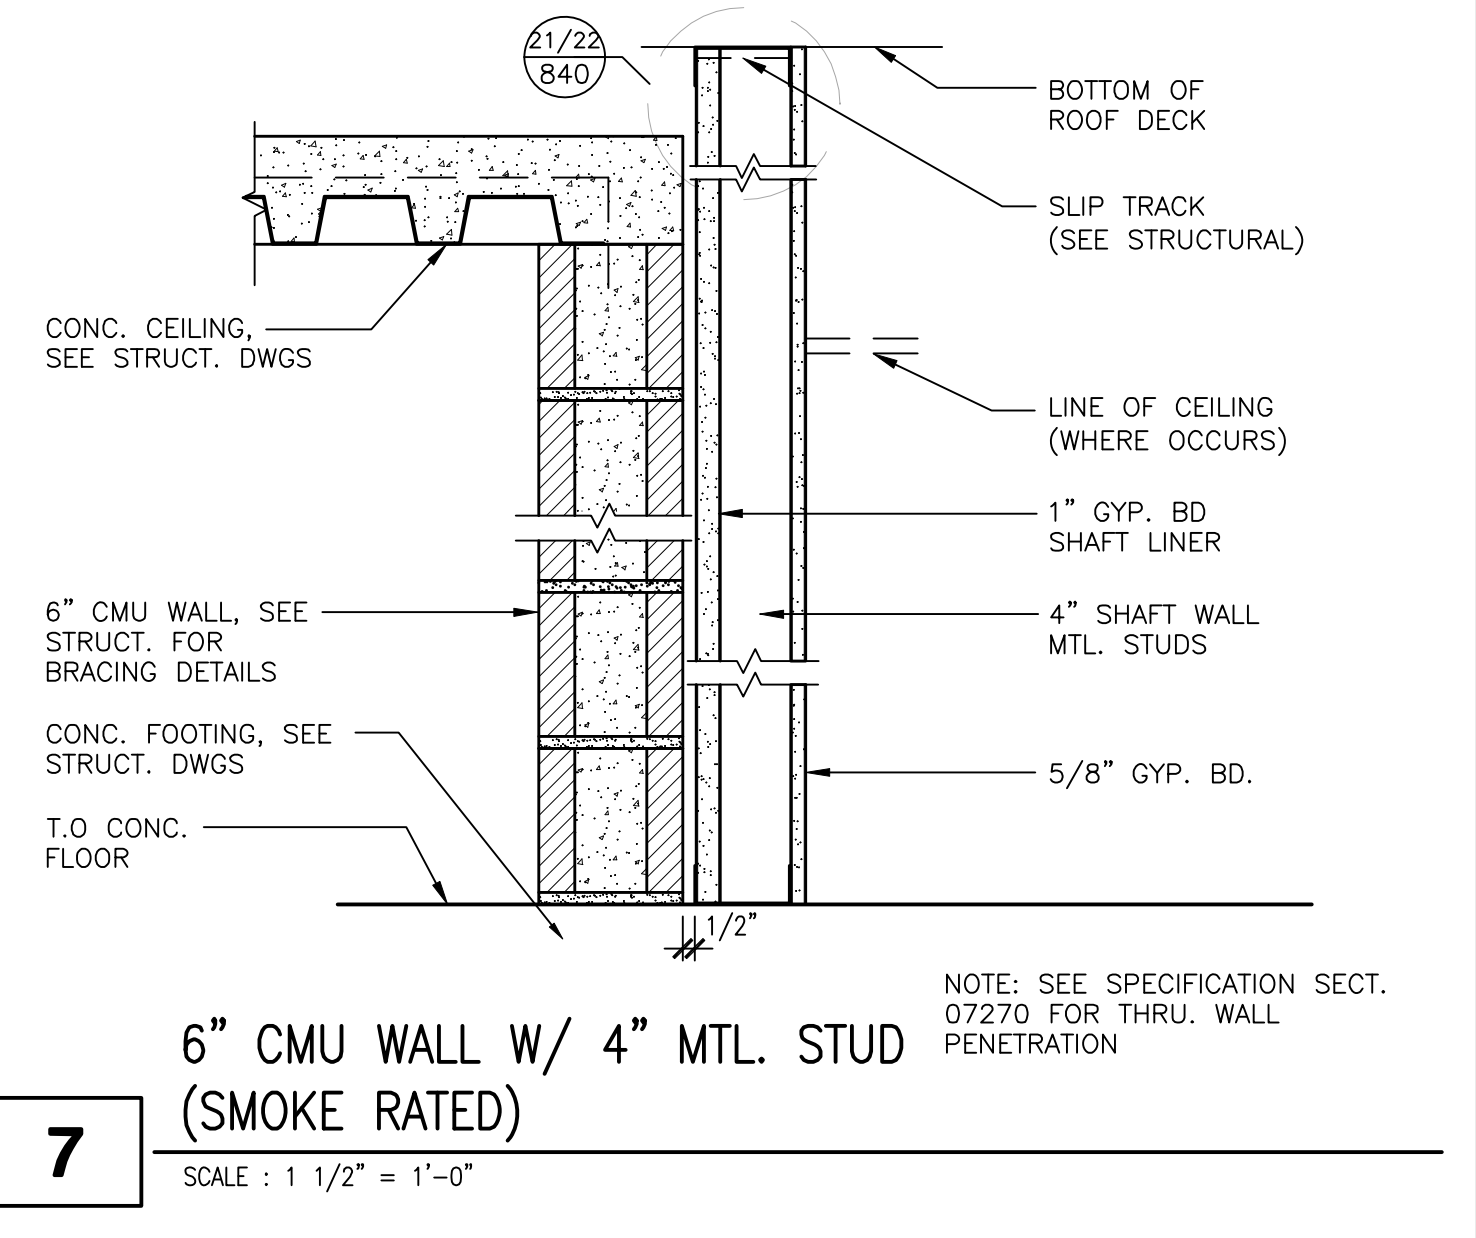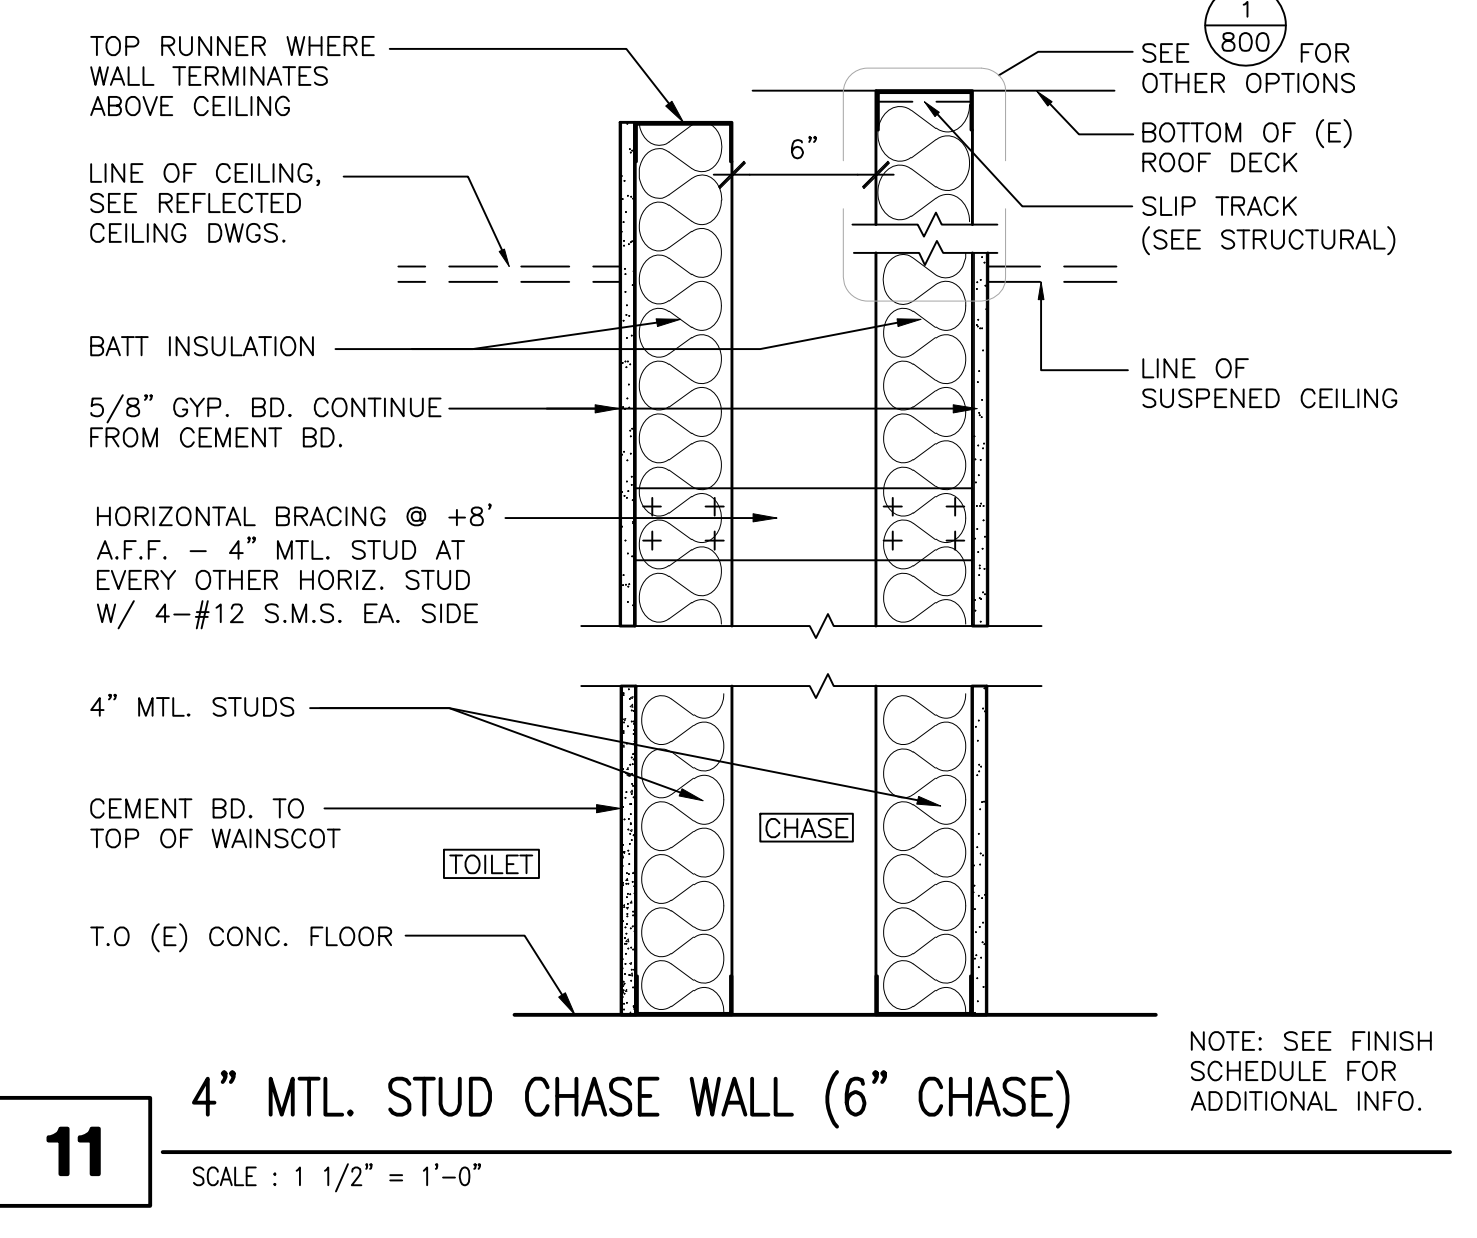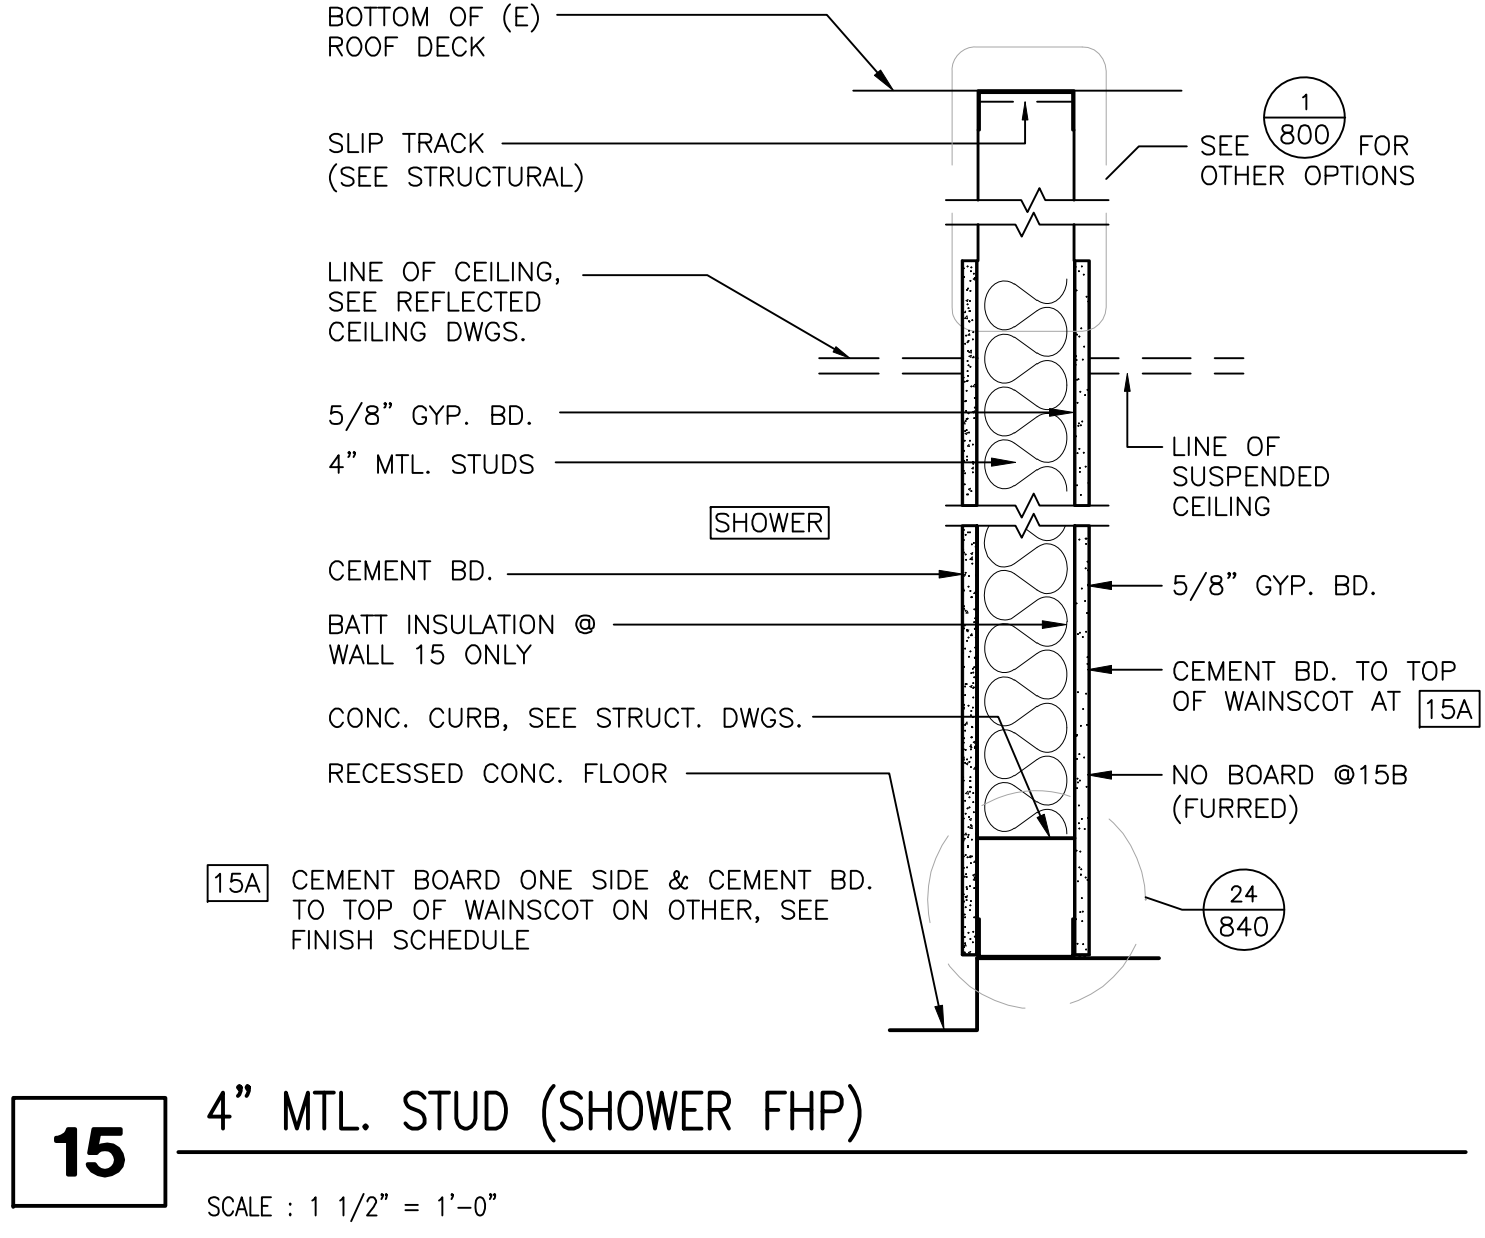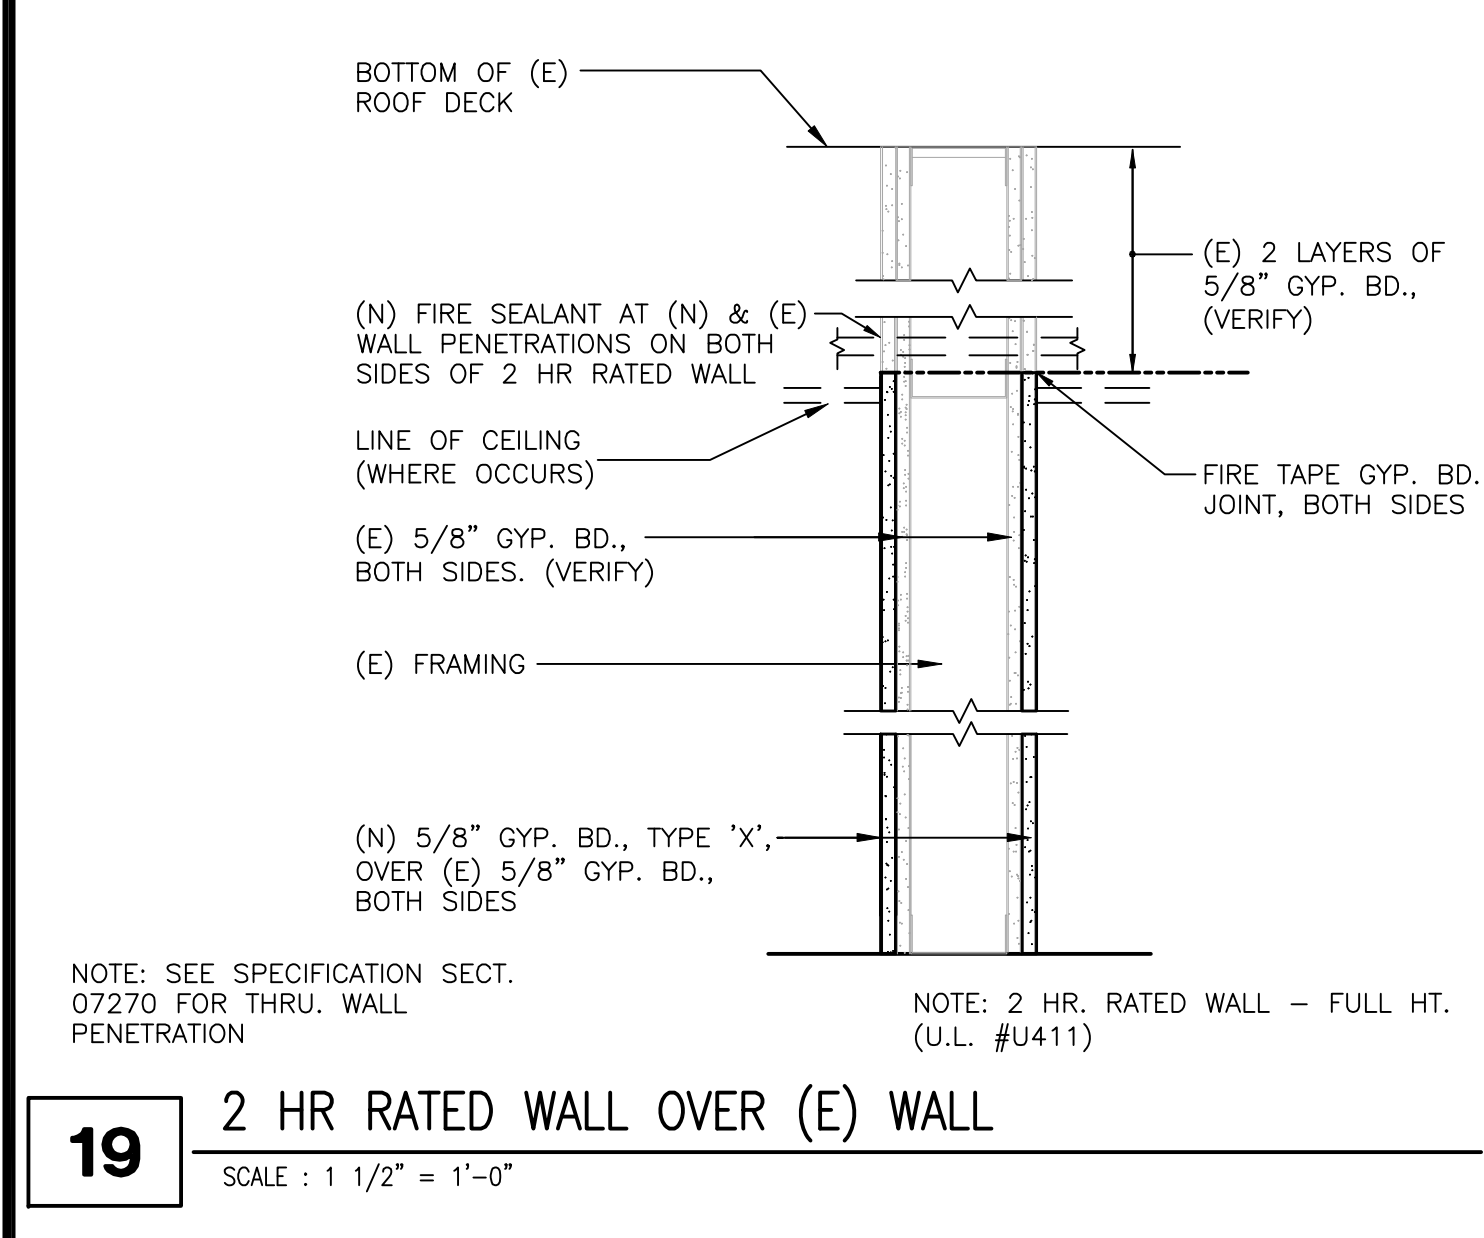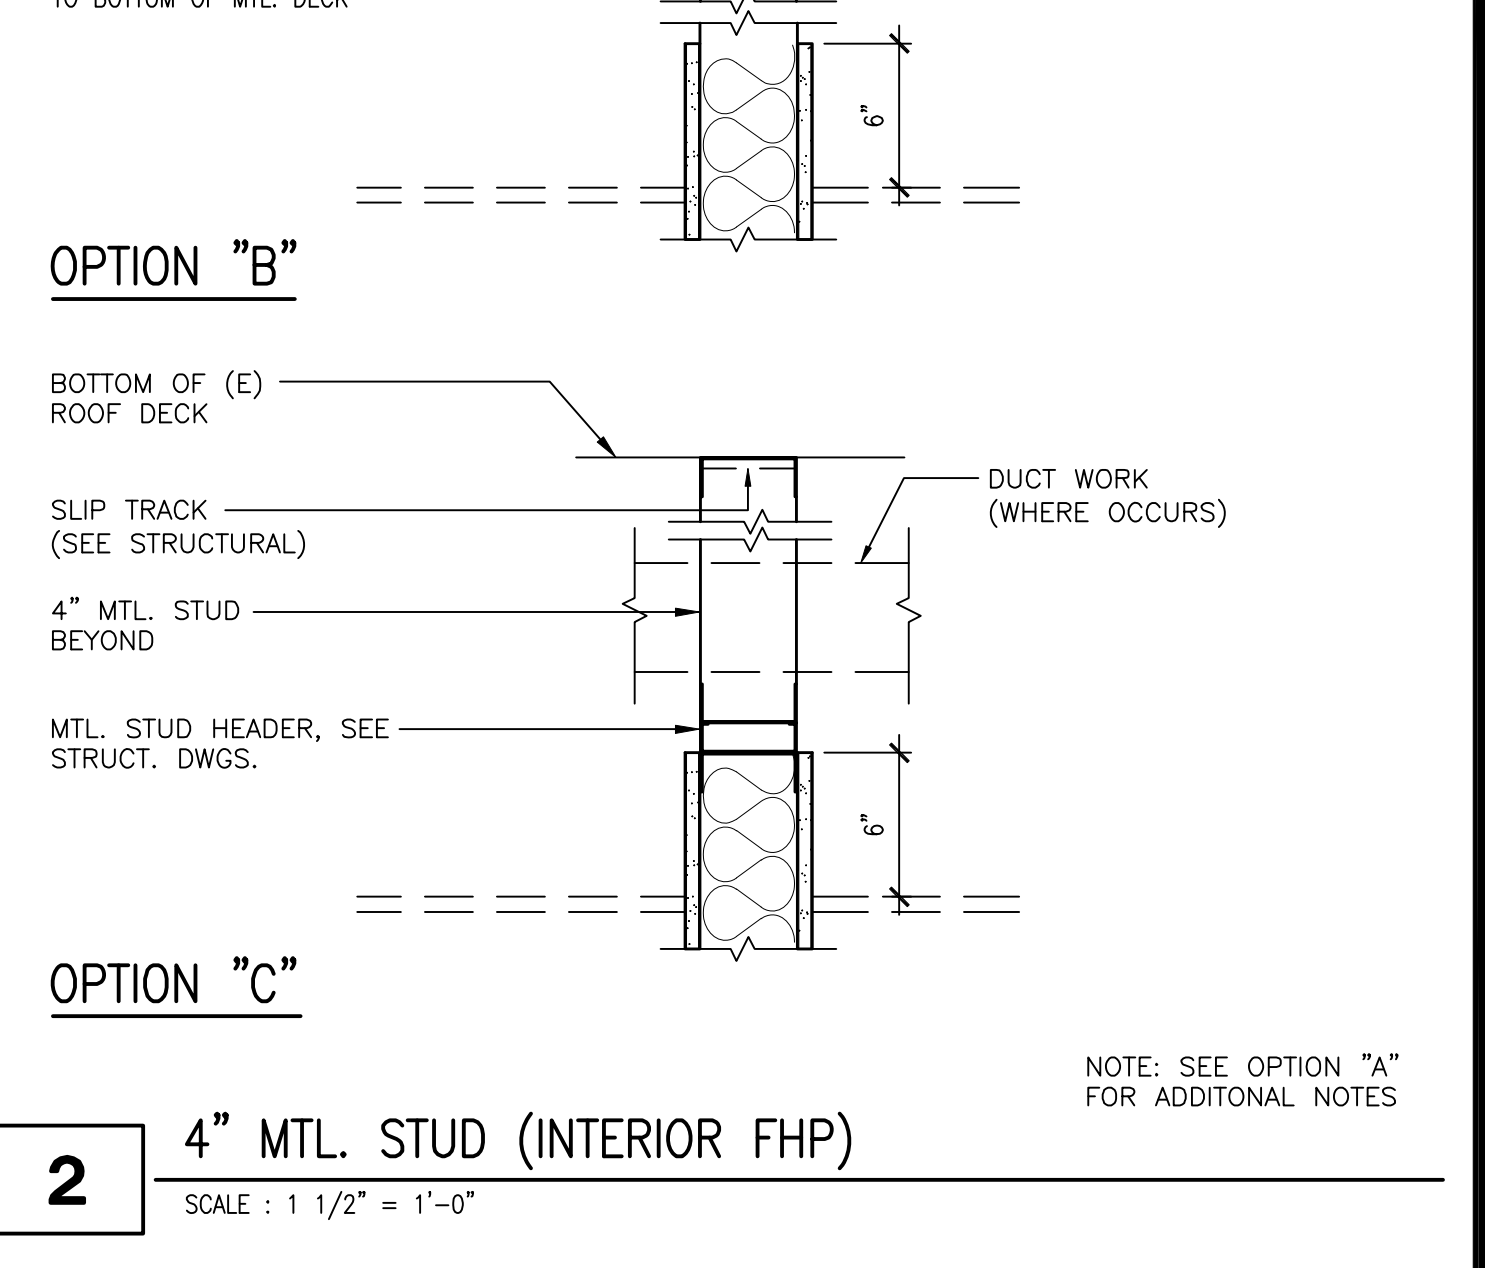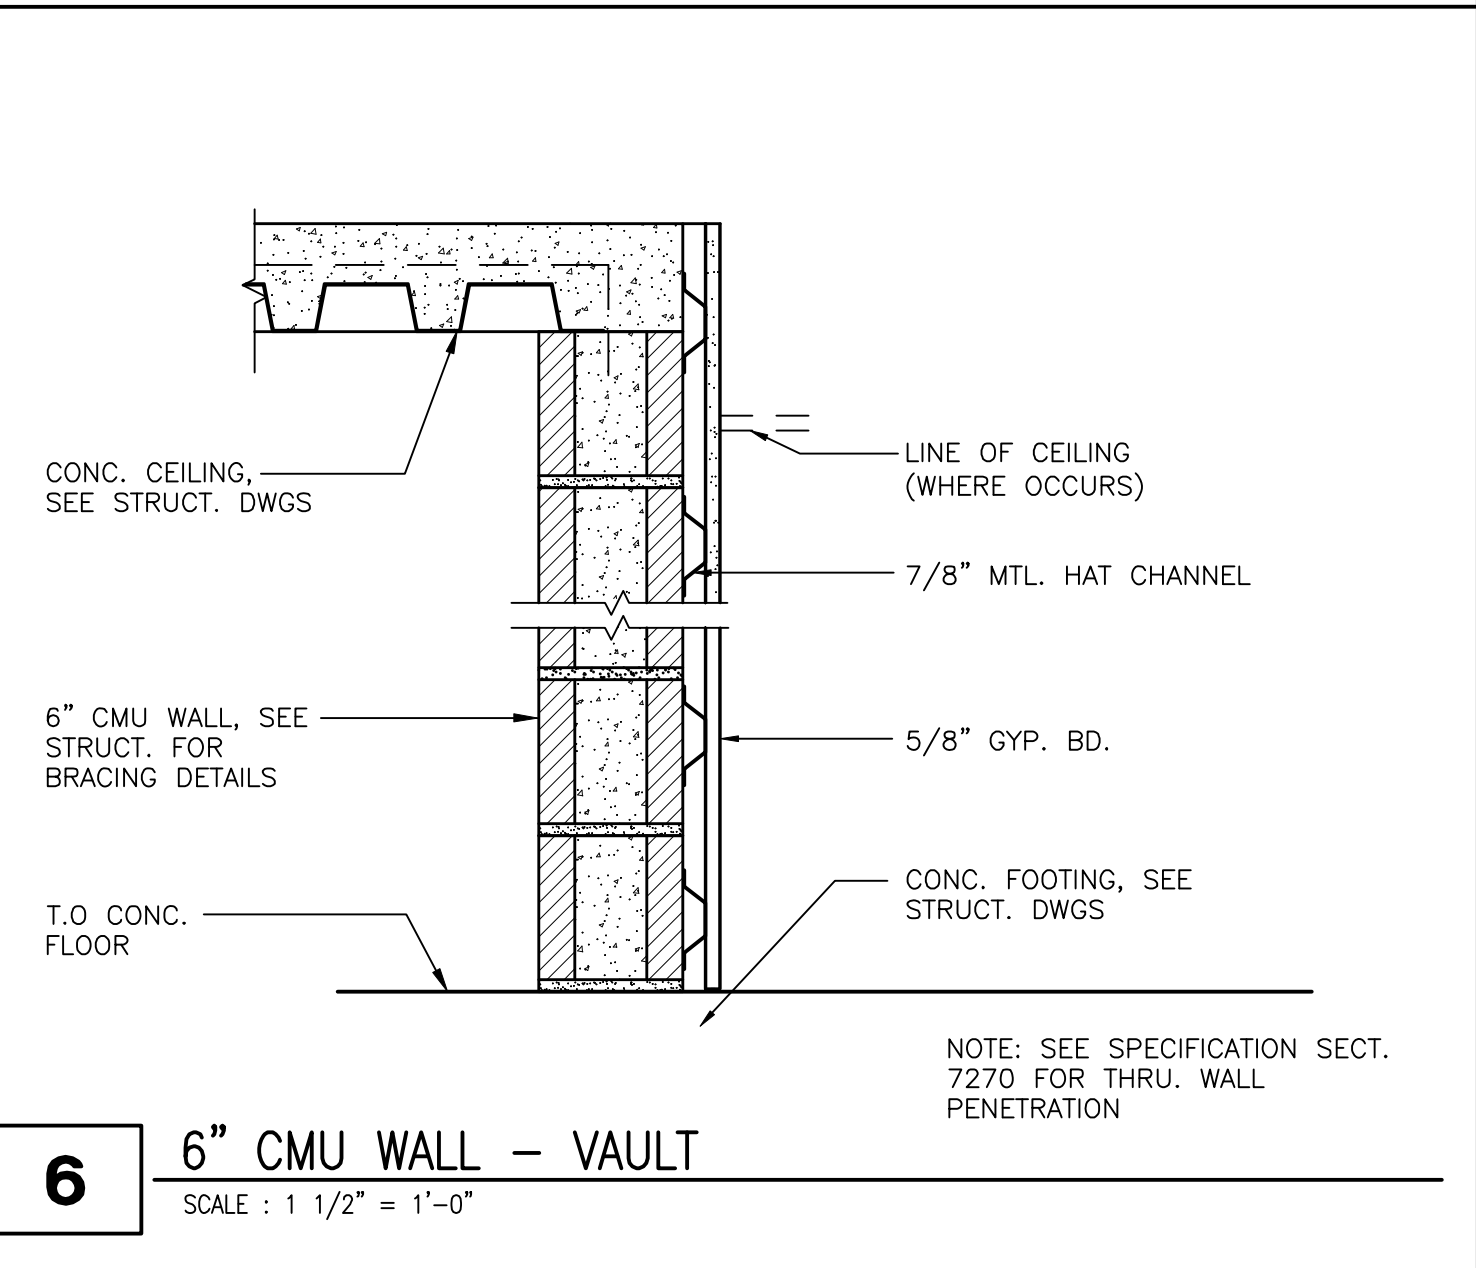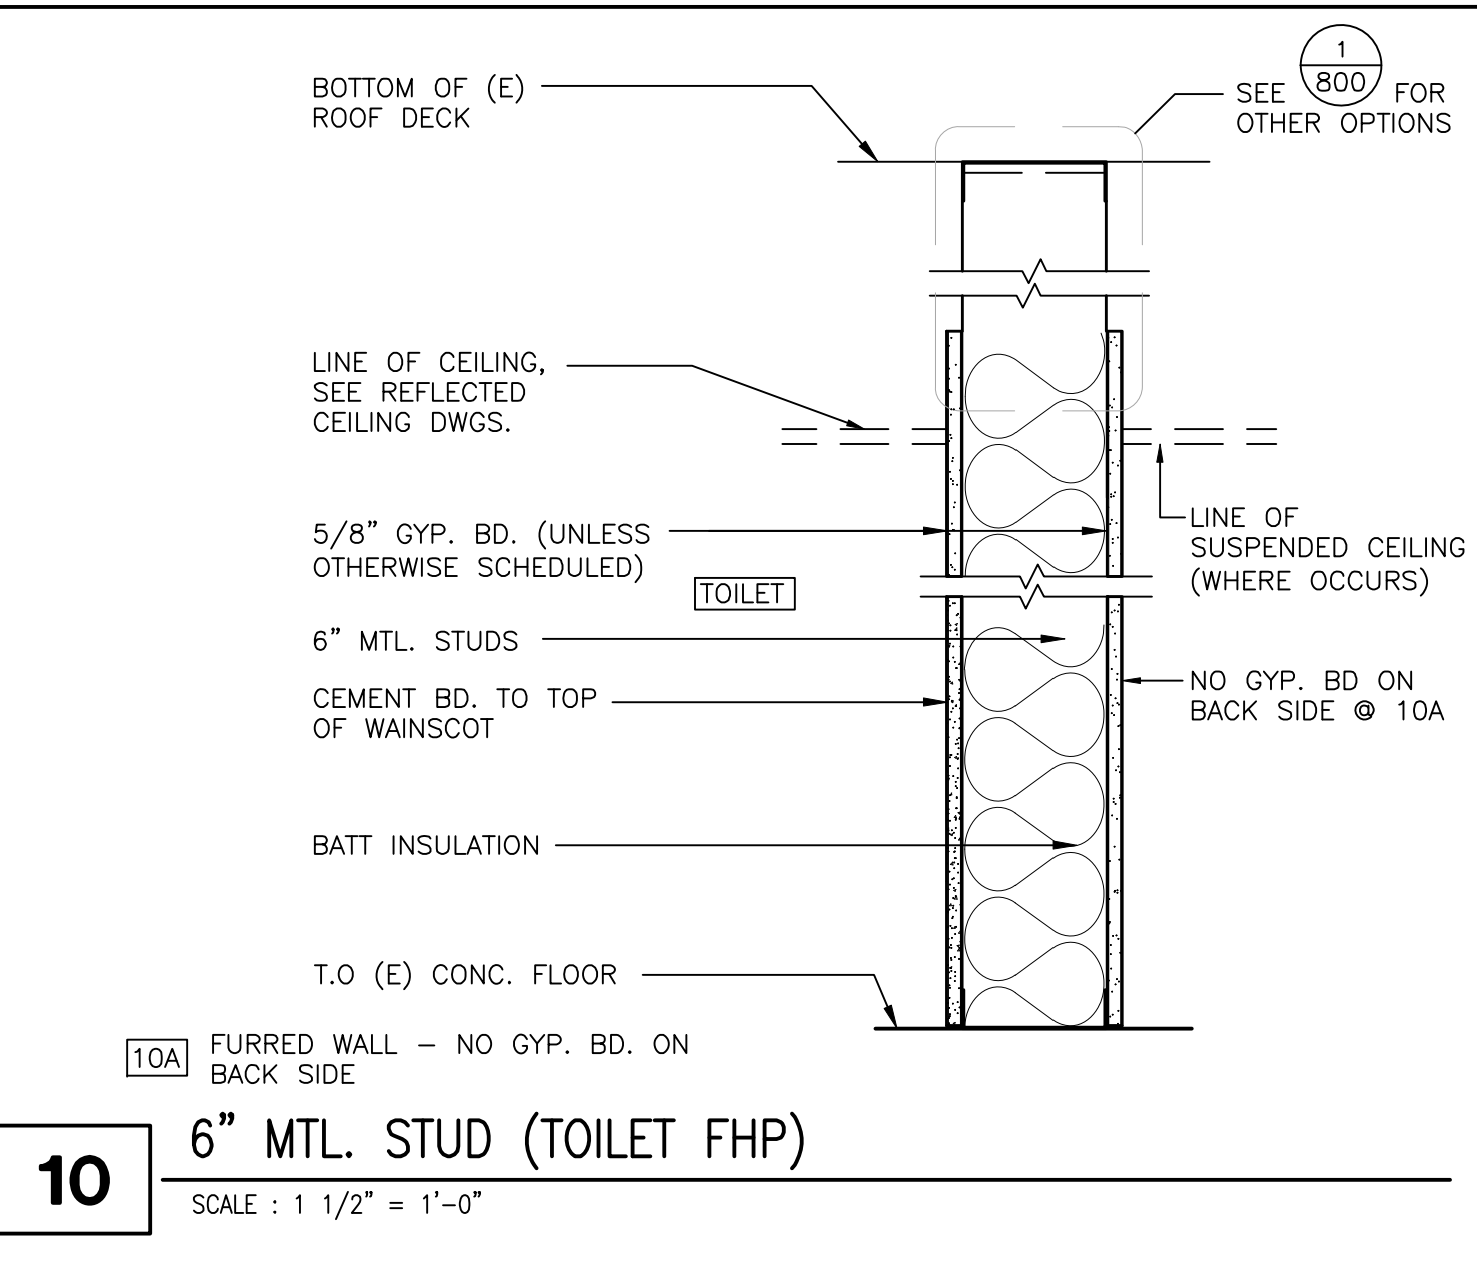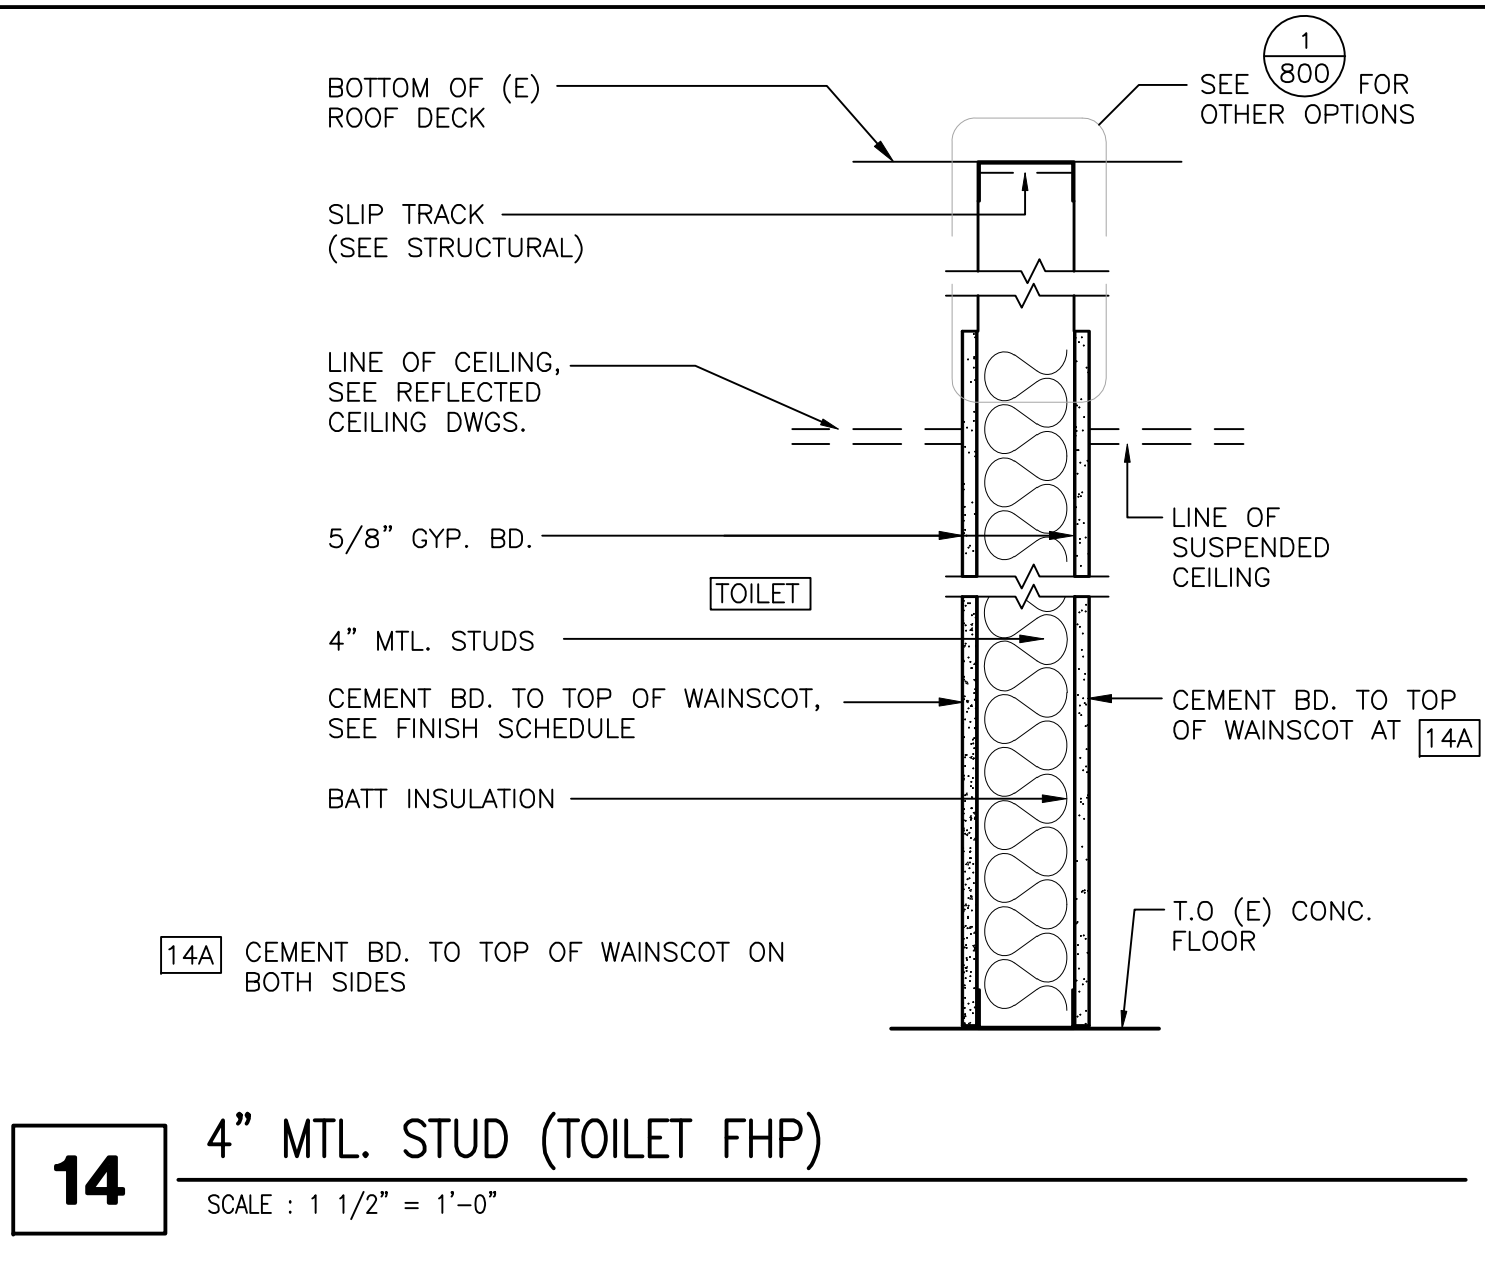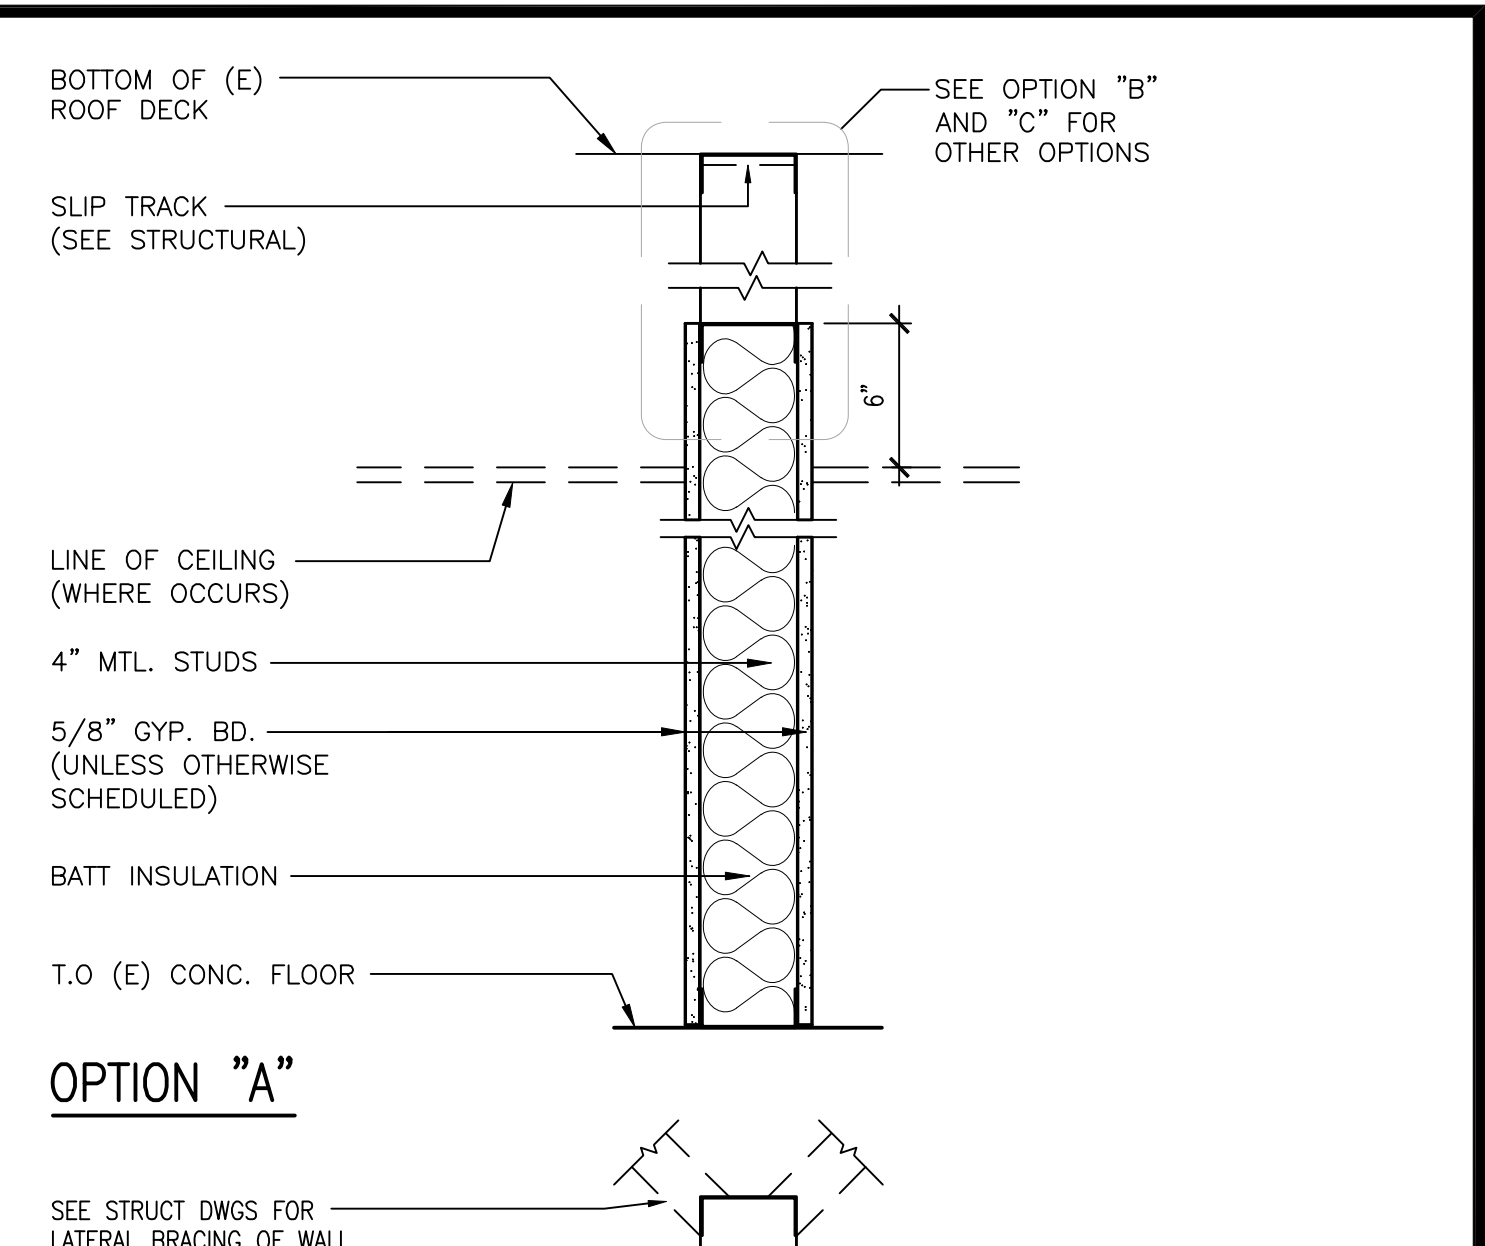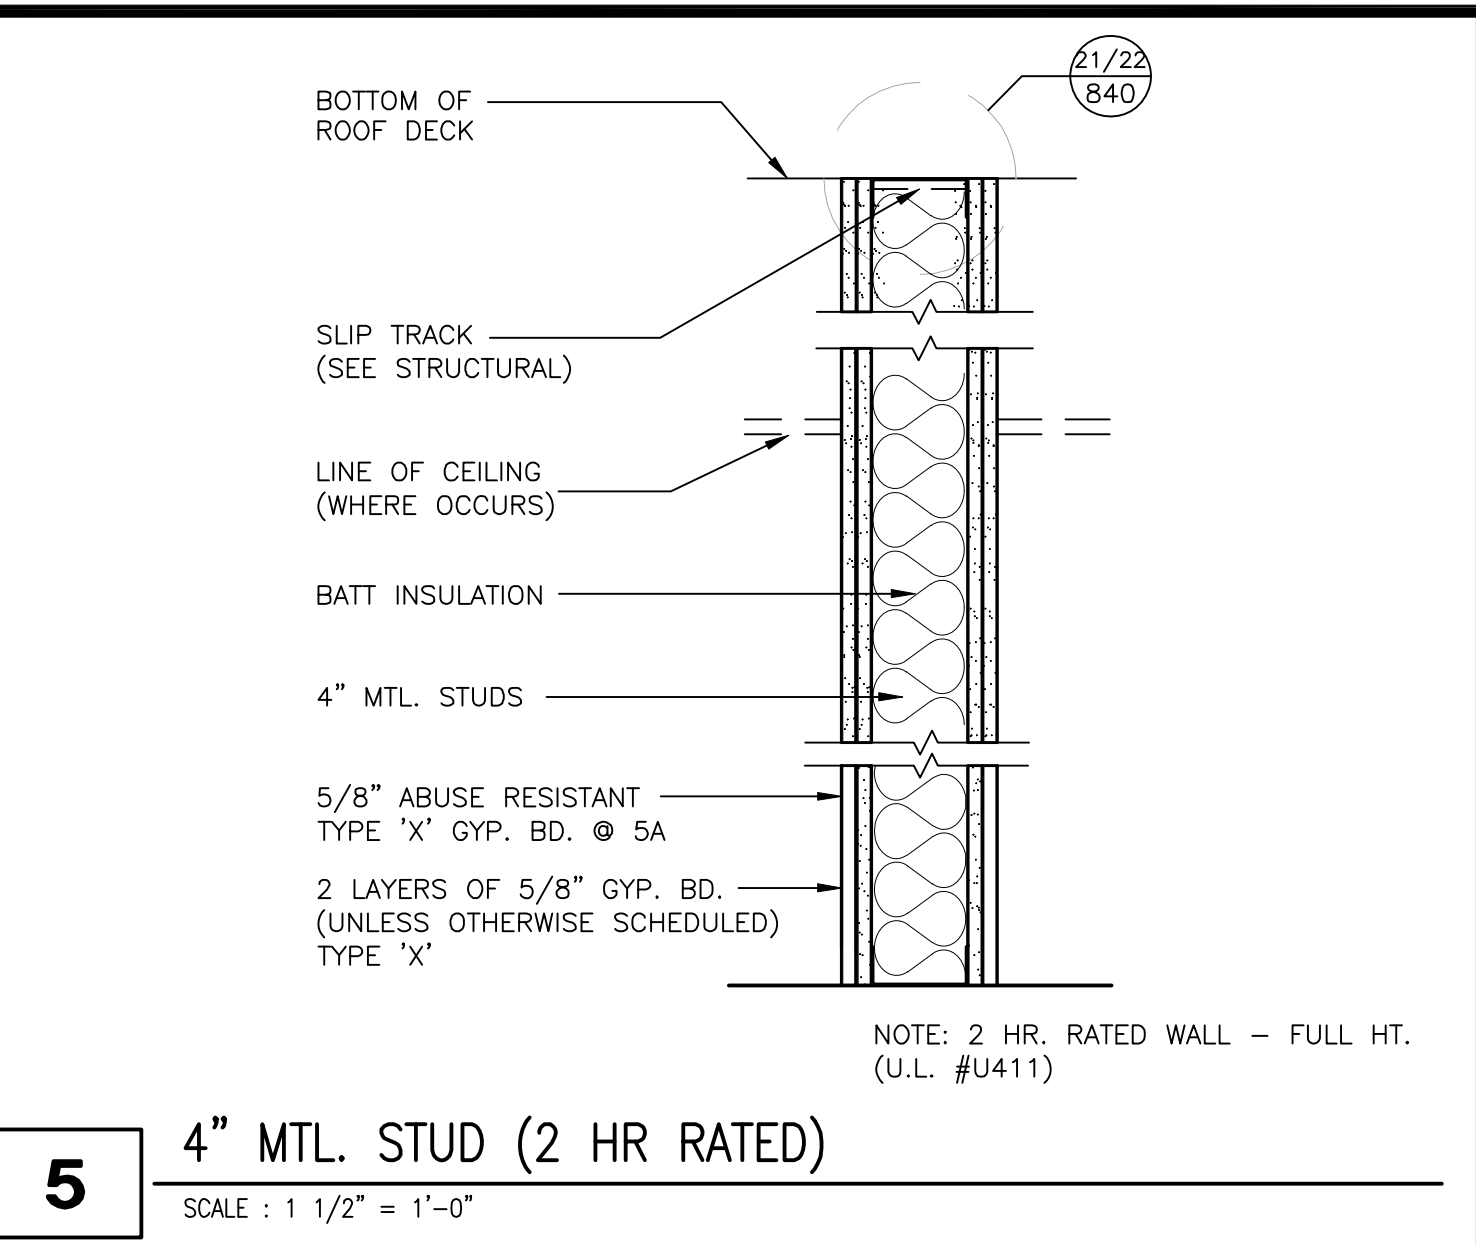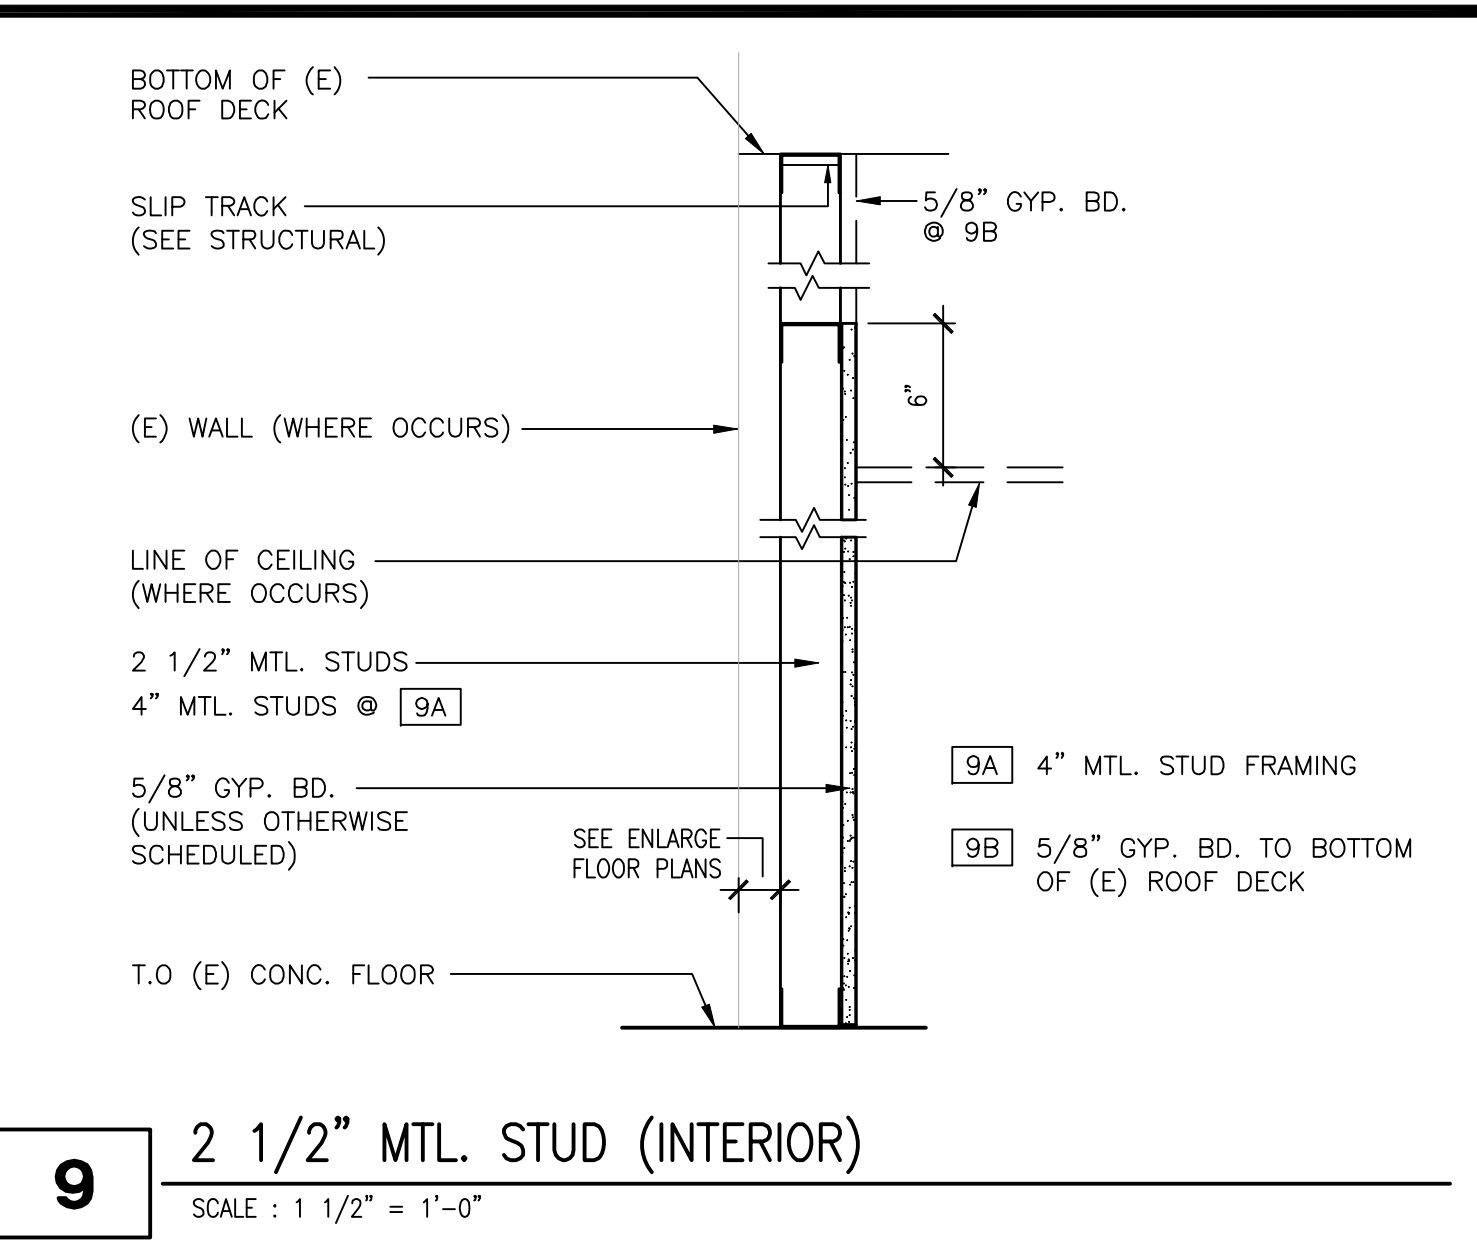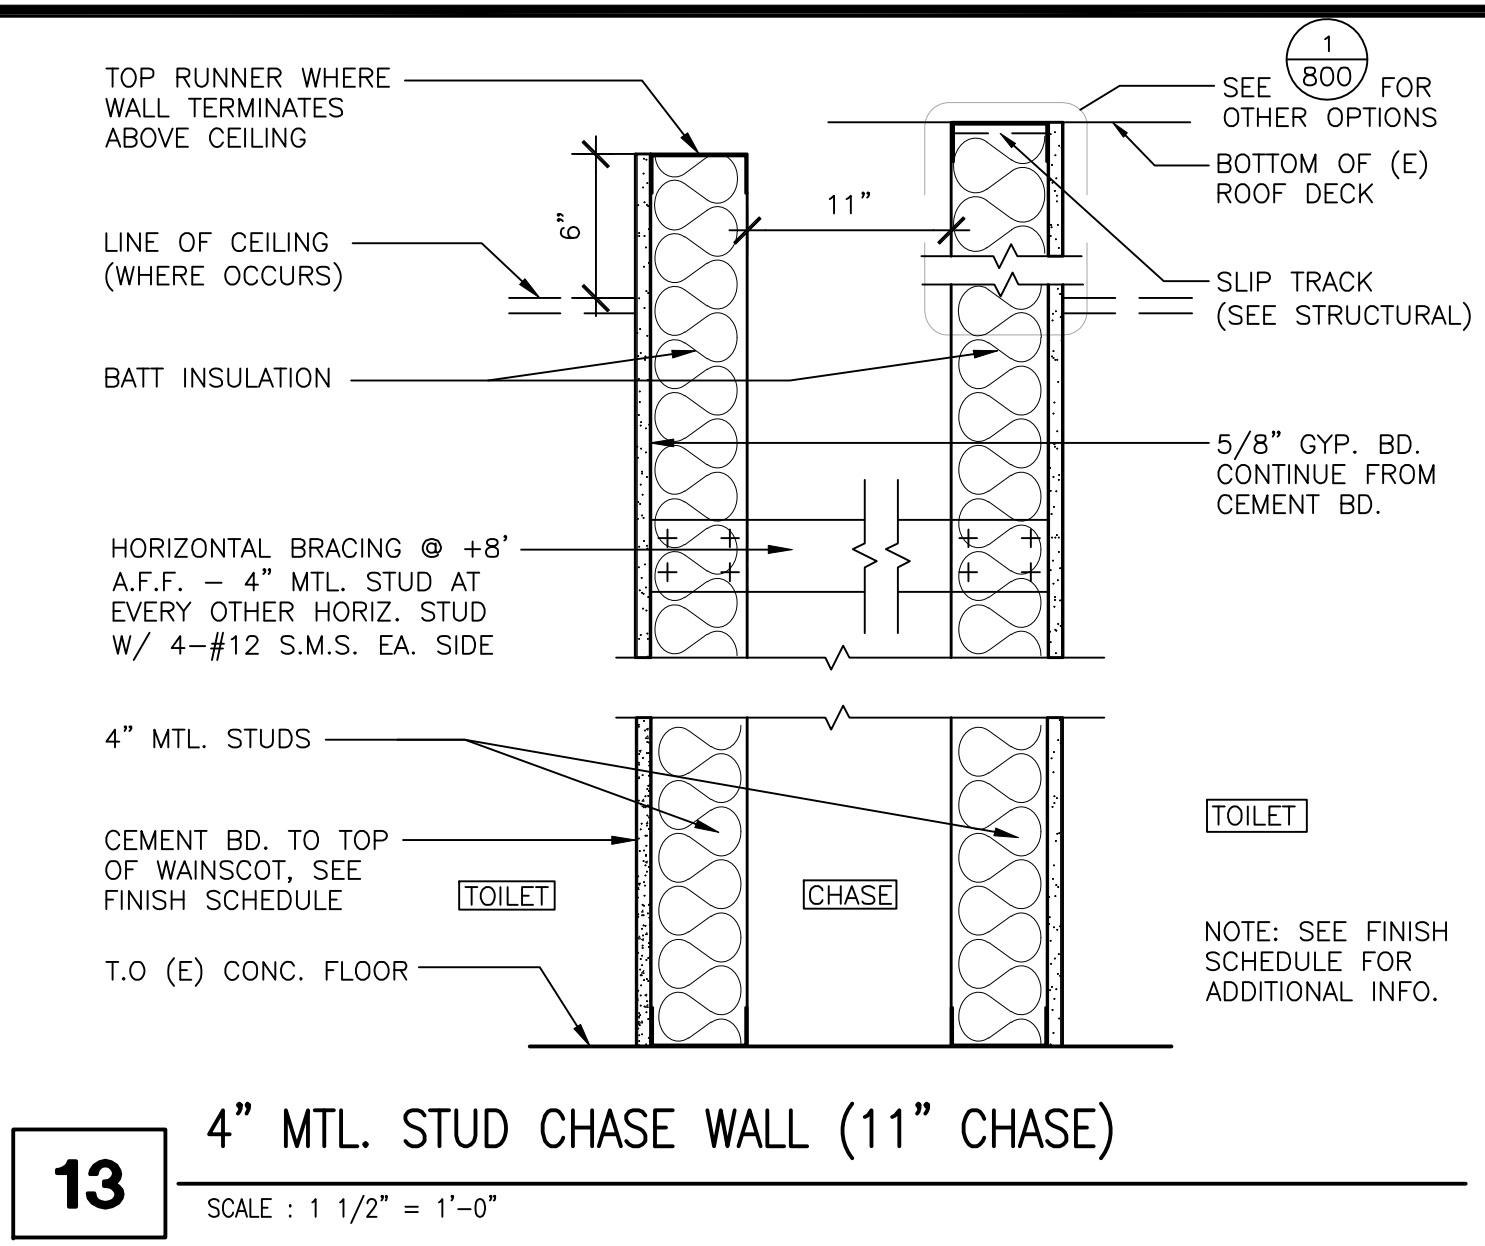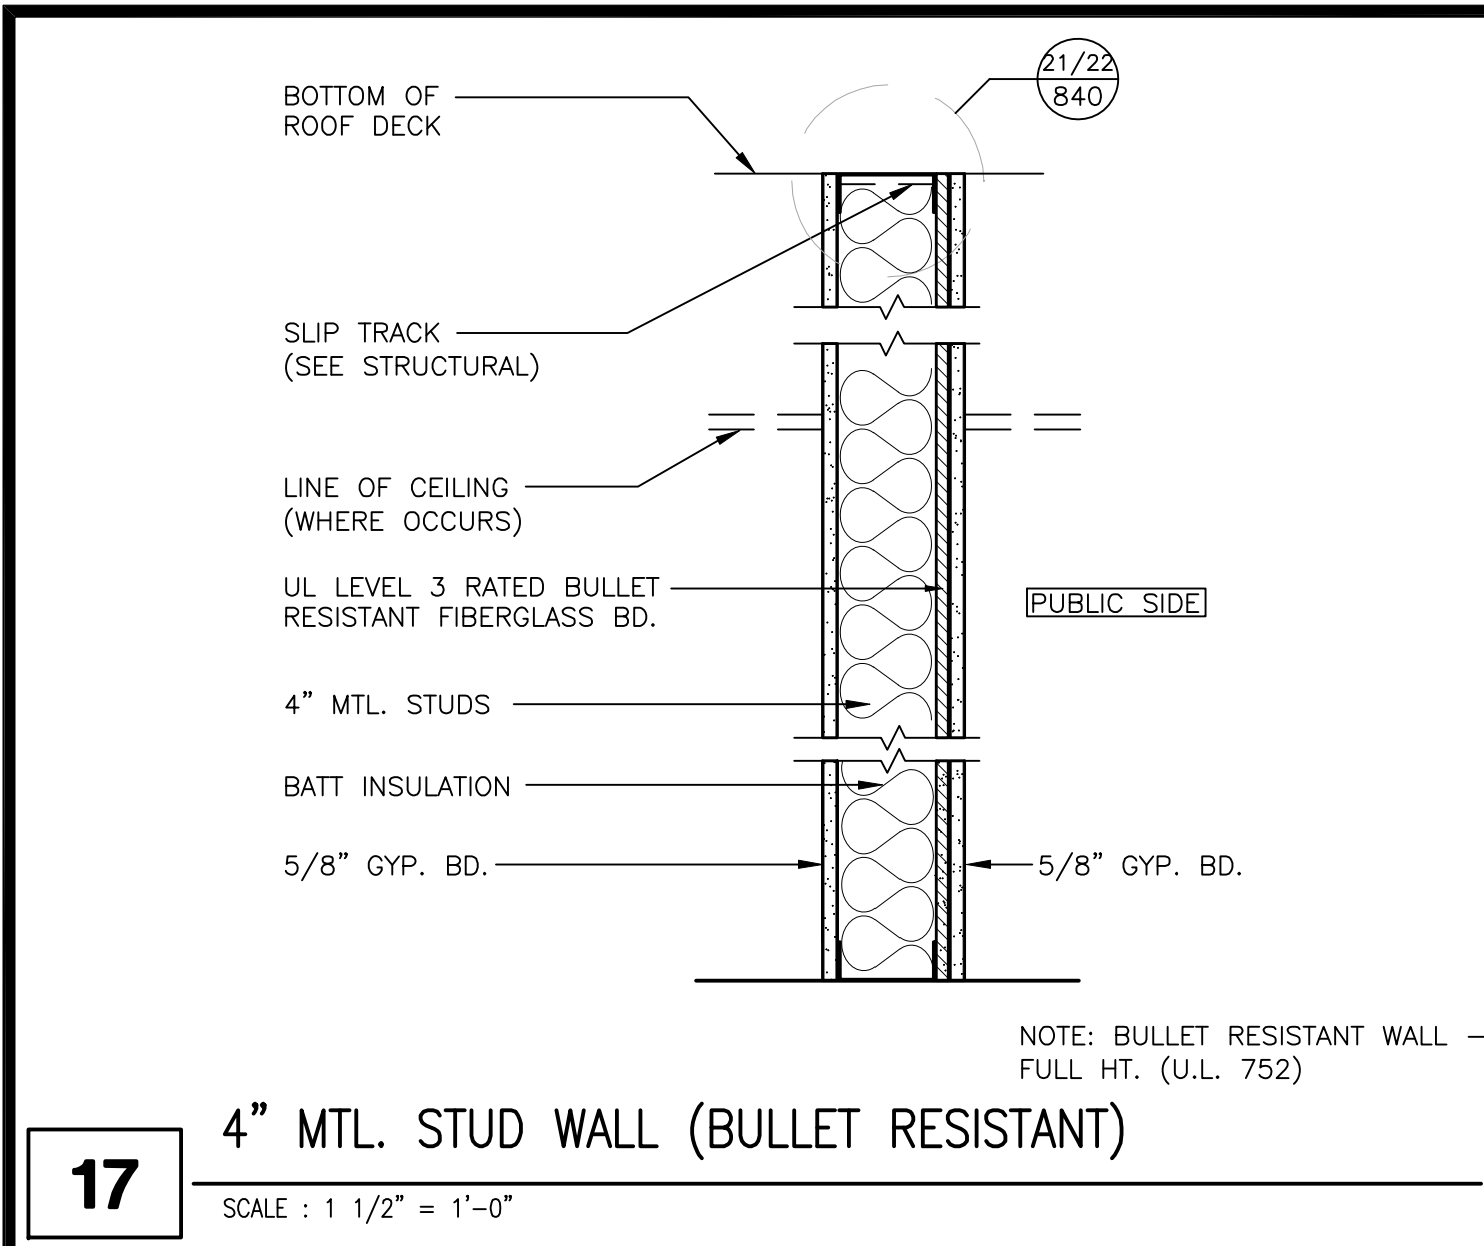

Revisions	Date

N L A
nacht & lewis
ARCHITECTS
600 Q Street, Suite 100
Sacramento, Ca 95814
(916) 327-4000 - www.narch.com

Design Consultant	

Keyplan	

Drawing Title	PARTITION TYPES
Scale	
Approved	MILAN SRKIC
Approved	


Project Title	VA/MCHCS SACRAMENTO MEDICAL CENTER MATHER, CALIFORNIA PHASE 2 - BUILDING 650 RENOVATION
Location	PETER MCCUEN BLVD. MATHER, CALIFORNIA
Date	11/7/08
Checked	
Drawn	
Project Number	612-1010
Building Name	650
Drawing Number	800
Scale	

Office of
Facilities
Management


Department of
Veterans Affairs

RECORD SET


FULLY SPRINKLERED

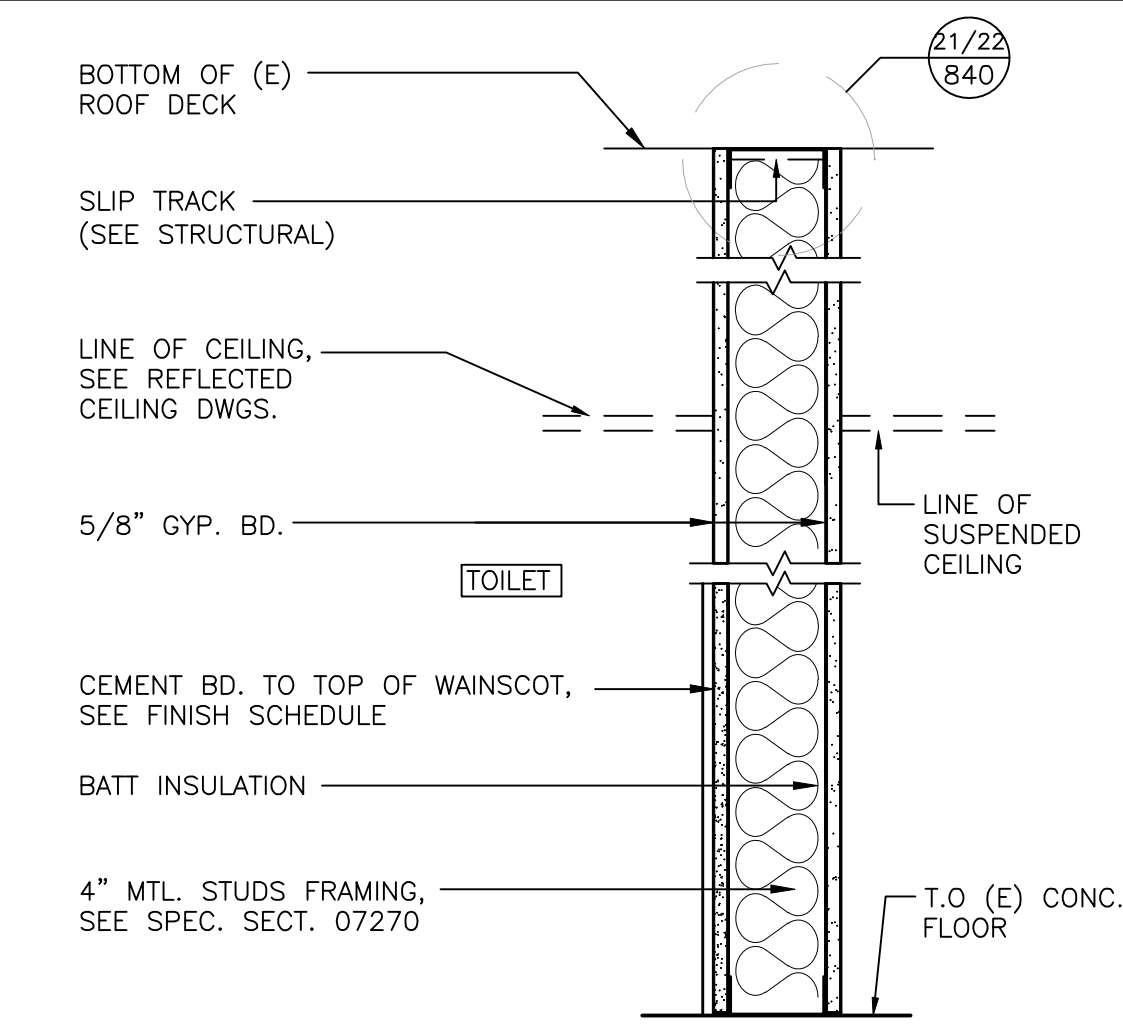


25 4" MTL. STUD (SMOKE RATED TOILET FHP)
SCALE : 1 1/2" = 1'-0"

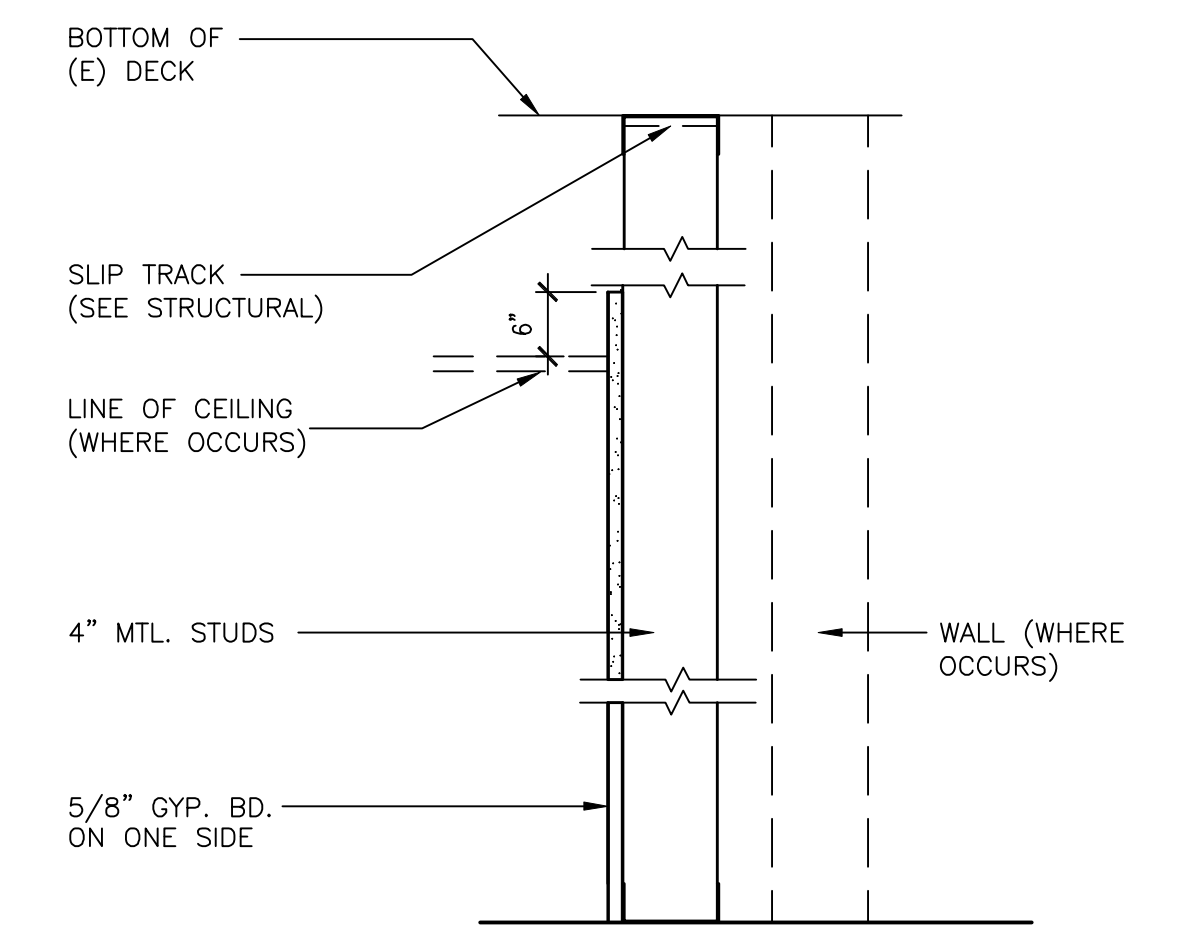


21 4" MTL. STUD
SCALE : 1 1/2" = 1'-0"

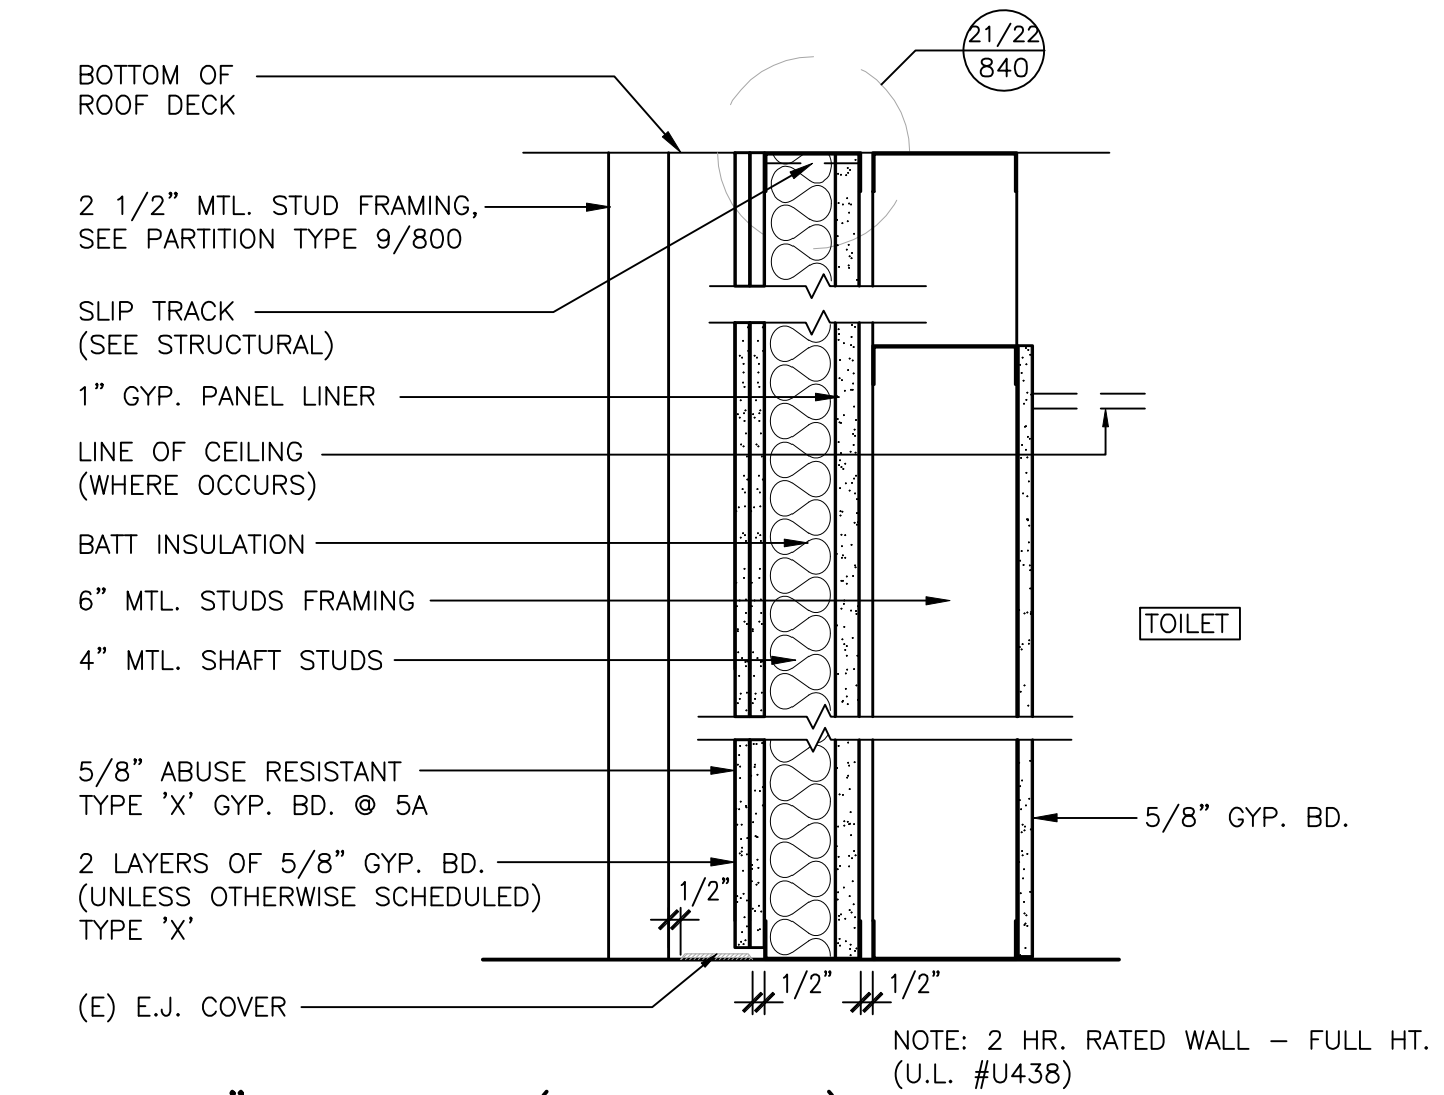


26 4" MTL. STUD (2 HR RATED)
SCALE : 1 1/2" = 1'-0"

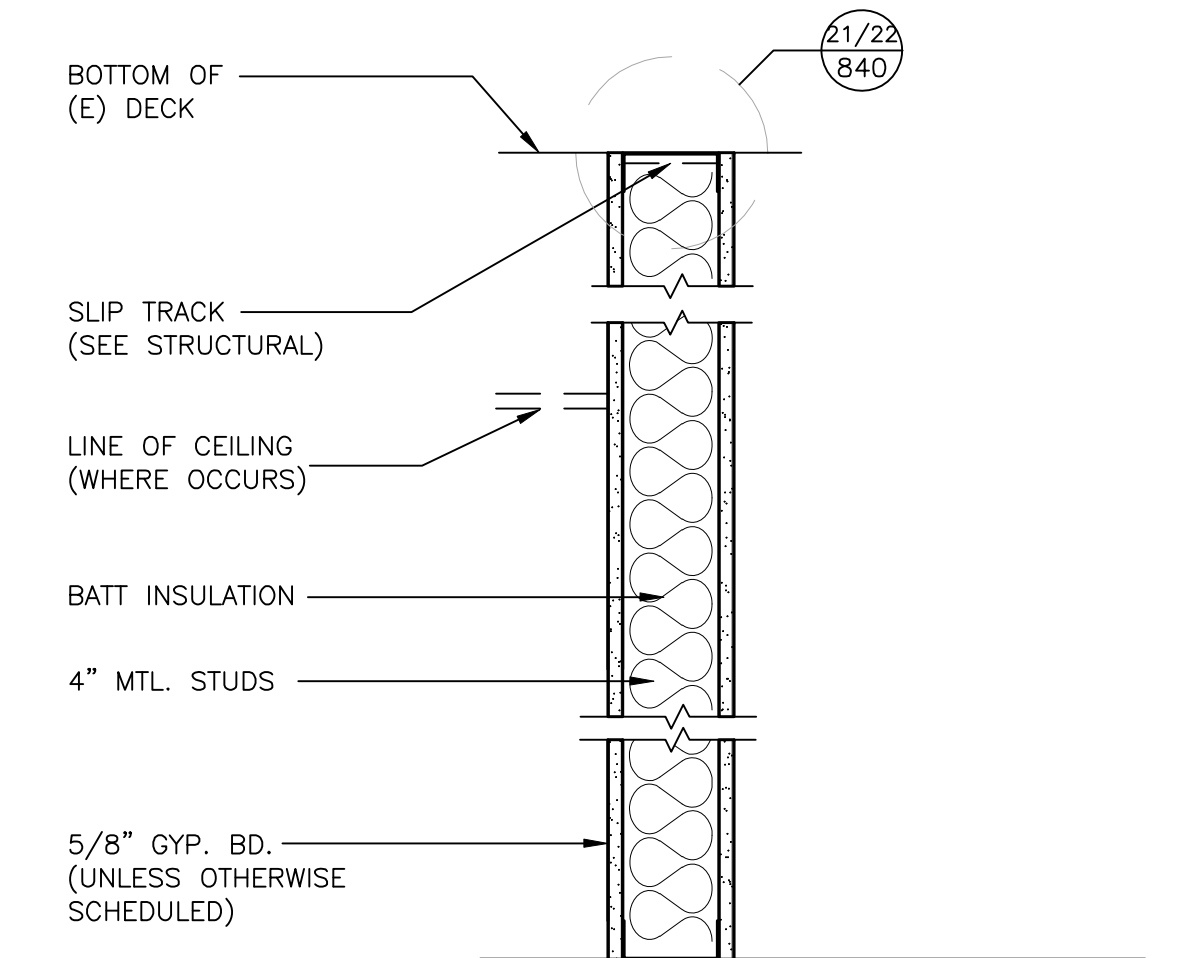


22 4" MTL. STUD (SMOKE RATED)
SCALE : 1 1/2" = 1'-0"

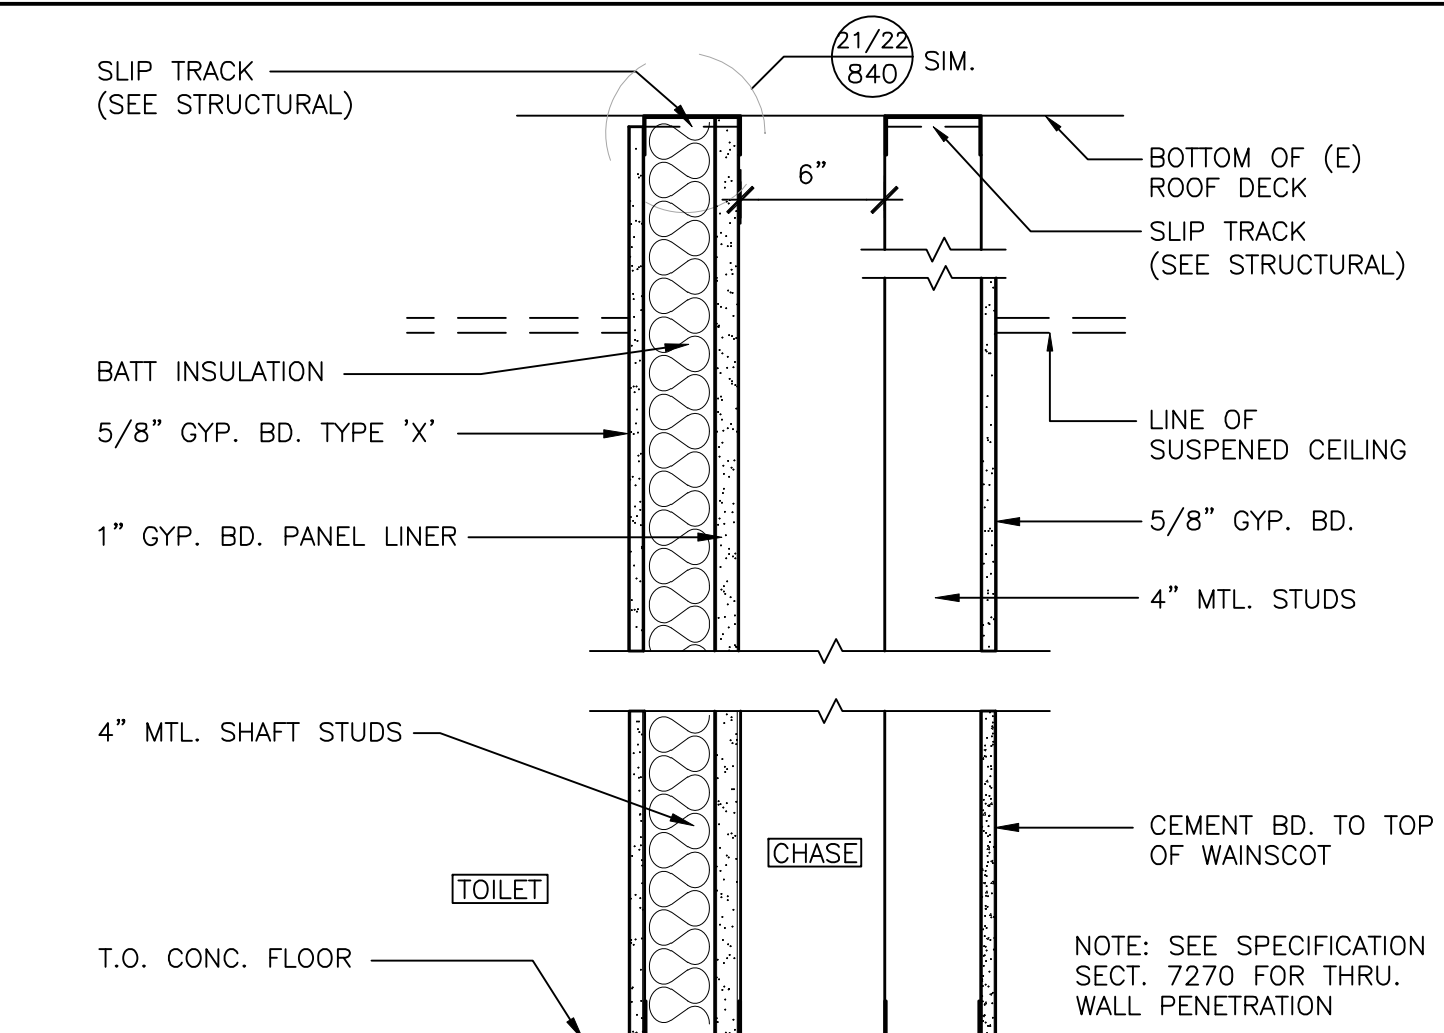

27 4" MTL. STUD CHASE WALL (6" CHASE)
SCALE : 1 1/2" = 1'-0"

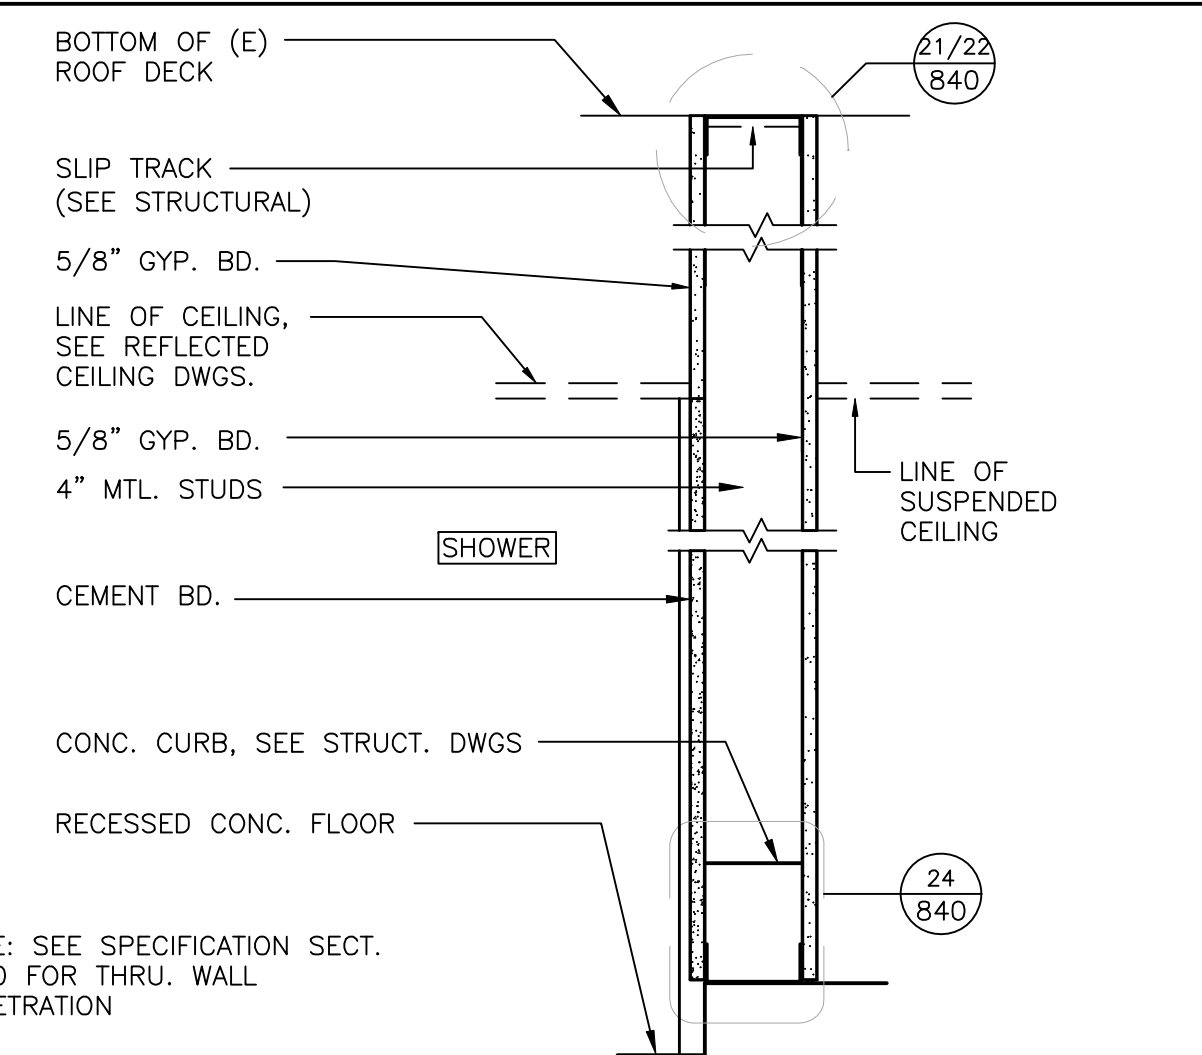

23 4" MTL. STUD (SHOWER FHP SMOKE RATED)
SCALE : 1 1/2" = 1'-0"

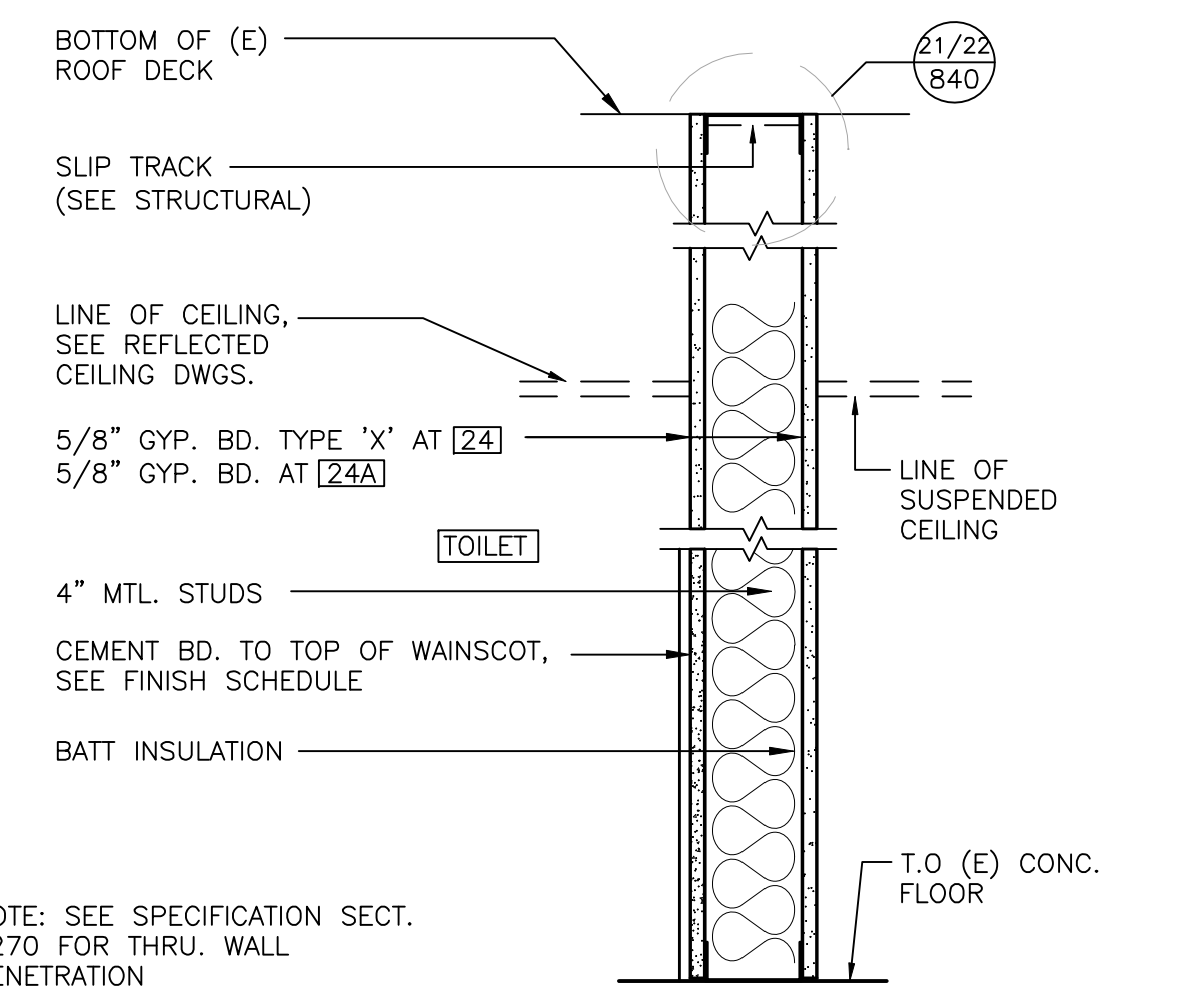

24 4" MTL. STUD (TOILET FHP) (GA FILE # WP 1200, U.L.C #W415; U.L. U465)
SCALE : 1 1/2" = 1'-0"

RECORD SET

**Office of
Facilities
management**



37

33

29

38

34

30

39

35


31





40

36


32


28

Revisions		Date		 <p>nacht & lewis ARCHITECTS 600 Q Street, Suite 100 Sacramento, Ca 95814 (916) 329-4000 • www.nlerch.com</p>		Design Consultant						Keyplan		Drawing Title PARTITION TYPES Scale Approved MILAN SRSKIC		Project Title VA/NCHCS SACRAMENTO MEDICAL CENTER MATHER, CALIFORNIA PHASE 2 - BUILDING 650 RENOVATION Location PETER McCUEN BLVD. MATHER, CALIFORNIA		Project Number 612-101D Building Name 650 Drawing Number 801 Scale		Office of Facilities Management  Department of Veterans Affairs	
										FULLY SPRINKLERED		Approved		Date 11/7/08		Checked 		Drawn 			

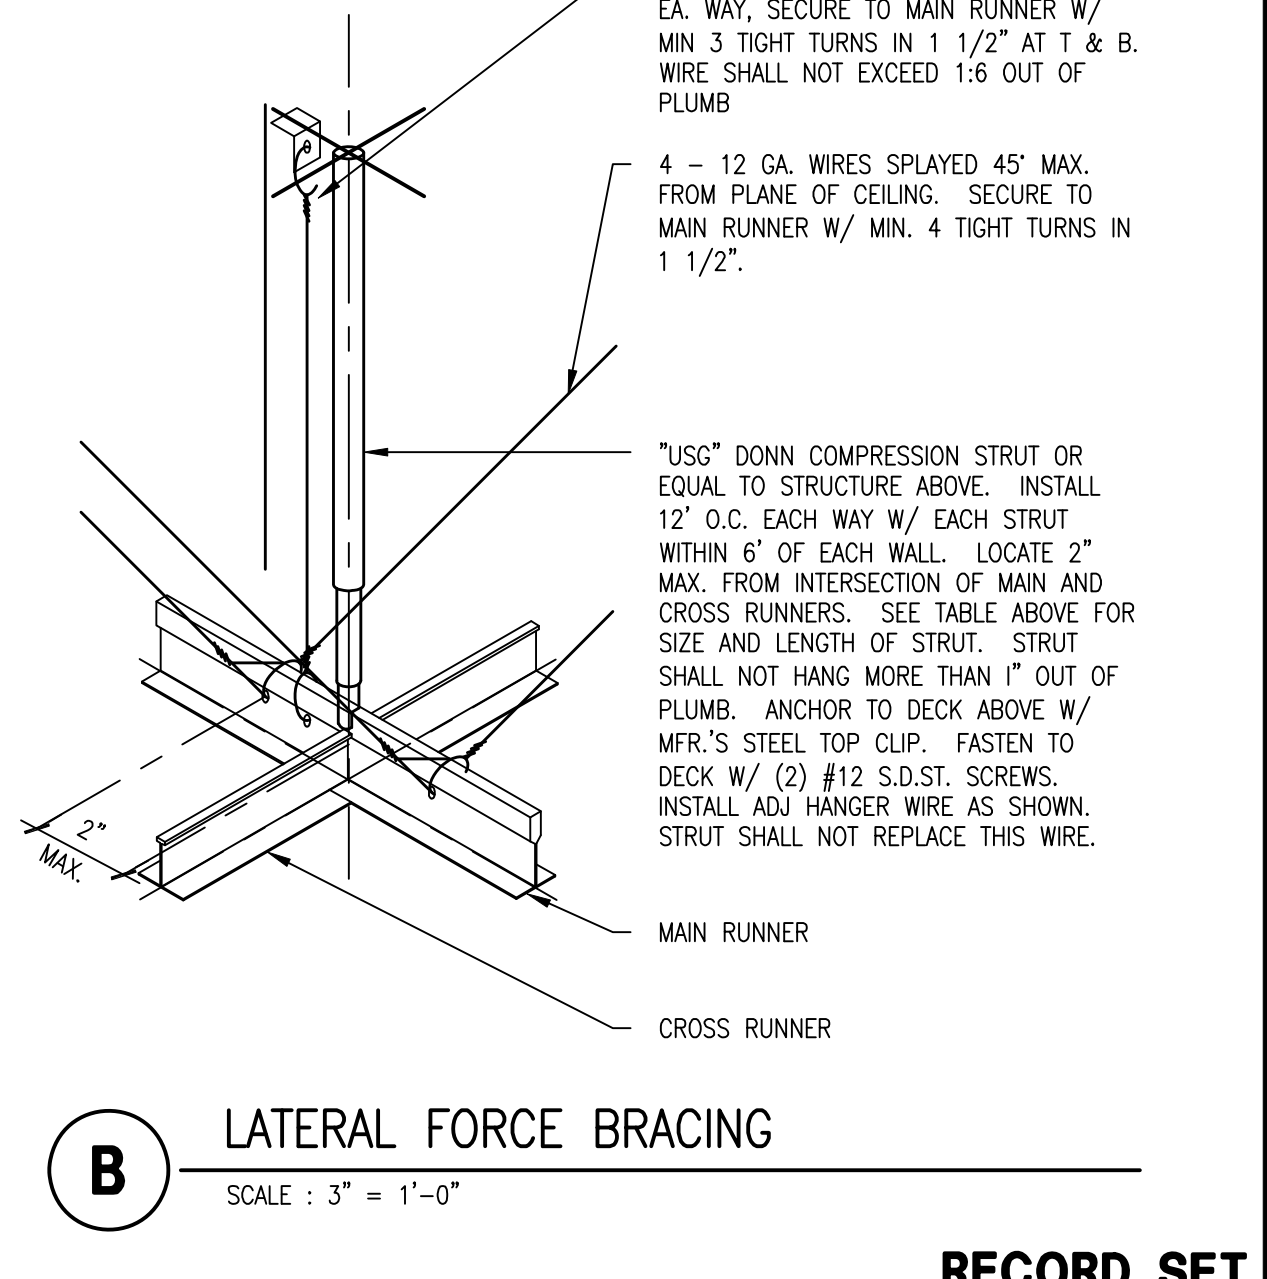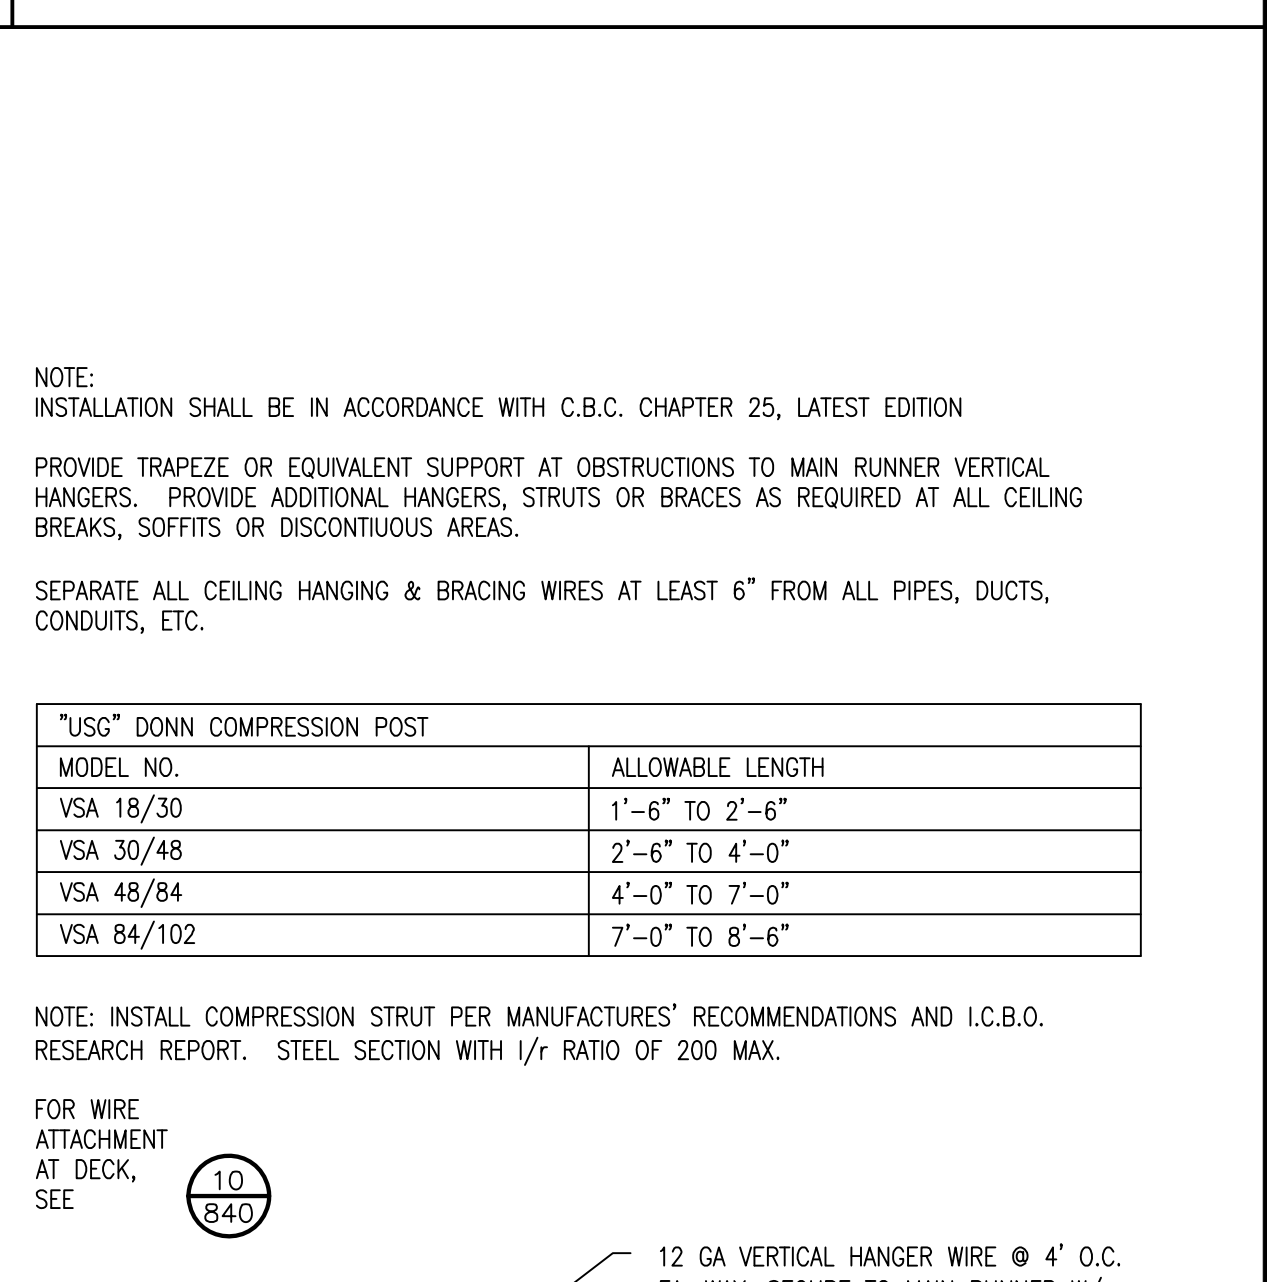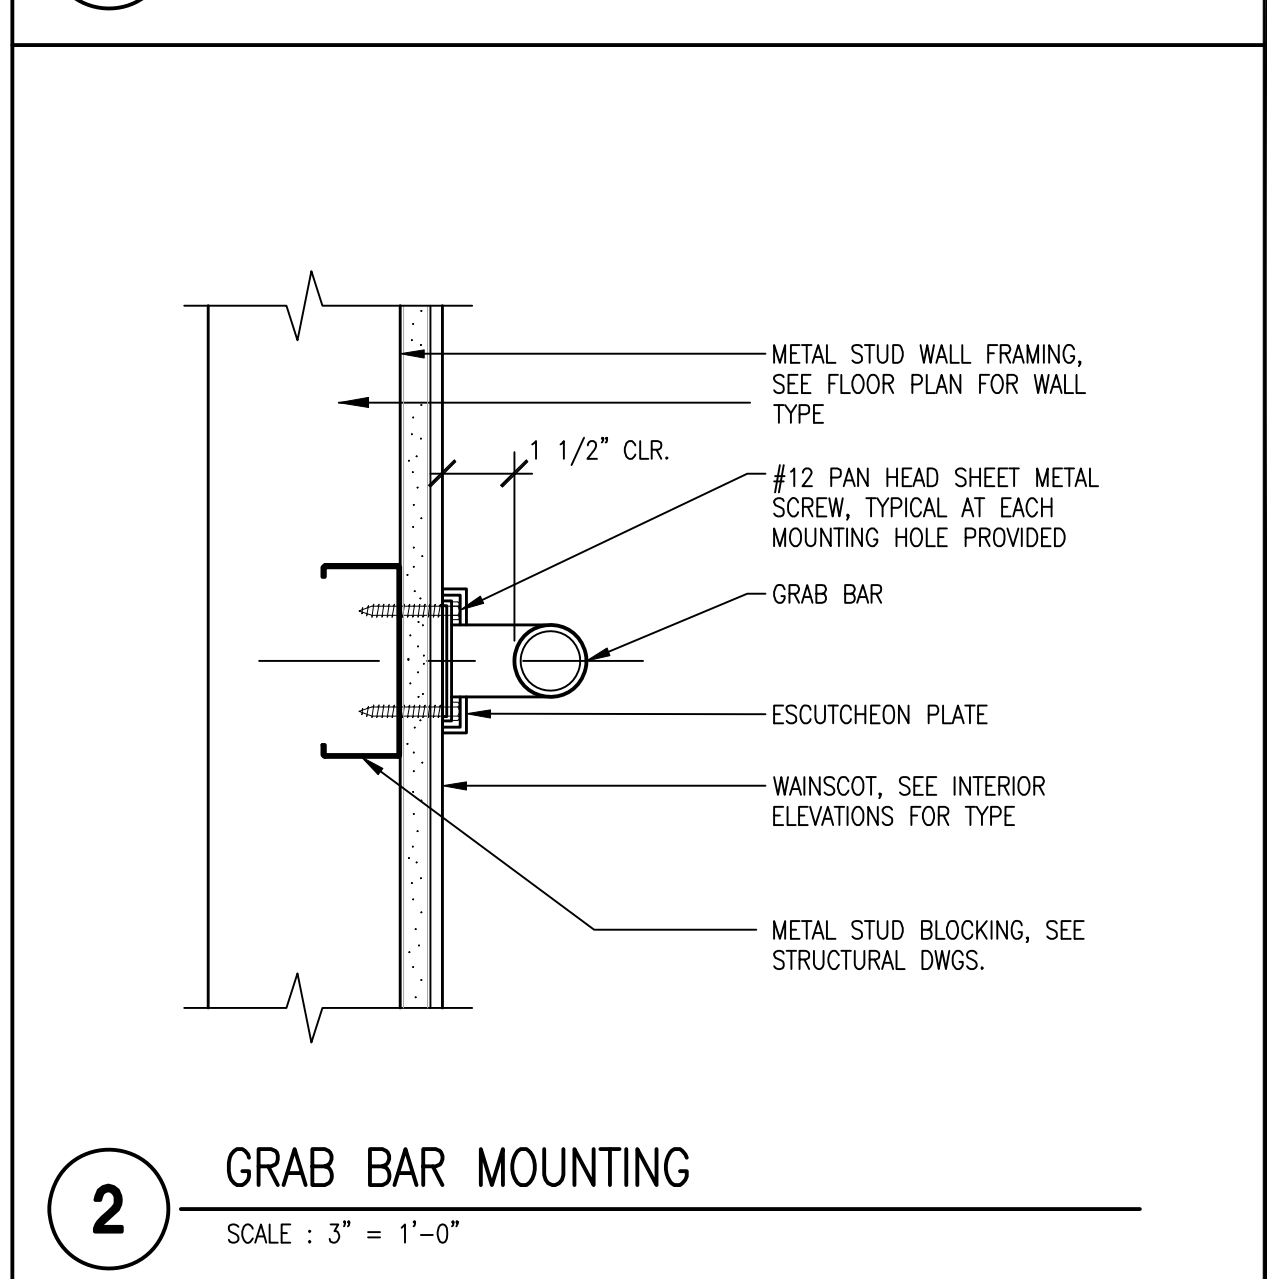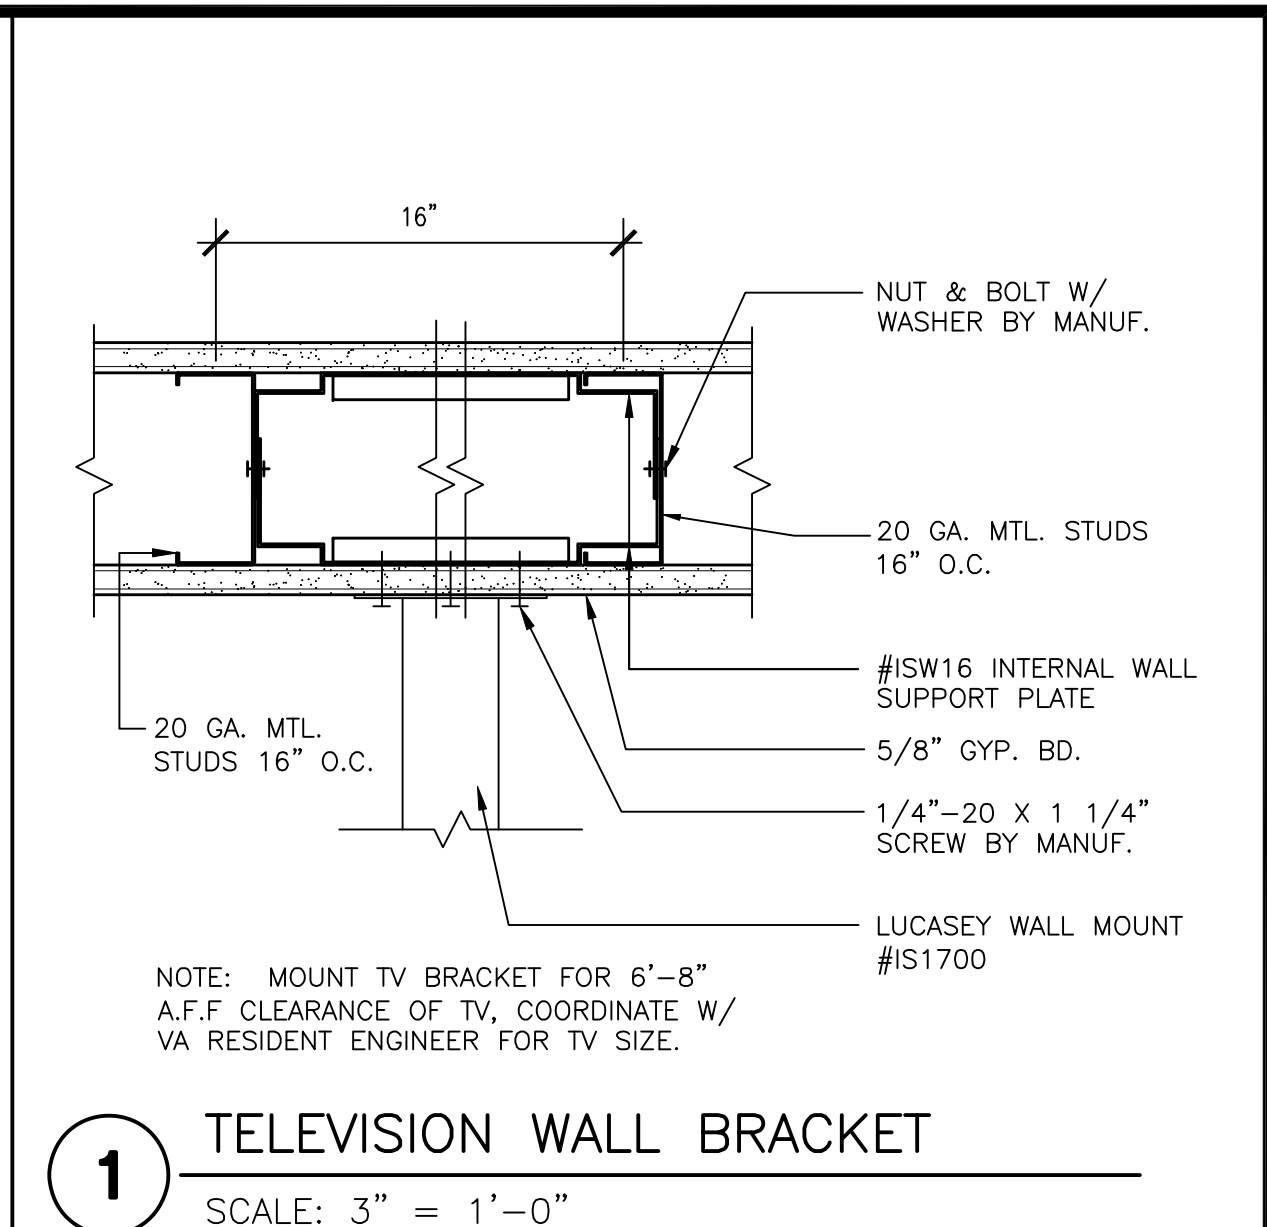


Revisions		Date	<div><div><div>N</div><div>L</div><div>A</div></div><div>nacht & lewis</div><div>ARCHITECTS</div><div>600 Q Street, Suite 100</div><div>Sacramento, Ca 95814</div><div>(916) 329-4000 - www.nlarch.com</div></div>	Design Consultant				Keyplan	Drawing Title		Project Title		Project Number		Office of Facilities Management	
		INTERIOR DETAILS							VA/NCHCS SACRAMENTO MEDICAL CENTER MATHER, CALIFORNIA PHASE 2 - BUILDING 650 RENOVATION		612-101D					
		Scale							Building Name		650					
		Approved MILAN SRSKIC							Location PETER McCUEN BLVD. MATHER, CALIFORNIA		Drawing Number 840					
		Approved							Date 11/7/08		Checked		Drawn			
		FULLY SPRINKLERED														
												Department of Veterans Affairs				

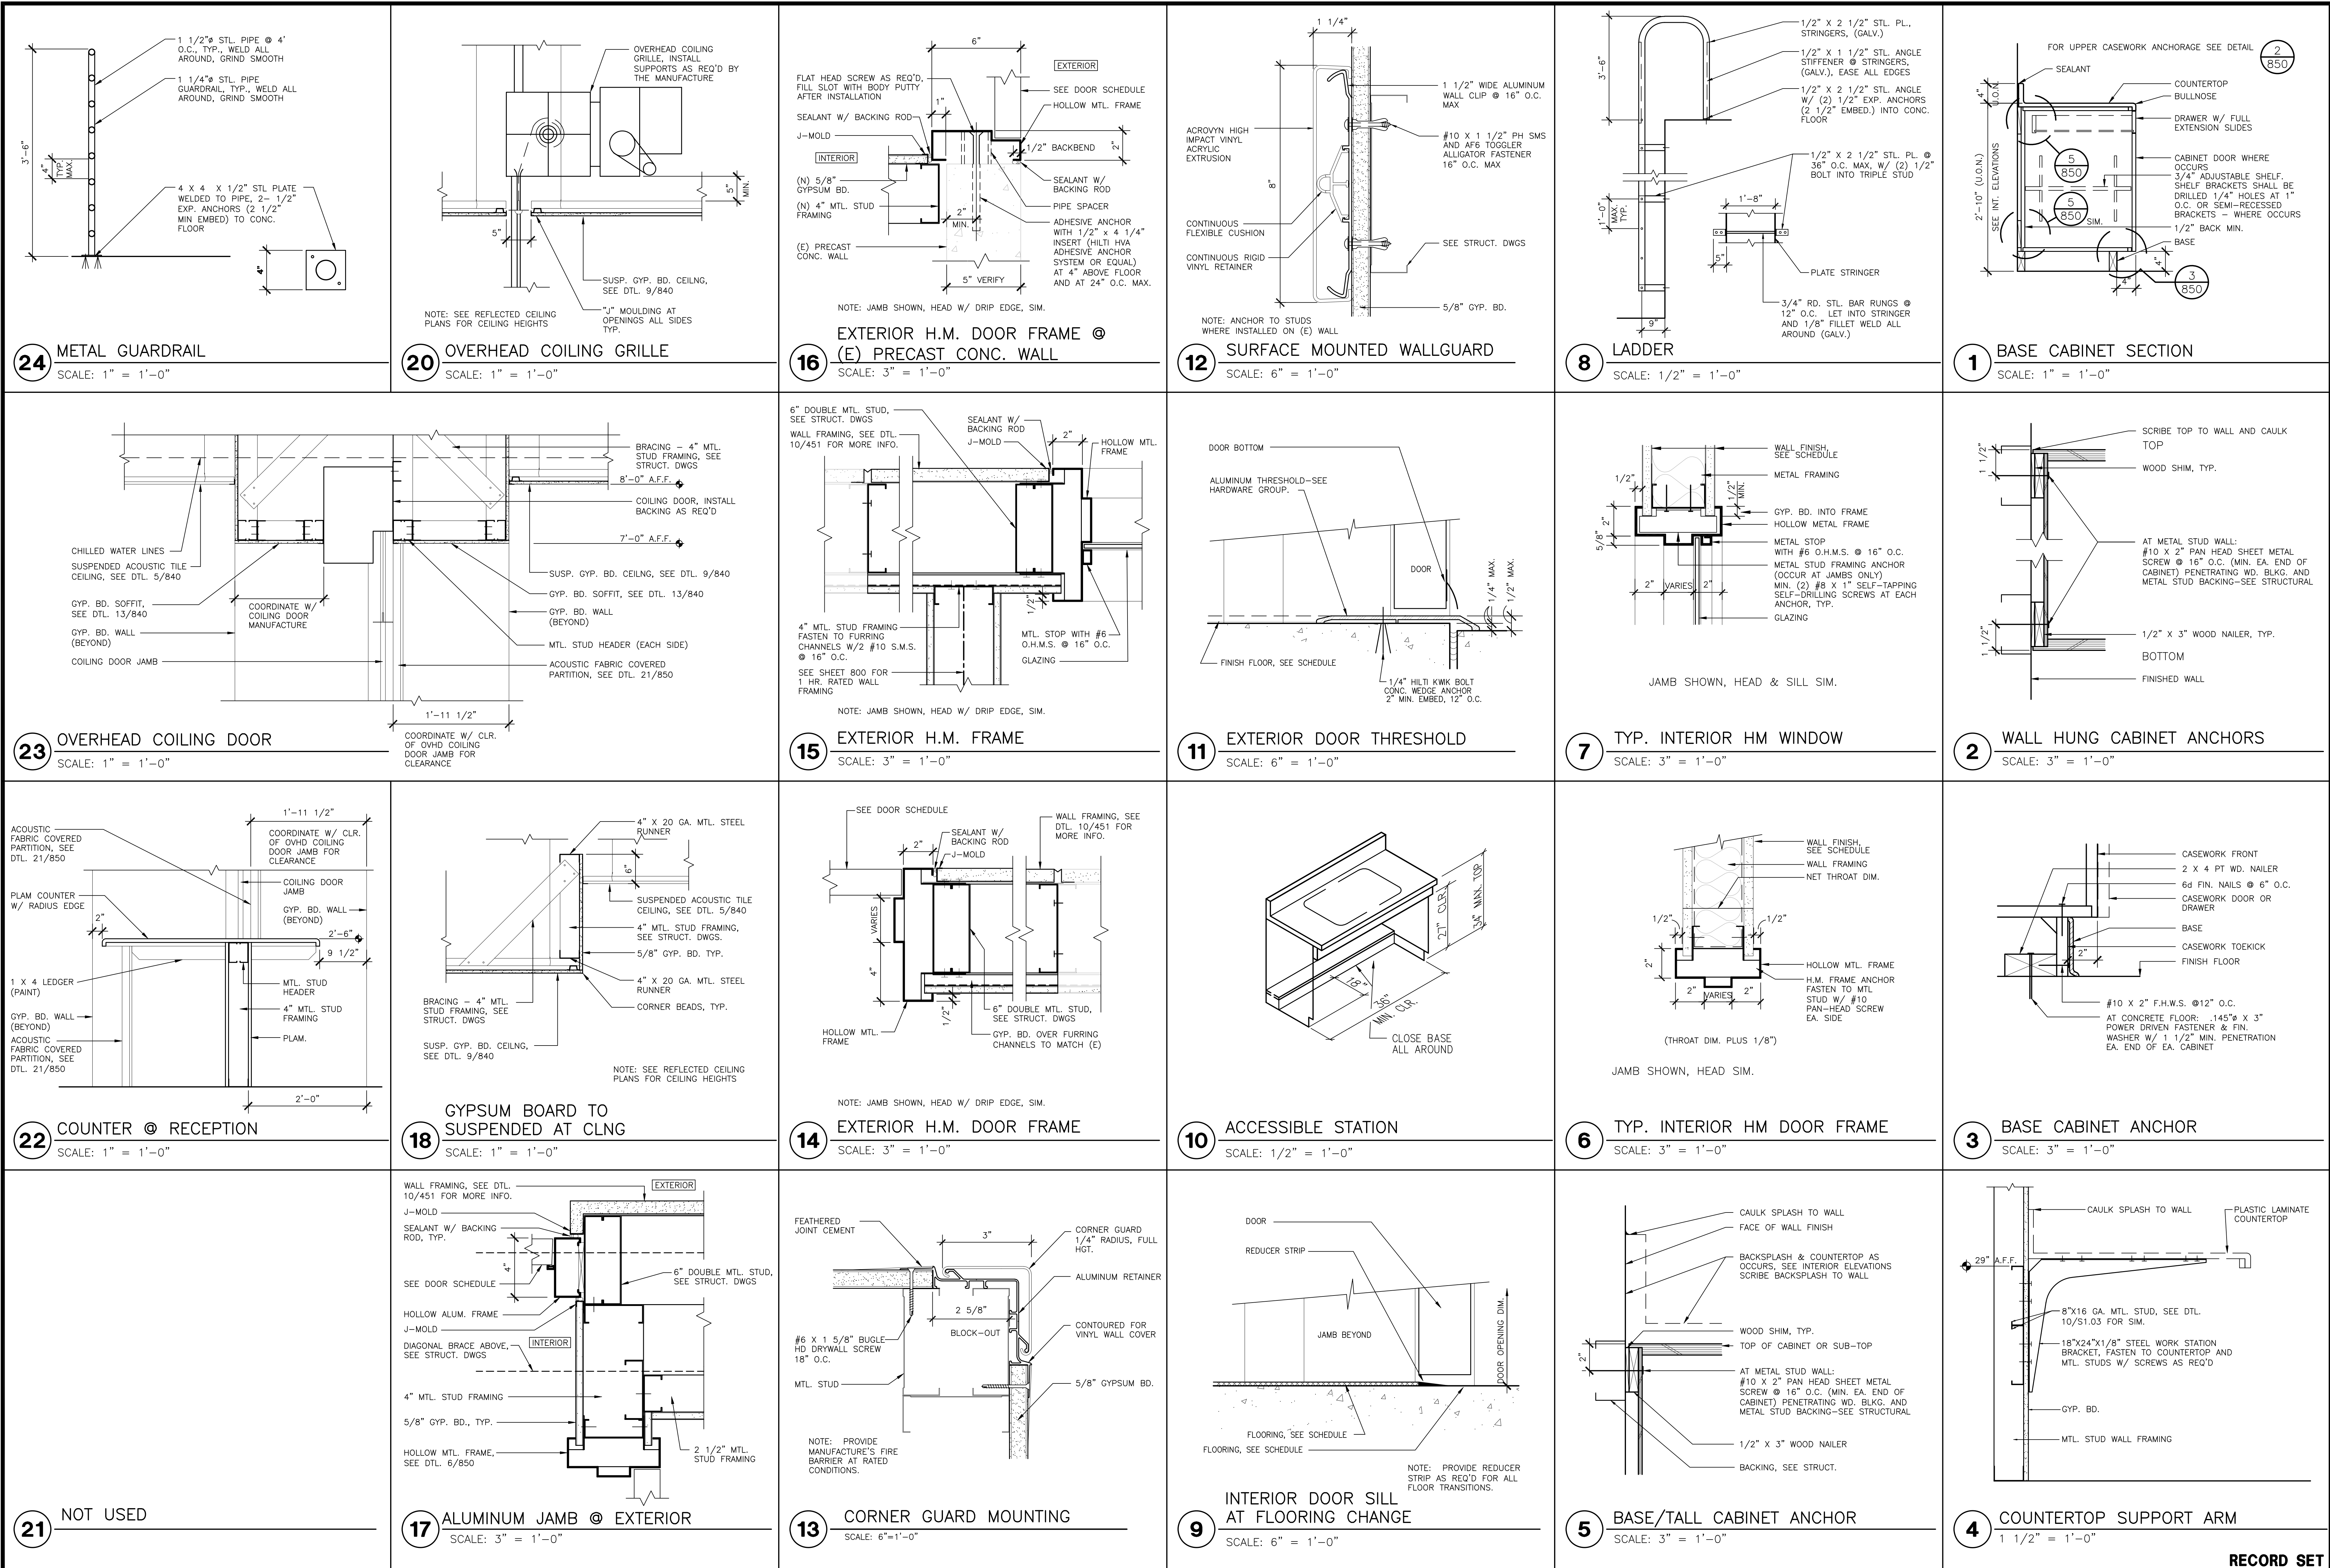

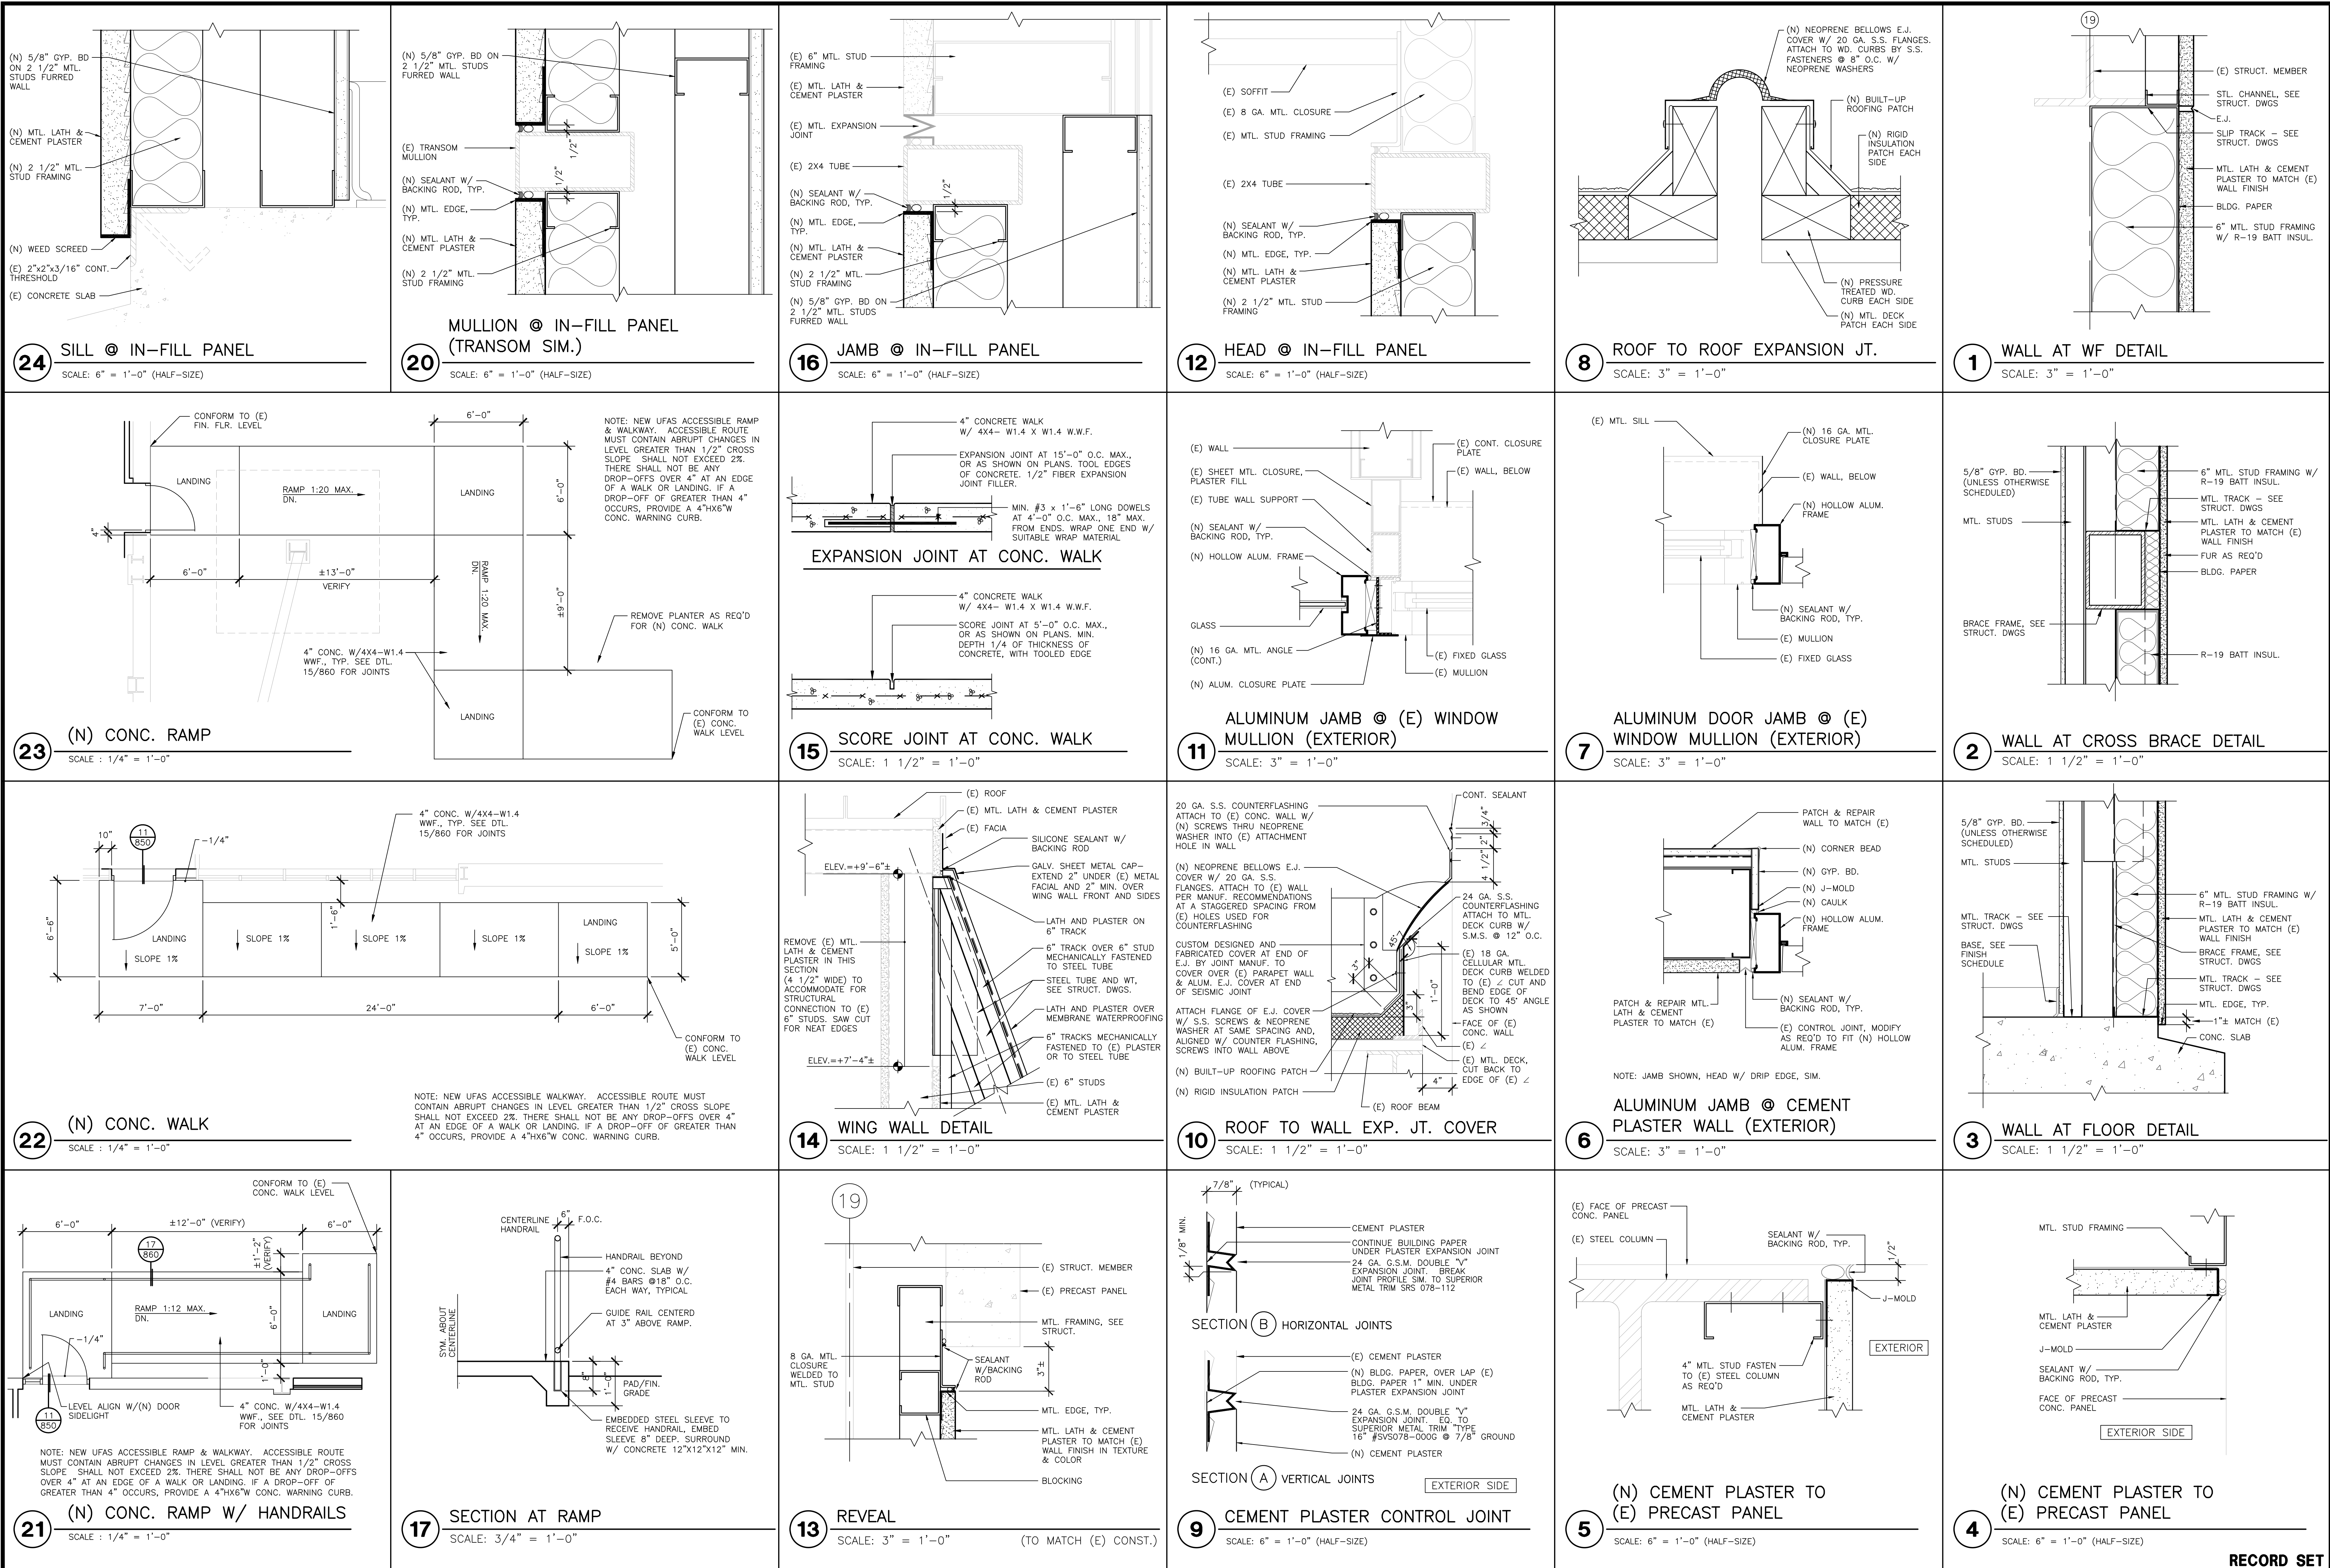

Revisions	Date	Design Consultant	Project Title	Project Number	Building Name	Drawing Number	Scale	Department of Veterans Affairs
			VA/MCHCS SACRAMENTO MEDICAL CENTER MATHER, CALIFORNIA PHASE 2 - BUILDING 650 RENOVATION	612-1010	650	860		
			Location PETER McCUEN BLVD. MATHER, CALIFORNIA	Date 11/7/08	Checked	Drawn		
			Keyplan FULLY SPRINKLERED	Drawing Title EXTERIOR DETAILS	Scale	Approved MILAN SRKIC	Approved	

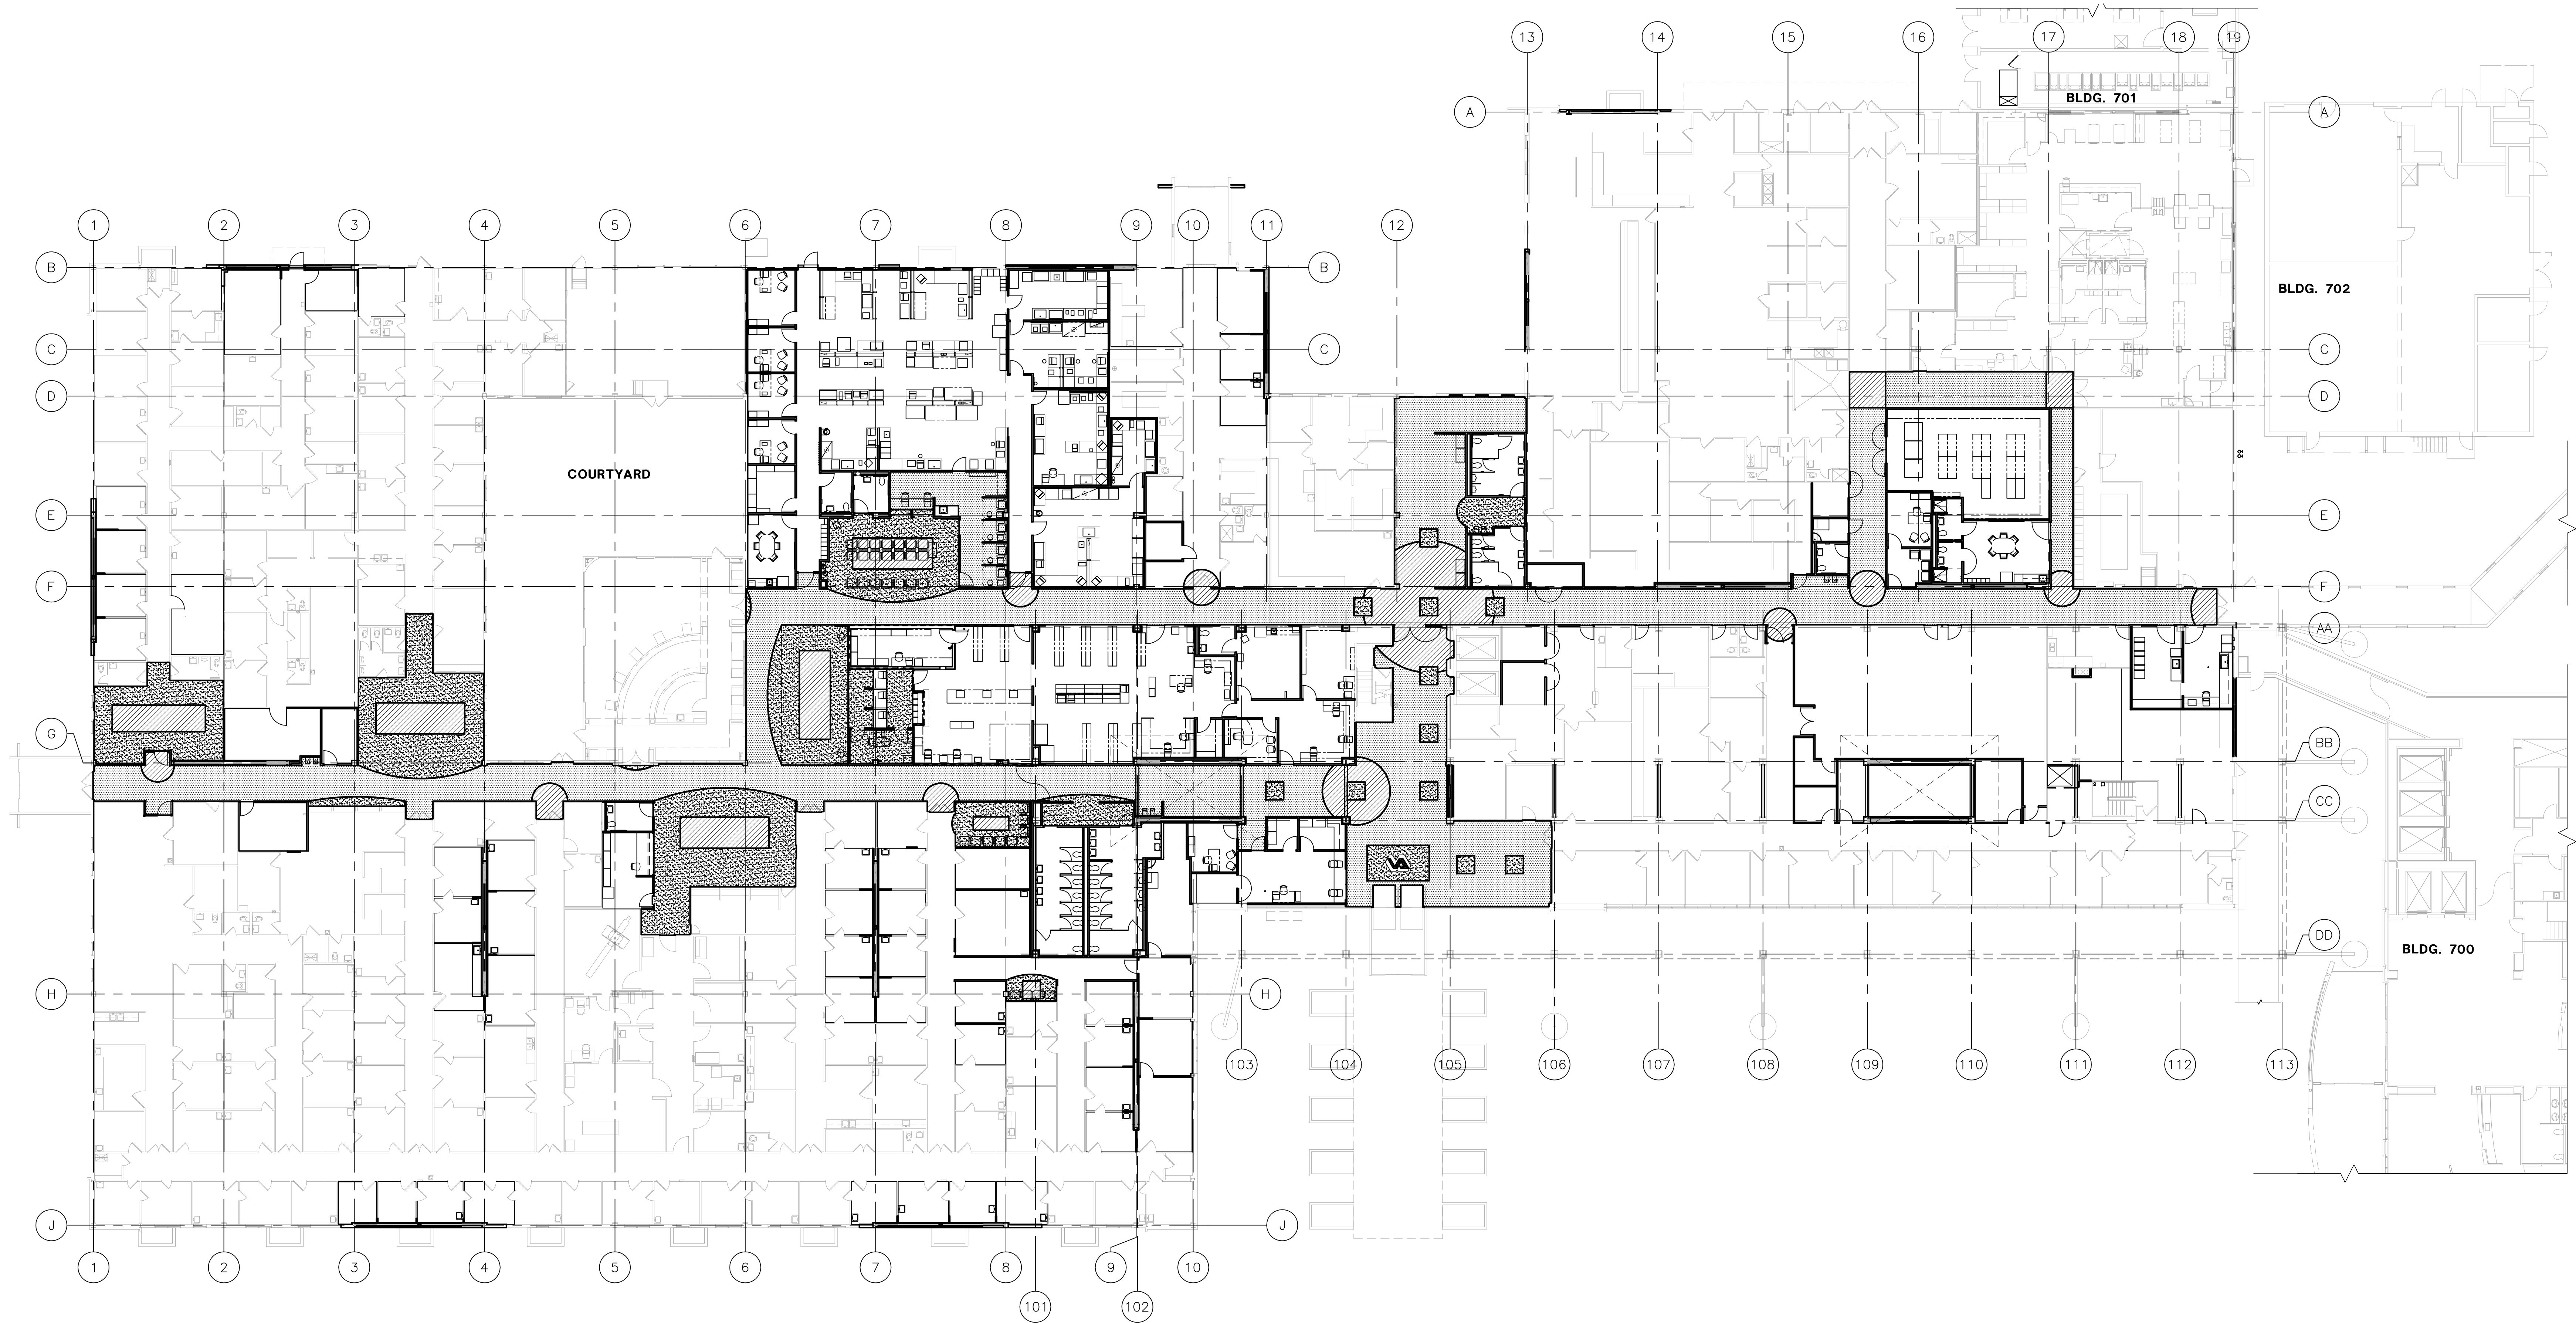

**Overall First Floor Plan
Floor Pattern**
1/16"=1'-0"

W N
S E

LEGEND
THE LEGEND IS APPLICABLE TO THIS SHEET ONLY

- RTF-1
- RTF-2
- RTF-3

Revisions		Date	Design Consultant			Keyplan	Drawing Title	Project Title	Project Number	Office of Facilities Management	
							OVERALL FIRST FLOOR PLAN - FLOOR PATTERN	VA/MCHCS SACRAMENTO MEDICAL CENTER MATHER, CALIFORNIA PHASE 2 - BUILDING 650 RENOVATION	612-1010		
							Scale	Location	Building Name	Department of Veterans Affairs	
							Approved MILAN SRKIC	PETER MCCUEN BLVD. MATHER, CALIFORNIA	650		
							Approved	Date	Drawing Number		
								11/7/08	900		
							FULLY SPRINKLERED	Checked	Scale		
								Drawn			

