


0400	SECRETARY	CS-G-1A	WAITING
0401	CORRIDOR	CS-G-3	CORRIDOR
0401A	EXAM. RM.	CS-G-5	CORRIDOR
0401B	DOCTOR OFF.	CS-G-6	CORRIDOR
0401C	EXAM ROOM	CS-G-6	CORRIDOR
0401D	DOCTOR OFFICE	CS-G-9	CORRIDOR
0401E	H.A.C.	CS-G-9A	VEST
0401F	EQUIP. STOR.	CS-G-10	CORRIDOR
0401G	CAST ROOM	CS-G-10	CORRIDOR
0402	ELEC. RM.	0426	WAITING
0416	CHIEF		
0418	SEC.		
0419	WH. CH. TOILET		
0420	REP. OFFICE		
0422	OFFICE CLERKS		
0425	GENERAL SHOP		
0425A	OFFICE		
0425B	STORAGE		
0424	FITTING ROOM		
0423	ORTHOPEDIC SHOE SHOP		
0421	RESTORATION TREAT.		
0421A	RESTORATION LAB		
0415	STORAGE		
0415A	CLOSET		
0414	CLASSROOM		
0403	MEN'S LOUNGE		
0403A	LOCKERS		
0403B	STAFF MEN'S TOILET & SHOWER		
0409	INTERNS STUDY ROOM		
0413	VEST		
0413A	LOCKERS		
0413B	STAFF WOMEN'S TOILET & SHWR.		
0412	EMPLOYEES LOUNGE		
0410	VEST.		
0410A	LOCKER		
0410B	STAFF MEN'S TOILET & SHWR.		
0411	PM & P. DIET COST ACCT.		
0408	H.A.C.		
0407	BUILDING MEN-T		
0406	KITCHEN		
0429	CHIEF OF PRODUCTION		
0430	H.A.C.		
0431	DETERGENT ROOM		
0428	ISSUE & INGREDIENT CONTROL		
0428A	STAFF TOILET		
0421	SALAD REF.		
0435	STAFF WOMEN'S TOILET SHOWER & LOCKERS		
0404	WOMEN'S LOUNGE		
0437	UNASSIGNED		

NOTE:  
FOLLOW SET D.W.G.  
FOR REF. LINES

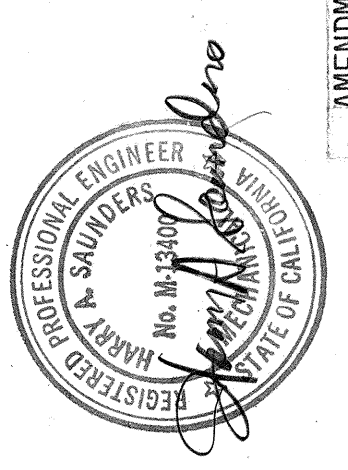

AMENDMENT DRAWING  
GROUND FLOOR PLAN W. CENTER  
PHASE 2 BLDG. 500.

820 BED HOSPITAL BUILDING


VETERANS ADMINISTRATION  
VAH, LOS ANGELES, CALIFORNIA

Drawn: L.M.  
Checked: C.C.  
Date: 7-10-74


AS BUILT  
DRAWING NUMBER  
500-H-19

Charles Luckman Associates  
PLANNING - ARCHITECTURE - ENGINEERING  
228 SUMMIT BLVD. LOS ANGELES, 90009

Approved: [Signature]  
PROJECT DIRECTOR

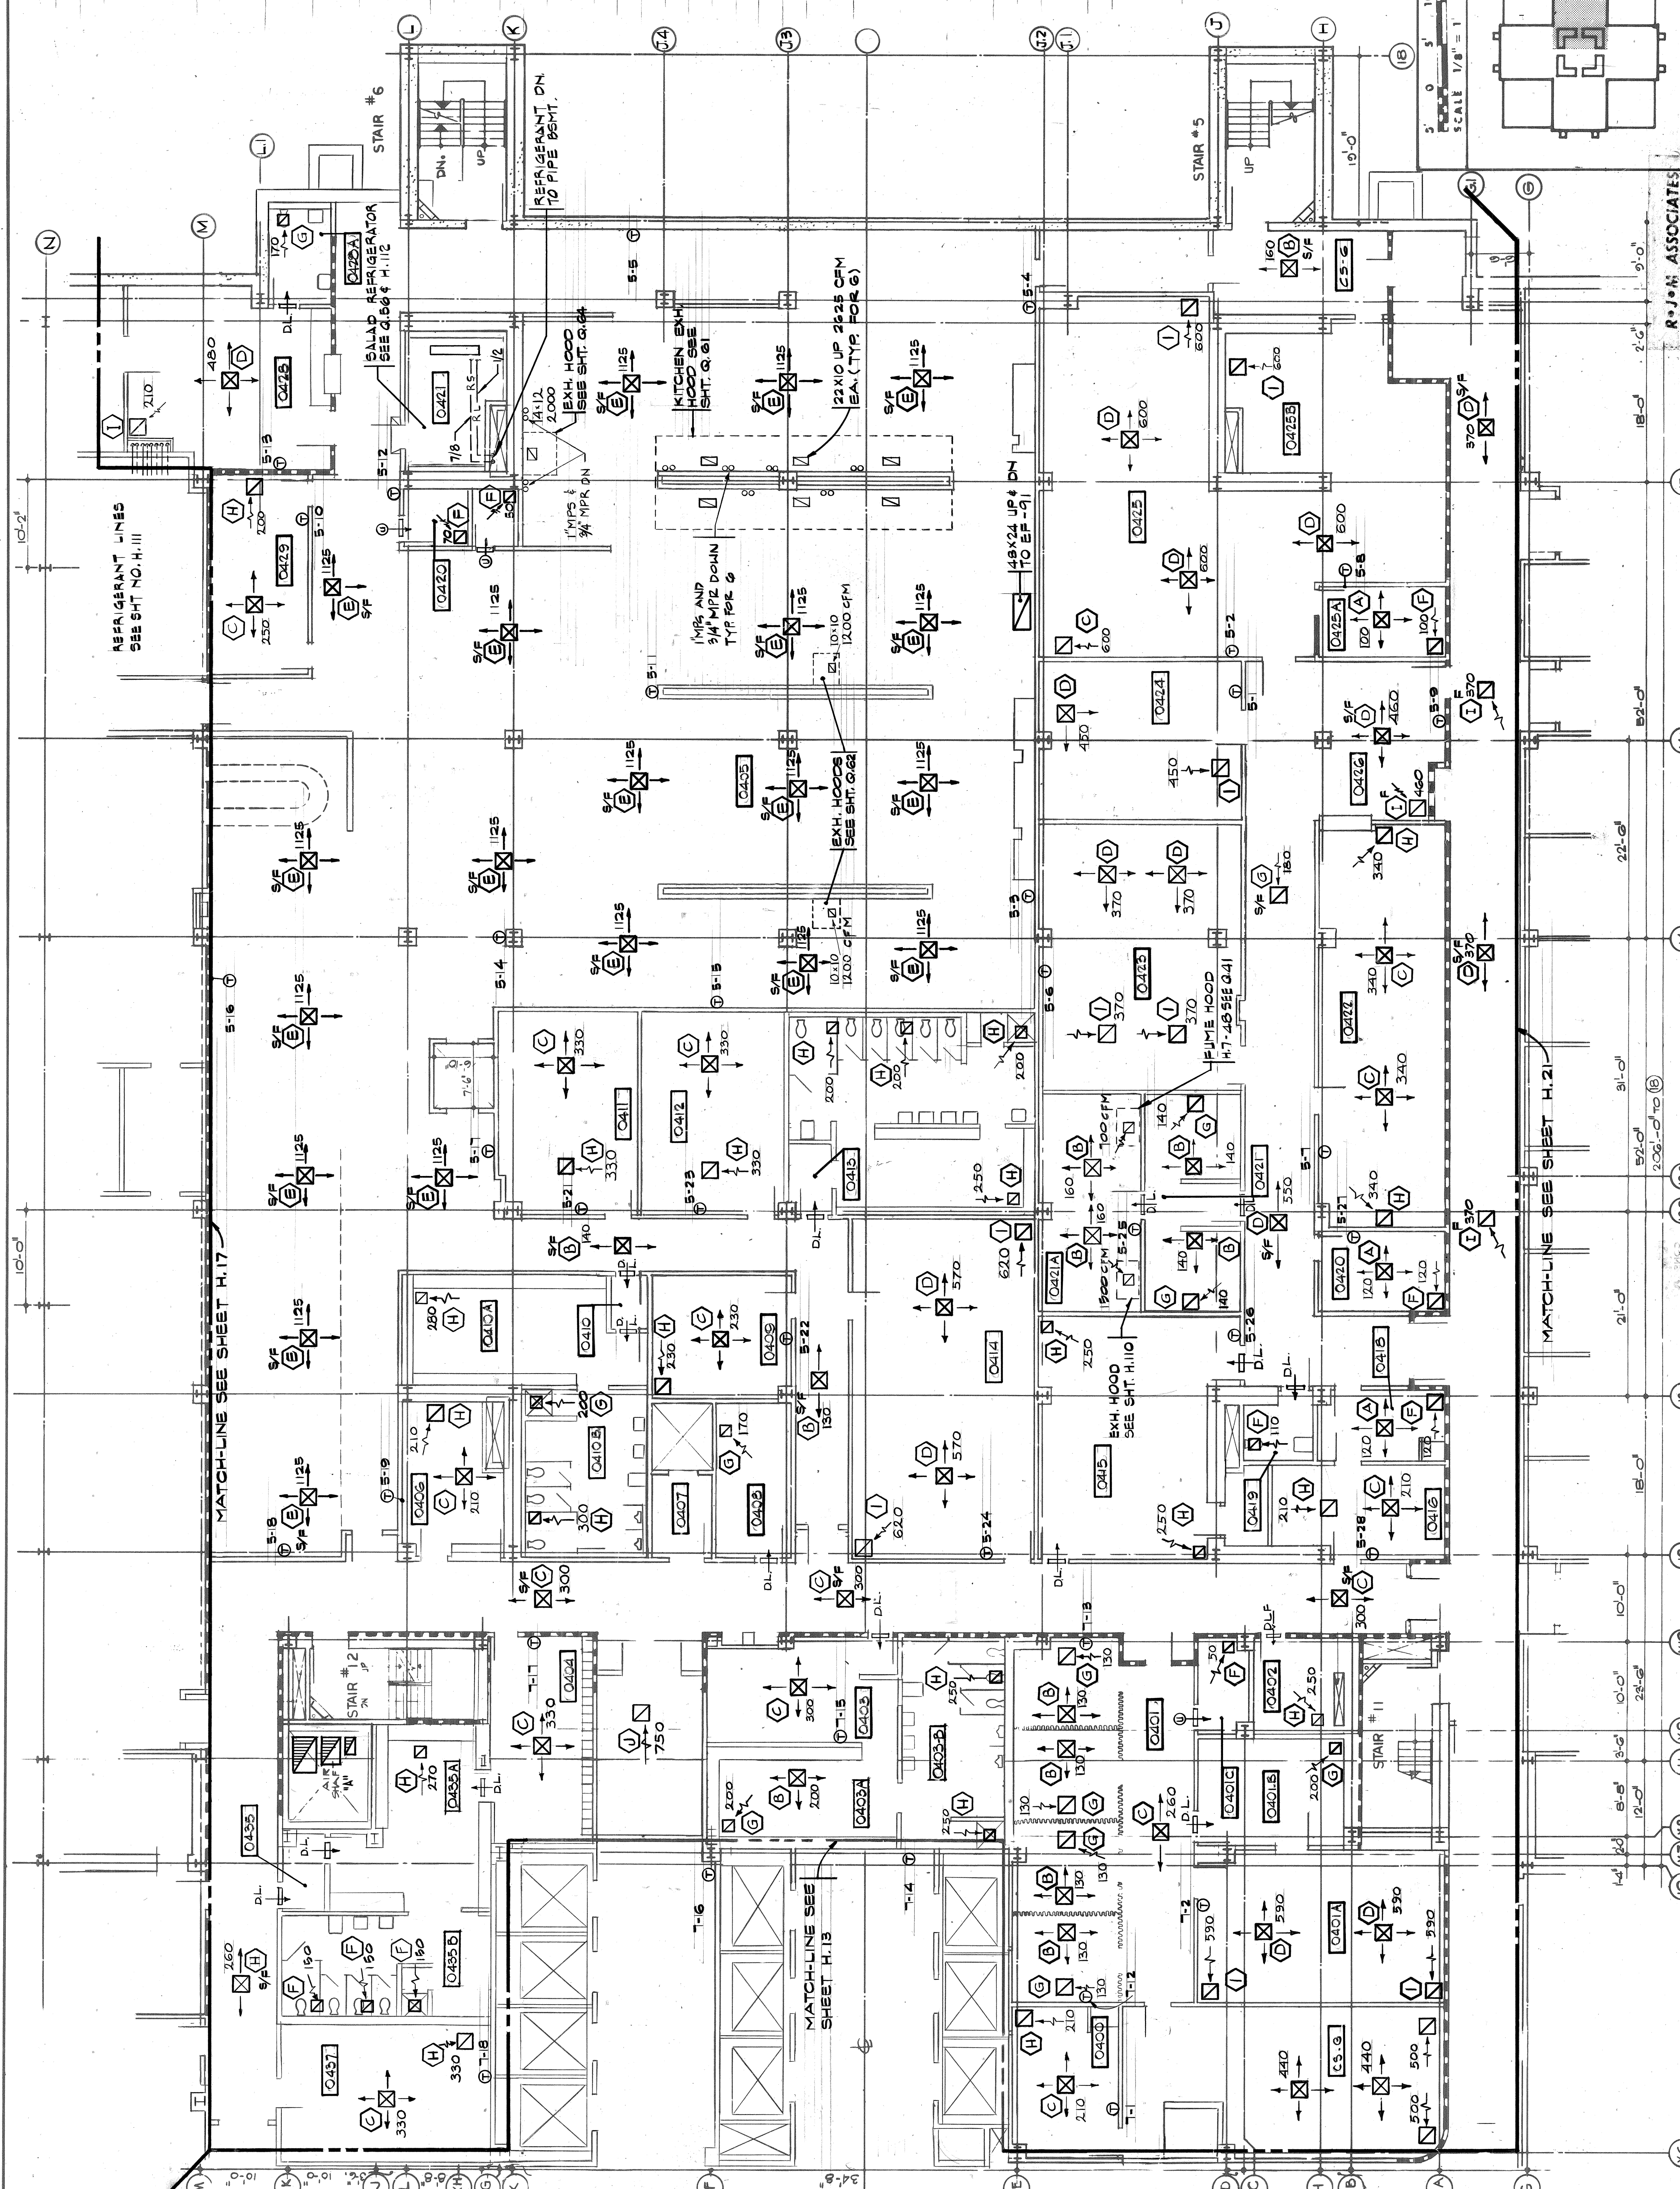

KEY PLAN

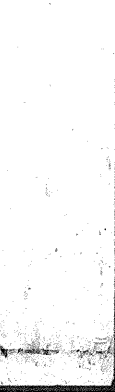

R. J. M. ASSOCIATES  
CONSULTING ENGINEERS  
228 SUMMIT BLVD.  
LOS ANGELES, CALIFORNIA

RETURN TO PLAN LIBRARY

FILE FOLDER NO. 2C