


MECHANICAL KEYED NOTES

1. PROVIDE AN AIR VALVE AS INDICATED ON SCHEDULE. MOUNT VALVE IN DUCTWORK AS RECOMMENDED BY MANUFACTURER. SET VALVE TO CFM NOTED ON PLANS.
2. PROVIDE A HOT WATER COIL AS INDICATED ON SCHEDULE. INSTALL COIL IN DUCTWORK AS RECOMMENDED BY MANUFACTURER. FIELD COORDINATE RIGHT/LEFT CONFIGURATION PRIOR TO ANY CONSTRUCTION.
3. PROVIDE RECTANGULAR TO ROUND TRANSITION AT FLANGE CONNECTION OF HEATING COIL. FIELD VERIFY EXACT DIMENSIONS PRIOR TO ANY CONSTRUCTION.
4. SUPPLY/RETURN/EXHAUST AIR DUCT DOWN TO NECK OF GRILLE. TYPICAL.
5. CONDENSING UNIT SUPPORTED ON STEEL TRAPEZE SUSPENDED FROM EXISTING STRUCTURE.
6. EXISTING HEPA FILTER BANK TO REMAIN.
7. EXISTING EXHAUST FAN FOR ISOLATION ROOM TO REMAIN.
8. ISOLATION ROOM EXHAUST DUCT TO REMAIN.
9. EXISTING EXHAUST LOUVER TO REMAIN.
10. SUPPLY DUCT BETWEEN FILTER AND FAN. PROVIDE MAINTENANCE CLEARANCE FOR EXISTING EQUIPMENT.
11. PROVIDE GRATING FOR MAINTENANCE PLATFORM. SUSPEND FROM STRUCTURE.
12. REBALANCE EXHAUST TO PROVIDE 1900 CFM. RESHAPE FAN, REPLACE BELTS.
13. REPLACE OUTSIDE AIR DUCT IF REQUIRED TO FIT NEW DUCTWORK IN SPACE. DUCT CAN BE REUSED. INSULATE EXISTING OR NEW DUCT.
14. BALANCE OUTSIDE AIR TO 375. REBALANCE AIR TO EACH EXISTING FAN COIL TO 75 CFM EACH FOR ROOMS. REBALANCE OUTSIDE AIR HANDLER, REMOVING OUTSIDE AIR QUANTITY OF AREA 5B EXCEPT 375 CFM.

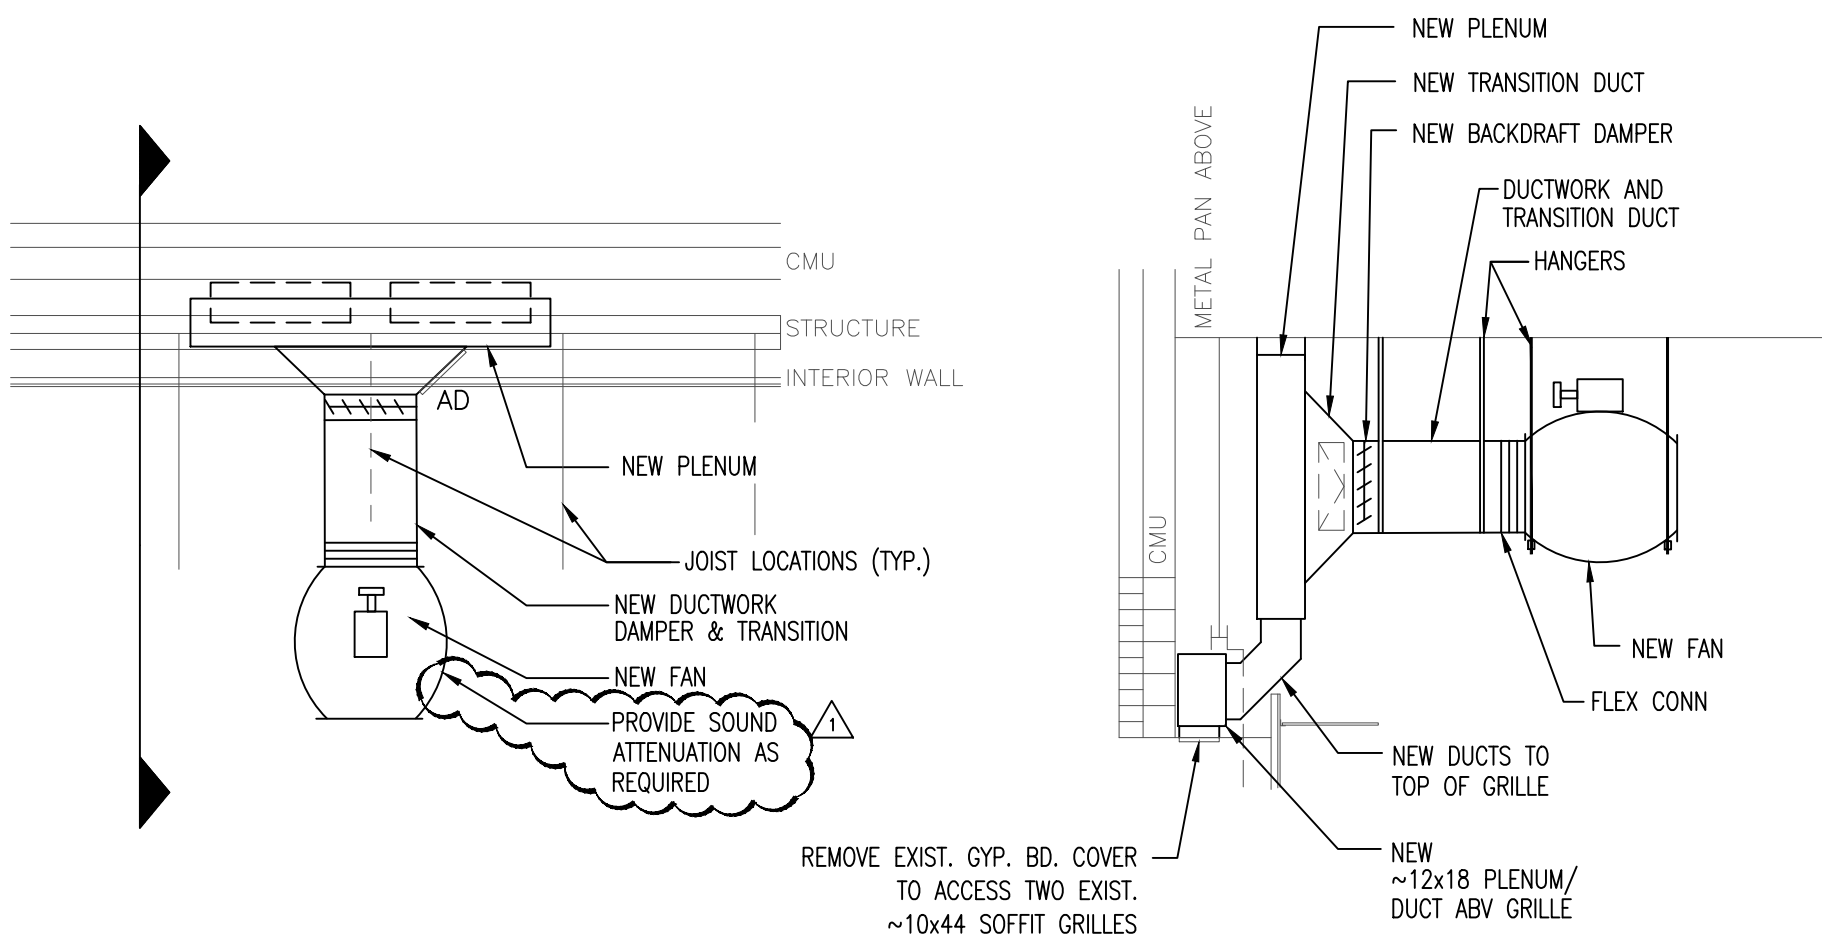


PLAN

SECTION


2 EXHAUST FAN SECTION  
H 22 SCALE: 1/4" = 1'-0"

1 FIFTH FLOOR-INTERSTITIAL - MECHANICAL - NEW WORK  
H 22 SCALE: 1/8" = 1'-0"

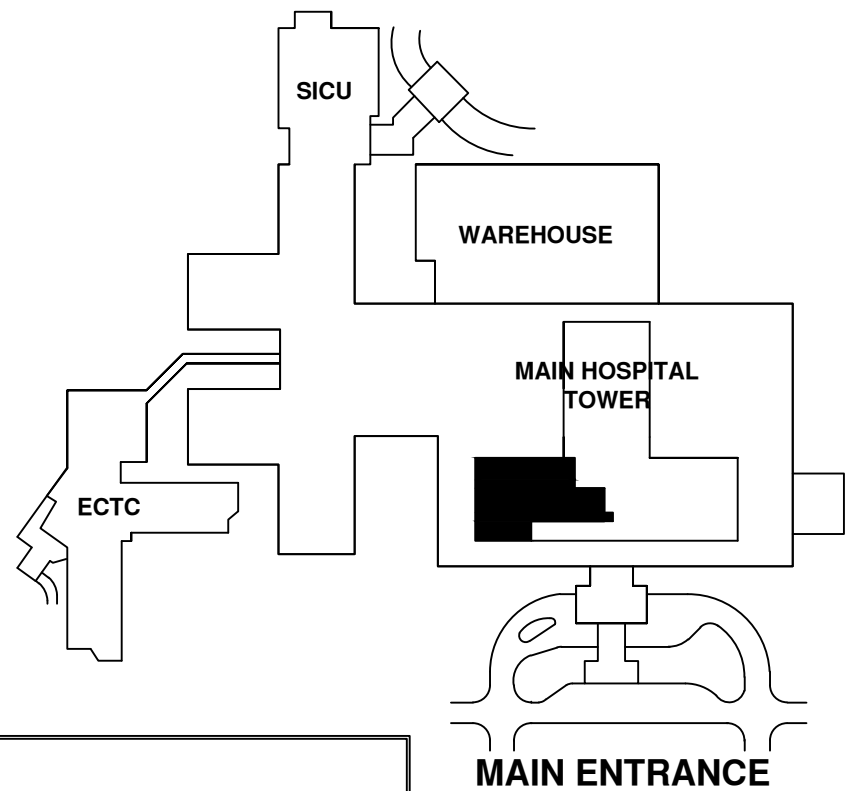

AS-BUILT DOCUMENTS

DATE: AUGUST 1, 2010  
THESE AS-BUILT DOCUMENTS HAVE BEEN PREPARED BASED ON INFORMATION PROVIDED BY THE CONTRACTOR UTILIZING PERSPECTIVE DEVELOPMENT. THE ARCHITECT/ENGINEER HAS NOT VERIFIED THE ACCURACY AND/OR COMPLETENESS OF THIS INFORMATION AND SHALL NOT BE RESPONSIBLE FOR ANY ERRORS OR OMISSIONS THAT MAY BE INCORPORATED AS RESULT OF INCOMPLETE INFORMATION PROVIDED BY THE CONTRACTOR.

<div>CHANGED DURING CONSTRUCTION - FIELD CHANGE</div> <div>Revisions</div> <div>Date</div>	<div>Alderson &amp; Associates, Inc.</div> <div>Consulting Engineers</div> <div>8415 Delapoint Dr.</div> <div>Suite 725</div> <div>San Antonio, TX 78229</div> <div>Phone (210) 614-1110</div> <div>Fax (210) 615-8549</div> <div>© 2010 Alderson and Associates Inc</div> <div>F-1008</div>	<div>WESTEAST DESIGN GROUP</div> <div></div> <div>1617 E. COMMERCE ST., SUITE 7102, SAN ANTONIO, TEXAS 78205 USA</div> <div>210.530.0755 FAX 210.530.9427</div> <div>These documents can not be copied or reproduced without written consent from WestEast Design Group</div>	<div>Project Title</div> <div>MECHANICAL NEW WORK</div> <div>5TH FLOOR INTERSTITIAL</div> <div>Approved: Director Project Management</div>	<div>Drawing Title</div> <div>MECHANICAL NEW WORK</div> <div>5TH FLOOR INTERSTITIAL</div>	<div>Project Title</div> <div>RENOVATE &amp; EXPAND</div> <div>WARDS PHASE II</div> <div>UNIT 5B</div> <div>Building Number</div> <div>1</div> <div>Checked</div> <div>DTA</div> <div>Drawing</div> <div>EGM</div> <div>Location</div> <div>Audie L. Murphy Memorial Veterans Hospital</div> <div>San Antonio, Texas</div>	<div>Date</div> <div>AUG 1, 2010</div> <div>Project No.</div> <div>671-047B</div> <div>DRAWING NO.</div> <div>H 2.2</div> <div>Dwg 31 of 65</div>	<div>Office Of Facilities</div>	<div>Department of Veterans Affairs</div>
--	--	--	--	---	--	---	---------------------------------	---