


SECOND FLOOR
ELECTRICAL ROOM EE-200

SCALE: 1/4"=1'-0"

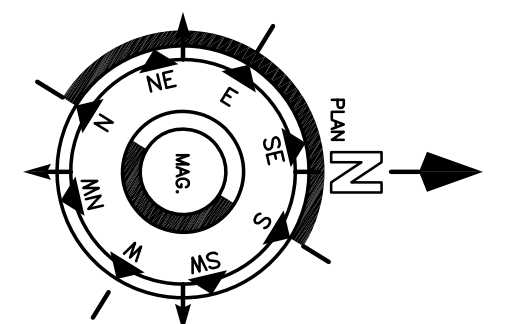

AS-BUILT SET

Revisions		Date	
ENGINEER:			
GARY TRAVINSKI ASSOCIATES Engineering Consultants HERMAN A. HANEMANN, JR. REGISTERED PROFESSIONAL ENGINEER No. 10892-E Professional Seal			
94 BOSTON HILL - LARKSPALE, PENNSYLVANIA 18651 - Telephone: (570) 779-7843 - WWW.GTAENG.COM			
Drawing Title		Project Title	
ELECTRICAL ROOM EE-200 - NEW		REPLACE ELECTRICAL SWITCHGEAR	
Approved: Project Manager EMILY McDONALD		Building Number 01	
Approved: Service Chief SUSAN LANG		Checked D.A.O.	
Location PENNYSYLVANIA		Drawn D.A.O.	
Date 01-28-11		Project No. 562-07-101	
Drawing No. E-3.3		Dwg. ____ of ____	
VA Department of Veterans Affairs			