



1
A.4 EXTERIOR ELEVATION
SCALE: 1/4"=1'-0"


GENERAL NOTE:
SEE STRUCTURAL DRAWINGS FOR
FOUNDATION PLAN AND DETAILS.

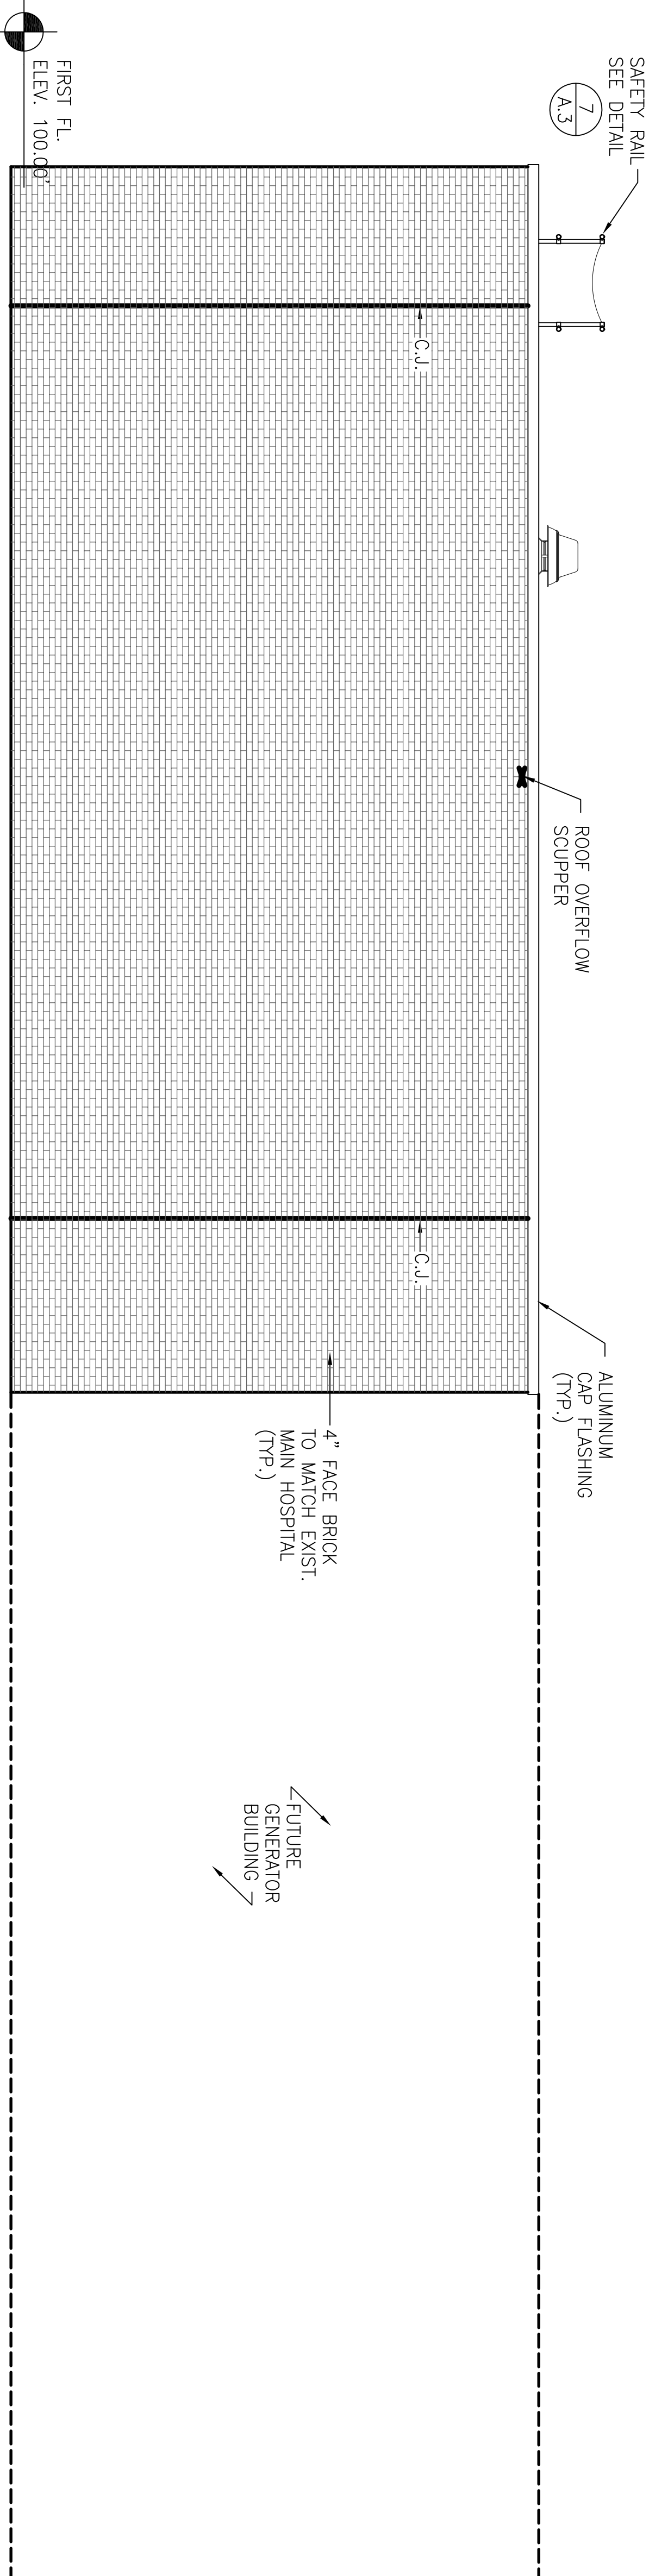

3
A.4 EXTERIOR ELEVATION
SCALE: 1/4"=1'-0"

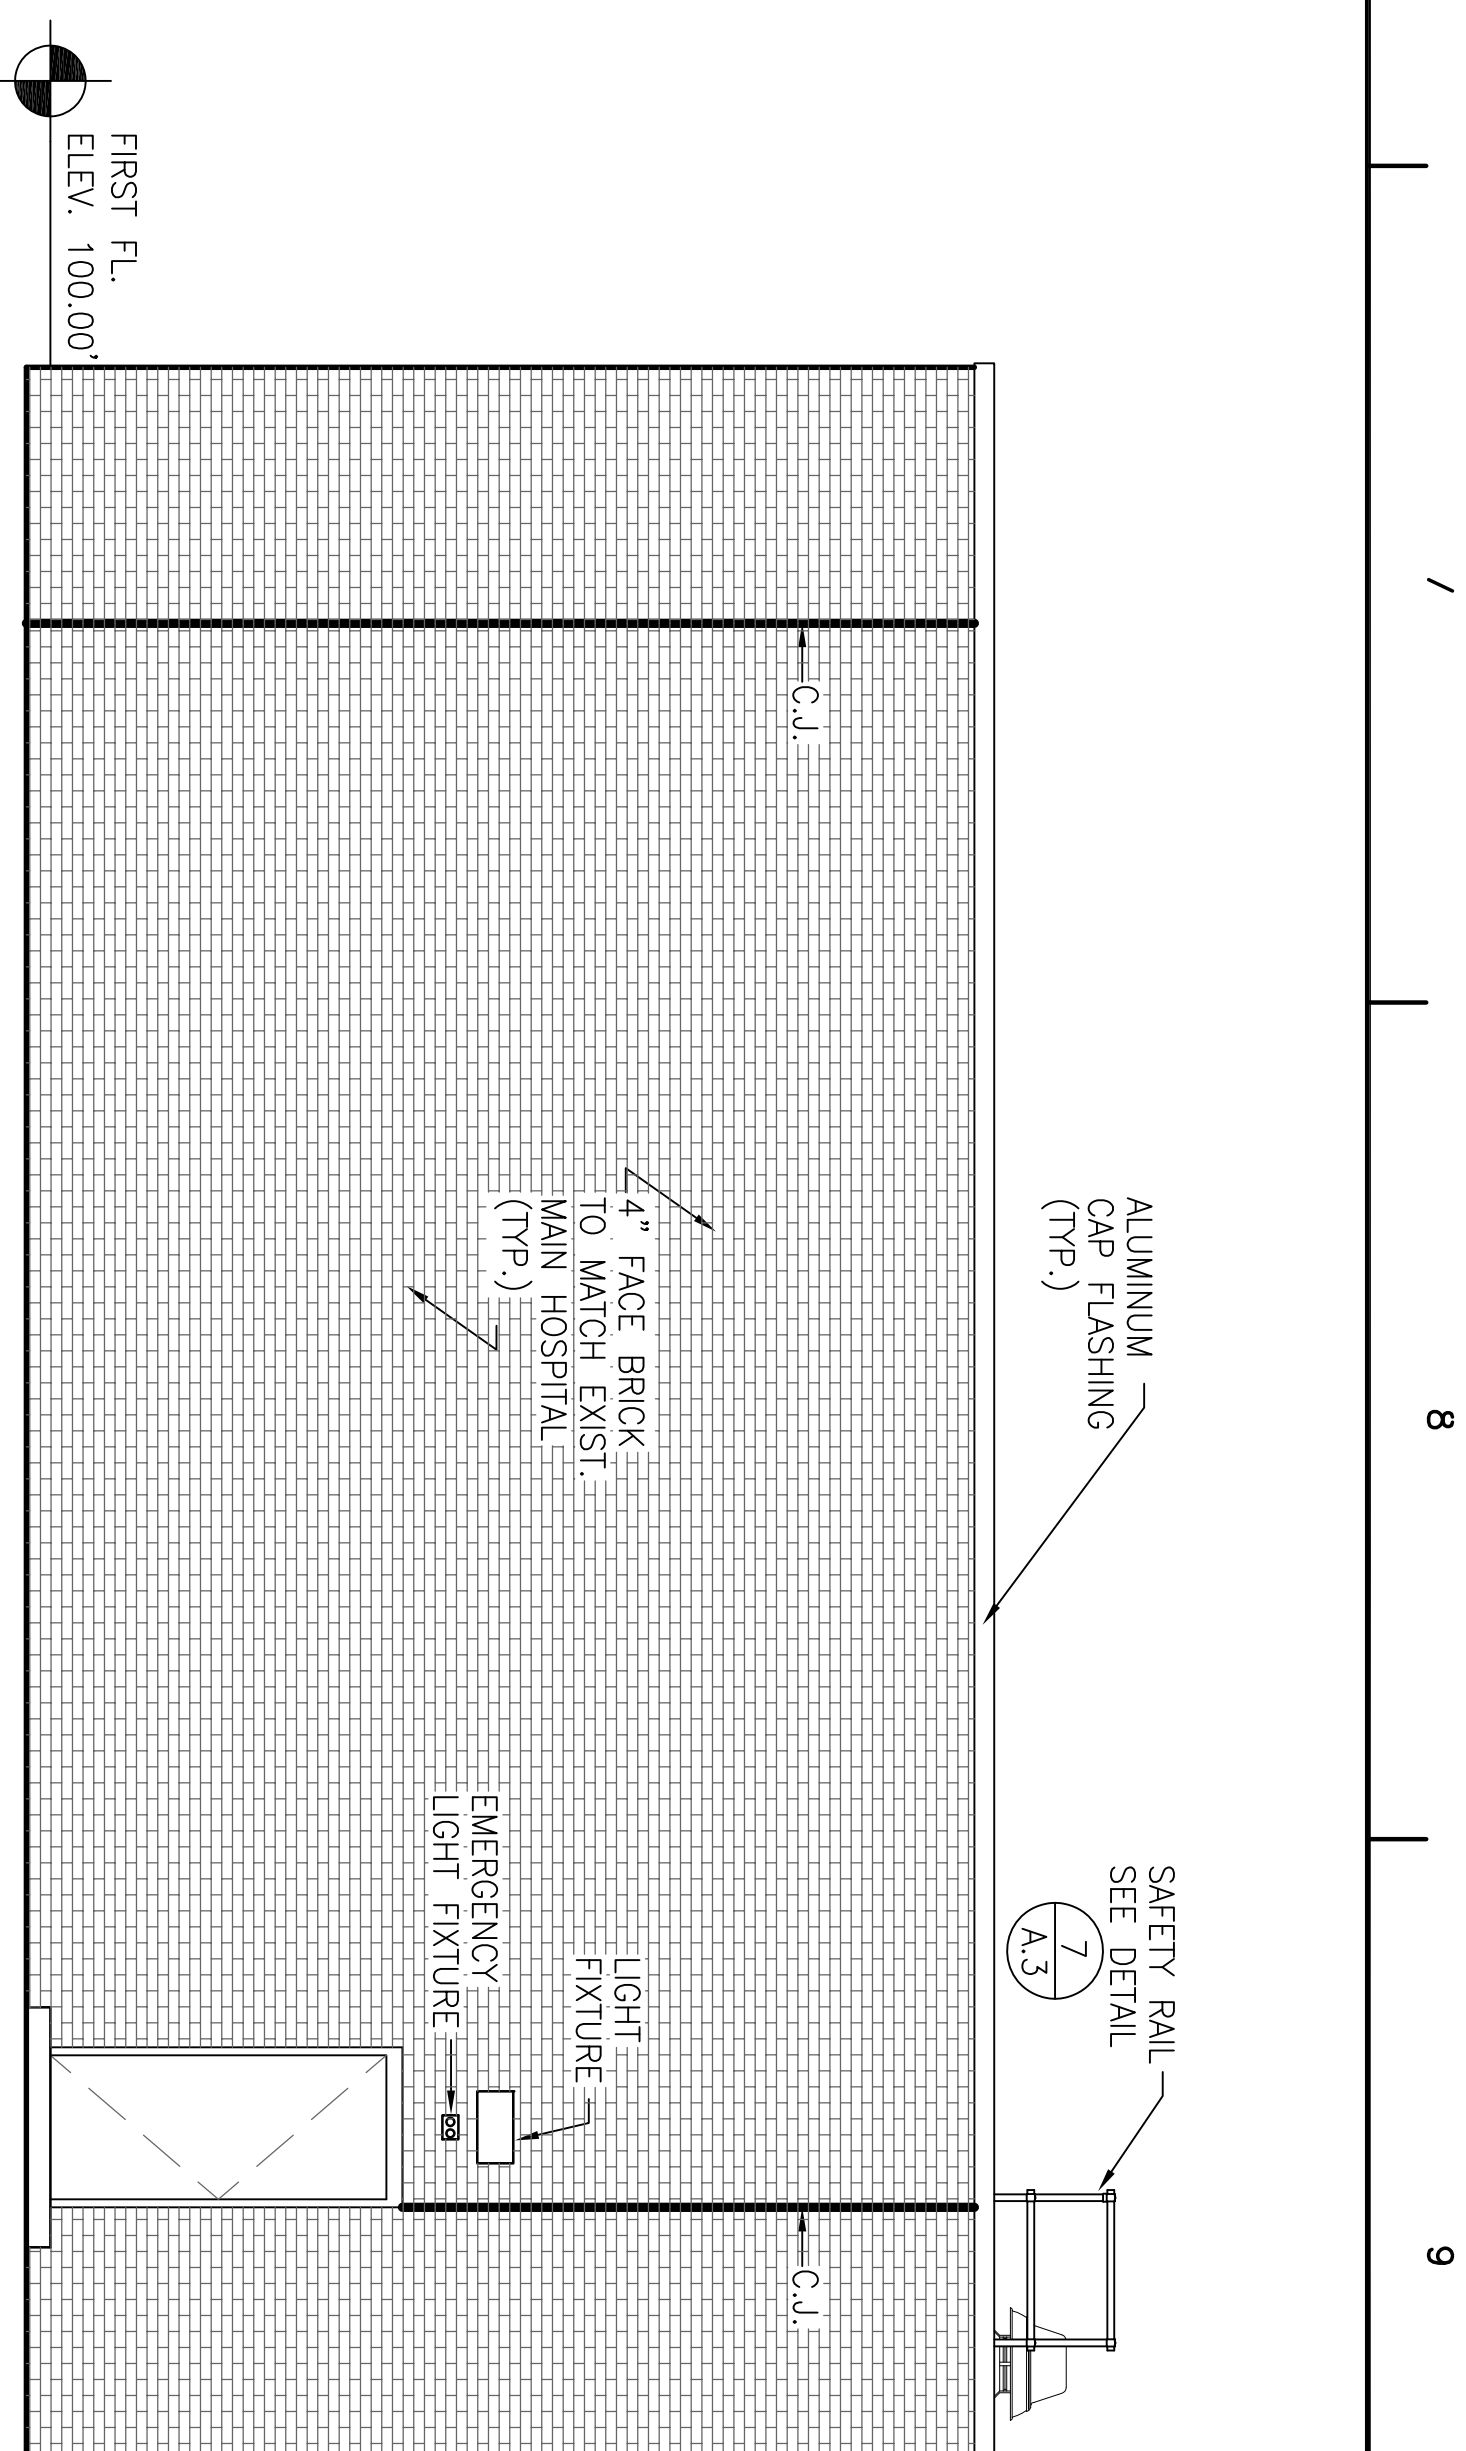

2 EXTERIOR ELEVATION
A.4 SCALE: 1/4"=1'-0"

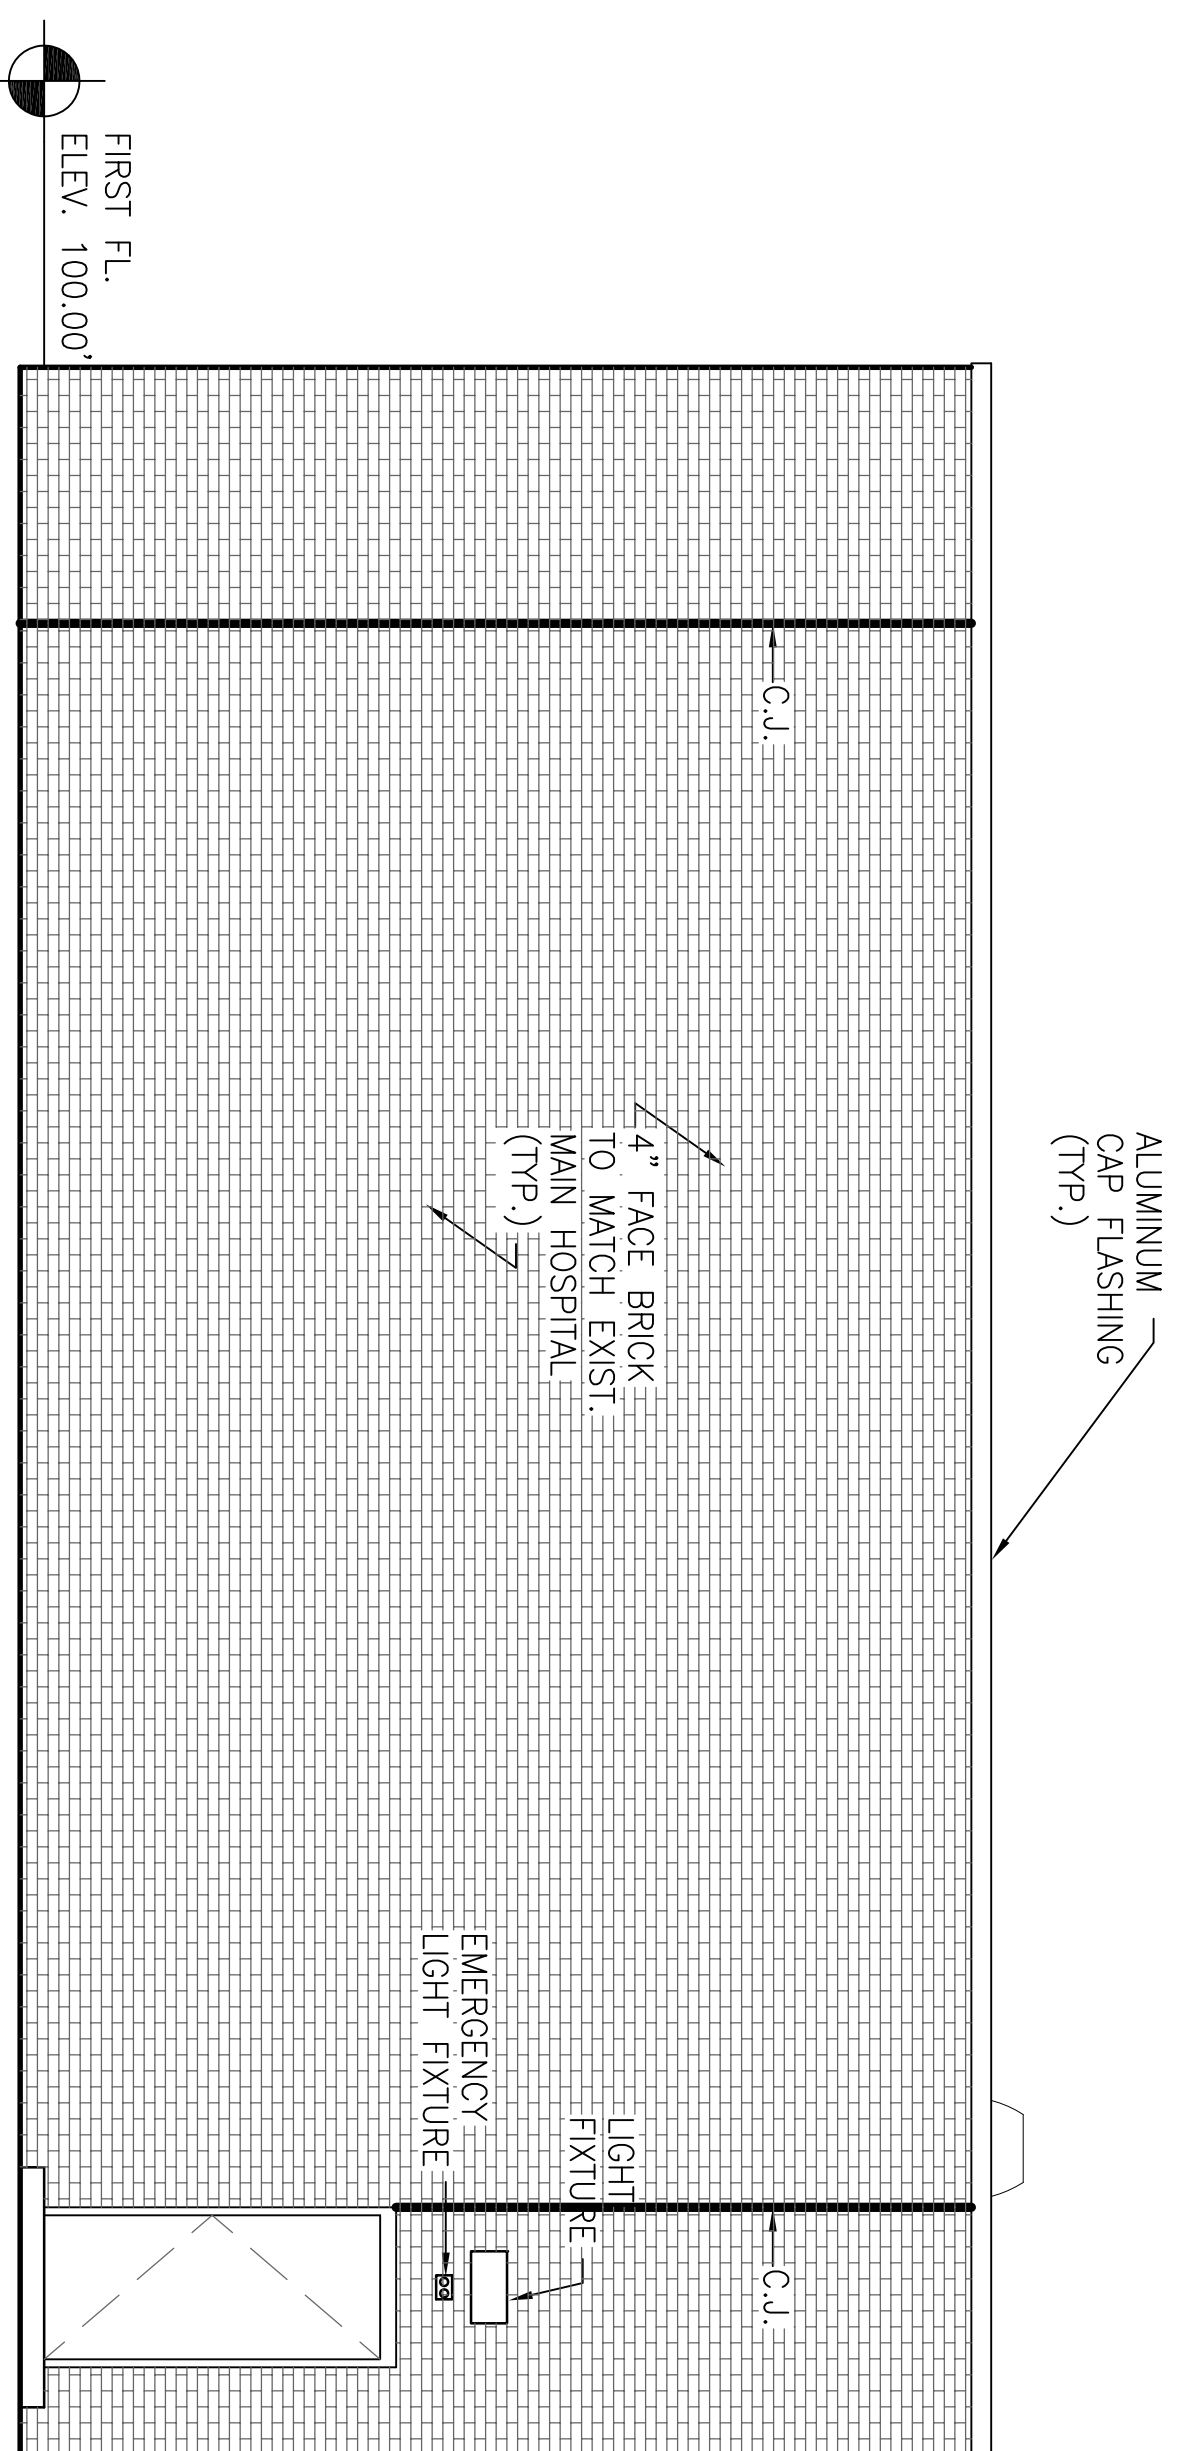

4
A.4 EXTERIOR ELEVATION
SCALE: 1/4"=1'-0"

[illegible]

Karasinski ARCHITECTURE pc


14 PRIESTLY STREET
WILKESHAIRE, PA 18702
TEL 570-829-4220
F 570-829-4122
www.karasinskiarchitecture.com

ARCHITECTURE
INTERIOR ARCHITECTURE
HISTORIC PRESERVATION
PLANNING

ARCHITECTURE
INTERIOR ARCHITECTURE
HISTORIC PRESERVATION
PLANNING

Professional Seal

GARY TRAVINSKI ASSOCIATES
Engineering Consultants




94 Boston Hill - Larksville, PA 18651
Tel: 570-779-7843 Fax: 570-779-7851
www.gtaengs.com

94 Boston Hill - Larksville, PA 18651
Tel: 570-779-7843 Fax: 570-779-7851

Drawing Title
EXTERIOR ELEVATIONS
Approved: Project Manager EMILY McDONALD
Approved: Service Chief SUSAN LANG

Project Title		
REPLACE ELECTRICAL SWITCHGEAR		
Building Number	Checked LPK	Drawn KJK
ALL		
Location		
WAMC, ERIE PENNSYLVANIA		

Date	1-28-11
Project No.	562-07-101
Drawing No.	A.4

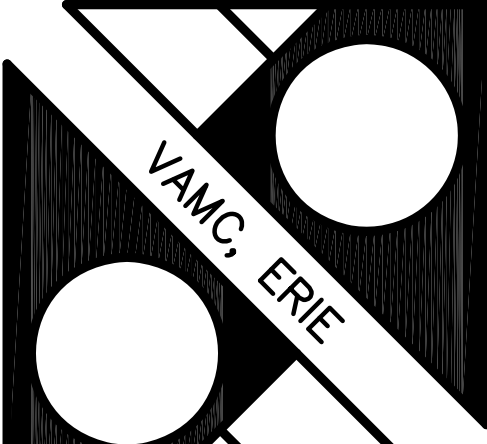

Department of
Veterans Affairs

AS-BUILT SET