
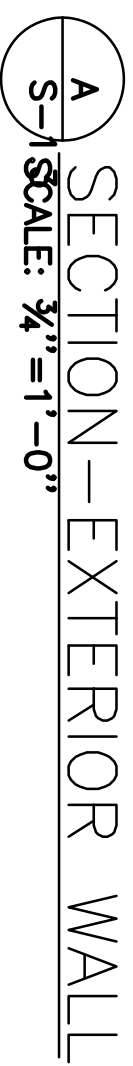


AS-BUILT SET

[illegible]


QPROQ ENGINEERING, INC.
187 NORTH MAIN STREET WILKES BARRE, PENNSYLVANIA 18702
570-823-9035

RESIDENTIAL	GOVERNMENT	INDUSTRIAL
INSTITUTIONAL		COMMERCIAL

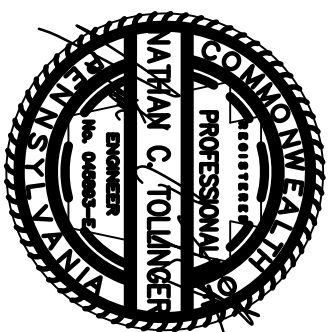

Professional Seal

ENGINEER:

GTA 
ENGINEERING
COMMISSIONING
PROJECT MANAGEMENT

GARY TRAMANSKI ASSOCIATES
Engineering Consultants

94 BOSTON HILL - LARKSVILLE, PENNSYLVANIA 16851 - Telephone: (570) 779-7843 - WWW.GTAENG.COM

TRAPEZE MOUNTED TRANSFORMER

SECTION - EXTERIOR WALL

SECTION-EXTERIOR WALL

Drawing Title		Project Title		Date
SECTIONS AND DETAILS		REPLACE ELECTRICAL SWITCHGEAR		01-28-11
Approved: Project Manager EMILY McDONALD		Building Number	Checked N.C.T.	Project No. 562-07-101
			Drawn S.J.B	
Approved: Service Chief SUSAN LANG		Location YAMC, ERIE PENNSYLVANIA		Dwg. 3 of -

