


ATTACHMENT B DELWOOD FACILITY LAYOUT

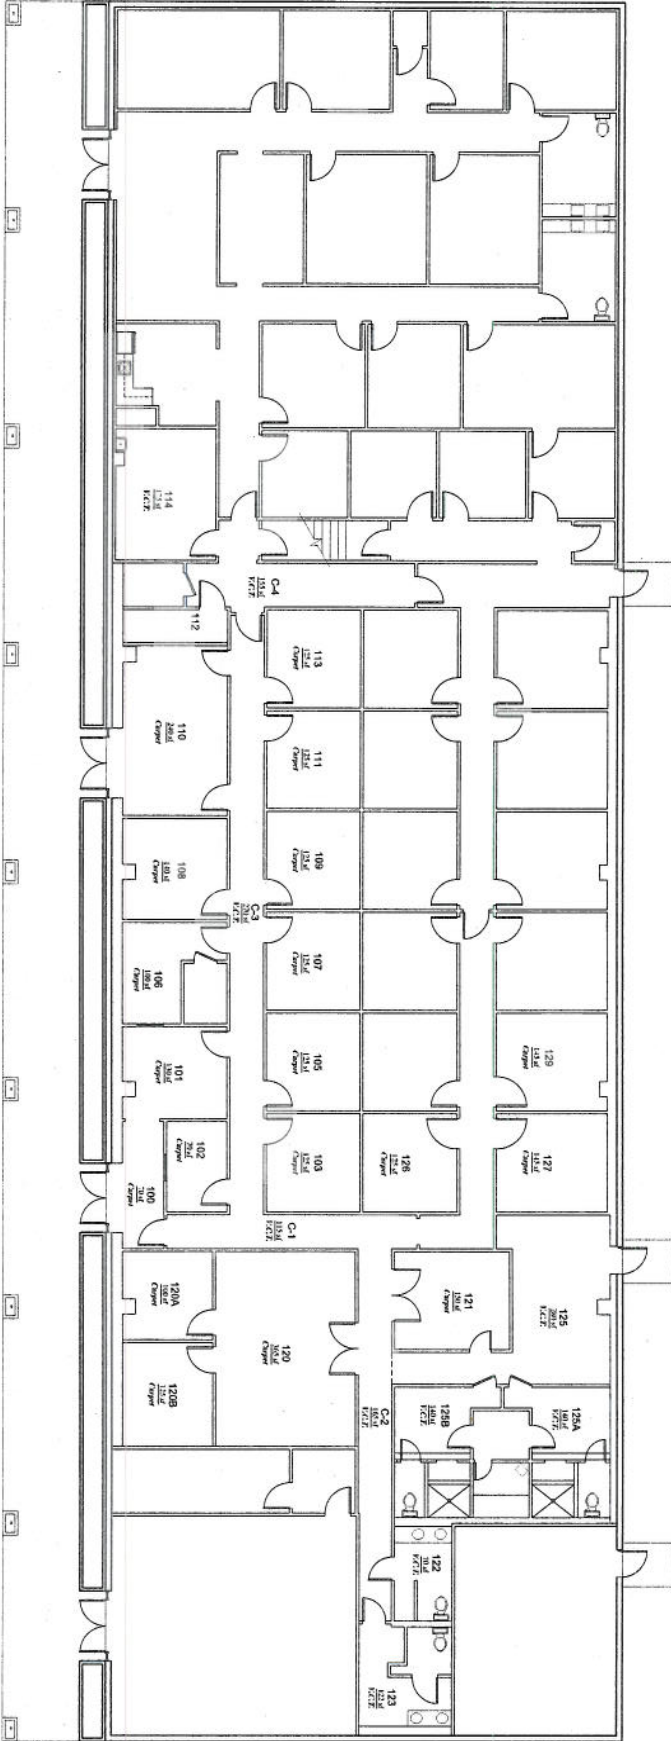

NOTES:

SCALE: 1/8" = 1'-0"

Approved:

Design:

Project:

Date:

Office of Facilities

Department of Veterans Affairs

DELLWOOD

AS-BUILT DRAWINGS

ARI

08/02/10

Page 1 of 1