

AS-BUILTS
FULLY SPRINKLERED

AS-BUILTS		
REVISIONS		
DATE	2-14-12	

GENERAL
NOTES:


[illegible]

ARCHITECT:

Wolfgang|Knutson
Architects Ltd.

3640 NEIL HANSON RD.
SUITE # 328
EAGAN, MN 55121

T: 651-888-6304
F: 651-888-6343

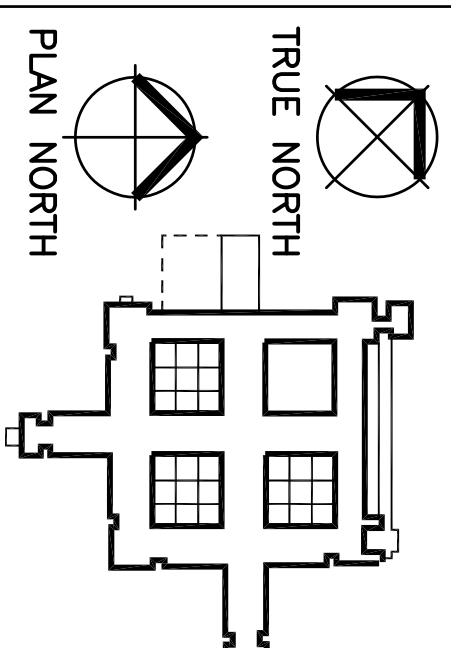

DRAWING NO. 1255-A3 Day4 of 25	Building Number 70	Project No. 618-11-153	Project Title SAFE PATIENT HANDLING PHASE II	Drawing Title OVERALL PLAN SECOND FLOOR	DRAWING CENTER: DATE THIS PLAN, SPECIFICATIONS, AND ALL OTHERS HEREON MADE BY THE ARCHITECT SHALL BE THE PROPERTY OF THE ARCHITECT. NO PART OF THIS DRAWING IS TO BE LOANED, REPRODUCED, COPIED, OR IN ANY MANNER REPRODUCED WITHOUT THE ARCHITECT'S WRITTEN PERMISSION.
			Location VA MEDICAL CENTER ONE VETERANS DRIVE MINNEAPOLIS, MN 55417	Approved: Division Chief	
			Date 8-27-2012	Checked SJK	Drawn JMD
				Approved: Service Director	Drawing Scale 1/2" = 1'-0"