


one eighth inch = one foot  
one quarter inch = one foot  
one half inch = one foot  
three eighths inch = one foot  
one inch = one foot  
one and one half inches = one foot  
two inches = one foot  
three inches = one foot



# LEGEND

- BORING
- CULVERT
- CLEAN OUT
- CATCH BASIN
- CONTROL POINT
- FLAG POLE
- TRASH BIN
- GUARD POST
- HYDRANT
- IRRIGATION CONTROL BOX
- LIGHT POLE
- MANHOLE
- POWER POLE
- SIGN
- SPRINKLER HEAD
- WATER VALVE
- ROOF DRAIN
- CONIFEROUS TREE
- DECIDUOUS TREE
- DIRECTION OF GRAVESTONE FACE
- POWER POLE ANCHOR
- FENCE
- GAS
- OVERHEAD WIRES
- PAVEMENT CRACK
- STORM SEWER
- STORM SEWER PER PLANS
- EXPANSION JOINT
- UNDERGROUND ELECTRIC
- WATER MAIN
- SANITARY SEWER

CONTROL SCHEDULE				
POINT NO.	NORTHING	EASTING	ELEVATION	POINT NAME
100	1437270.95	2183438.88	1163.99	B-17
101	1437277.99	2182947.40	1168.94	B-10
102	1437600.91	2182920.50	1189.32	1397
105	1437761.48	2183168.98	1167.00	I-13
106	1437548.98	2183510.30	1136.52	F-18
107	1437760.33	2183650.47	1124.91	I-20
110	1437543.80	2183861.13	1160.61	F-23
112	1437333.26	2183861.34	1174.68	C-23
115	1437275.16	2183229.20	1158.70	B-14
117	1437640.08	2182505.40	1148.83	G-3
119	1437770.08	2182330.24	1129.77	I-1
126	1437521.79	2182363.90	1128.13	F-1
129	1437428.60	2182523.54	1152.78	D-4

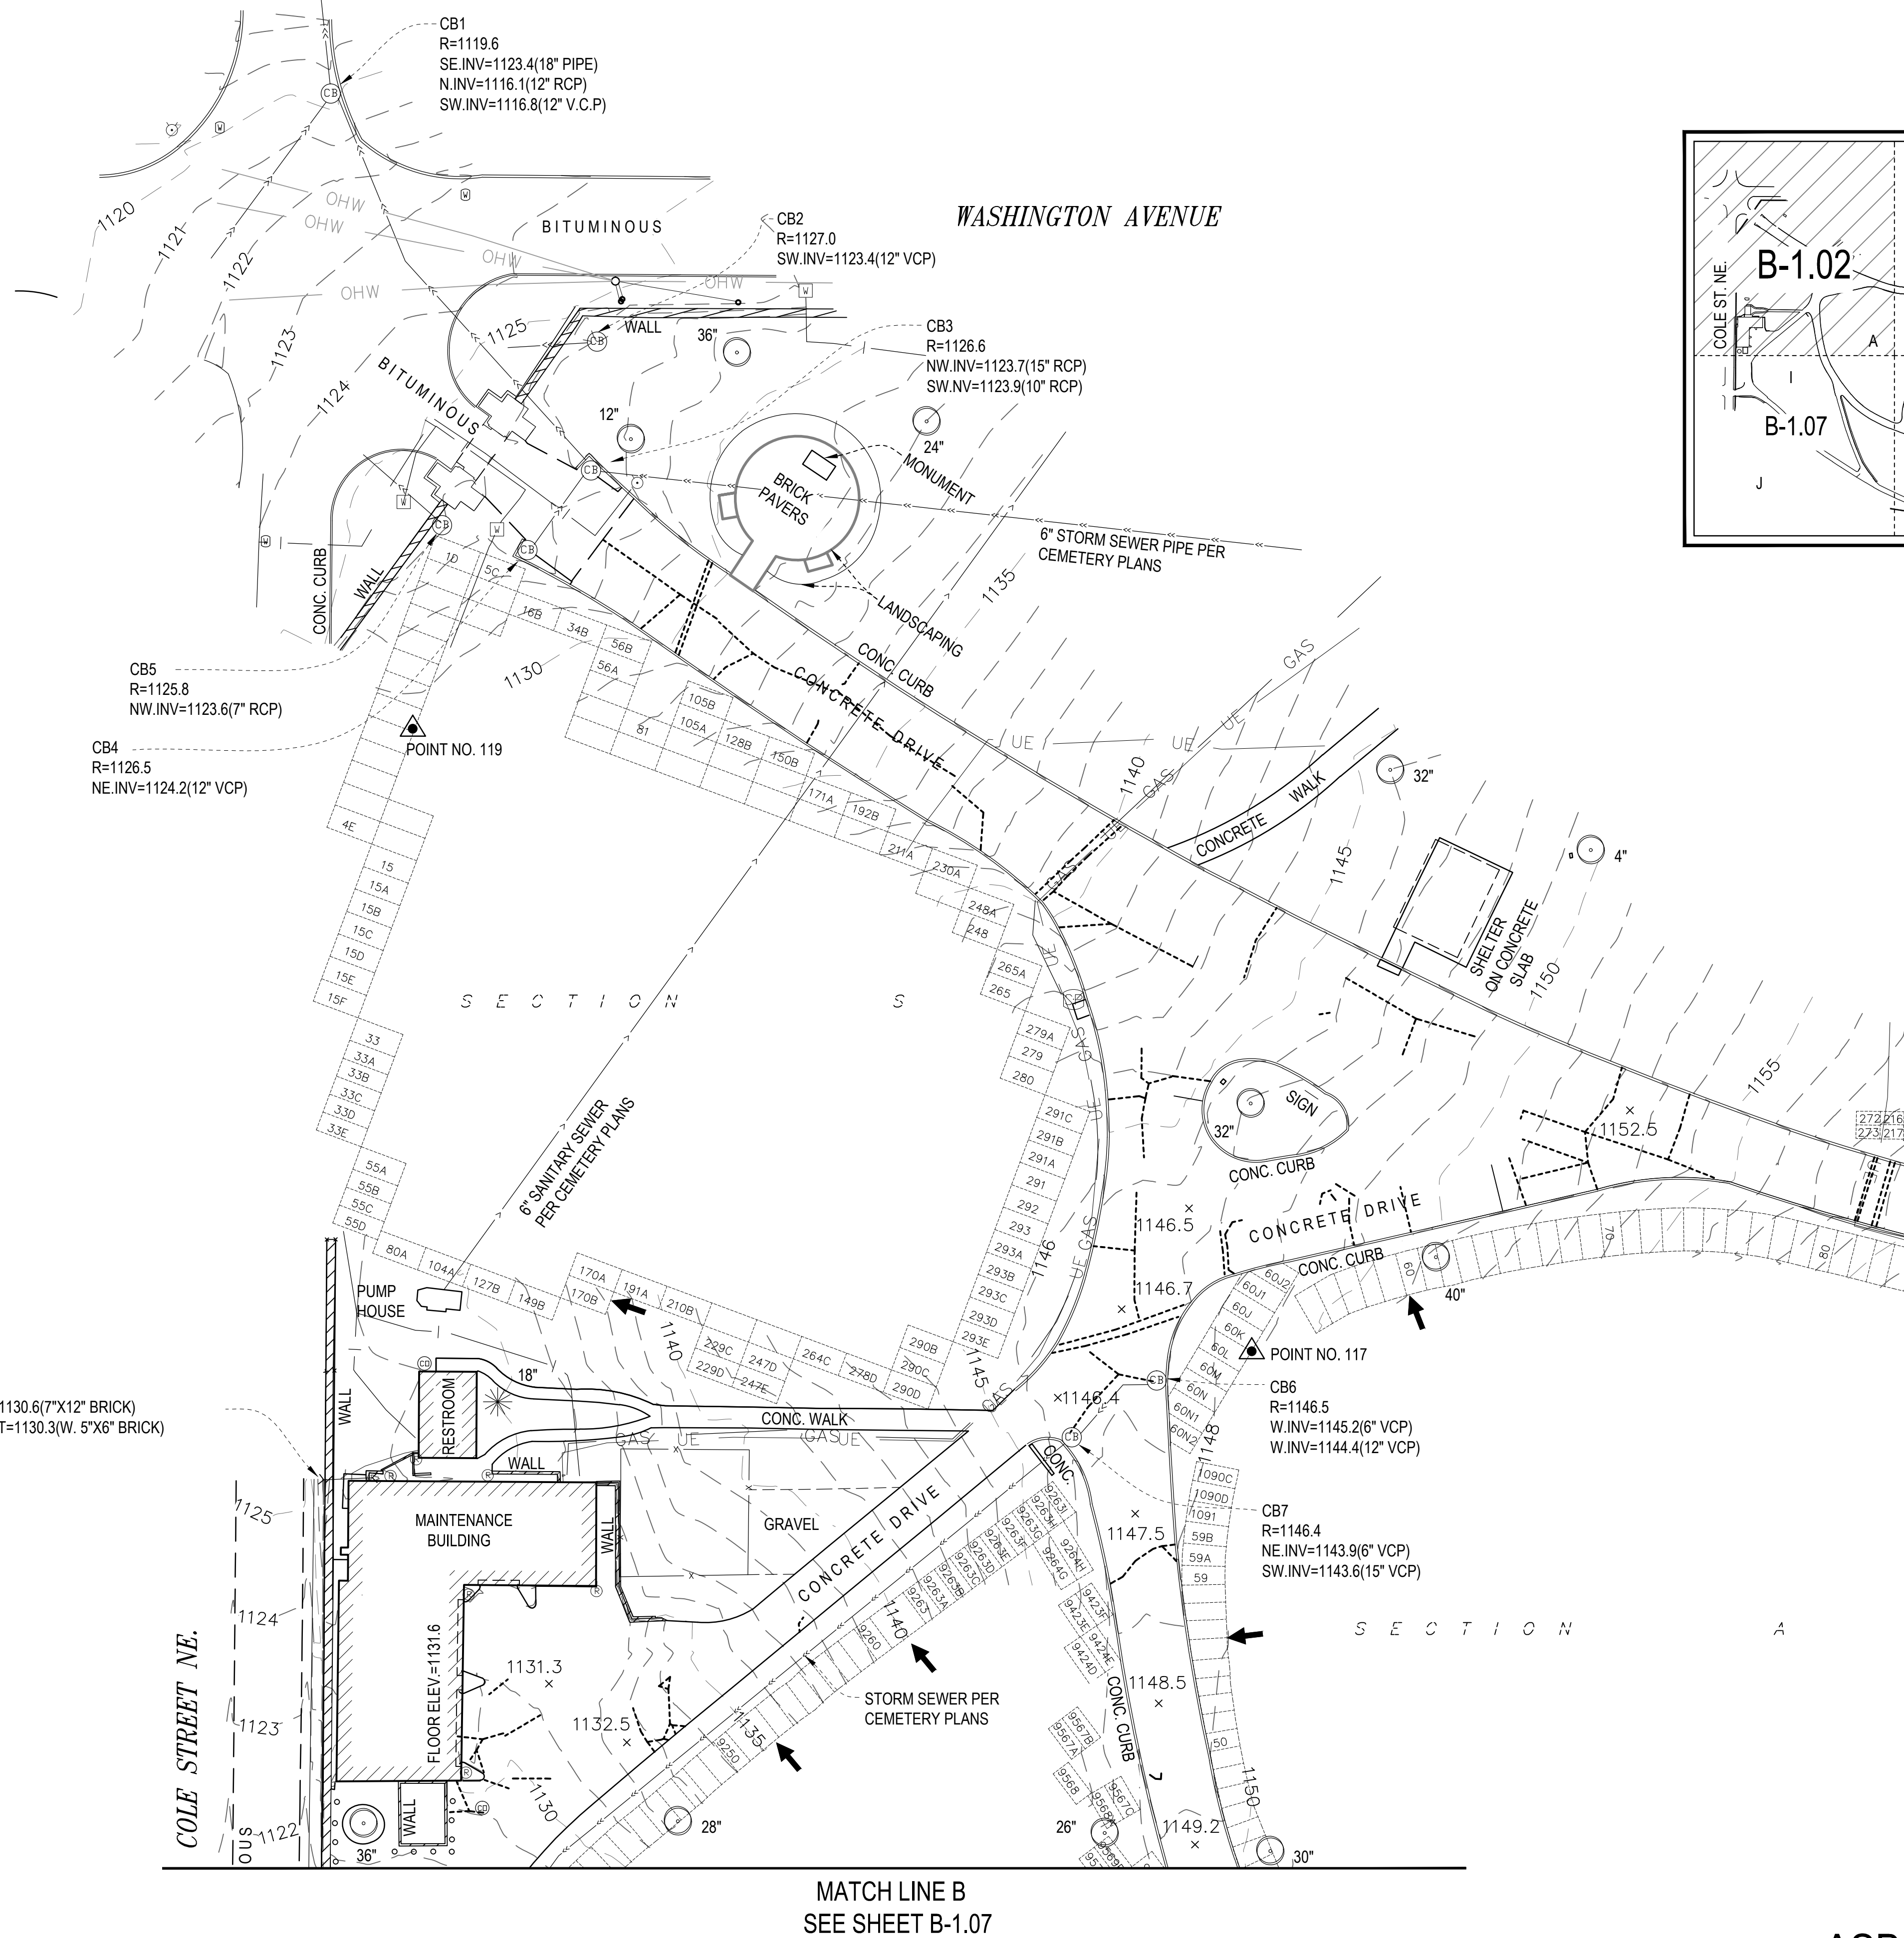

## SITE SHEET KEY

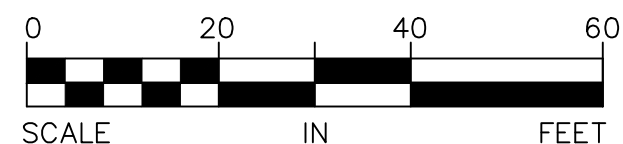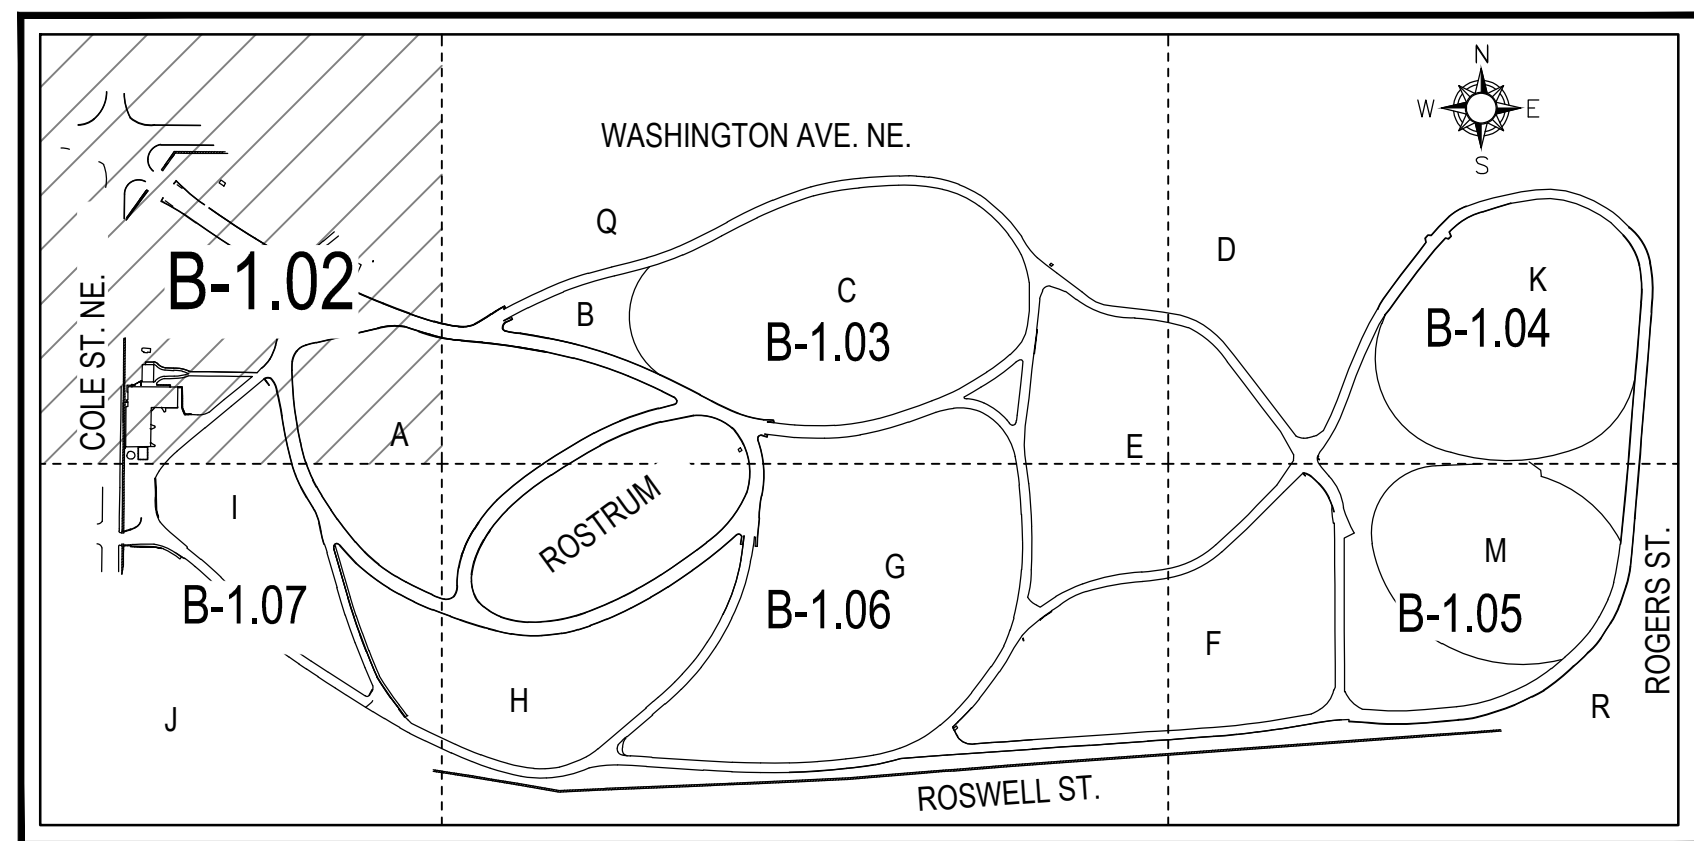

ASBUILT DRAWINGS - SEPTEMBER 10, 2015

CONSULTANTS:		ARCHITECT/ENGINEERS:		Drawing Title		Project Title		Project Number		National Cemetery Administration Department of Veterans Affairs			
<b>Terracon</b> Terracon 2855 Premiere Pkwy, Ste. C Duluth, GA 30097 (770) 623-0755 tel (770) 623-9628 fax www.terracon.com		<b>ANDERSON ENGINEERING</b> Anderson Engineering of Minnesota, LLC 13605 1st Avenue North Suite 100 Plymouth, MN 55441 763-412-4000 (o) 763-412-4090 (f) www.ae-mn.com		SITE SURVEY		ROADWAY AND STORM DRAINAGE REPLACEMENT		859CM3020					
ASBUILT DRAWINGS Revisions:		ENGINEERING • ARCHITECTURE • LAND SURVEYING ENVIRONMENTAL SERVICES • LANDSCAPE ARCHITECTURE		Approved: Project Director		Location MARIETTA NATIONAL CEMETERY MARIETTA, GEORGIA		Building Number					
9-10-15 Date						Date JANUARY 31, 2014		Checked TGMB		Drawn THPH			
								Drawing Number		B-102			
								Dwg. 5 of 58					