


one-eighth inch = one foot
one-quarter inch = one foot
three-eighths inch = one foot
one-half inch = one foot
three-quarters inch = one foot
one inch = one foot
one and one-half inches = one foot
two inches = one foot
three inches = one foot

UPDATED TO AS-BUILT	MAKI	7-21-15
DEL. C5-3/23, ADD 5B107A/B/C/D, 5D TITLES		6-3-99
ADD 5A104A/B/C/D		6-3-99
SD128A/5A132A/5C129A/5B130A/5B107A/B/C/D		6-3-99
FIRE1 LAYER, FIRE/SMOKE WALLS		6-3-99
Revisions		Date

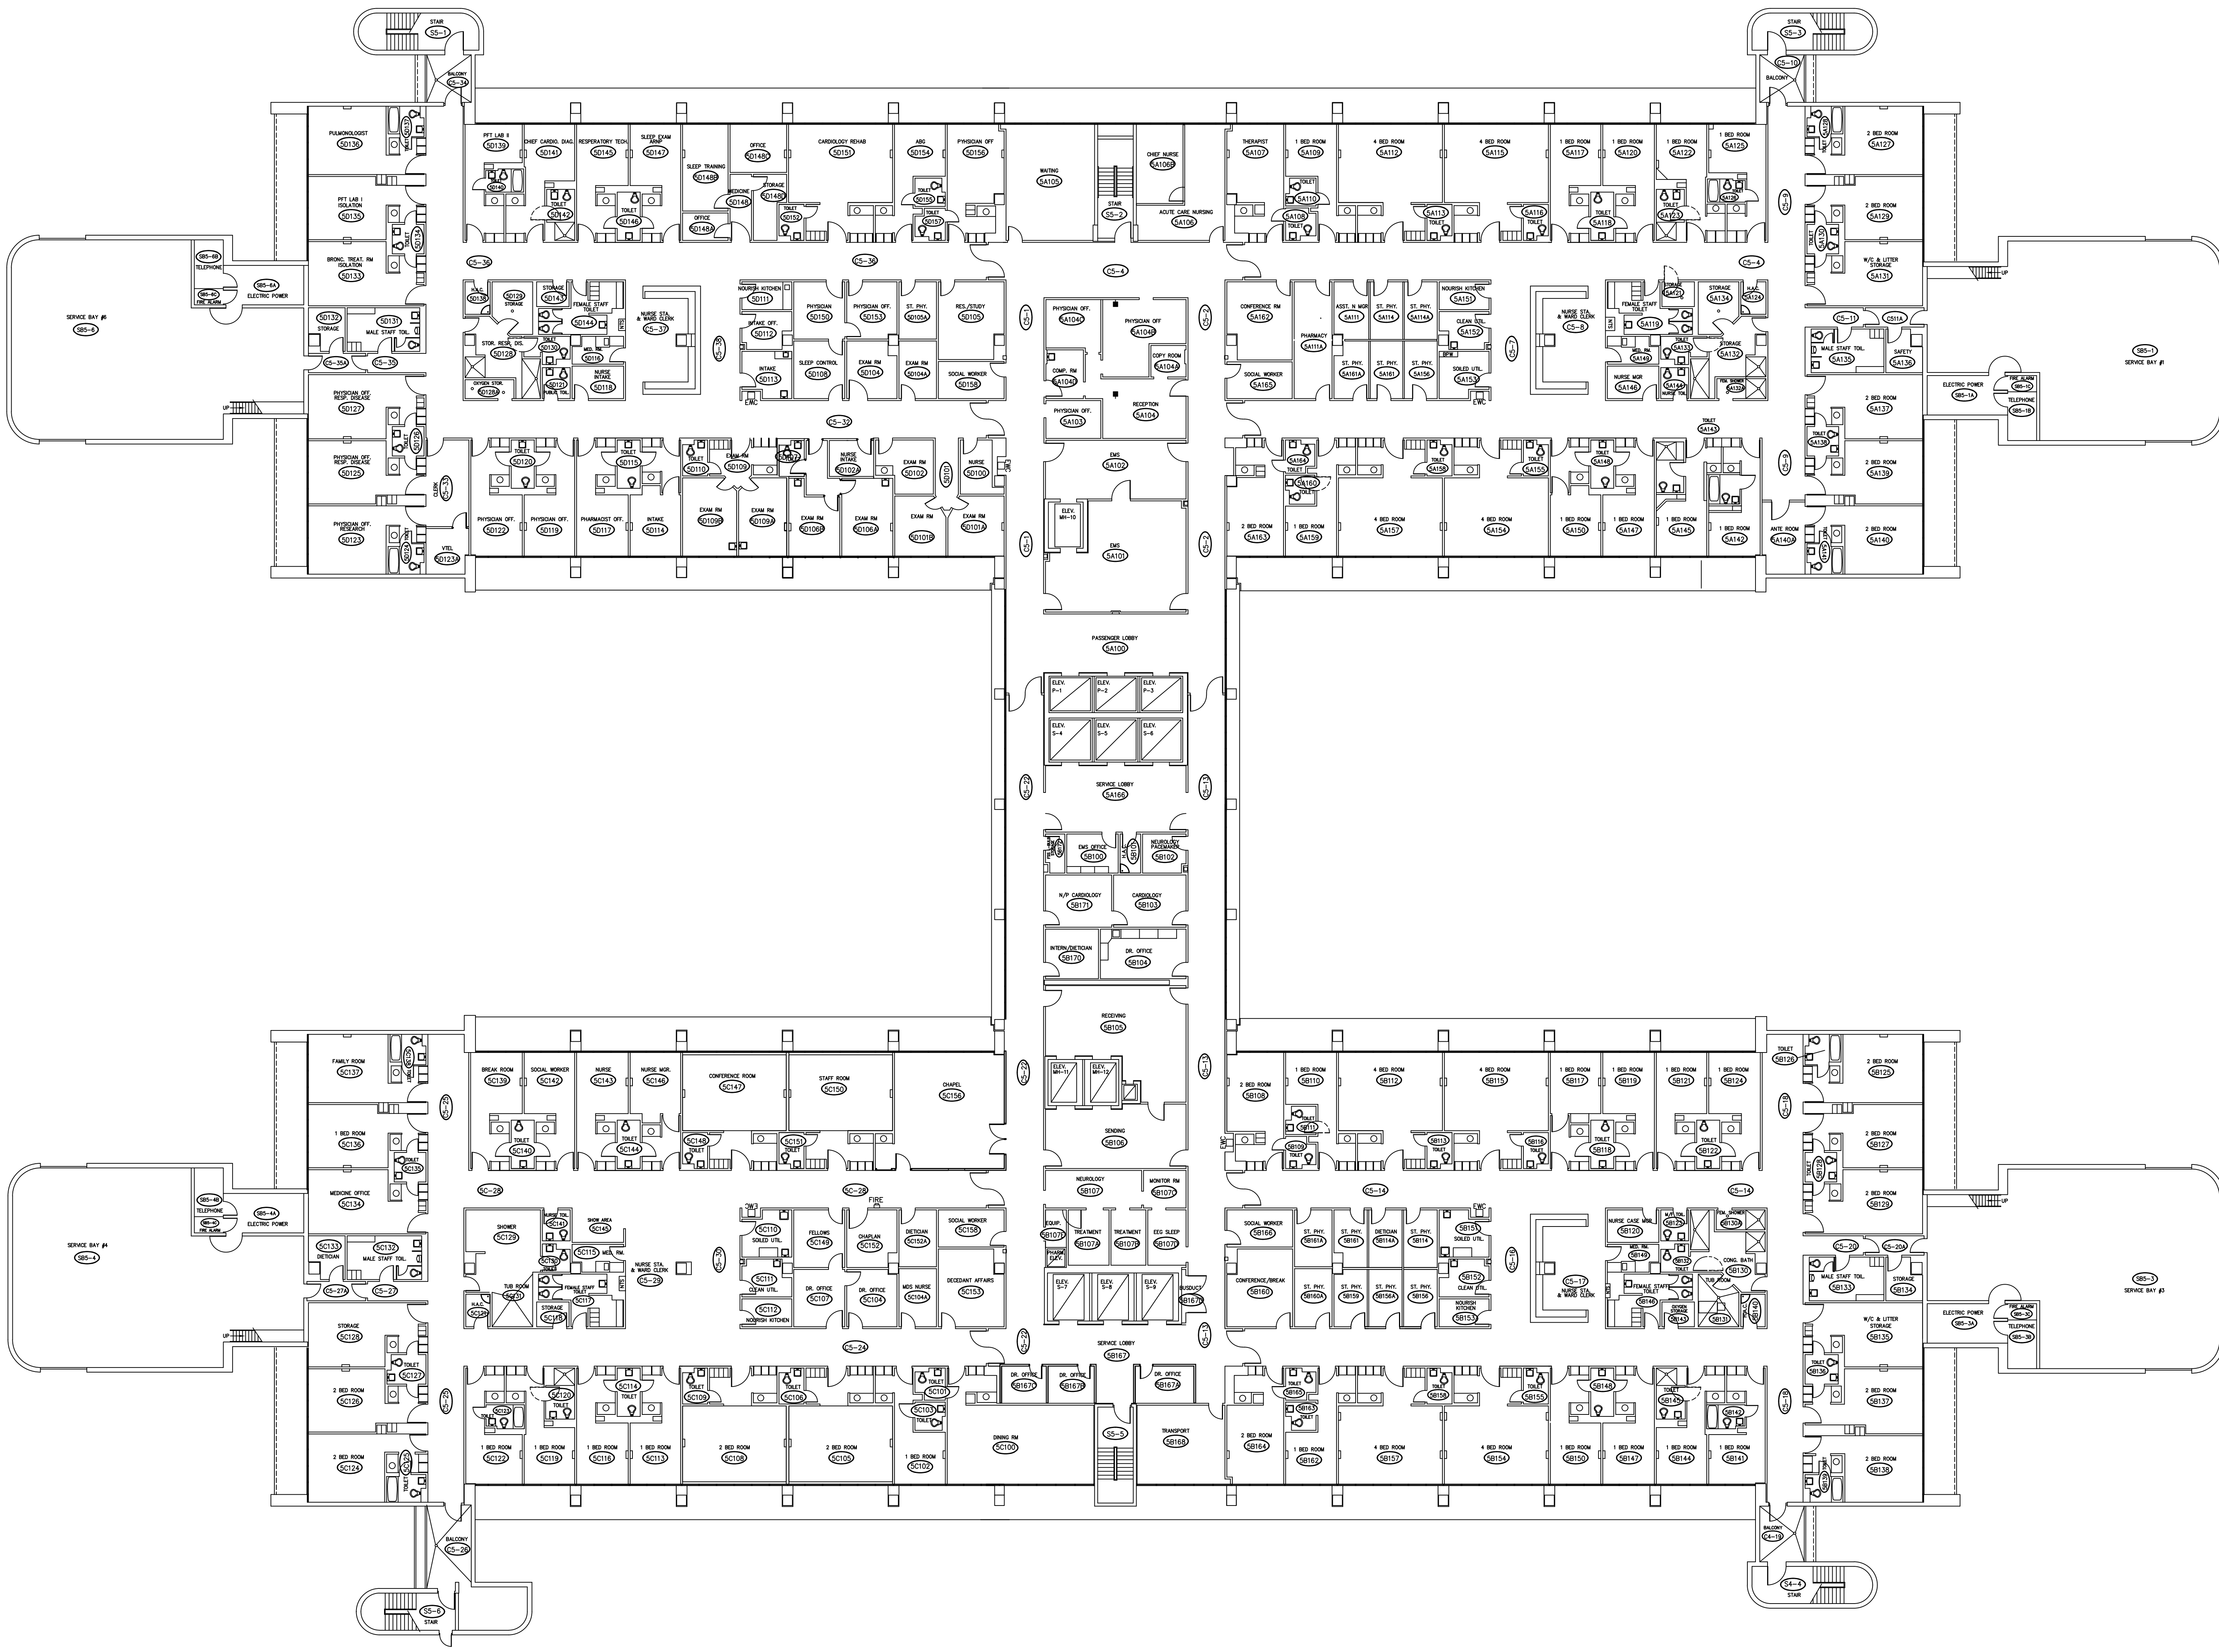

Drawing Title FIFTH FLOOR PLAN	Project Title AS-BUILT	Date 11-4-02
SCALE: 1/16" = 1'-0"	Building Number 100	Project No. AS-BUILTS
Approved: Division Chief	Checked	Drawn MAKI
Approved: Service Director	Location VAMC Bay Pines Bay Pines FL 33744	Drawing No. 100-5A Dwg. 7 of 7

