
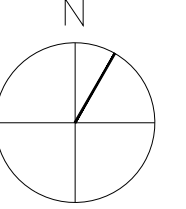


SHEET NOTES :  
1. SEE GENERAL ARCHITECTURAL NOTES,  
DWG X-4

RADIOLOGY - 276  
ORTHOPEDIC CLINIC - 258  
ABULATORY CARE - 262  
SEE DET PLAN 100-118

SHEET NOTES:  
1. SEE GENERAL ARCHITECTURAL NOTES,  
DWG X-4.

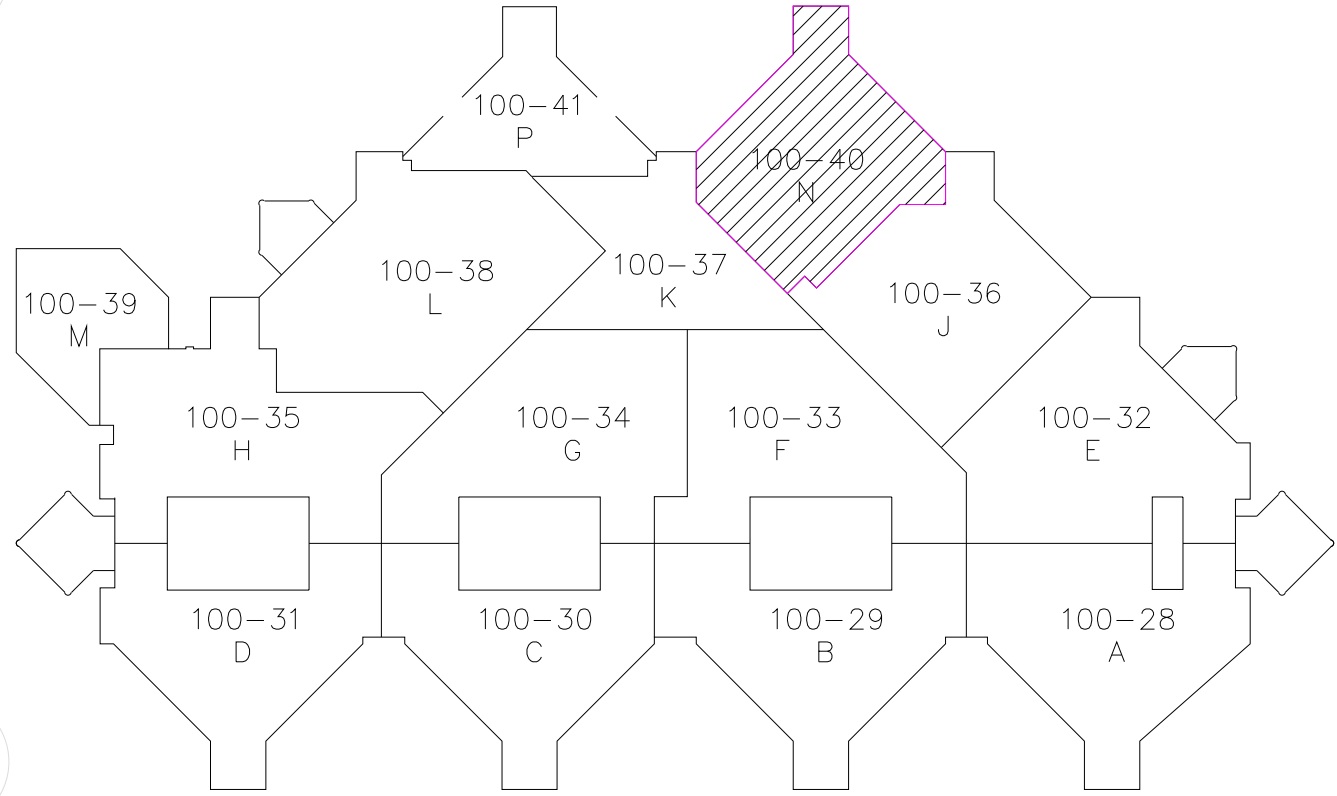

<div>RECORD DRAWING</div> <div>AMENDMENT NO. 1</div> <div>AMENDMENT NO. 2</div> <div>DEC 4-95</div> <div>SP1 84-1982</div>	8-3-92	<div>Professional Seal</div>				Drawing Title		Project Title		Date	<div>VAMC, HOUSTON</div>	<div>VA Department of Veterans Affairs</div>	
	26 FEB 87					FIRST FLOOR PLAN -- AREA N		AS-BUILT Drawings		2 JAN 87			
	27 FEB 87									Project No.			
	10 NOV 87									580-040			
	24 AUG 95									Drawing No.			
18 JAN 2005	24 AUG 95									100-40R2			
Revisions	Date					Approved:		Building Number	Checked	Drawn			
								100					
						Approved:		Location					
								VAMC, HOUSTON TEXAS.					