
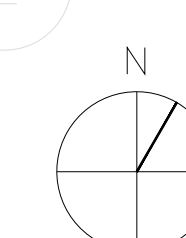


SHEET NOTES :
1. SEE GENERAL ARCHITECTURAL NOTES,
DWG X-4

RADIOLOGY - 276
ORTHOPEDIC CLINIC - 258
AMBULATORY CARE - 262
SEE DET PLAN 100-118

| LIGHTING LEGEND | | | SYMBOL | | |
|-----------------|----------|-----------------------------------------|--------|--------------|----------------------------------------------------------------------------------|
| SYMBOL | NAME | DESCRIPTION | SYMBOL | NAME | DESCRIPTION |
| | 2x4FLU | 2x4 FLUORESCENT LIGHTING FIXT. | | 4FLSTR | 1x4 FLUORESCENT STRIP EM. FIXTURE. |
| | 1x4FLU | 1x4 FLUORESCENT LIGHTING FIXT. | | LIGHTSM | INCANDESCENT STRIP FIXT. ON D.W. PAR. GLG. |
| | 1224FLU | 12x24 FLUORESCENT LIGHTING FIXT. | | LIGHTMFW | INCANDESCENT STRIP FIXT. ON DW. PAR. WALL GLG. MOUNTED INCANDESCENT L.T.G. FIXT. |
| | 4x4FLU | 4x4 FLUORESCENT LIGHTING FIXT. | | LIGHT-W | WALL MOUNTED INCANDESCENT L.T.G. FIXT. |
| | 2x2FLU | 2x2 FLUORESCENT LIGHTING FIXT. | | EXITLtg-C | EXIT LIGHT (CEILING MOUNTED) |
| | 1x1FLU | 1x1 FLUORESCENT LIGHTING FIXT. | | EXITLtg-D | EXIT LIGHT (CEILING MOUNTED) (DOUBLE FACE) |
| | 2x3FLU | 2x3 FLUORESCENT LIGHTING FIXT. | | EXITLtg-S | EXIT LIGHT (CEILING MOUNTED) (SINGLE FACE) |
| | 1818FLU | 18x18 FLUORESCENT LIGHTING FIXT. | | EXITLtg-W | EXIT LIGHT WALL MOUNTED (DOUBLE FACE) |
| | 6x4FLU | 6x4x FLUORESCENT LIGHTING FIXT. | | EXITLtg-W | EXIT LIGHT (BALL MOUNTED) |
| | 6x3FLU | 6x3x FLUORESCENT LIGHTING FIXT. | | BOX-W | BOX - W/ALL - JUNCTION BOX |
| | 6x2FLU | 6x2x FLUORESCENT LIGHTING FIXT. | | JBX-C | CEILING MOUNTED JUNCTION BOX |
| | 1x8FLU | 1x8 FLUORESCENT LIGHTING FIXT. | | PILOTLGT | INTERSTITIAL PILOT LIGHT |
| | 12x36FLD | 12x36 FLOOD LIGHT | | MOTDET | MOTION DETECTOR SENSOR |
| | 2x2FLE | 2x2 FLUORESCENT EMERGENCY L.T.G. | | 1Pole-SW | SINGLE POLE SWITCH |
| | 1x2FLE | 1x2 FLUORESCENT EMERGENCY L.T.G. | | 2Pole-SW | DOUBLE POLE SWITCH |
| | 6x18FLE | 6x18 FLUORESCENT EMERGENCY L.T.G. | | 3Pole-SW | THREE - WAY SWITCH |
| | 6x24FLE | 6x24 FLUORESCENT EMERGENCY L.T.G. | | 4Pole-SW | FOUR - WAY SWITCH |
| | 6x36FLE | 6x36 FLUORESCENT EMERGENCY L.T.G. | | DMRCLT | DIMMER CONTROL |
| | 6x18FLE | 6x18 FLUORESCENT EMERGENCY L.T.G. | | 1Pcm-SW | ONE POLE SW. TO CONTRL. EX. L.T.G. FIXT. |
| | 1x2FLE | 1x2 FLUORESCENT EMERGENCY L.T.G. | | 30m-SW | 30" SW - DIMMER SWITCH |
| | 1x3FLE | 1x3 FLUORESCENT EMERGENCY L.T.G. | | Mcm-SW | MOMENTARY CONTACT KEYPAD SWITCH |
| | 2x4FLE | 2x4 FLUORESCENT EMERGENCY L.T.G. | | KEY-SW | KEY CONTACT |
| | 4x4FLE | 4x4 FLUORESCENT EMERGENCY L.T.G. | | MCM-MSV | MANUAL MOTOR STARTING SW. W/THRM. PROT. |
| | 1x4FLE | 1x4 FLUORESCENT EMERGENCY L.T.G. | | MCM-TS | MOMENTARY CONTACT SWITCH |
| | 2x4FLS | 2x4 FLUORESCENT L.T.G. LIFE SAFETY | | PUSH-BTN | PUSH BUTTON SWITCH |
| | 2x2FLS | 2x2 FLUORESCENT L.T.G. LIFE SAFETY | | PILOT-SW | SW. w/PILOT LIGHT |
| | 1x4FLS | 1x4 FLUORESCENT L.T.G. LIFE SAFETY | | RMTCR-SW | REMOTE CONTROL SWITCH |
| | 1x8FLS | 1x8 FLUORESCENT L.T.G. LIFE SAFETY | | WPRFSSW | WEATHERPROOF SWITCH |
| | 1x1FLS | 1x1 FLUORESCENT L.T.G. LIFE SAFETY | | 3W-HSCH | THREE - WAY KEY OPERATED SWITCH |
| | 1x1FLS | 1x1 FLUORESCENT L.T.G. LIFE SAFETY | | S-INTC | SIGNALING LIGHT INTENSITY CONTROLLER |
| | 1x1FLS | 1x1 FLUORESCENT L.T.G. LIFE SAFETY | | TMR-SW | TIMER SWITCH |
| | 1x1FLS | 1x1 FLUORESCENT L.T.G. LIFE SAFETY | | DMR-SW | DIMER SWITCH |
| | 1x1FLU | 1x1 FLUORESCENT L.T.G. | | ARROW-01 | FOR DIRECTION |
| | 1x1FLU | 1x1 FLUORESCENT L.T.G. | | ARROW-02 | FOR DIRECTION |
| | 1x1FLU | 1x1 FLUORESCENT L.T.G. | | SIGNAL ARROW | FOR DIRECTION |
| | 1x1FLU | 1x1 FLUORESCENT L.T.G. | | ARROW-02 | FOR DIRECTION |
| | 6x4FSD | 6x4 FLUORESCENT FIXTURE-DUAL, SWITCHED | | SYMBOL1 | FOR DIRECTION |
| | 6x36FSD | 6x36 FLUORESCENT FIXTURE-DUAL, SWITCHED | | SYMBOL2 | FOR DIRECTION |
| | 6x4FSD | 6x4 FLUORESCENT FIXTURE-DUAL, SWITCHED | | | |

SHEET NOTES:
1. SEE GENERAL ARCHITECTURAL NOTES

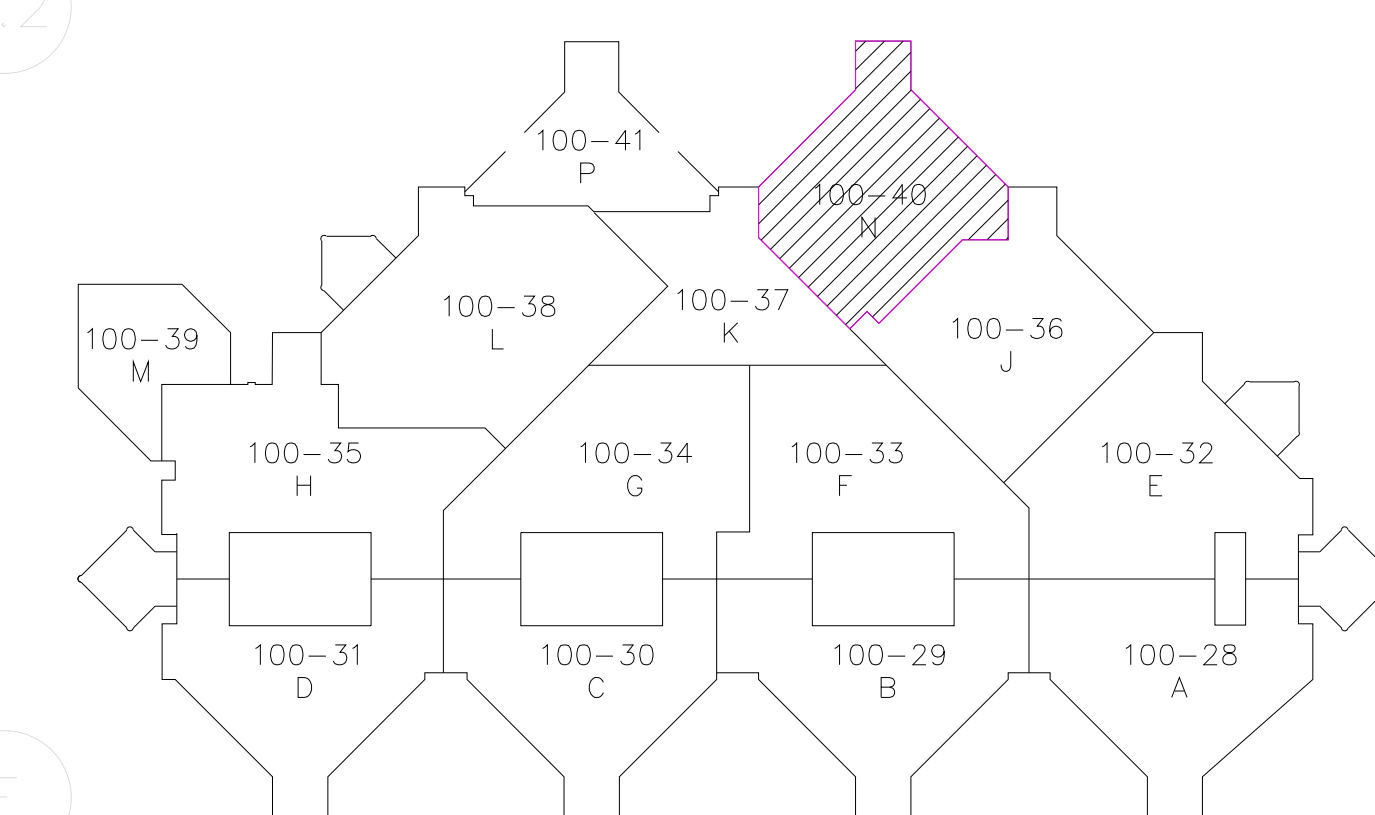

| | | | | | | | | | | |
|--------------------------------------------------------------------------------------------------------------------------------------------------------------------------------|------|-------------|--|-------------------|-----------------------------------------------------|------------------------------------|------------------------|-------------------------|--|--|
| RECORD DRAWING | | 8-3-92 | | | Drawing Title FIRST FLOOR PLAN - AREA N LIGHTING | Project Title AS-BUILT Drawings | | Date 2 JAN 87 | | |
| <div style="text-align: center;"> AMENDMENT NO. 1 AMENDMENT NO. 2 ISSUED REVISED </div> | | 20 FEB 87 | | | | | Project No. 580-040 | | | |
| | | 27 FEB 87 | | | | | | Drawing No. 100-28R2 | | |
| | | 10 NOV 87 | | | Approved: | Building Number 100 | Checked | Drawn | | |
| | | 24 AUG 90 | | | | | | | | |
| | | 18 JUN 2005 | | | | | | | | |
| Revisions | Date | | | Professional Seal | Approved: | Location VAMC, HOUSTON TEXAS. | | | | |