
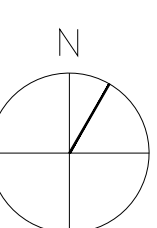


MEDICAL GAS LEGEND		
SYMBOL	NAME	DESCRIPTION
MA	MEDICAL AIR	
LA	LABORATORY AIR	
SA	DENTAL AIR	
SH	SHOP AIR	
WV	MEDICAL VACUUM	
LV	LABORATORY VACUUM	
OE	ORAL EVACUATION	
O	OXYGEN	
NO	NITROUS OXIDE	
G	GAS	
N	NITROGEN	
SYMBOL	NAME	DESCRIPTION
TEE	TEE	
ELBOW	ELBOW	
ABOUTLET	AIR OUTLET	
NOUTLET	NITROUS OXIDE OUTLET	
OOUTLET	OXYGEN OUTLET	
NOUTLET	NITROGEN OUTLET	
VACOUTLET	VACUUM OUTLET	
GASOUTLET	GAS OUTLET	
ZVB	ZONE VALVE BOX	
PIPE CAP	PIPE CAP	
MEDICAL GAS EQUIPMENT	MEDICAL GAS EQUIPMENT	
ALARM PANEL	ALARM PANEL	
DATE VALVE	DATE VALVE	
SHUT OFF VALVE	SHUT OFF VALVE	
RISER	RISER	
DROP	DROP	
AIR RISER	AIR RISER	
OXYGEN RISER	OXYGEN RISER	
NITROGEN RISER	NITROGEN RISER	
NITROUS OXIDE RISER	NITROUS OXIDE RISER	
VACUUM RISER	VACUUM RISER	
AIR DROP	AIR DROP	
VACUUM DROP	VACUUM DROP	
NITROGEN DROP	NITROGEN DROP	
NITROUS OXIDE DROP	NITROUS OXIDE DROP	
OXYGEN DROP	OXYGEN DROP	
FOR INDS. IN HEXAGON	FOR INDS. IN HEXAGON	
PIPE LEVEL DESIGNATION	PIPE LEVEL DESIGNATION	
GAS VALVE	GAS VALVE	
HI-LOW PRESSURE ALARM	HI-LOW PRESSURE ALARM	

SHEET NOTES :  
1. SEE GENERAL ARCHITECTURAL NOTES,  
DWG X-4

RADIOLOGY - 276  
ORTHOPEDIC CLINIC - 258  
ABULATORY CARE - 262  
SEE DET PLAN 100-118

SHEET NOTES:  
1. SEE GENERAL ARCHITECTURAL NOTES,  
DWG X-4.

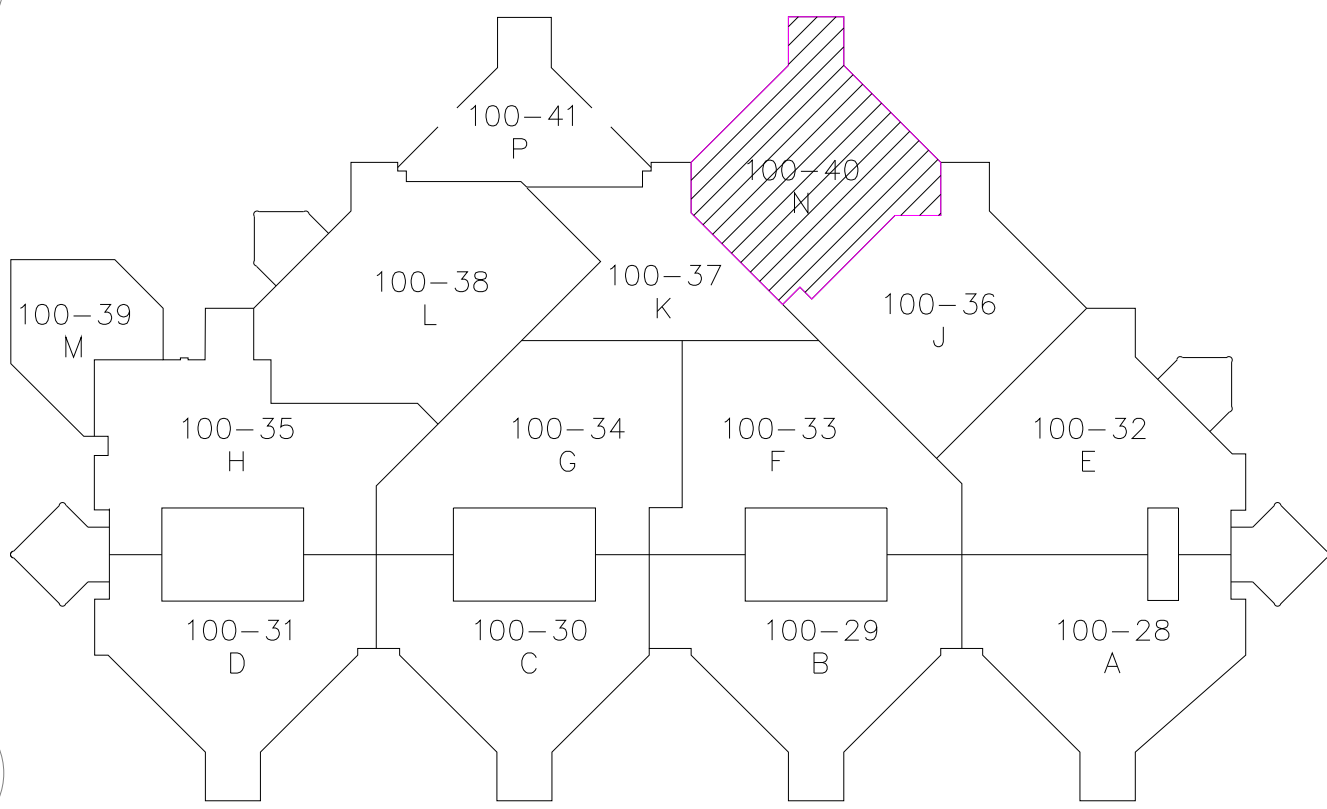

Drawing Title  
FIRST FLOOR PLAN - AREA N  
MEDICAL GAS

Project Title  
AS-BUILT Drawings

Building Number  
100

Location  
VAMC, HOUSTON  
TEXAS.

Date  
2 JAN 87

Project No.  
580-040

Drawing No.  
100-28R2

VA Department of Veterans Affairs