
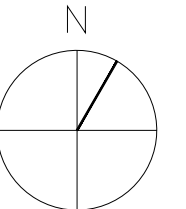


SHEET NOTES :
1. SEE GENERAL ARCHITECTURAL NOTES,
DWG X-4

RADIOLOGY - 276
ORTHOPEDIC CLINIC - 258
AMBULATORY CARE - 262
SEE DET PLAN 100-118

SHEET NOTES:
1. SEE GENERAL ARCHITECTURAL NOTES,
DWG X-4.

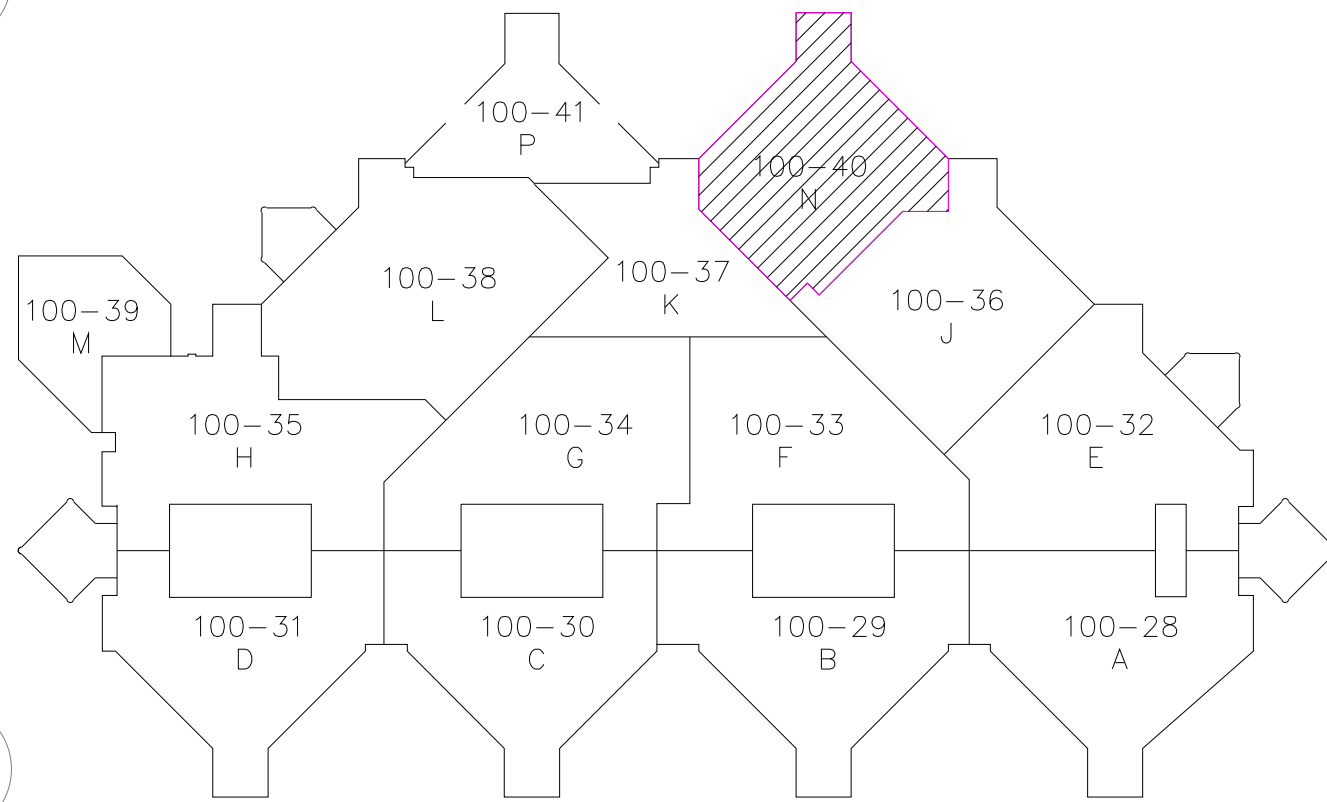

RECORD DRAWING	8-3-92					Drawing Title FIRST FLOOR PLAN - AREA N PANELS	Project Title AS-BUILT Drawings	Date 2 JAN 87		VA Department of Veterans Affairs		
AMENDMENT NO. 1	26 FEB 87					Approved:	Building Number 100	Checked			Drawn	Project No. 580-040
AMENDMENT NO. 2	27 FEB 87					Approved:	Location VAMC, HOUSTON TEXAS.					Drawing No. 100-28R2
100 A-10	10 NOV 87											
100 B-100	24 AUG 95											
100 C-100	18 JAN 2005											
Revisions	Date					Professional Seal						