
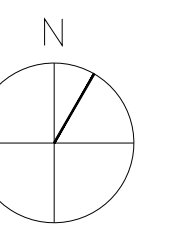


LEGEND		
SYMBOL	NAME	DESCRIPTION
[Symbol]	2X4FLF	2X4 FLUORESCENT LIGHTING FIXTURE
[Symbol]	1X4FLF	1X4 FLUORESCENT LIGHTING FIXTURE
[Symbol]	12X24FLF	12X24 FLUORESCENT LIGHTING FIXTURE
[Symbol]	4X4FLF	4X4 FLUORESCENT LIGHTING FIXTURE
[Symbol]	2X2FLF	2X2 FLUORESCENT LIGHTING FIXTURE
[Symbol]	1X1FLF	1X1 FLUORESCENT LIGHTING FIXTURE
[Symbol]	2X3FLF	2X3 FLUORESCENT LIGHTING FIXTURE
[Symbol]	18X48FLF	18X48 FLUORESCENT LIGHTING FIXTURE
[Symbol]	1X8FLF	1X8 FLUORESCENT LIGHTING FIXTURE
[Symbol]	1X16FLF	1X16 FLUORESCENT LIGHTING FIXTURE
[Symbol]	12X58FLD	12X58 FLOOD LIGHT
[Symbol]	EXTLTC-C	EXIT LIGHT CEILING MOUNTED
[Symbol]	LIGHT-C	CEILING MOUNTED INCANDESCENT LIGHTING FIXTURE
[Symbol]	FAHEATD	FIRE ALARM HEAT DETECTOR
[Symbol]	SMOCDT	SMOKE DETECTOR
[Symbol]	PNDSPRN	PENDENT SPRINKLER
[Symbol]	UPRTSPRN	UPRIGHT SPRINKLER
[Symbol]	SUPPDT	SUPPLY CEILING DIFFUSER
[Symbol]	RETDT	RETURN CEILING DIFFUSER
[Symbol]	EXHDT	EXHAUST CEILING DIFFUSER

SHEET NOTES :  
1. SEE GENERAL ARCHITECTURAL NOTES,  
DWG X-4

RADIOLOGY - 276  
ORTHOPEDIC CLINIC - 258  
AMBULATORY CARE - 262  
SEE DET PLAN 100-118

SHEET NOTES:  
1. SEE GENERAL NOTES FOR REFLECTED CEILING  
PLANS, DRAWING NO. DE-4.  
2. PROVIDE RADIUS WALL MOLDINGS @  
CURVED WALLS TO MATCH ADJACENT WALL  
MOLDINGS.  
SHEET NOTES:  
1. SEE GENERAL ARCHITECTURAL NOTES,  
DWG X-4.

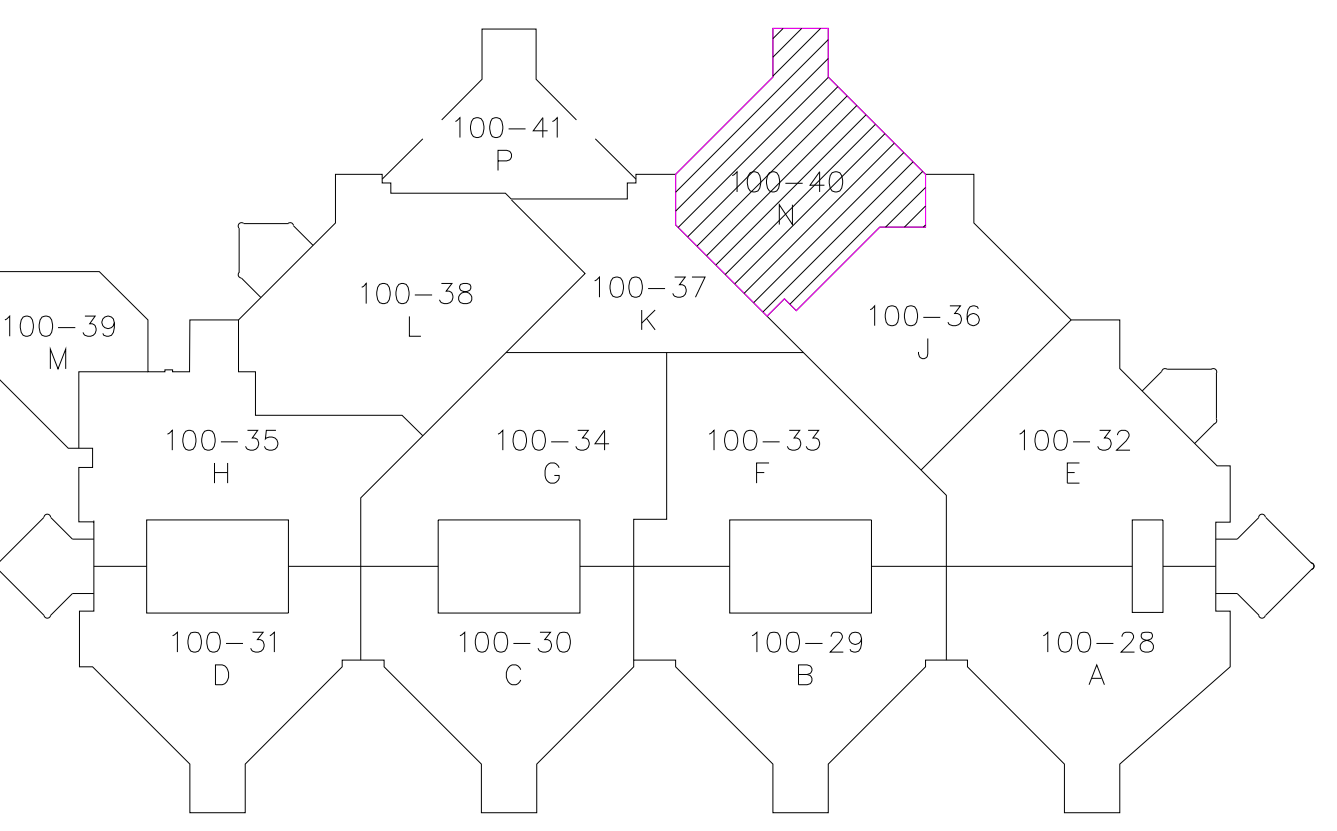

RECORD DRAWING	8-3-87			Drawing Title FIRST FLOOR PLAN - AREA N REFLECTED CEILING PLAN		Project Title AS-BUILT Drawings		Date 2 JAN 87			VA Department of Veterans Affairs
AMENDMENT NO. 1	26 FEB 87			Approved:		Building Number 100		Project No. 580-040			
AMENDMENT NO. 2	27 FEB 87			Approved:		Checked		Drawing No. 100-28R2			
DEC 8-85	26 NOV 87					Location VAMC, HOUSTON TEXAS.					
REV 84-1982	26 AUG 95										
15 JAN 2005											
Revisions	Date			Professional Seal							