

BENCHMARK:
CITY OF HOUSTON SURVEY MARKED 5329-1016
E.L. = 47.50, U.G.S., 1954 ADJUSTMENT
LOCATED AT S.E. CORNER OF OLD SPANISH
TRAIL AND ALMEDA ROAD.

NOTE:
TOPOGRAPHY BASED UPON SURVEY INFORMATION
PROVIDED BY SURVCON, INC., DATED OCTOBER,
1994. SEE SHEETS L-1 THRU L-37 FOR LEGEND,
POSSIBLE UTILITY CONFLICTS AND ADDITIONAL
SURVEY INFORMATION.



NOTE: REFER TO DRAWING NO. L-49 FOR LEGEND

NOTE: EXIST WATER METER TO BE
ABANDONED WHEN PHASE III WATER
LINES ARE PLACED IN SERVICE

NOTE: IF SANITARY SEWER SERVING BLDG NO. 7
IS TO REMAIN IN SERVICE, CONTRACTOR SHALL
NOT INTERRUPT SERVICE UNTIL PHASE II & III
UTILITIES ARE CONNECTED, TESTED AND PLACED
IN SERVICE.

NOTE: SANITARY SEWER EAST OF
BLDG NO. 206 IS TO REMAIN IN
SERVICE. CONTRACTOR SHALL NOT
INTERRUPT SERVICE UNTIL PHASE
II & III UTILITIES ARE CONNECTED,
TESTED AND PLACED IN SERVICE.

NOTE: EXIST WATER METER
TO BE ABANDONED WHEN
PHASE III WATER LINES ARE
PLACED IN SERVICE

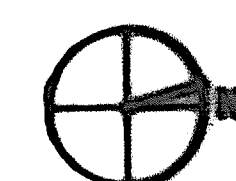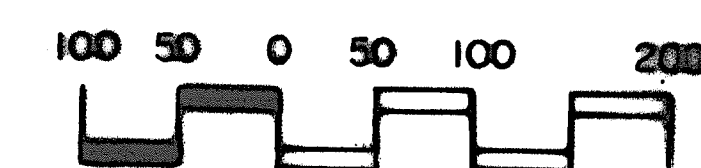


REVISION R.E.I. NO. C-289	12/3/91	REVISION F.S.A. NO. 599	7/27/93
REVISION R.E.I. NO. C-289	11/1/91	REVISION F.S.A. NO. 569	2/23/93
REVISION R.E.I. NO. C-279	9/4/93	REVISION F.S.A. NO. 561	1/22/93
REVISION I.O.C. NO. C003	3/20/93	REVISION F.S.A. NO. 557	1/19/93
REVISION R.E.I. NO. C-60	2/22/93	REVISION R.E.I. NO. C-300	9/29/92
REVISION I.O.C. NO. C001	1/5/87	REVISION F.S.A. NO. 497	7/22/92
AMENDMENT NO. 1	2/20/92	REVISION R.E.I. NO. C-290	12/9/91
		RECORD DRAWING	11/24/92

3D/INTERNATIONAL AND STONE, MARRACCINI AND PATTERSON
3D/I • SHP A JOINT VENTURE HOUSTON, TEXAS

1500 WEST LOOP SOUTH, SUITE 200 HOUSTON, TEXAS 77057 TELEPHONE (713) 671-7000

STRUCTURAL AND CIVIL
MECHANICAL AND ELECTRICAL

WALTER P. HENKE AND ASSOCIATES, INCORPORATED
HOUSTON & HOLLER, INC. AND 3D/INTERNATIONAL

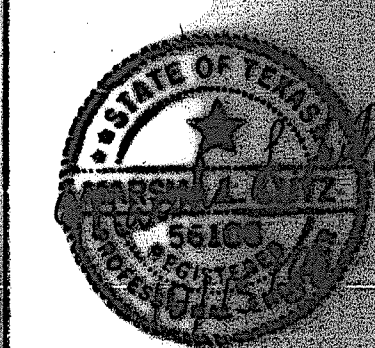

PHASE III RECORD DRAWING

Utility Site Plan

Approved Project Director

AC Pappas

REPLACEMENT /
MODERNIZATION
MEDICAL CENTER

Building Number

Checked MLL

Draw R.F.

VAMC HOUSTON, TEXAS

Date

2 JAN 92

Project No.

580-040

DRAWING NO.

W-2 R14

Page 1 of 49

Volume
Administration

W-2