



CONCRETE BEAM SCHEDULE											
MARK	WIDTH	DEPTH	REINFORCEMENT				ARR.	STIRRUPS	REMARKS		
			STRAIGHT	BENT	NO-SIZE	NO-SIZE					
5B-1	18"	26"	2#7	2#8	2#7	2#7		6" S	ADD 2#8 T. CONT.		
5B-2	26"	26"	4#6					6" S	EXTEND STR. BOT. BARS 1'-0" PAST FACE OF N. SUPP.		
5B-3	36"	15"	5#6	7#7	2#5	5#8		6" S	ADD 2#8 T. CONT.		
5B-4	36"	15"	5#6	5#8	2#6	4#8		6" S	ADD 2#8 T. CONT.		
5B-5	36"	15"	4#7					6" S	ADD 2#8 T. CONT.		
5B-6	36"	15"	5#6	5#8	4#8	2#6		6" S	ADD 2#8 T. CONT.		
5B-7	24"	15"	3#6	2#6	2#6	3#8		6" S	ADD 2#8 T. CONT.		
5B-8	24"	15"	5#5					6" S	ADD 2#8 T. CONT.		
5B-9	24"	15"	3#6	6#6	3#8	2#6		6" S	ADD 2#8 T. CONT.		
5B-10	30"	15"	5#9	4#8	5#9	5#9		6" S	EXTEND STR. BOT. BARS 2'-0" PAST FACE OF EACH SUPPORT		
5B-11	30"	15"	5#6					6" S	ADD 2#8 T. CONT.		
5B-12	30"	15"	3#6	4#7	2#8	2#8		6" S	ADD 2#8 T. CONT.		
5B-13	30"	15"	3#9	3#8	4#9	4#9		6" S	EXTEND STR. BOT. BARS 2'-0" PAST FACE OF EACH SUPPORT		
5B-14	30"	15"	3#5	4#6				6" S	ADD 2#8 T. CONT.		
5B-15	12"	15"	4#9		2#6	2#8		6" S	ADD 2#8 T. CONT.		
5B-16	26"	26"	1#8	2#8	4#8			6" S	ADD 2#8 T. CONT.		
5B-17	18"	15"	3#6	3#7	2#5	3#7		6" S	ADD 2#8 T. CONT.		
5B-18	18"	15"	4#5					6" S	ADD 2#8 T. CONT.		
5B-19	18"	15"	3#6	3#7	3#7	2#5		6" S	ADD 2#8 T. CONT.		
5B-20	26"	26"	1#8	2#8		4#8		6" S	ADD 2#8 T. CONT.		
5B-21	18"	15"	2#8					6" S	ADD 2#8 T. CONT.		
5B-22	24"	15"	7#7		5#9	4#9		6" S	ADD 2#8 T. CONT.		
5B-23	12"	15"	2#8	2#6	1#6	1#6		6" S	ADD 2#8 T. CONT.		
5B-24	36"	20"	4#8	5#9	4#7	2#9		6" S	ADD 2#8 T. CONT.		
5B-25	36"	20"	8#6					6" S	ADD 2#8 T. CONT.		
5B-26	15"	15"	7#7	3#7	9#8	2#5		6" S	ADD 2#8 T. CONT.		
5B-27	8"	15"	1#10	1#8				6" S	ADD 2#8 T. CONT.		
5B-28	16"	15"	2#6	2#6	2#4	2#4		6" S	ADD 2#8 T. CONT.		
5B-29	8"	15"	2#5					6" S	ADD 2#8 T. CONT.		
5B-30	26"	26"	2#5	2#7				6" S	ADD 2#8 T. CONT.		
5B-31	26"	26"	1#10	2#9	2#6	2#6		6" S	ADD 2#8 T. CONT.		
5B-32	26"	26"	1#8	2#8	2#9			6" S	ADD 2#8 T. CONT.		
5B-33	26"	26"	1#8	2#8		2#9		6" S	ADD 2#8 T. CONT.		
5B-34	18"	15"	3#8	2#6	3#8	3#8		6" S	ADD 2#8 T. CONT.		
5B-35	26"	26"	2#9					6" S	ADD 2#8 T. CONT.		
5B-36	12"	15"	2#10	2#8				6" S	ADD 2#8 T. CONT.		
5B-37	16"	15"	2#9	2#8				6" S	ADD 2#8 T. CONT.		
5B-38								6" S	ADD 2#8 T. CONT.		
5B-39	18"	15"	2#5	3#6		3#8		6" S	ADD 2#8 T. CONT.		
5B-40	18"	15"	3#10	2#10				6" S	ADD 2#8 T. CONT.		
5B-41	14"	26"	2#8	3#8	2#7	2#7		6" S	ADD 2#8 T. CONT.		
5B-42	14"	26"	4#6					6" S	ADD 2#8 T. CONT.		
5B-43	18"	15"	4#10	2#10				6" S	ADD 2#8 T. CONT.		
5B-44	16"	15"	2#7	3#7	2#5	2#5		6" S	ADD 2#8 T. CONT.		
5B-45	12"	15"	2#9	2#8				6" S	ADD 2#8 T. CONT.		
5B-46	30"	15"	3#8	5#9	2#6	2#8		6" S	ADD 2#8 T. CONT.		
5B-47	18"	15"	3#8	2#8	4#8	2#6		6" S	ADD 2#8 T. CONT.		
5B-48	24"	15"	3#7	6#6	3#7	2#6		6" S	ADD 2#8 T. CONT.		
5B-49	14"	15"	2#4	2#5		2#4		6" S	ADD 2#8 T. CONT.		
5B-50	10"	15"	2#6					6" S	ADD 2#8 T. CONT.		
5B-51	16"	15"	4#5					6" S	ADD 2#8 T. CONT.		
5B-52	18"	15"	4#5					6" S	ADD 2#8 T. CONT.		
5B-53	30"	15"	3#7	4#9				6" S	ADD 2#8 T. CONT.		

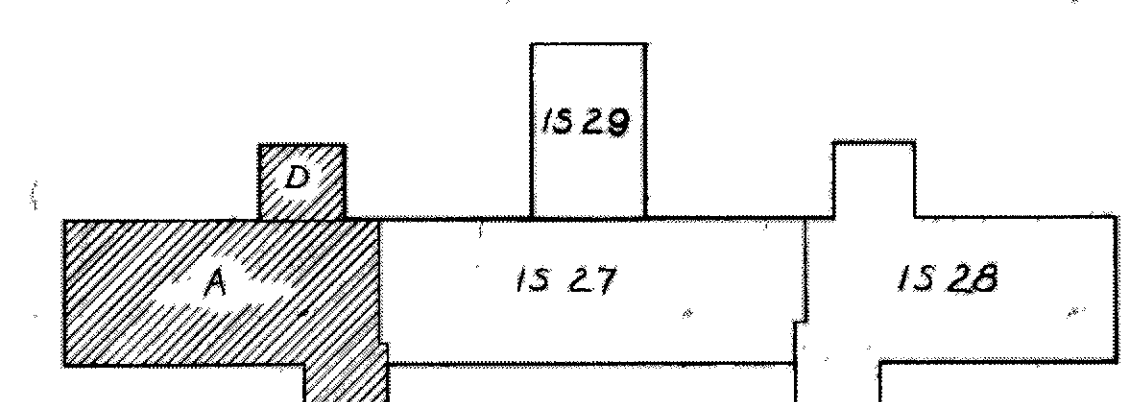

SCALE 1/4" = 1'-0"

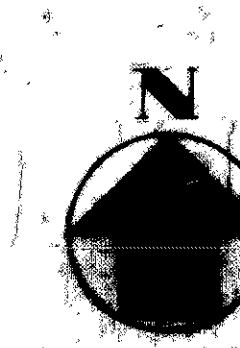

AS BUILT	
FIFTH FLOOR FRAMING PLAN UNITS A & D	
BUILDING NO. 1	
800 BED GM&S HOSPITAL & REGIONAL OFFICE MEDICAL CLINICS	
VETERANS ADMINISTRATION CLEVELAND (WADE PARK), OHIO	
DRAWN BY: J. L. L. L. L. CHECKED BY: J. L. L. L. L. DATE: 2/1/77	REVISIONS 1-526 2-526
DALTON-DALTON ASSOCIATES SMITH, HINCHMAN & GRYLLS ASSOC., INC. ARCHITECTS-ENGINEERS 179 THE ARCADE CLEVELAND 14, OHIO	
APPROVED DIRECTOR, DESIGN SERVICE 6-4085	

RETURN TRACINGS TO PLAN FILES

AS BUILT  
FILE FOLDER NO. 2A