



| CONCRETE BEAM SCHEDULE |                   |       |               |          |          |          |      |  |                       |                    |  |
|------------------------|-------------------|-------|---------------|----------|----------|----------|------|--|-----------------------|--------------------|--|
| MARK                   | WIDTH             | DEPTH | REINFORCEMENT |          |          |          |      |  | STIRRUPS<br>@ EA. END | REMARKS            |  |
|                        |                   |       | BOTTOM        |          | TOP      |          | ARR. |  |                       |                    |  |
|                        |                   |       | STRAIGHT      | BENT     | STRAIGHT | BENT     |      |  |                       |                    |  |
|                        |                   |       | NO. SIZE      | NO. SIZE | NO. SIZE | NO. SIZE |      |  |                       |                    |  |
| RB-54                  | 8                 | 16    | 2-#8          |          |          |          |      |  | 2-#8 @ 6" THRUOUT     | ADD 2-#4 T. CONT.  |  |
| RB-55                  | VALUES<br>12" 14" | 27    | 4-#6          |          |          |          |      |  |                       | ADD 2-#6 T. CONT.  |  |
| RB-56                  | VALUES<br>12" 14" | 27    | 2-#5          | 2-#7     | 2-#5     | 2-#5     |      |  | 2-#3 @ 6"             | ADD 2-#7 T. CONT.  |  |
| RB-57                  | 14                | 24    | 5-#5          |          |          |          |      |  |                       |                    |  |
| RB-58                  | 14                | 24    | 2-#8          | 3-#9     |          |          |      |  | 14-#3 @ 14"           |                    |  |
| RB-59                  | 14                | 16    | 2-#5          | 2-#5     |          | 2-#5     |      |  | 6-#3 @ 6"             |                    |  |
| RB-60                  | 10                | 16    | 2-#7          |          |          |          |      |  | 4-#3 @ 6"             | ADD 2-#5 T. CONT.  |  |
| RB-61                  | 14                | 27    | 4-#6          |          |          |          |      |  | 4-#3 @ 6"             | ADD 2-#6 T. CONT.  |  |
| RB-62                  | 14                | 27    | 2-#7          | 2-#8     |          |          |      |  | 4-#3 @ 6"             | ADD 2-#7 T. CONT.  |  |
| RB-63                  | 30                | 16    | 4-#8          | 5-#9     | 3-#7     | 3-#7     |      |  | 12-#3 @ 12"           | ADD 2-#8 T. CONT.  |  |
| RB-64                  | VALUES<br>12" 14" | 26    | 2-#8          |          |          |          |      |  | 12-#3 @ 12"           | ADD 2-#8 T. CONT.  |  |
| RB-65                  | 12                | 20    | 2-#9          | 2-#9     |          | 1-#10    |      |  | 4-#3 @ 12"            | ADD 2-#9 T. CONT.  |  |
| RB-66                  | 12                | 20    | 2-#7          |          |          |          |      |  |                       | ADD 2-#7 T. CONT.  |  |
| RB-67                  | 12                | 16    | 2-#8          | 2-#7     |          |          |      |  |                       |                    |  |
| EB-1                   | 14                | 18    | 4-#6          |          |          |          |      |  |                       |                    |  |
| EB-2                   | 14                | 18    | 3-#10         |          |          |          |      |  | 6-#3 @ 6"             |                    |  |
| EB-3                   | 14                | 21    | 3-#10         |          |          |          |      |  |                       |                    |  |
| EB-4                   | 8                 | 21    | 2-#11         |          |          |          |      |  |                       |                    |  |
| EB-5                   | 8                 | 21    | 3-#5          |          |          |          |      |  | 4-#3 @ 6"             | ADD 2-#5 T. CONT.  |  |
| EB-6                   | 10                | 51    | 2-#8          |          |          |          |      |  | 4-#3 @ 6"             | ADD 2-#8 T. CONT.  |  |
| EB-7                   | 10                | 30    | 3-#9          |          |          |          |      |  | 4-#3 @ 6"             | ADD 2-#9 T. CONT.  |  |
| EB-8                   | 10                | 30    | 2-#8          |          |          |          |      |  | 4-#3 @ 6"             | ADD 2-#8 T. CONT.  |  |
| EB-9                   | 12                | 30    | 2-#8          |          |          |          |      |  | 4-#3 @ 6"             | ADD 2-#8 T. CONT.  |  |
| EB-10                  | 14                | 36    | 4-#11         |          |          |          |      |  | 4-#3 @ 6"             | ADD 2-#11 T. CONT. |  |
| EB-11                  | 8                 | 12    | 2-#5          |          |          |          |      |  |                       |                    |  |
| EB-12                  | 14                | 36    | 4-#11         |          |          |          |      |  | 15-#3 @ 6"            | ADD 2-#11 T. CONT. |  |
| EB-13                  | 14                | 36    | 4-#11         |          |          |          |      |  | 15-#3 @ 6"            | ADD 2-#11 T. CONT. |  |
| EB-14                  | 9                 | 51    | 2-#11         |          |          |          |      |  | 15-#3 @ 6"            | ADD 2-#11 T. CONT. |  |

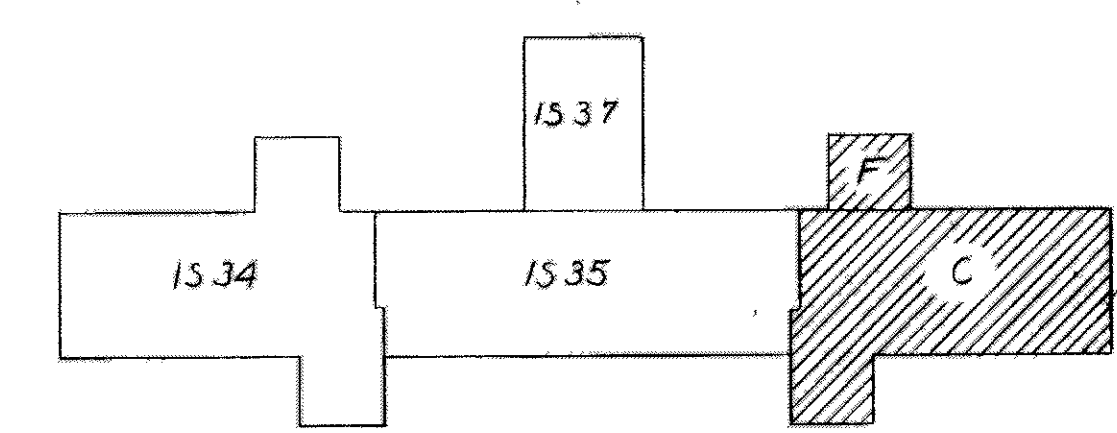

SCALE 1/8"=1'-0"

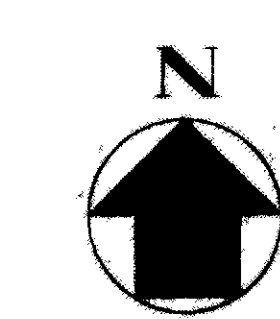

|   |                                      |
|---|--------------------------------------|
| ROOF FRAMING PLAN UNITS C & F   |                                      |
| BUILDING NO. 1  |                                      |
| 800 BED GM&S HOSPITAL & REGIONAL OFFICE MEDICAL CLINICS   |                                      |
| VETERANS ADMINISTRATION CLEVELAND (WADE PARK), OHIO   |                                      |
| DRAWN BY: J.A. McLELLAN<br>CHECKED BY: J.A. McLELLAN<br>DATE: 2/1/61  | REVISIONS<br>1-536<br>SHEET 36 OF 52 |
| DALTON-DALTON ASSOCIATES<br>SMITH, HINCHMAN & GRYLLS ASSOC., INC.<br>ARCHITECTS-ENGINEERS<br>879 THE ARCADE<br>CLEVELAND 14, OHIO |                                      |
| APPROVED DIRECTOR, DESIGN SERVICE<br>PROJ. NO. 6-4085   |                                      |

AS BUILT