


SCALE:  
 $\frac{1}{16}" = 1'$



Revisions Date		Professional Seal		Drawing Title PARTIAL FIRST FLOOR PLAN ARCHITECTURAL	Project Title AS-BUILT Drawings		Date 01-26-2016
				Approved:	Building Number 500	Checked Drawn	Project No.
				Approved:	Location VA RICHMOND		Drawing No.

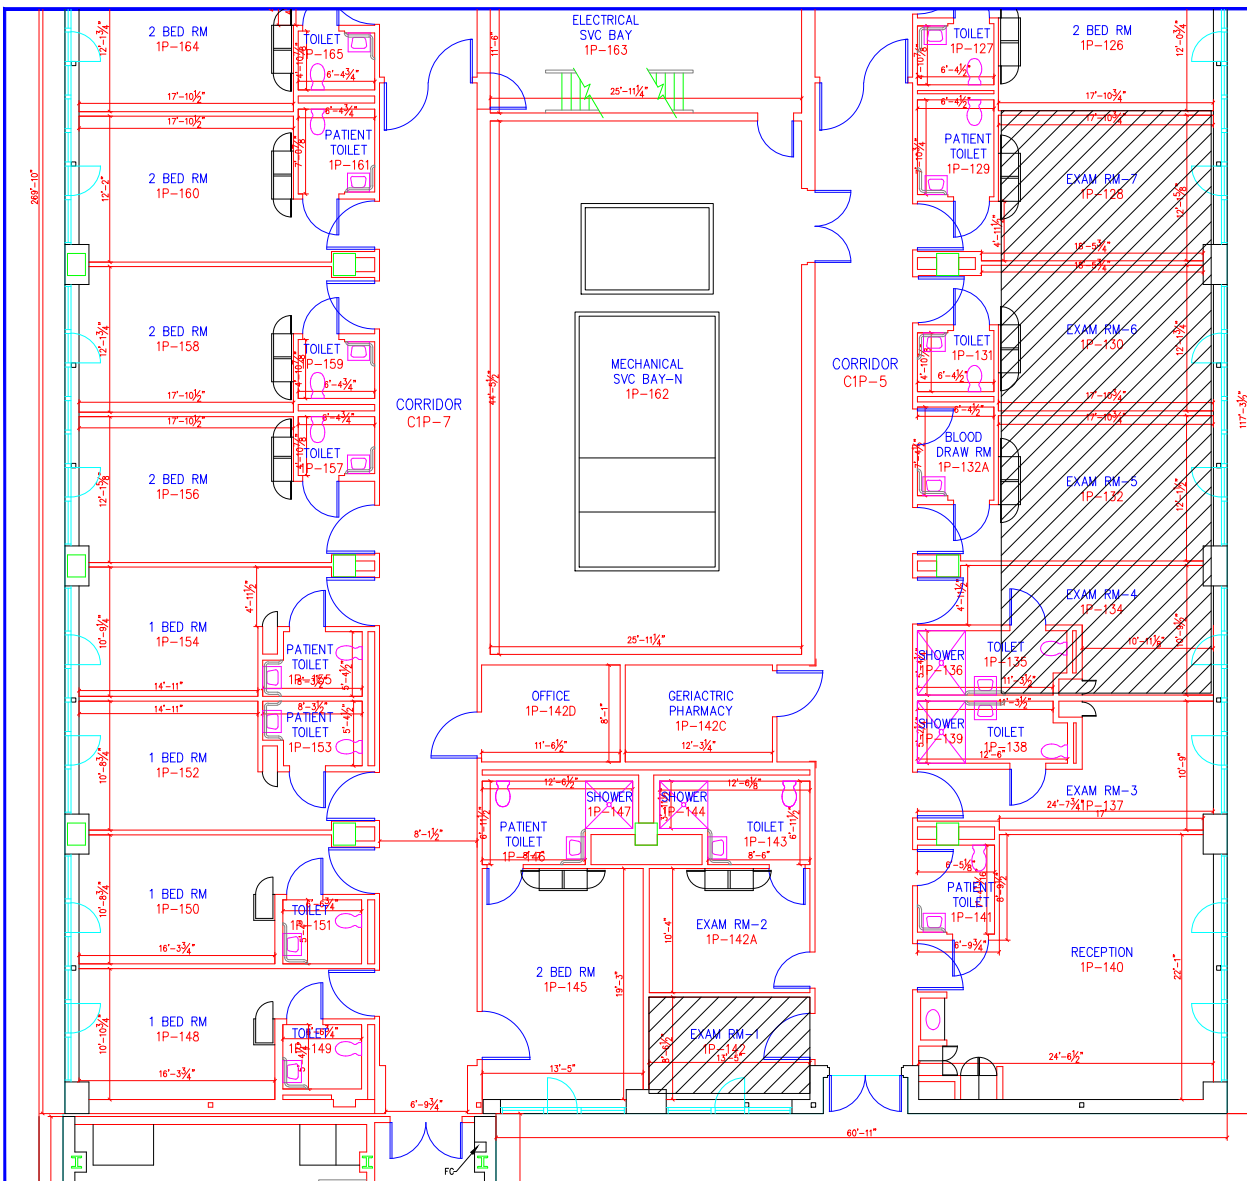