

LEGEND




#1 AT&T WSRBS

400' 6" supply

700' 1" RETURN

ALL RUCKWELL PIPE

Scale: 1" = 100' (horizontal), 1" = 20' (vertical)
 Updates from AS-BUILTS: 03/15/12
 Areas Requiring Clarification: 11/27/12

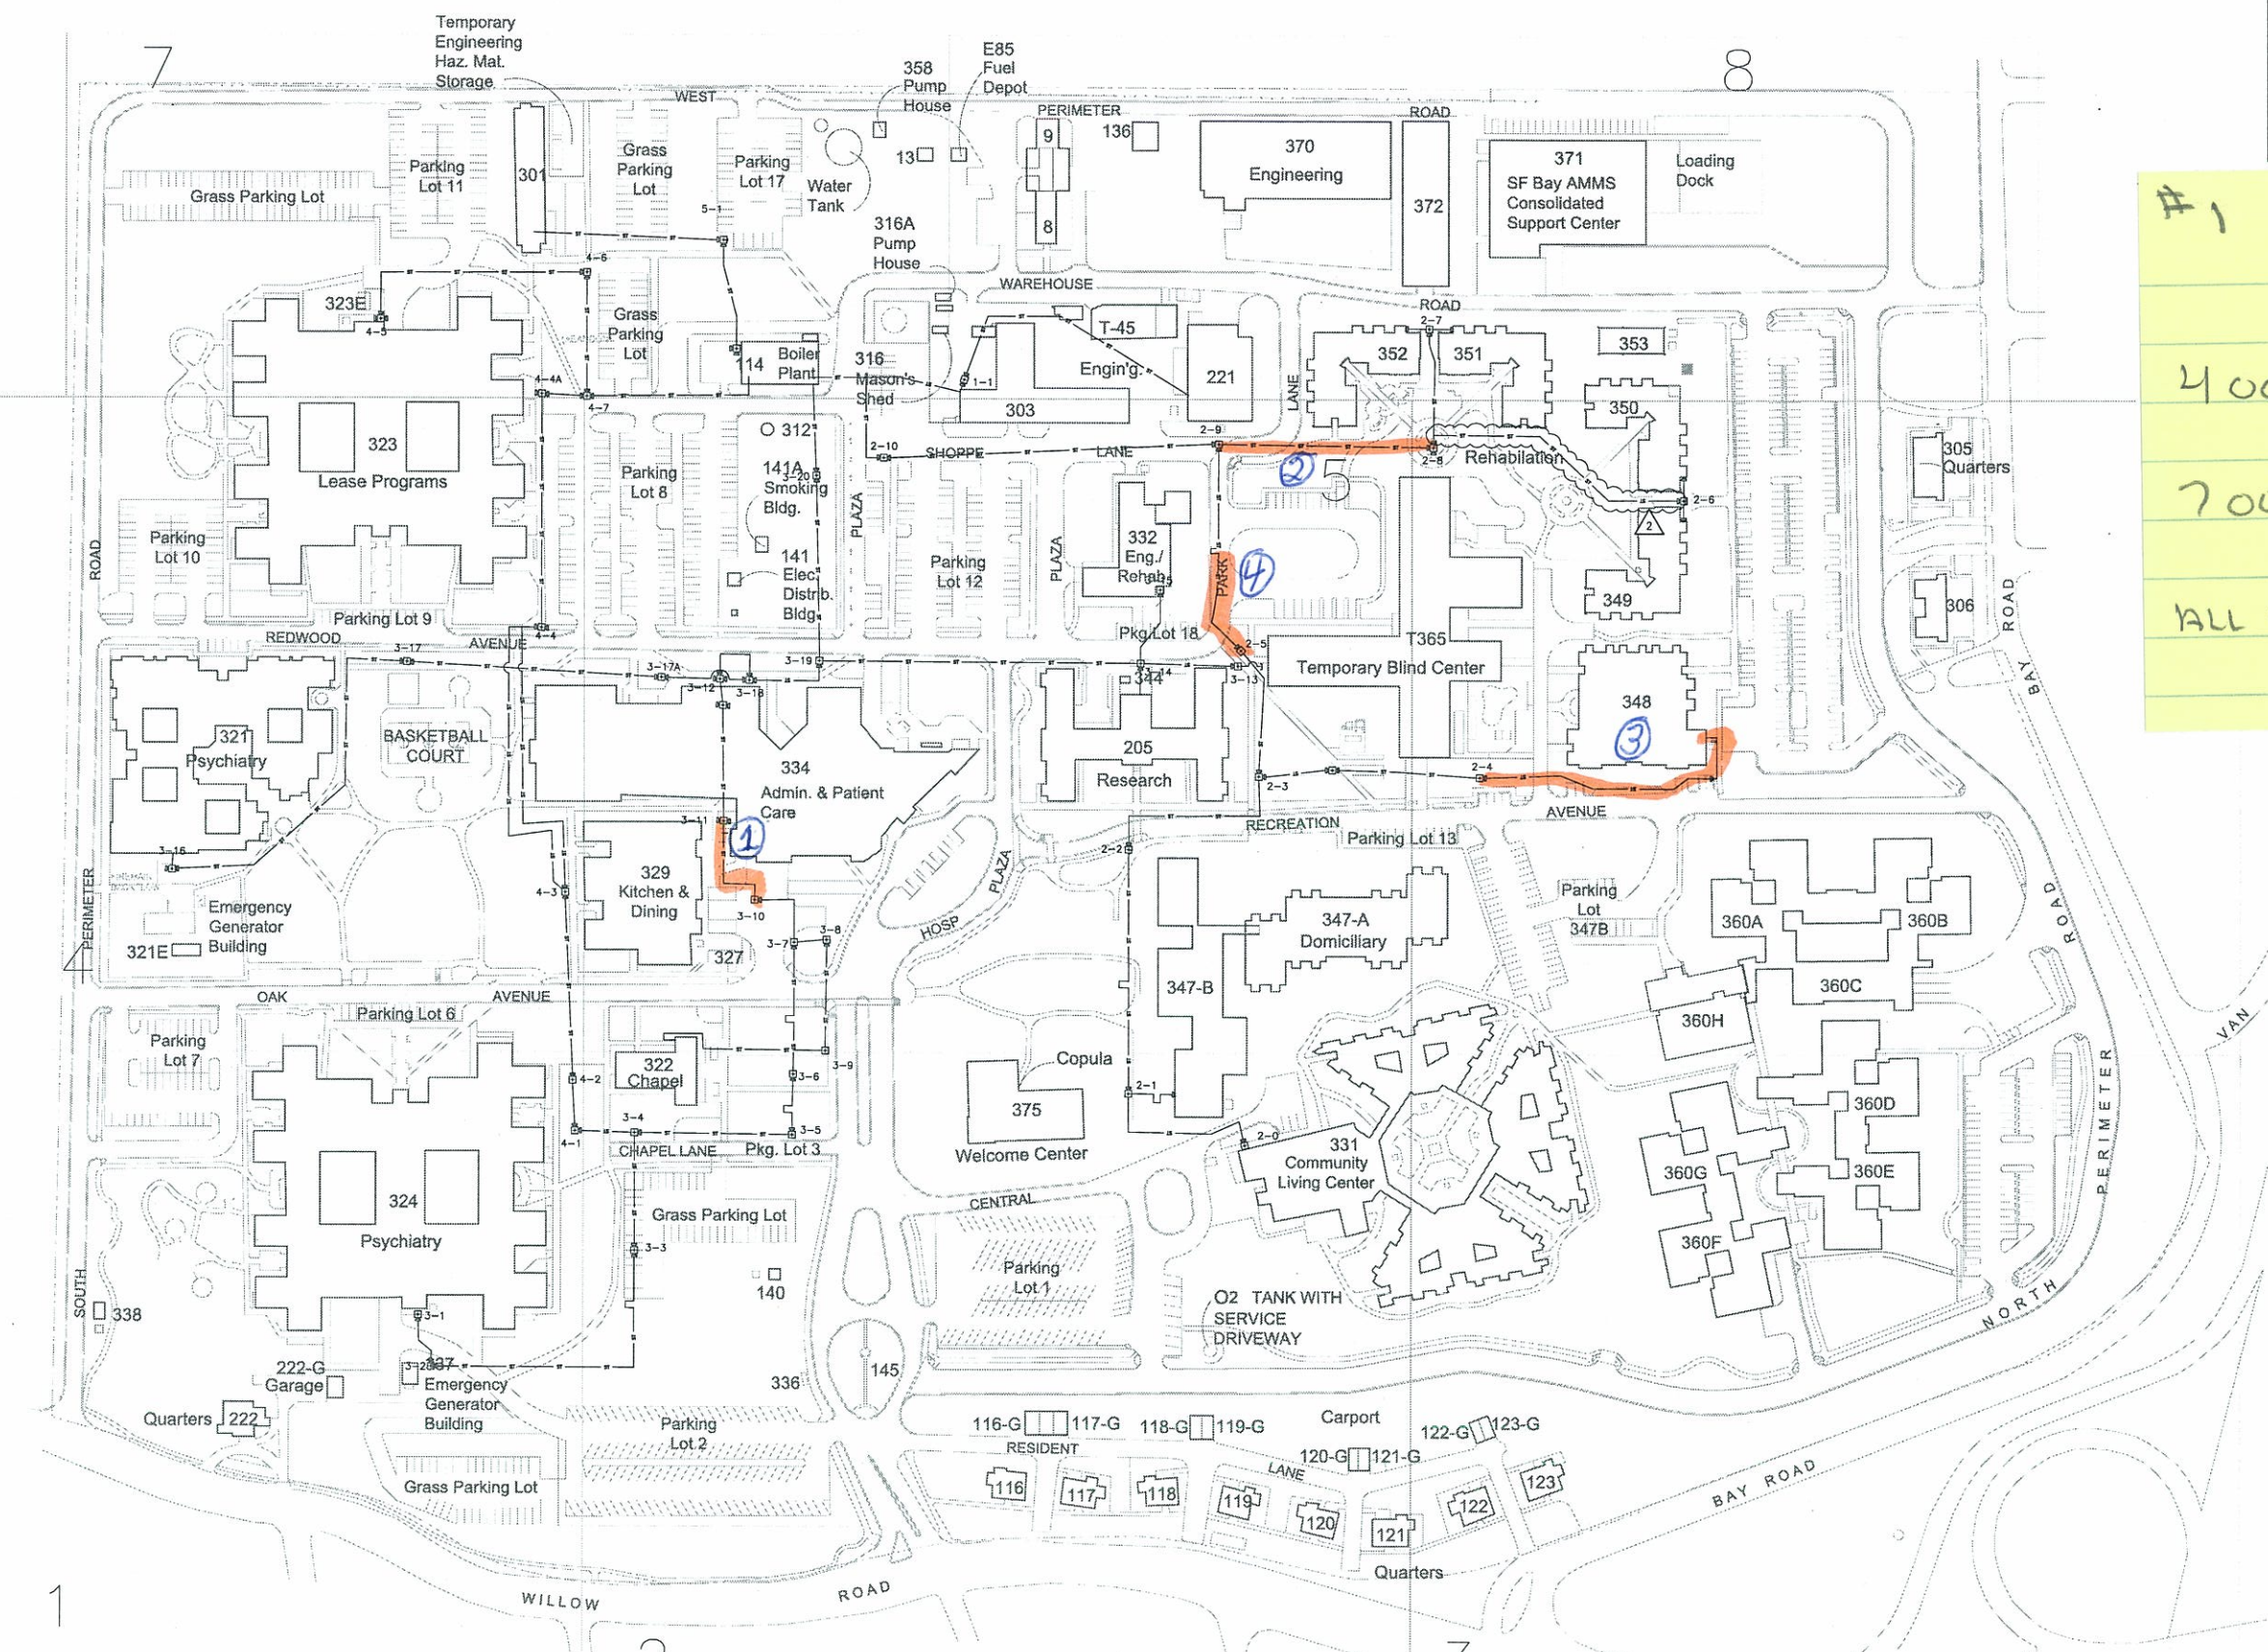

CONSULTANTS:

ARCHITECT/ENGINEERS:

Referenced From:
 JOSEPH CHOW & ASSOCIATES, INC.
 650 DELANCEY STREET, SUITE 211
 SAN FRANCISCO, CALIFORNIA 94107
 415-777-1288 (T) / 415-777-2552 (F)
 EMAIL: JCHOW@JCHOWARCHITECTS.COM
 CONTACT: JOSEPH CHOW

Drawing Title

UTILITY EXHIBIT
 STEAM LINES
 Approved Project Director:
 VAPACUS PLANNING AND ENGINEERING

Project Title


MPD SITE UTILITIES
 (FOR REFERENCE ONLY)
 (NOT FIELD VERIFIED)
 Location: MPD MENLO PARK CA
 Date: 2013/02/07
 Checked: JR
 Drawn: JPM

Project Number

640-13-000M
 Building Number:
 Drawing Number:
 CU-STM
 Dwg. # of --

Office of
 Construction
 and Facilities
 Management




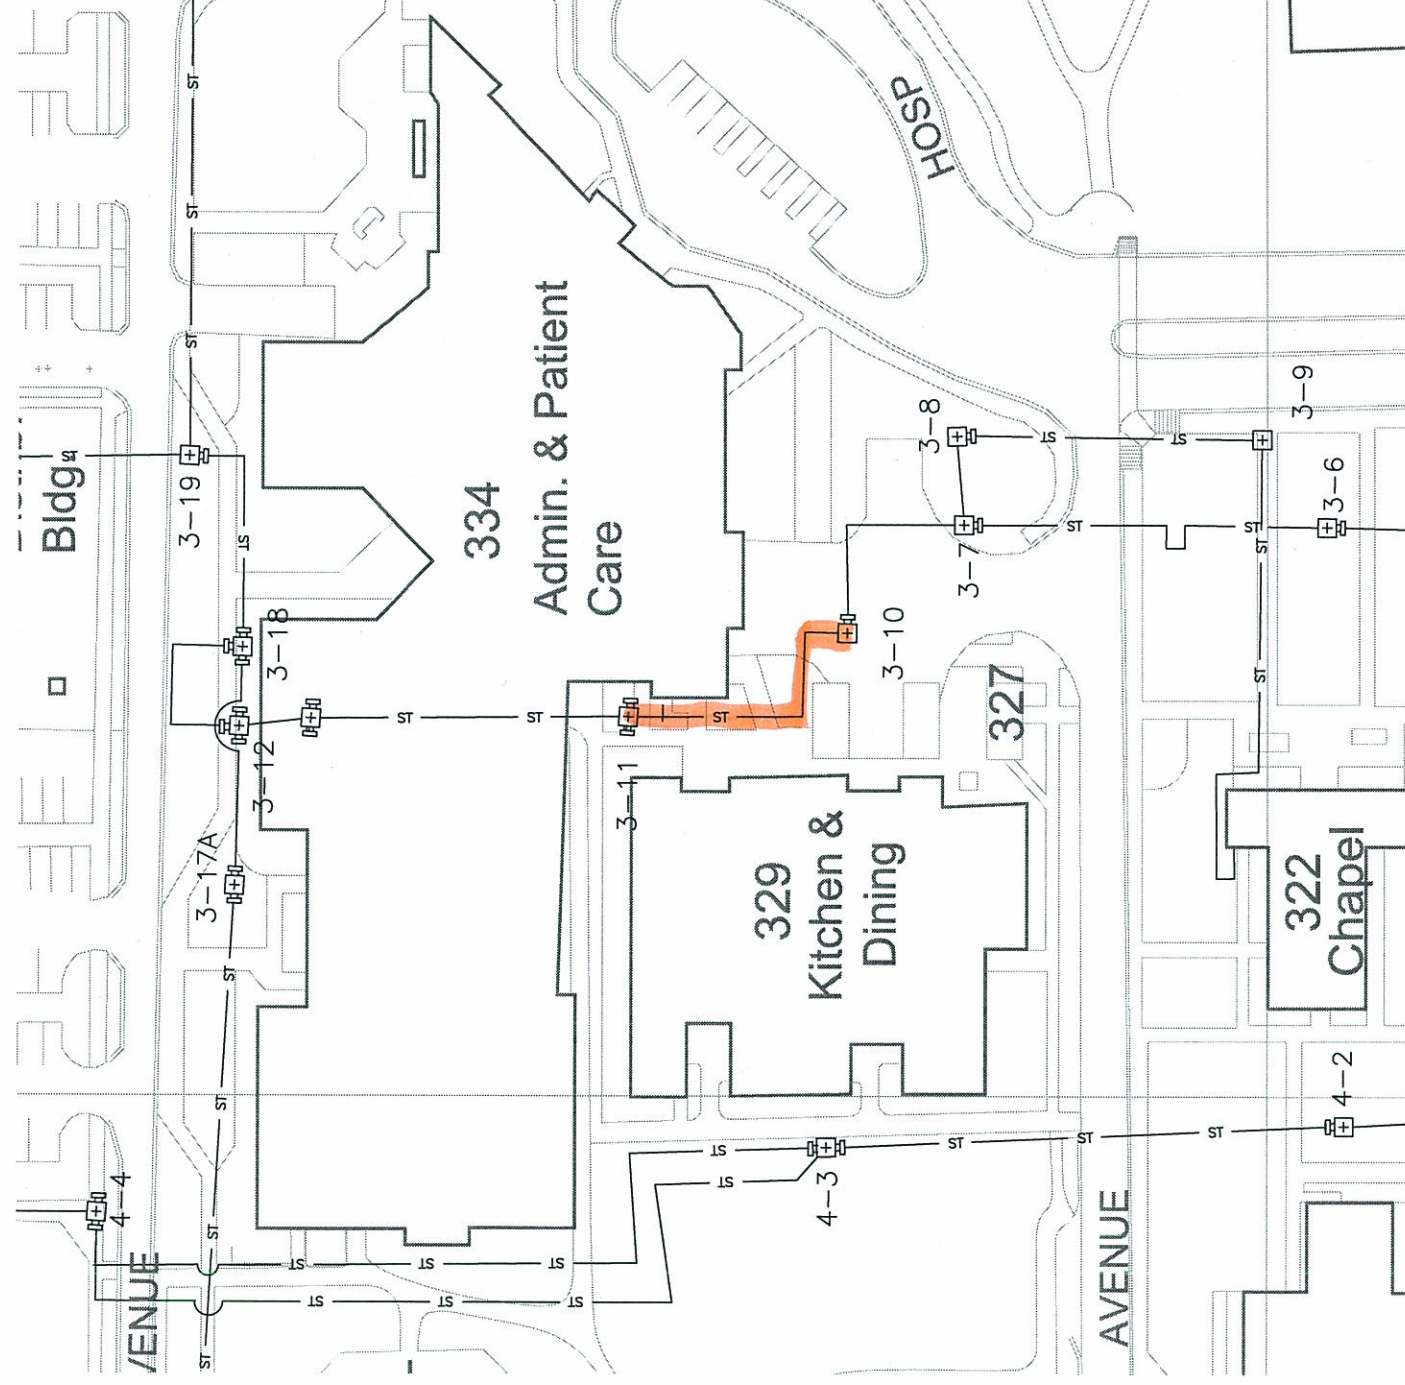


#1

6" STEAM SUPPLY
APPROX 200 L.F. OF PIPE

BT'S
WIRES

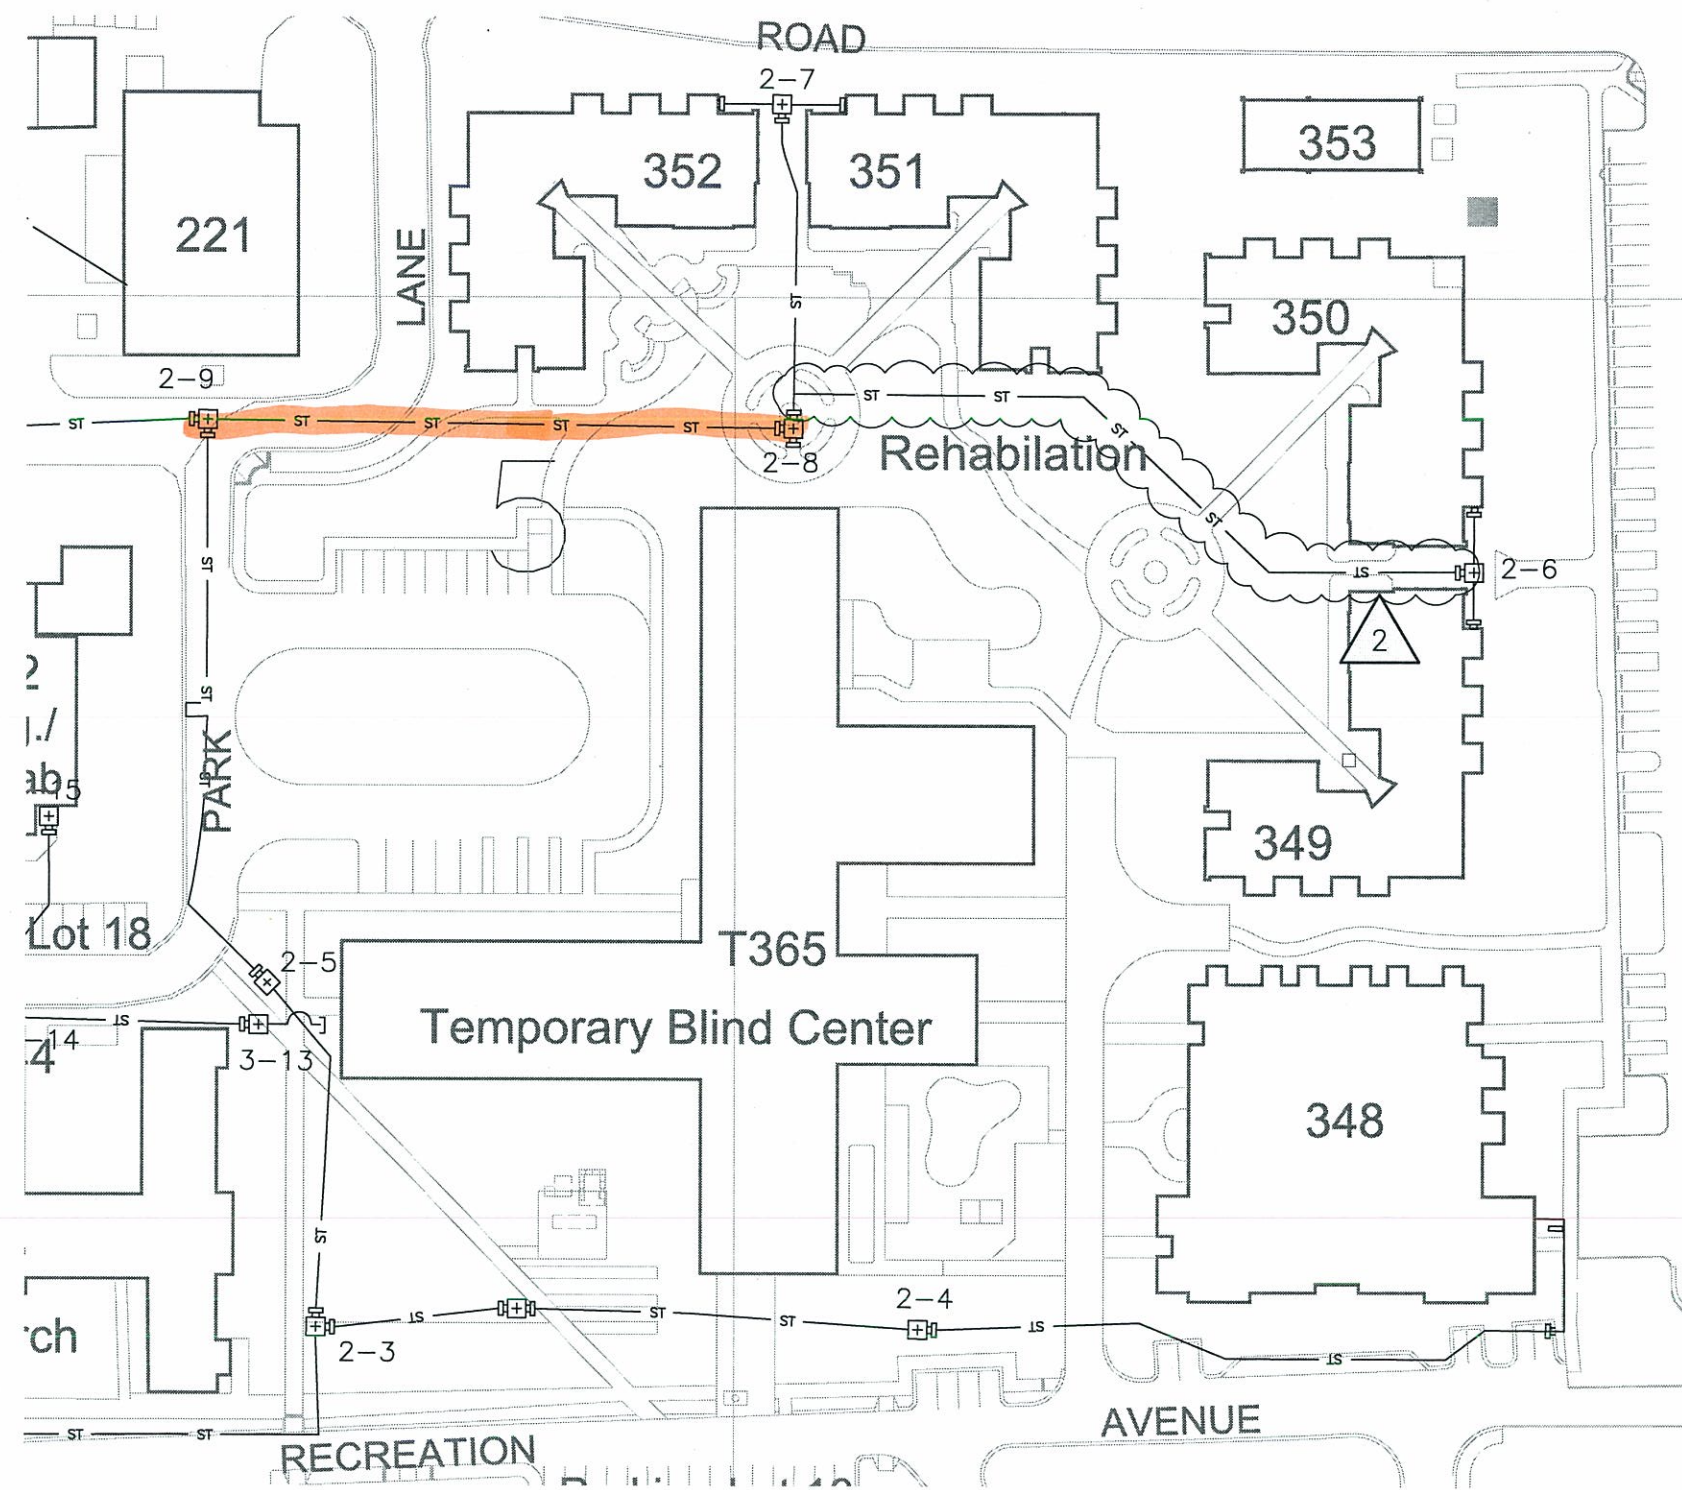


#2 1" CONDENSATE RETURN
APPROX 300 L.F. OF PIPE

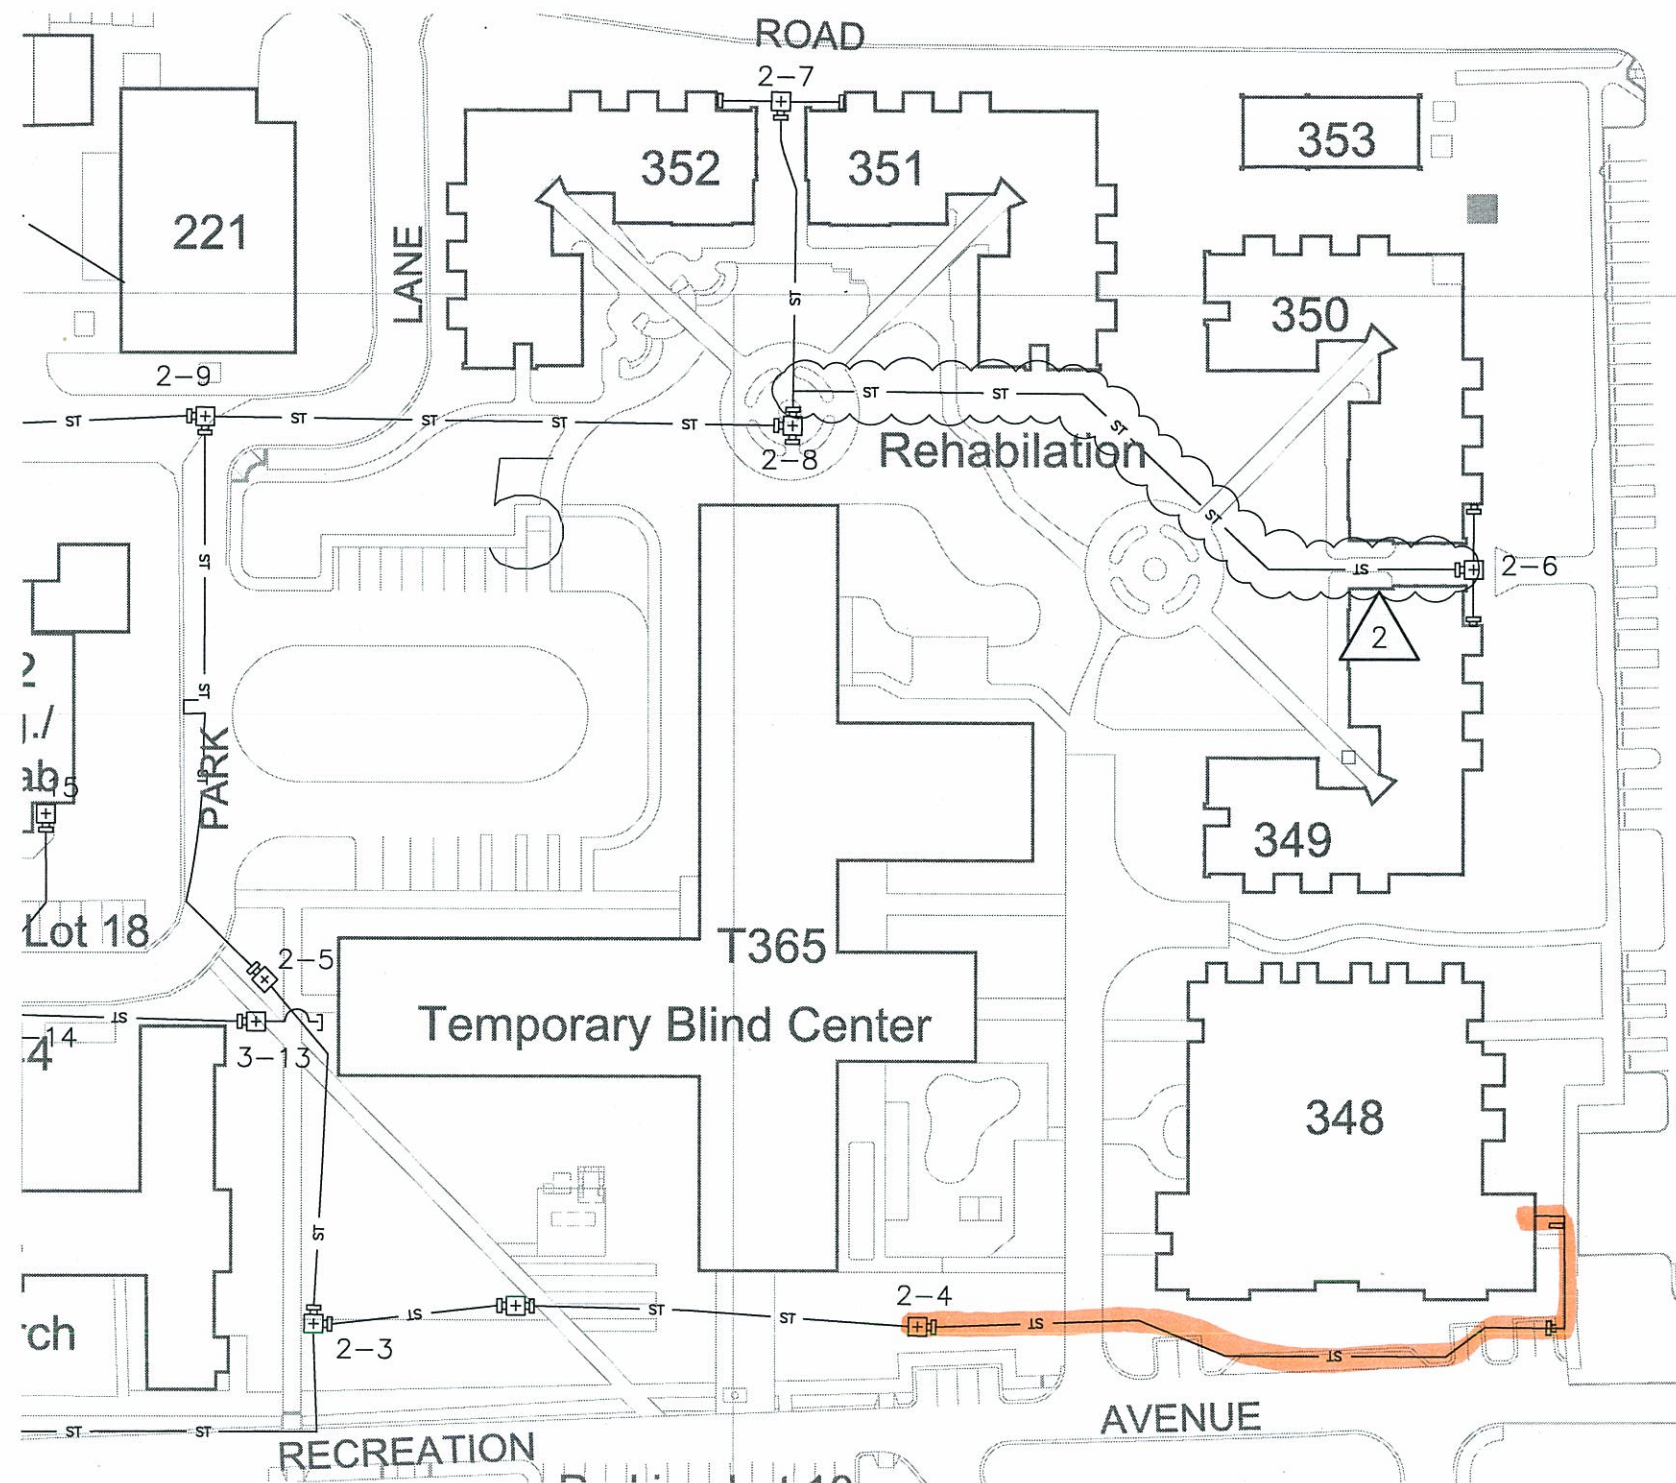

#3

1" CONDENSATE RETURN
APPROX 400 L.F. OF PIPE

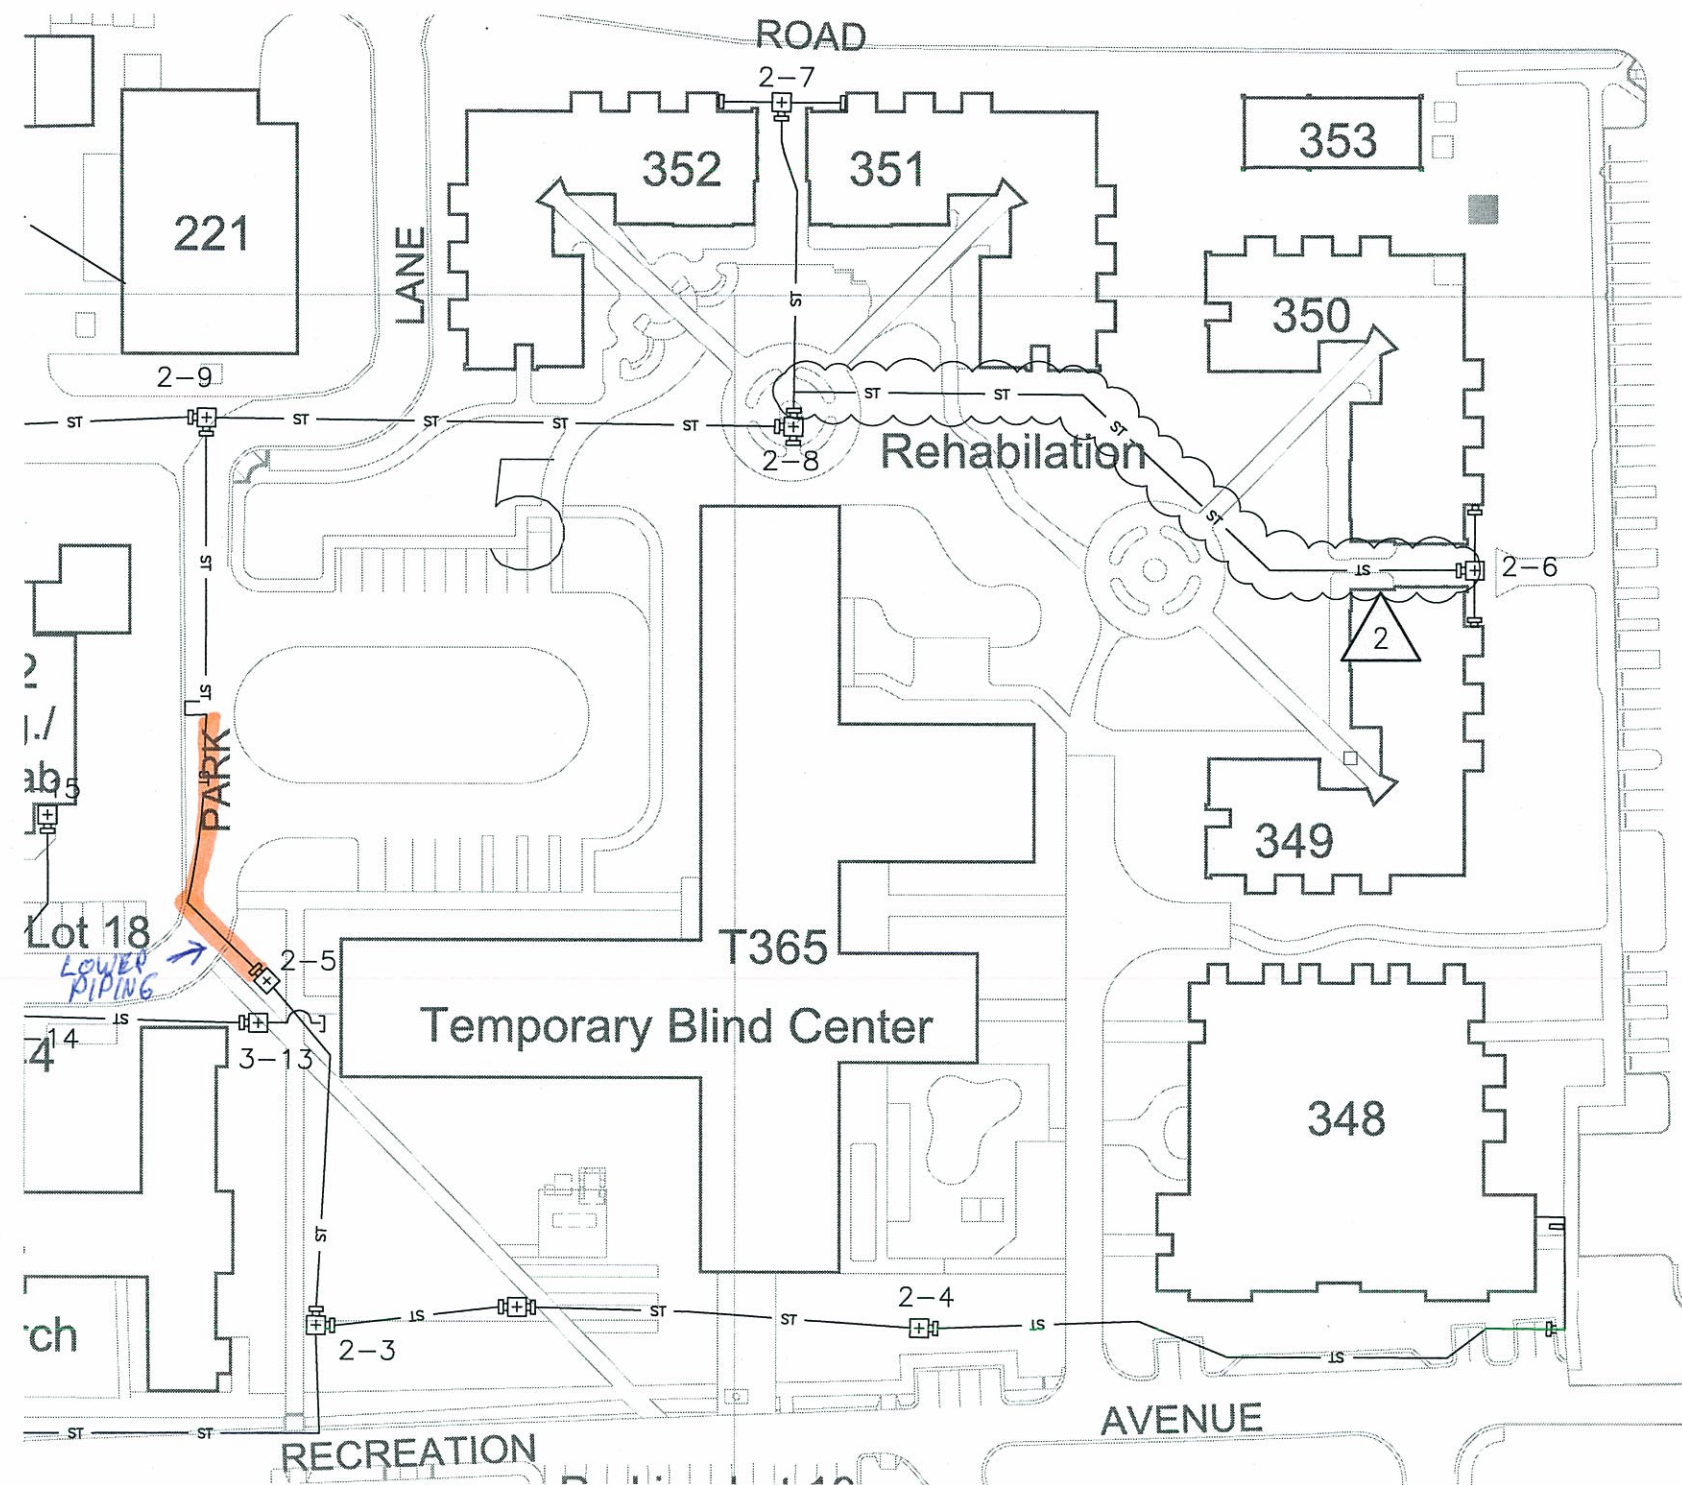

#4 6" STEAM SUPPLY PIPING TOO SHALLOW
APPROX 200 L.F. OF PIPE