


Mountain Home (Johnson City), Tennessee



BUILDING INDEX	
NO.	BUILDING
1	STSU MID. SCHOOL
2	STSU MED. SCHOOL / VA
3	STSU MED. SCHOOL (CONF.)
4	STSU MID. SCHOOL LIBRARY
5	STSU RESEARCH LAB (CONF.)
6	STSU RESEARCH LAB (FUTURE)
7	STS CLASSES, AMB. SVC. / PHYSICAL
8	RESTAURANT
9	CHAPEL
10	HOSPITAL GUEST HOUSE (LEASED)
11	SINGLE QTRS. (LEASED)
12	CARRIAGE LIBRARY (LEASED)
13	STSU GARAGE
14	HUMAN RESOURCE MGT.
15	
16	
34	MUSEUM/STSU LABS/BOOKSTORE
35	ENCL. SERVICES/CANTINE
36	MUSICAL THEATER (LEASED)
37	OLD MORGUE
38	PSYCH. BLDG.
39	DUPLEX GARAGE
40	RESIDENT ENGINEERS
41	PH ADMIN. OFFICES
42	PH PLANNING/DESIGN
43	(VACANT)
44	SINGLE QUARTERS
45	SINGLE QUARTERS
46	SINGLE QUARTERS
47	SINGLE QUARTERS
48	STSU MID. SCHOOL
49	U.S. POST OFFICE
50	STSU (VACANT)
51	
52	HOSPITAL ADMIN. BLDG.
53	
54	
77	CLINICAL SUPPORT BLDG.
78	
79	
80	
81	
82	
83	4-CAR GARAGE
84	2-CAR GARAGE
85	
86	
87	
88	FLAGPOLE
89	3-CAR GARAGE
90	2-CAR GARAGE
91	WATER METER/WALKER HOUSE
92	WATER TANK
93	
94	MEHC BOQ PLANT
95	WATER ELECT. SUBSTATION
96	EMER. GEN. BLDG.
97	NAT. CHEMISTRY ADMIN.
98	HEAT. CHEMISTRY STOV.
99	STSU MID. SCHOOL LAB BLDG.
100	MEHC BLDG. 100-1A/10
101	
102	
103	
104	
105	
106	
107	
108	
109	DOMICILIARY / FISCAL CARE
110	STSU GEN BLDG.100
111	MEHC
112	STSU RESEARCH BLDG.
113	
114	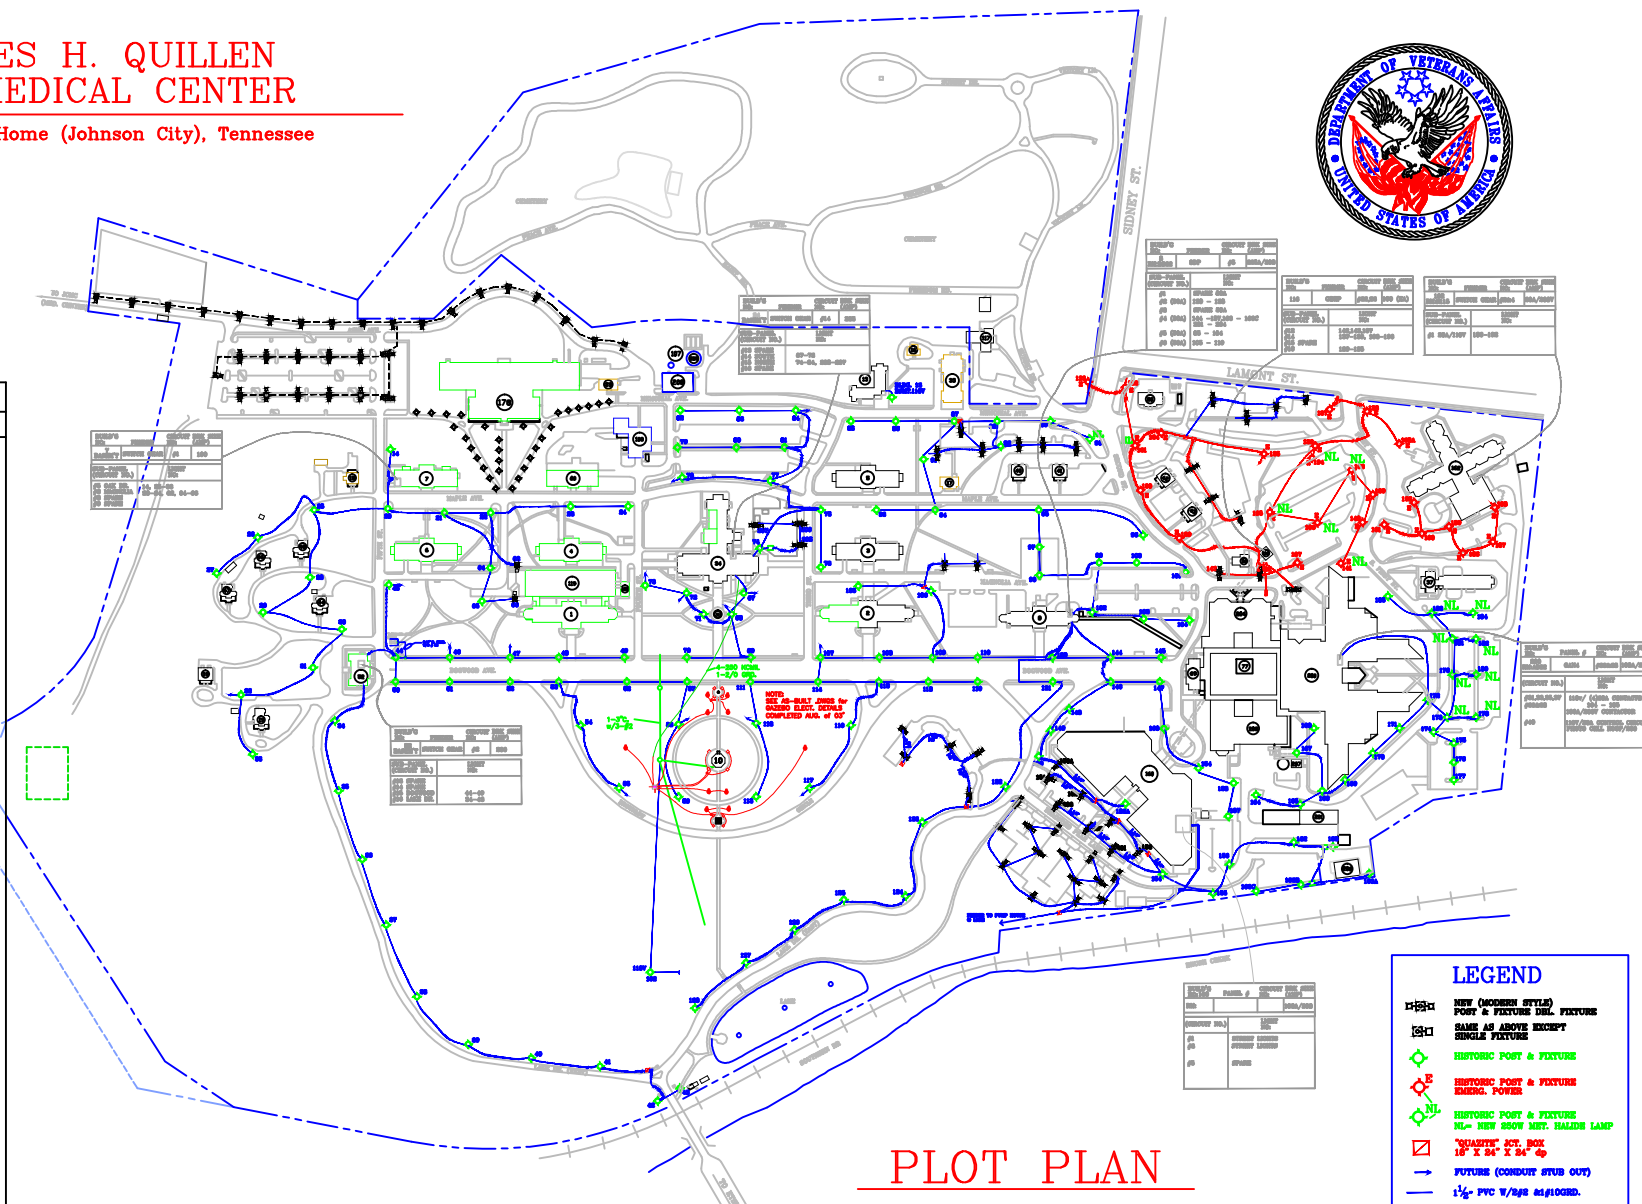
PLOT PLAN

Drawing Title STREET LIGHTING		Project Title AS-BUILT		Date 9/19/03
Approved Chief, Facilities Management		Building Number	Checked	Project No.
			Drawn CARON	Drawing No.
Approved Chief, Planning & Design		Location MOUNTAIN HOME, TN		ESL-1 Dep. 1 of 1