

**SHEET NOTES**

- NOTES:**
1. REFERENCE ARCHITECTURAL FOR DEMOLITION DRAWINGS.
  2. LOW VOLTAGE CONTRACTOR TO PULL BACK EXISTING COPPER AND FIBER FEEDS FROM EACH TRAILER TO THEIR SOURCE.
- DEMOLITION KEY NOTES:**
1. REMOVE EXISTING COPPER, FIBER, & SECURITY CABLING FROM TEMPORARY TRAILERS AND PULL BACK TO GRATE.
  2. EXISTING CITY OF LOMA LINDA FIBER OPTIC PULLBOX WITH 24 3M FIBER.
  3. EXISTING (3) 4" CONDUITS TO PULLBOX BELOW GRATE.
  4. EXISTING GRATE WITH UTILITIES BELOW.
  5. GENERAL CONTRACTOR TO DISCONNECT AND REMOVE ALL EXISTING TELECOM, PA & DATA SERVICES AND TURN OVER TO THE CITY.
  6. PULL BACK 24 3M FIBER FROM PB-1 TO PB-2 RELOCATE FROM PB-2 TO PB-3 OR SPlice NEW PIECE AS REQUIRED. PULLBOX PB-1 TO BE REMOVED AFTER FIBER RELOCATED.


Where does the city fiber that comes into this pull box continue onto? looking at this drawing it appears to dead end in this pull box. please clarify the fiber optic relocation scope of work

during the site visit it was observed that this pull box is not located in this location. Please identify where this pull box is located. We did find a pull box that might be this one about 100' away

There are three pull boxes in this vent shaft, some have 480v in them and some appear to have low voltage, please identify which of the three is the one that we are to run the new fiber thru and which contains the existing city fiber

During the site visit it was observed that this pull box is not located in this location? Is there an existing PB3? we could not find one

Possible location of PB2

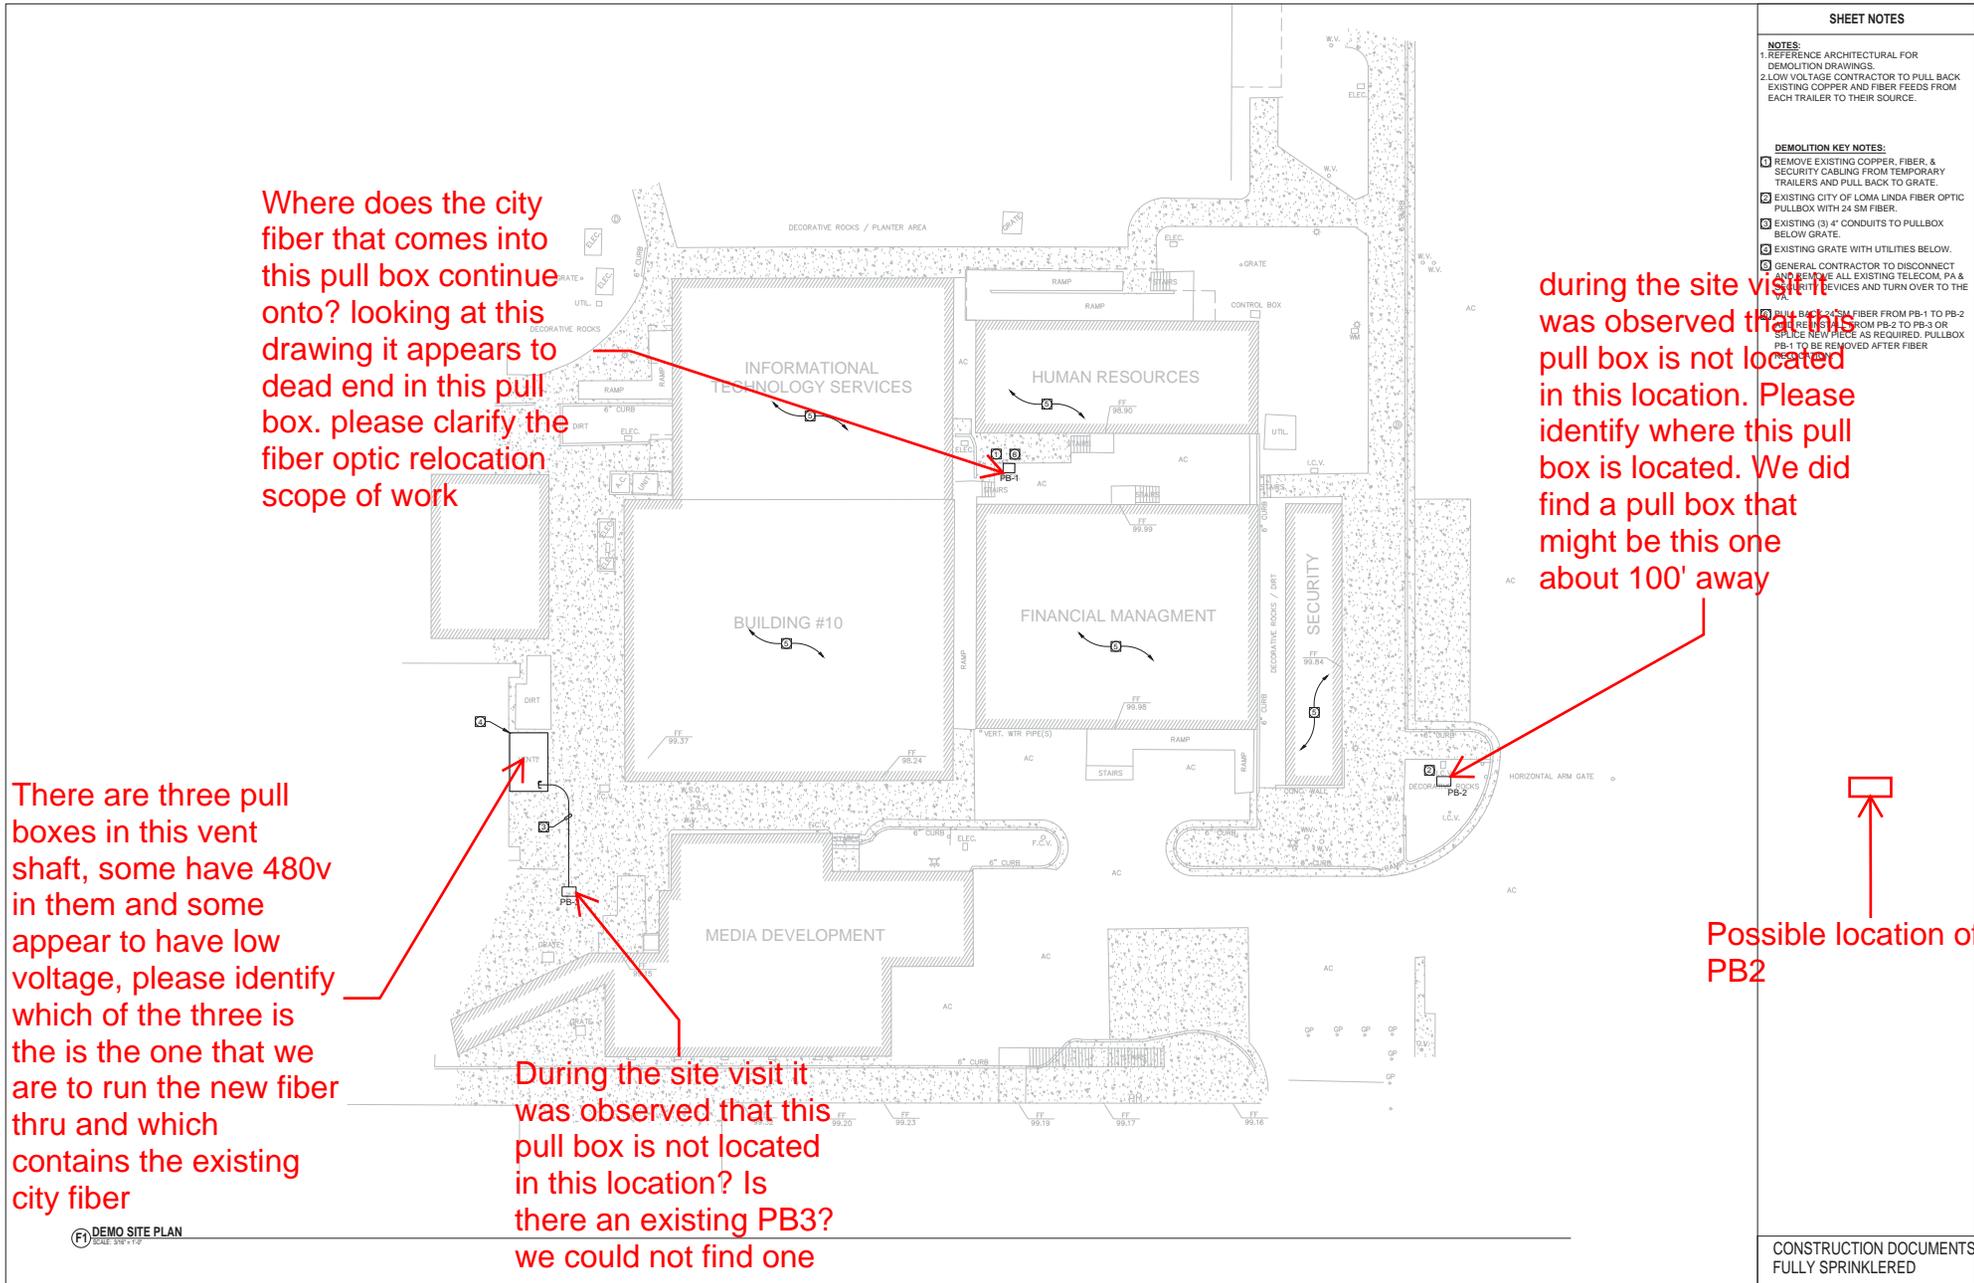

**(F1) DEMO SITE PLAN**  
SCALE: 3/4" = 1'-0"

CONSTRUCTION DOCUMENTS FULLY SPRINKLERED

No.	Description	Date
1	SCHEMATIC DESIGN (SD)	03/11/2015
2	DESIGN DEVELOPMENT (DD)	05/20/2015
3	CONSTRUCTION DOCUMENTS (CD)	05/26/2015

**CONSULTANTS:**

**ULTIMATE**  
Communication Systems

2579 W. WOODLAND DR. ANAHEIM, CA 92801  
TEL: (714) 484-3101 FAX: (714) 484-3102



**ARCHITECTS/ENGINEERS:**

**LEO A DALY** PLANNING ARCHITECTURE ENGINEERING INTERIORS

550 South Hope Street, 27th Floor  
Los Angeles, California 90071, USA  
213-629-0100 F213-629-0070 EST. 1915

Drawing Title: DEMO SITE PLAN

Approved: Project Director

Project Title: VA LOMA LINDA EYE CLINIC

Location: 11201 BENTON STREET, LOMA LINDA, CA 92307

Date: 05/26/16

Checked: DR

Drawn: AR

Project Number: 605-334

Building Number: 34

Drawing Number: ET002

Office of Construction and Facilities Management

