

ROOM No.	ROOM NAME
201 A	OFFICE
202	TREATMENT
203	TOILET
204	PHYSICIANS' OFFICE
205	BEDROOM
206	3 BED WARD
207	16 BED WARD
208	TOILET
209	EQUIPMENT STORAGE
210	DRESSING ROOM
210 A	SHOWER ROOM
211	KITCHEN
212	DAY ROOM
212 A	RECREATION ROOM
212 B	PORCH
213	BEDROOM
214	STAIR HALL
215	WOMENS' TOILET
215 A	WOMENS' TOILET
216	DOCTORS' OFFICE
217	SOCIAL WKR.
218	SBR
219	ALCOVE
219 A	TOILET
220	OXYGEN ROOM

ROOM No.	ROOM NAME
221	CLEAN LINEN ROOM
222	OFFICE
223	PSYCHOLOGISTS' OFFICE
224	UTILITY ROOM
224 A	UTILITY ROOM
225	STAIR HALL
226	OFFICE
227	DAY ROOM
227 A	PORCH
228	OFFICE
229	DRESSING ROOM
229 A	SHOWER ROOM
230	EQUIPMENT STORAGE
231	TOILET
232	16 BED WARD
233	3 BED WARD
234	DOCTORS' OFFICE
235	OFFICE
236	CONFERENCE ROOM
238	CORRIDOR
239	CORRIDOR
240	CORRIDOR
242	CORRIDOR
243	CORRIDOR
244	CORRIDOR
239 A	ELECTRICAL CLOSET
240 A	ELECTRICAL CLOSET
238 A	CORRIDOR


NOTES:

- EX. NORMAL BRANCH CIRCUIT FOR LIGHTING FIXTURE IN TOILETS, DRESSING ROOM, SHOWER & JANITOR CLOSET SHALL BE INTERCEPTED & RECONNECTED TO EMERGENCY CIRCUIT AS INDICATED. REMOVE EX. WIRE & ABANDON CONDUIT FROM POINT OF INTERCEPTION BACK TO PNL. BREAKER TO BECOME A SPARE.
- EX. LIGHTING FIXTURE TO REMAIN & BE DISCONNECTED FROM EX. NORMAL CIRCUIT. RECONNECT TO EMERGENCY CIRCUIT AS INDICATED. EX. NORMAL CIRCUIT TO BE MADE CONTINUOUS IF IN MIDDLE OF ELECTRICAL EQUIPMENT. IF AT END OF CIRCUIT REMOVE WIRE & ABANDON CONDUIT TO NEAREST ELECTRICAL EQUIPMENT.
- EX. LIGHTING FIXTURE TO REMAIN & BE DISCONNECTED FROM EX. NORMAL CIRCUIT. RECONNECT SO THAT (2) LAMPS ARE FED BY CIRCUIT 74LS1-2 & THE OTHER (2) LAMPS ARE CONTROLLED BY EX. NORMAL CIRCUIT. EX. CIRCUIT TO BE MADE CONTINUOUS IF ELECTRICAL EQUIPMENT IS IN MIDDLE OF CIRCUIT. IF AT END OF CIRCUIT, REMOVE WIRE & ABANDON CONDUIT TO NEAREST ELECTRICAL EQUIPMENT.
- CUT EX. 3/4" PLASTER & CONCRETE BLOCK WALL AS REQUIRED TO INSTALL NEW CONDUIT, RECESSED RECEPTACLES, SWITCHES & NIGHT LIGHTS (IF ANY) - PATCH & PAINT TO MATCH EX. ADJACENT SURFACES AFTER INSTALLATION.
- CUT THRU EX. 3/4" PLASTER & CONCRETE BLOCK WALL AS REQUIRED TO INSTALL NEW CONDUITS, PATCH (TYPICAL) & PAINT WALL (IF EXPOSED) TO MATCH EX. ADJACENT SURFACE AFTER INSTALLATION.
- EX. LIGHTING FIXTURE TO BE RELOCATED IN THIS ROOM DUE TO INTERFERENCE OF NEW WALL. CONTRACTOR SHALL MOVE LIGHT FIXTURE (1) TILE TO AVOID INTERFERENCE. EXTEND WIRING AS REQUIRED.
- CUT EX. PLASTER CEILING AS REQUIRED TO INSTALL NEW CONDUITS. PATCH & PAINT TO MATCH EX. ADJACENT SURFACES AFTER INSTALLATION.

SECOND FLOOR PLAN

SCALE: 1/8" = 1'-0"

NO. 9-30-81		RECORD DRAWINGS	
DATE	DESCRIPTION	REVISIONS:	
SHEET TITLE			
SECOND FLOOR PLAN			
BLDG. NO.	PROJECT TITLE		
74	EMERGENCY ELECTRICAL POWER SYSTEM		
DRAWN	CHECKED	DATE	
7793		6-25-79	
DRAWING NUMBER			
74-E3			
DWG. OF PROJECT NUMBER			
458-049			
VETERANS ADMINISTRATION			
LOCATION			
VAH, SALEM, VA.			

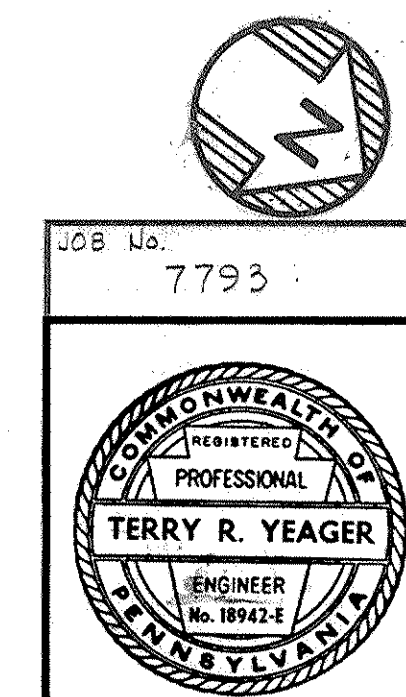

BARTON ASSOCIATES, INC.
CONSULTING ENGINEERS
415 NORWAY STREET
YORK, PENNA. 17403

APPROVED: PROJECT DIRECTOR
[Signature]

THREE INCHES EQUALS ONE FOOT

ONE AND ONE HALF INCHES EQUALS ONE FOOT

ONE INCH EQUALS ONE FOOT

THREE QUARTER INCH EQUALS ONE FOOT

ONE HALF INCH EQUALS ONE FOOT

THREE EIGHTH INCH EQUALS ONE FOOT

ONE QUARTER INCH EQUALS ONE FOOT

ONE EIGHTH INCH EQUALS ONE FOOT