


W/D FOR ELEVATOR TRANSFORMERS

120 x 120 / 16 x 16

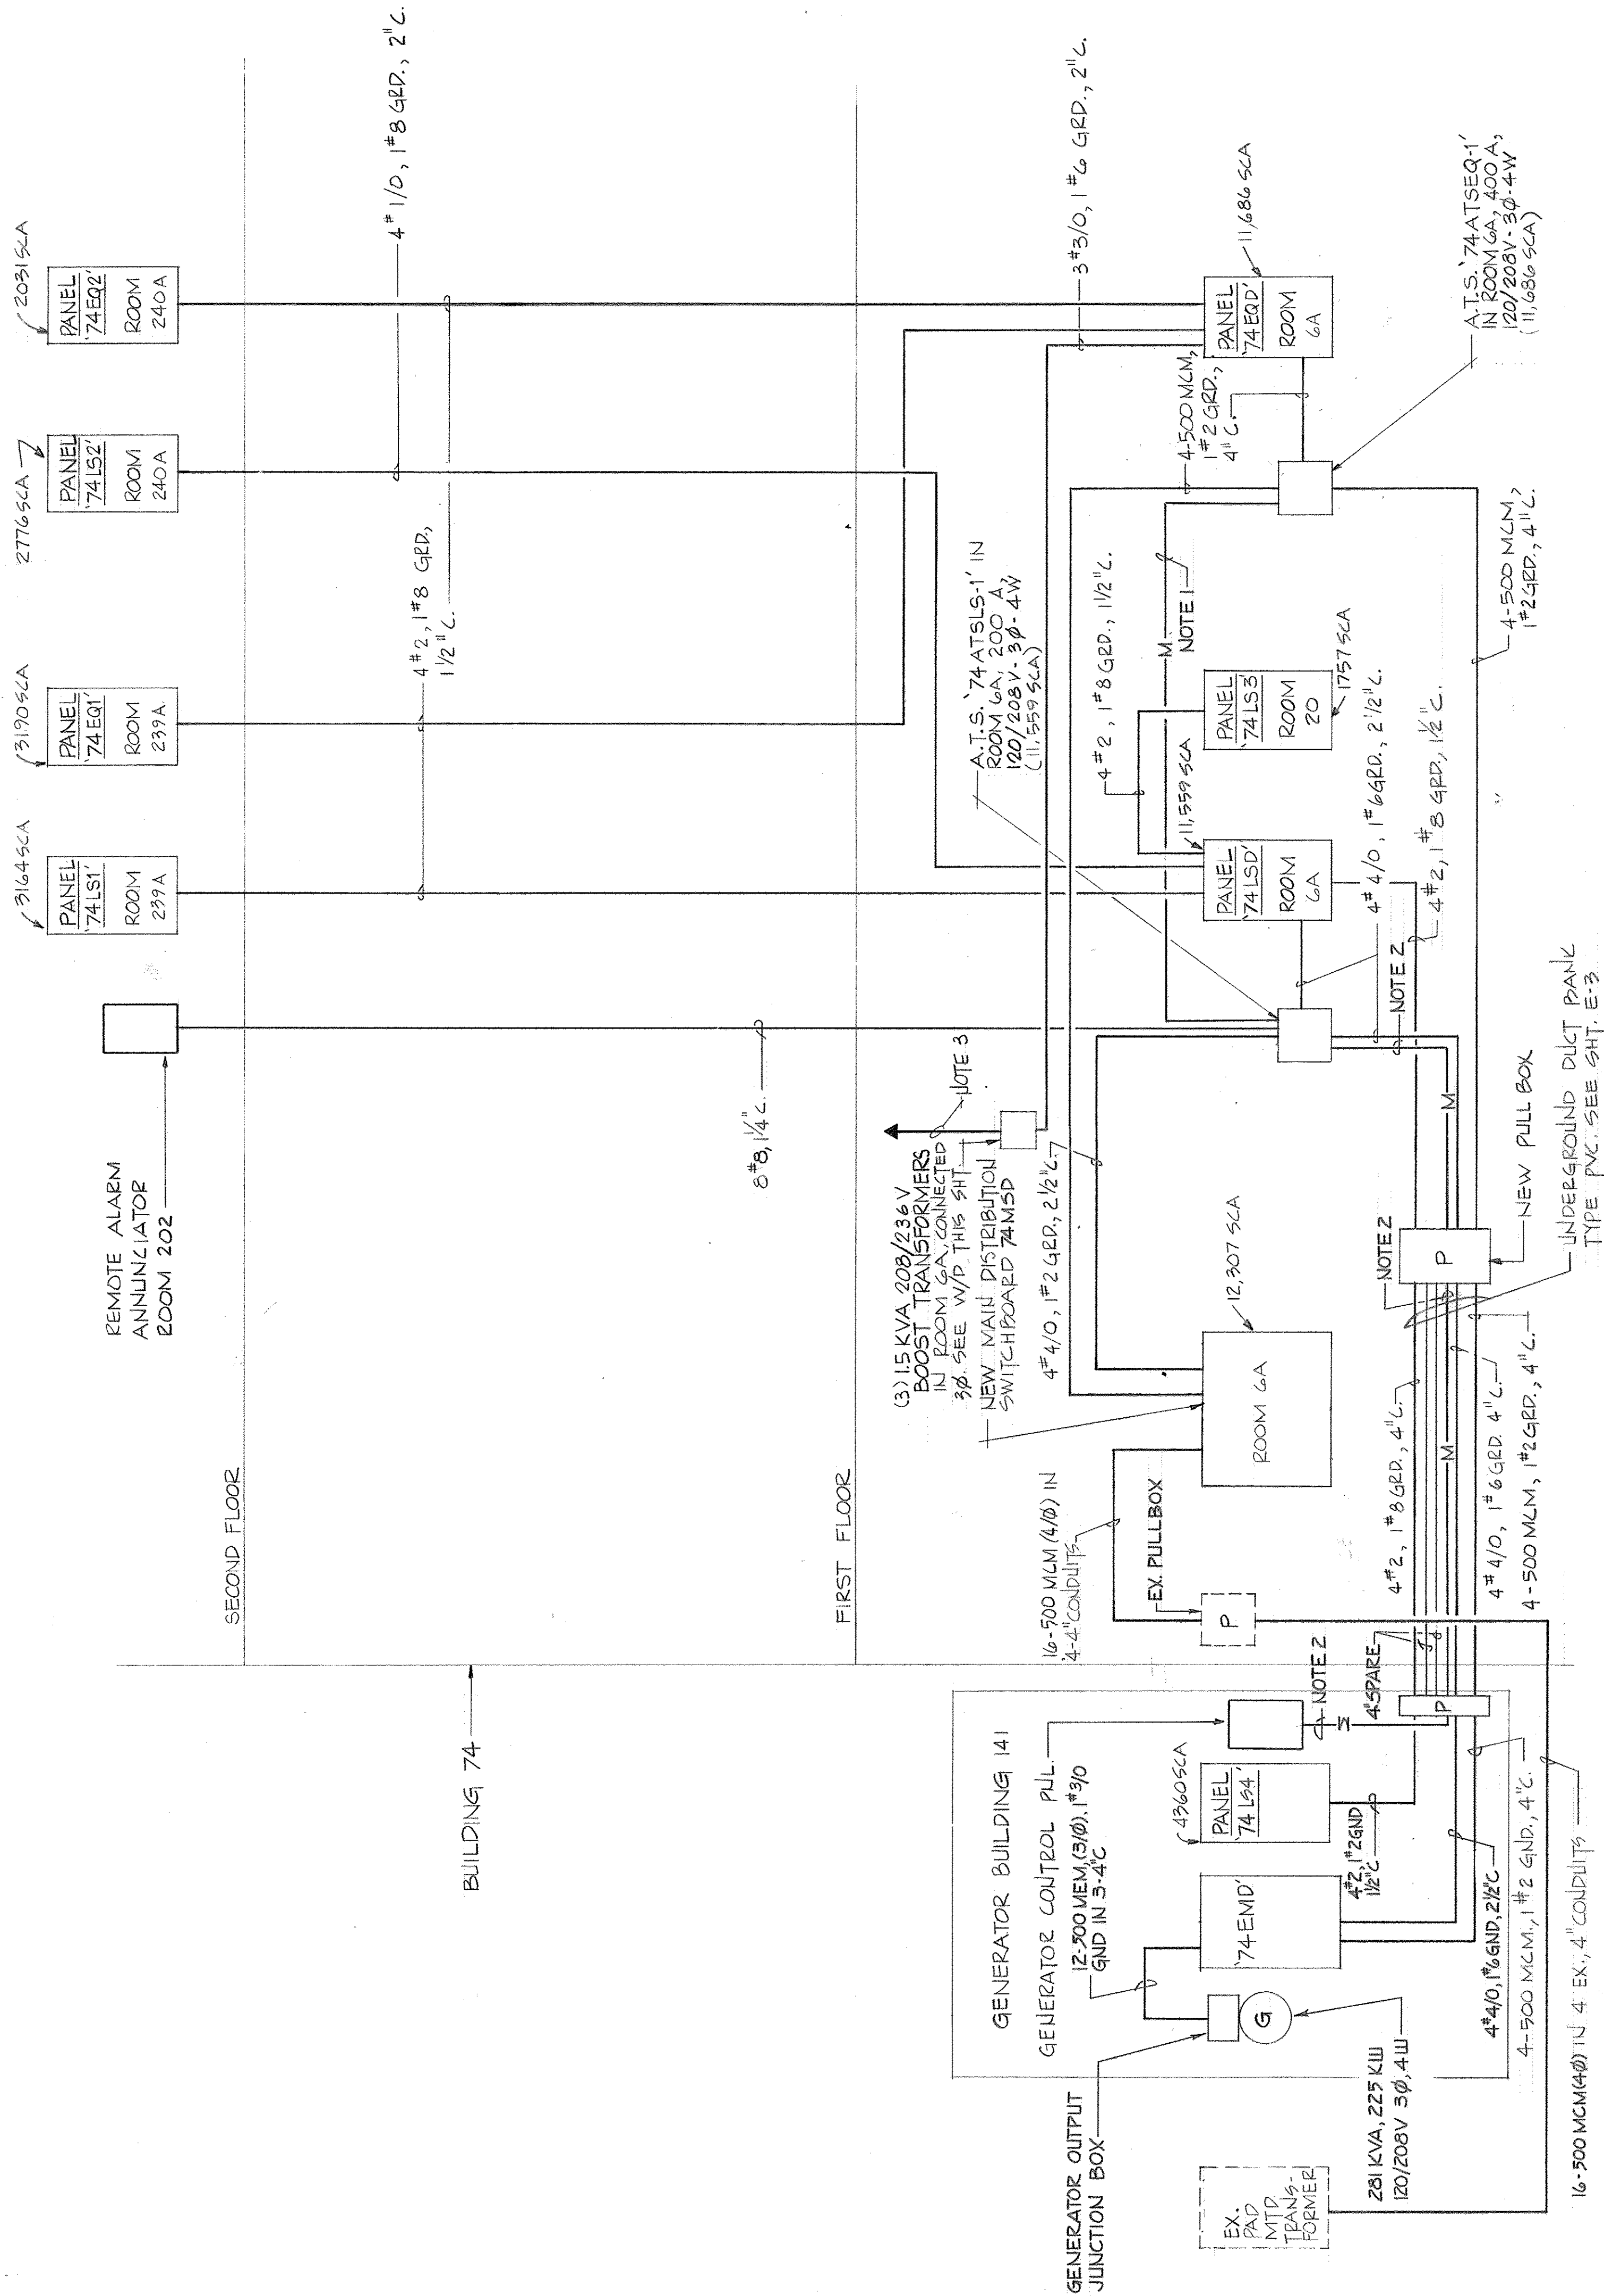

- NOTES:
- 1. WIRE, SIZE & QUANTITY AS RECOMMENDED BY MANUFACTURER, FROM ATS'S TO GENERATOR CONTROL PANEL, FOR ATS MONITORING AND CONTROL & ENGINE START CIRCUIT. CONDUIT SIZE AS REQUIRED
  - 2. 2.5" FROM GENERATOR CONTROL PANEL TO REMOTE ALARM ANNUNCIATOR & WIRE, SIZE & QUANTITY AS RECOMMENDED BY MANUFACTURER, FROM ATS'S TO GENERATOR CONTROL PANEL FOR ATS MONITORING & CONTROL & ENGINE START CIRCUIT. CONDUIT SIZE AS REQUIRED EXCEPT BETWEEN PULLBOXES WHICH SHALL BE 4" CONDUIT
  - 3. INTERCEPT EX. FEEDER FOR ELEVATOR FROM PANEL IN ROOM 6A & EXTEND & CONNECT TO PANEL 74EQD VIA TRANSFORMERS.

EMERGENCY SYSTEM POWER RISER

NO SCALE

SHEET TITLE EMERGENCY SYSTEM POWER RISER	
BUILD NO. 74	PROJECT TITLE EMERGENCY ELECTRICAL POWER SYSTEM
NO.	DATE
9-20-81	RECORD DRAWINGS
REVISIONS	
DESCRIPTION	
DATE	
DRAWN	
CHECKED	
DATE	
DRAWING NUMBER	
6-25-79	
DWG. OF	
74-EG	
PROJECT NUMBER	
658-049	
APPROVED PROJECT MANAGER	
TERRY R. YEAGER	
BARTON ASSOCIATES, INC.	
CONSULTING ENGINEERS	
415 NORMAN STREET	
NEW YORK, N.Y. 10036	
VETERANS ADMINISTRATION	
LOCATION	
VAH, SALEM, VA.	