


PENTHOUSE & PARTIAL ATTIC PLAN


SCALE: 1/8" = 1'-0"


NOTES:

1. CUT EX. CONCRETE BLOCK WALL AS REQUIRED TO INSTALL NEW CONDUIT - PATCH & PAINT TO MATCH EX. ADJACENT SURFACES AFTER INSTALLATION.
2. INSTALL 3/4" SPARE CONDUIT FROM PNL. 75EQ2 TO ELEVATOR PENTHOUSE.

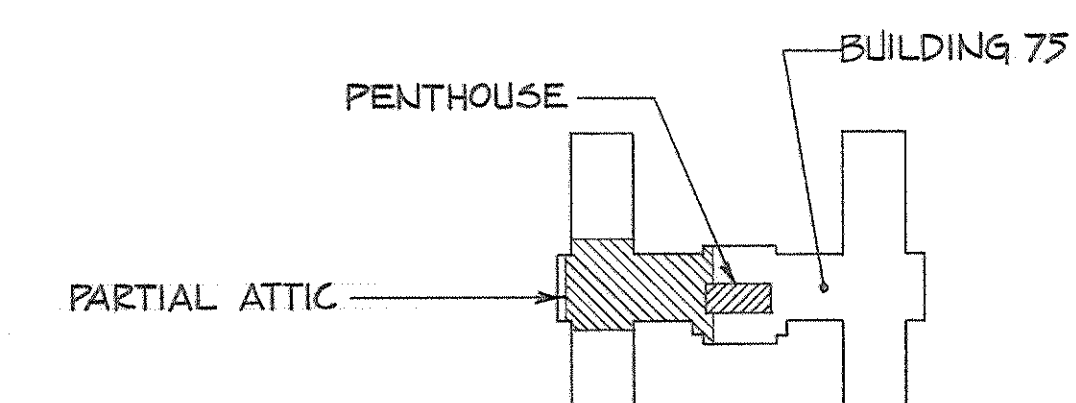

KEY PLAN NO SCALE

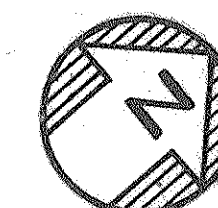

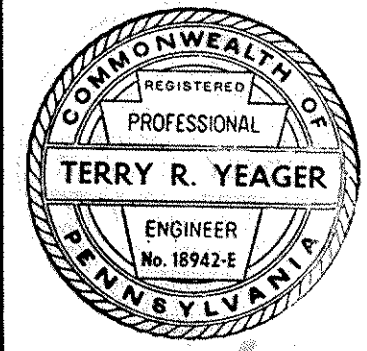RECORD DRAWINGS	
NO	DATE
DESCRIPTION	
REVISIONS:	
SHEET TITLE PENTHOUSE & PARTIAL ATTIC PLAN	
BLDG. NO. 75	PROJECT TITLE EMERGENCY ELECTRICAL POWER SYSTEM
DRAWN 7793	CHECKED DATE 6-25-79
	
BARTON ASSOCIATES, INC. CONSULTING ENGINEERS 415 NORWAY STREET YORK, PENNA. 17403	
APPROVED: PROJECT DIRECTOR	DWG. OF PROJECT NUMBER 75-E4 658-049
LOCATION VAH, SALEM, VA.	

