


three inches = one foot
one and one half inches = one foot
one inch = one foot
three quarters inch = one foot
one half inch = one foot
three eighths inch = one foot
one quarter inch = one foot
one eighth inch = one foot

KEYED NOTES

- 1 2" HOT WATER SUPPLY AND RETURN PIPES UP IN CHASE. INSTALL GOLD AND HOT WATER SUPPLY AND RETURN VALVES IN RISER.
- 2 4" CHILLED WATER SUPPLY AND RETURN PIPES UP IN CHASE. INSTALL GOLD AND HOT WATER SUPPLY AND RETURN VALVES IN RISER.
- 3 CHILLED WATER SUPPLY AND RETURN, HOT WATER SUPPLY AND RETURN PIPES UP IN CHASE. ROUTE ABOVE CEILING. PROVIDE 30X30 SERVICE ACCESS DOOR AT CHASE.
- 4 4" CHILLED WATER SUPPLY AND RETURN PIPES UNDER GROUND TO CHILLER PLANT. INSULATE PIPES AS PER SPECIFICATIONS.
- 5 2" HOT WATER SUPPLY AND RETURN PIPES UNDER GROUND TO BOILER PLANT. INSULATE PIPES AS PER SPECIFICATIONS.
- 6 4" CHILLED WATER SUPPLY AND RETURN PIPES DOWN THRU CONCRETE SLAB. MECHANICAL CONTRACTOR TO PROVIDE PIPE INSULATION FOR ALL THE PIPES INSIDE THE CHILLER PLANT.
- 7 2" HOT WATER SUPPLY AND RETURN PIPES DOWN THRU CONCRETE SLAB. MECHANICAL CONTRACTOR TO PROVIDE PIPE INSULATION FOR ALL THE PIPES INSIDE THE BOILER PLANT.
- 8 30"x30" ACCESS DOOR FOR CHILLED WATER, HOT WATER SUPPLY AND RETURN SHUT OFF VALVES.

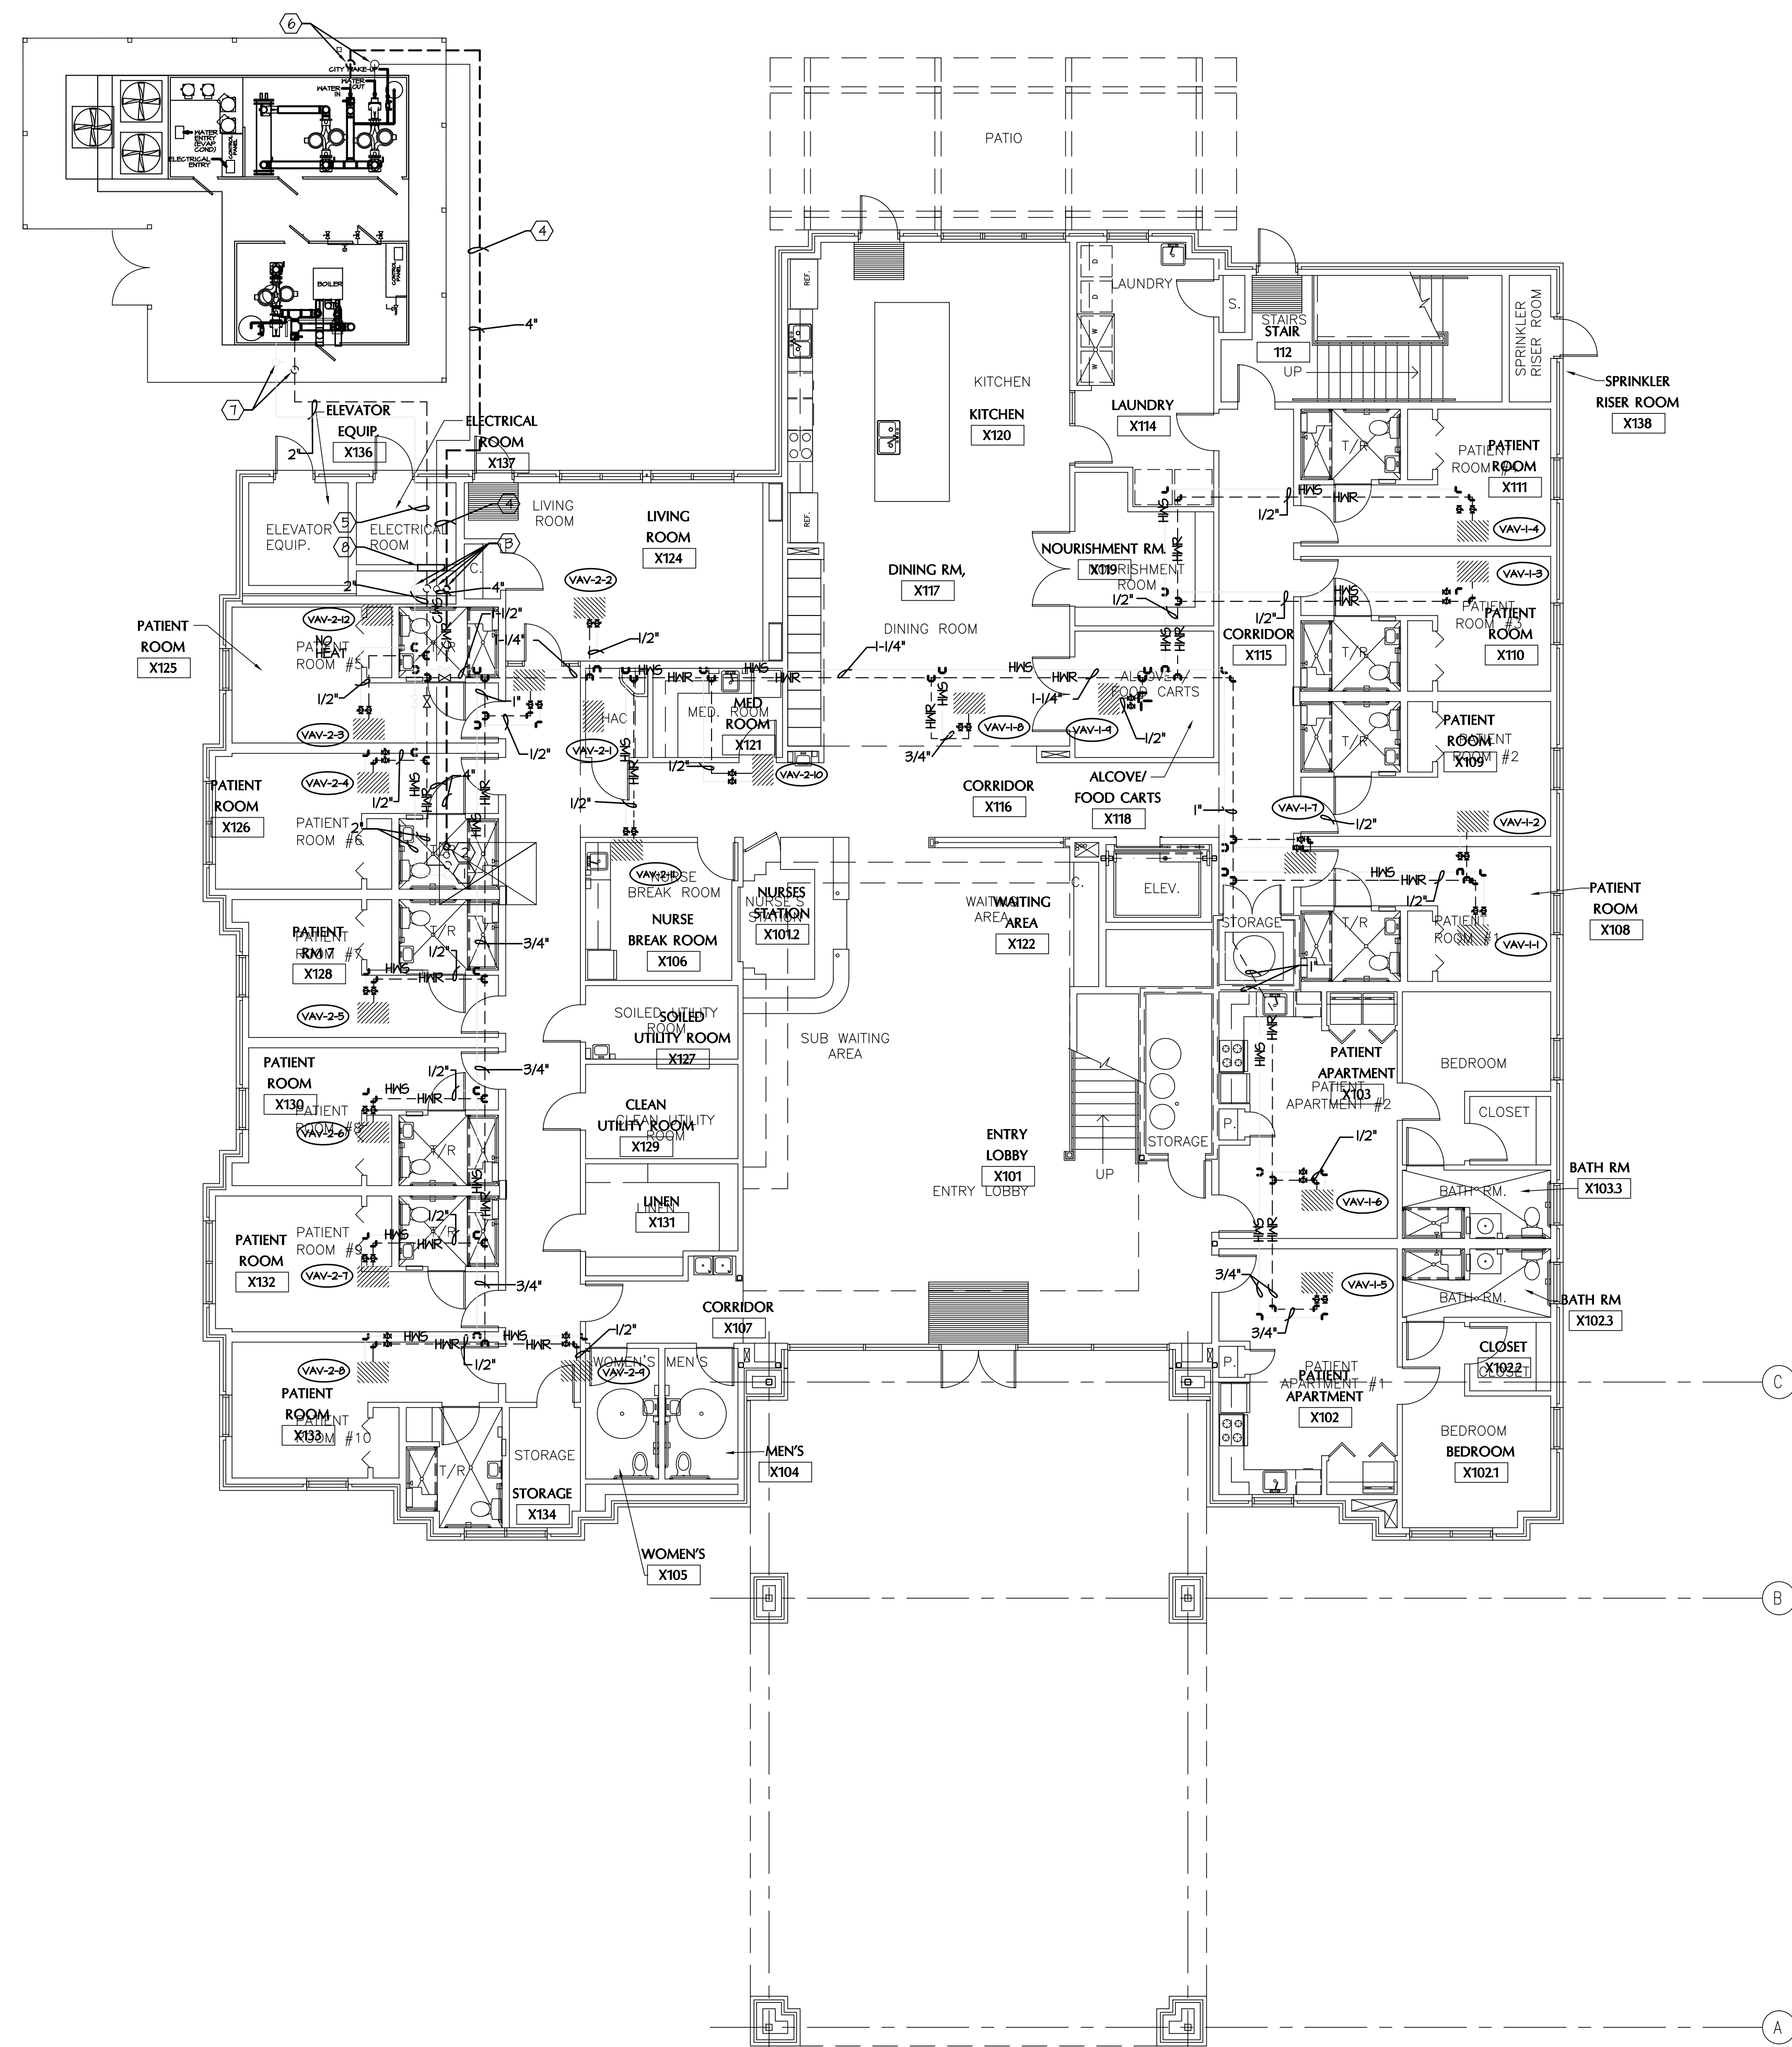

1 FIRST FLOOR MECHANICAL PLAN - CHILLED WATER & HOT WATER PIPING
SCALE: 1/8" = 1'-0"

RECORD DRAWINGS
DATE: NOVEMBER 16, 2012
THESE AS-BUILT DOCUMENTS HAVE BEEN PREPARED BASED ON INFORMATION PROVIDED BY THE CONTRACTOR LOKUS GENERAL CONTRACTORS, LTD. THE ARCHITECT/ENGINEER HAS NOT VERIFIED THE ACCURACY AND/OR COMPLETENESS OF THIS INFORMATION AND SHALL NOT BE RESPONSIBLE FOR ANY ERRORS OR OMISSIONS THAT MAY BE INCORPORATED AS RESULT OF INCORRECT INFORMATION PROVIDED BY THE CONTRACTOR.

--	--	