


Building 20
BP020-TY-11-101

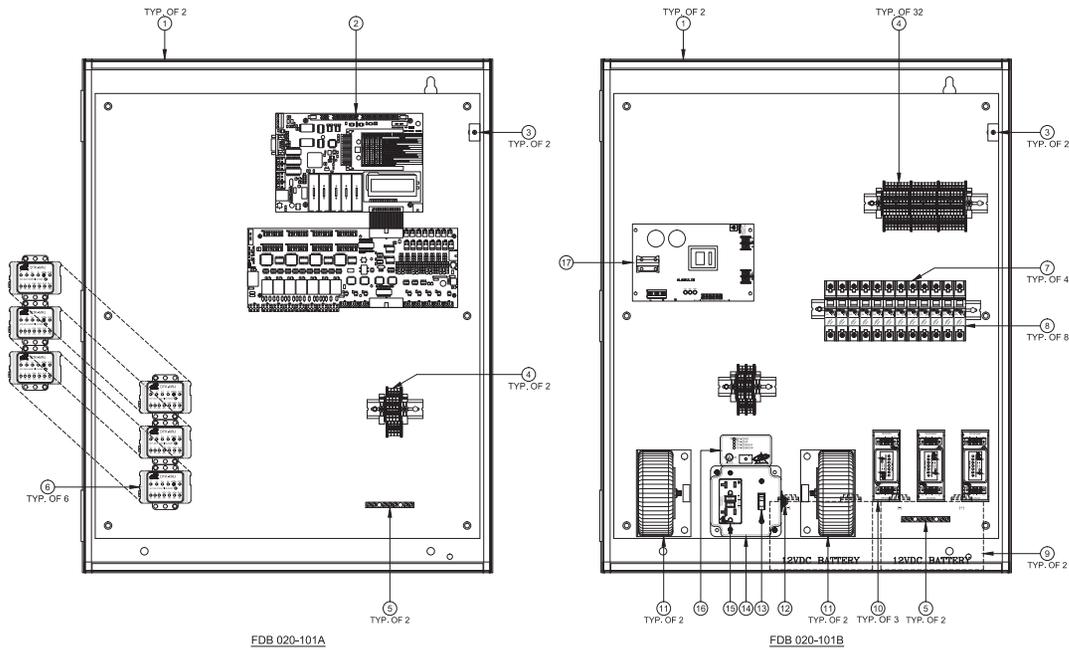

FDB 020-101A & 020-101B / LOCATED IN ROOM 100A

#	MANUFACTURER	COMPONENT	PART/MODEL/STOCK NO.	QTY
1	HOFFMAN	ENCLOSURE WITH BACKPLANE	A30N24DLP	2
2	SOFTWARE HOUSE	iSTAR PRO 8 DOOR INTELLIGENT CONTROLLER	STAR008W-64A	1
3	SENTROL	TAMPER SWITCH	3025T	2
4	PHOENIX CONTACT	FEED THROUGH MODULAR TERMINAL BLOCK	ATP-UTTB 2,5/4	32
5	SQUARE D	GROUNDING BUS BAR	PK7GTA	2
6	DITEK	SURGE PROTECTOR	DTK-MRJ45C5E	6
7	ABL SURSUM	5 AMP CIRCUIT BREAKER	1G5UM	4
8	ABL SURSUM	1 AMP CIRCUIT BREAKER	1G1UM	8
9	INTERSTATE BATTERY	12VDC 12AH BATTERY BACKUP	SLA1105	2
10	DITEK	SURGE PROTECTOR	DTK-2MHLP24-BWB	3
11	ALTRONIX	24/28 VAC TRANSFORMER - 300 VA	T2428300	2
12	TYCO ELECTRONICS	5 AMP CIRCUIT BREAKER	W57-XB7A4A10-5	1
13	LEVITON	SWITCH	1451-2W	1
14	CROUSE-HINDS	STEEL OUTLET BOX	TP403	1
15	LEVITON	GFCI RECEPTACLE	76367-08	1
16	DITEK	SURGE PROTECTOR	DTK-120HW	1
17	ALTRONIX	12VDC POWER SUPPLY	AL600ULXB	1

NOTE: REFER TO PAGE BP999-TY-50-123 FOR FIRE PANEL TIE-IN INFORMATION



UNIFIED CONSULTANTS GROUP, INC.
111 HIGHLAND DRIVE
FAYETTEVILLE, GA 30214
PHONE: 770-692-1971
FAX: 678-817-9028

CLIENTELE



U.S. DEPARTMENT OF VETERANS AFFAIRS
4300 DUHME ROAD, SUITE 300
MADIGRA BEACH, FL 33708

PROJECT IDENTIFICATION

BAY PINES VA HEALTHCARE FACILITY
ELECTRONIC & PHYSICAL SECURITY UPGRADE

AS-BUILT SET

REV E 11-15-2013 AS-BUILT

MARK DATE DESCRIPTION

CONTRACT NUMBER VA248-12-F-0157

CAD DWG FILE BP020-TY-53-101

DESIGNED BY: B. YOUNG

DRAWN BY: I. MACFARLANE/S.LEVITT

CHECKED BY: B. YOUNG

REVIEWED BY: M. LAUDE

DATE: JANUARY 9, 2013

FOR OFFICIAL USE ONLY

SHEET TITLE

FDB 020-101A & 020-101B

CONSTRUCTION

BP020-TY-53-101

SECTION - FIELD DISTRIBUTION BOXES

SHEET 7 OF 8



**UNIFIED CONSULTANTS
GROUP, INC.**
111 HIGHLAND DRIVE
FAYETTEVILLE, GA 30214
PHONE: 770-822-1971
FAX: 678-817-9028

CLIENTELE



**U.S. DEPARTMENT OF
VETERANS AFFAIRS**
4300 DUHAME ROAD, SUITE 300
MADRIDA BEACH, FL 33708

PROJECT IDENTIFICATION

**BAY PINES VA
HEALTHCARE
FACILITY
ELECTRONIC & PHYSICAL
SECURITY UPGRADE**

AS-BUILT SET

REV E 11-15-2013 AS-BUILT

MARK	DATE	DESCRIPTION

CONTRACT NUMBER	VA248-12-F-0157
CAD DWG FILE	BP020-TY-53-101
DESIGNED BY:	B. YOUNG
DRAWN BY:	I. MACFARLANE/S.LEVITT
CHECKED BY:	B. YOUNG
REVIEWED BY:	M. LAUDE
DATE:	JANUARY 9, 2013

FOR OFFICIAL USE ONLY

SHEET TITLE

**FDB 020-101A &
020-101B
WIRING DIAGRAM**

CONTRACT NUMBER VA248-12-F-0157

CAD DWG FILE BP020-TY-53-101

DESIGNED BY: B. YOUNG

DRAWN BY: I. MACFARLANE/S.LEVITT

CHECKED BY: B. YOUNG

REVIEWED BY: M. LAUDE

DATE: JANUARY 9, 2013

FOR OFFICIAL USE ONLY

SHEET TITLE

**FDB 020-101A &
020-101B
WIRING DIAGRAM**

CONTRACT NUMBER VA248-12-F-0157

CAD DWG FILE BP020-TY-53-101

DESIGNED BY: B. YOUNG


DRAWN BY: I. MACFARLANE/S.LEVITT

CHECKED BY: B. YOUNG

REVIEWED BY: M. LAUDE

DATE: JANUARY 9, 2013

FOR OFFICIAL USE ONLY

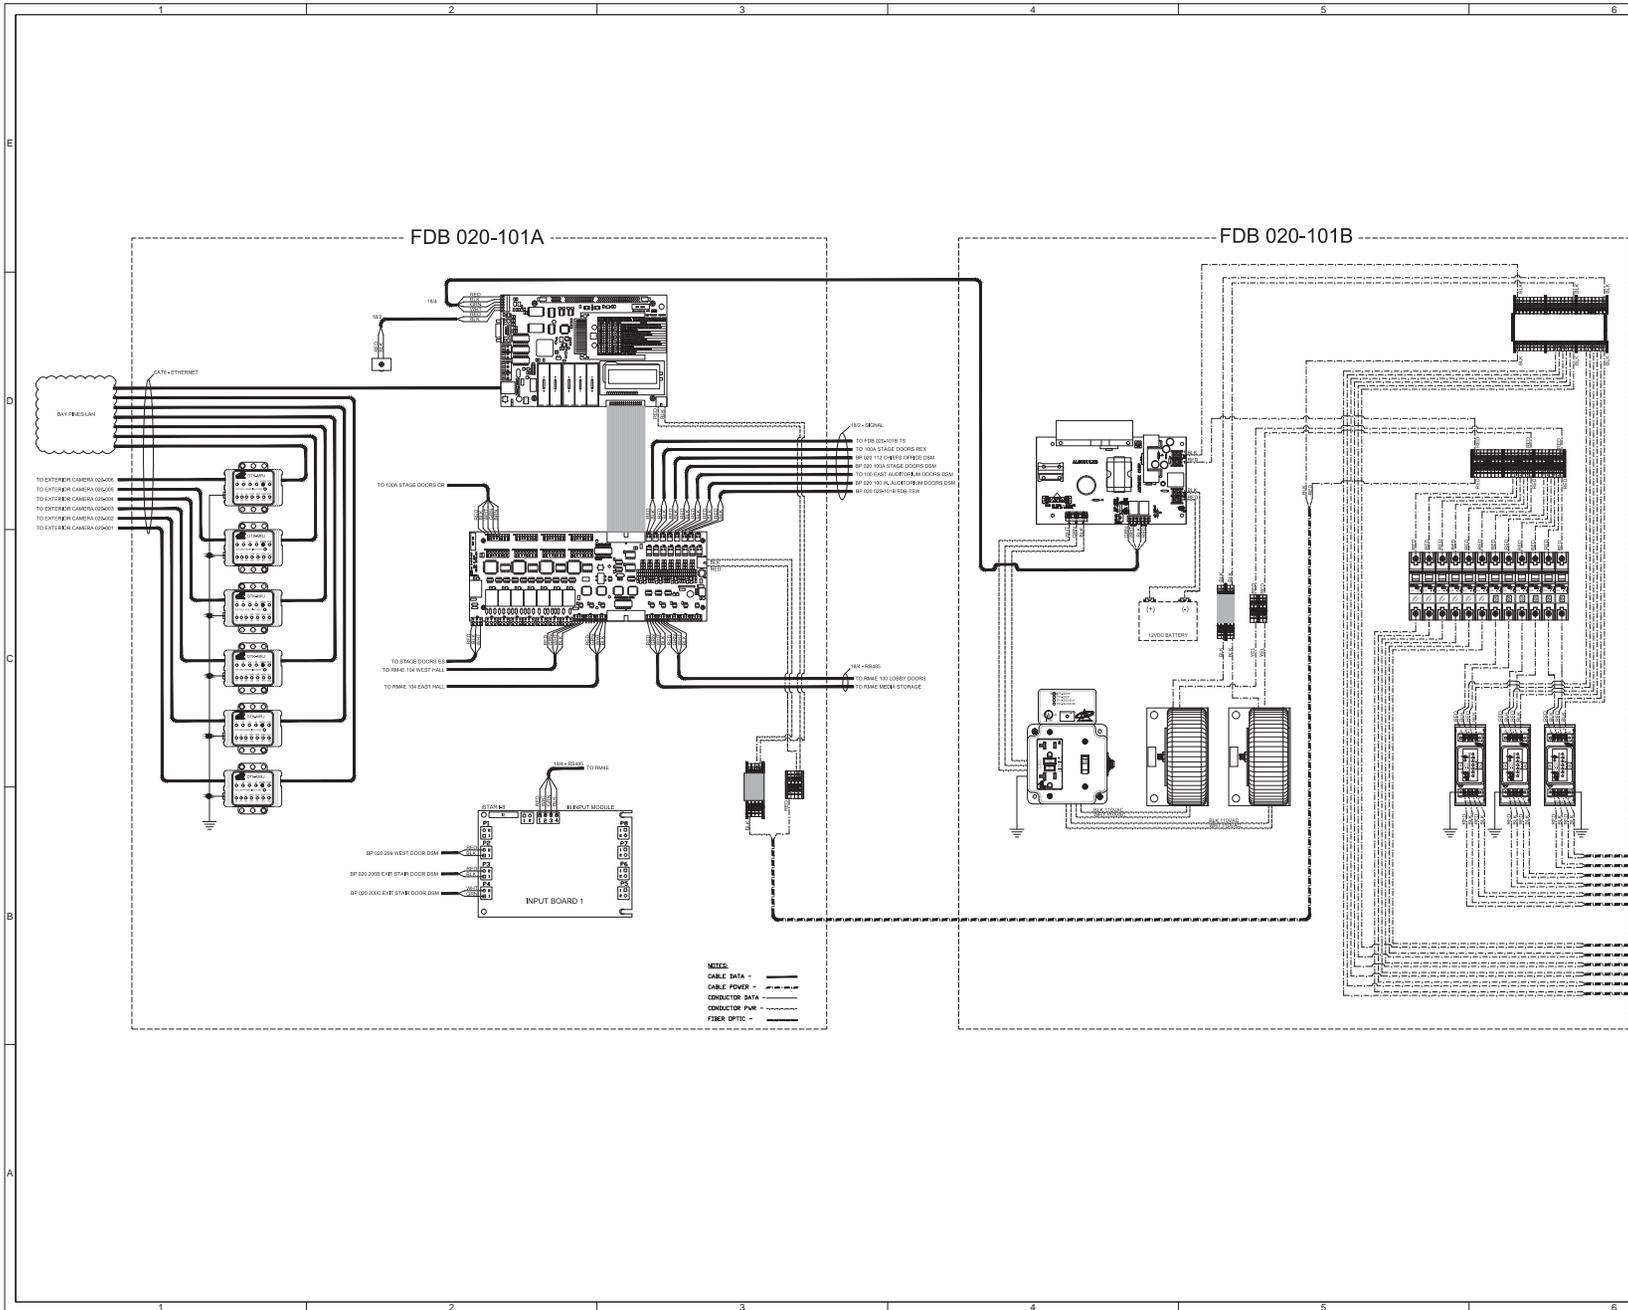

BP020-TY-54-101
SECTION - FIELD DISTRIBUTION BOXES
SHEET 8 OF 8