



UNIFIED CONSULTANTS
GROUP, INC.
11 HIGHLAND DRIVE
FARMINGTON, CT 06031
PHONE: 770-923-1971
FAX: 693-817-9228



U.S. DEPARTMENT OF
VETERANS AFFAIRS
4300 DUANE ROAD, SUITE 300
INDUSTRIAL PARK, FL 32108

PROJECT IDENTIFICATION

BAY PINES VA
HEALTHCARE
FACILITY
ELECTRONIC & PHYSICAL
SECURITY UPGRADE

AS-BUILT SET

KEY E 11-19-2013 AS-BUILT

MARK DATE DESCRIPTION

CONTRACT NUMBER VZ49-12F-0157
CAD DRAWING FILE BP100-TY-11-101
DRAWN BY L. MACFARLANE & J. LEVITT
CHECKED BY B. YOUNG
REVIEWED BY M. LAUDE
DATE MARCH 19, 2013

FOR OFFICIAL USE ONLY

SHEET TITLE

BUILDING 100
1ST FLOOR
WIRE RUNS



BP100-TY-11-101
SECTION - ELECTRICAL & CABLEING
SHEET 11 OF 69

OUTPATIENT

SERVICE BAY 10

MAGNETS


SERVICE BAY 9

EMERGENCY

SERVICE BAY 8

PSYCH

ED

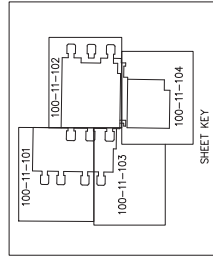

SHEET KEY



UNIFIED CONSULTANTS
GROUP, INC.
111 HIGHLAND DRIVE
FARMINGTON, CT 06030
PHONE: 775-692-5871
FAX: 678-817-8028



U.S. DEPARTMENT OF
VETERANS AFFAIRS
4000 DUNN ROAD, SUITE 300
NACCAVA, SOUTH CAROLINA 29578

PROJECT IDENTIFICATION

BAY PINES VA
HEALTHCARE
FACILITY
ELECTRONIC & PHYSICAL
SECURITY UPGRADE

AS-BUILT SET

REV E 11-13-2013 AS-BUILT


MARK DATE DESCRIPTION

CONTRACT NUMBER: VAS4012F-0557
CADD FILE: BP100-TY-11-103
DESIGNED BY: I. MACFARLANE/LEVITT
DRAWN BY: B. YOUNG
CHECKED BY: M. LAUDE
REVIEWED BY: M. LAUDE
DATE: MARCH 13, 2013


FOR OFFICIAL USE ONLY

SHEET TITLE

BUILDING 100
1ST FLOOR
WIRE RUNS

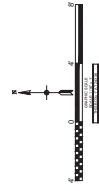

BP100-TY-11-103
SECTION - ELECTRICAL & CABLING
SHEET 13 OF 68

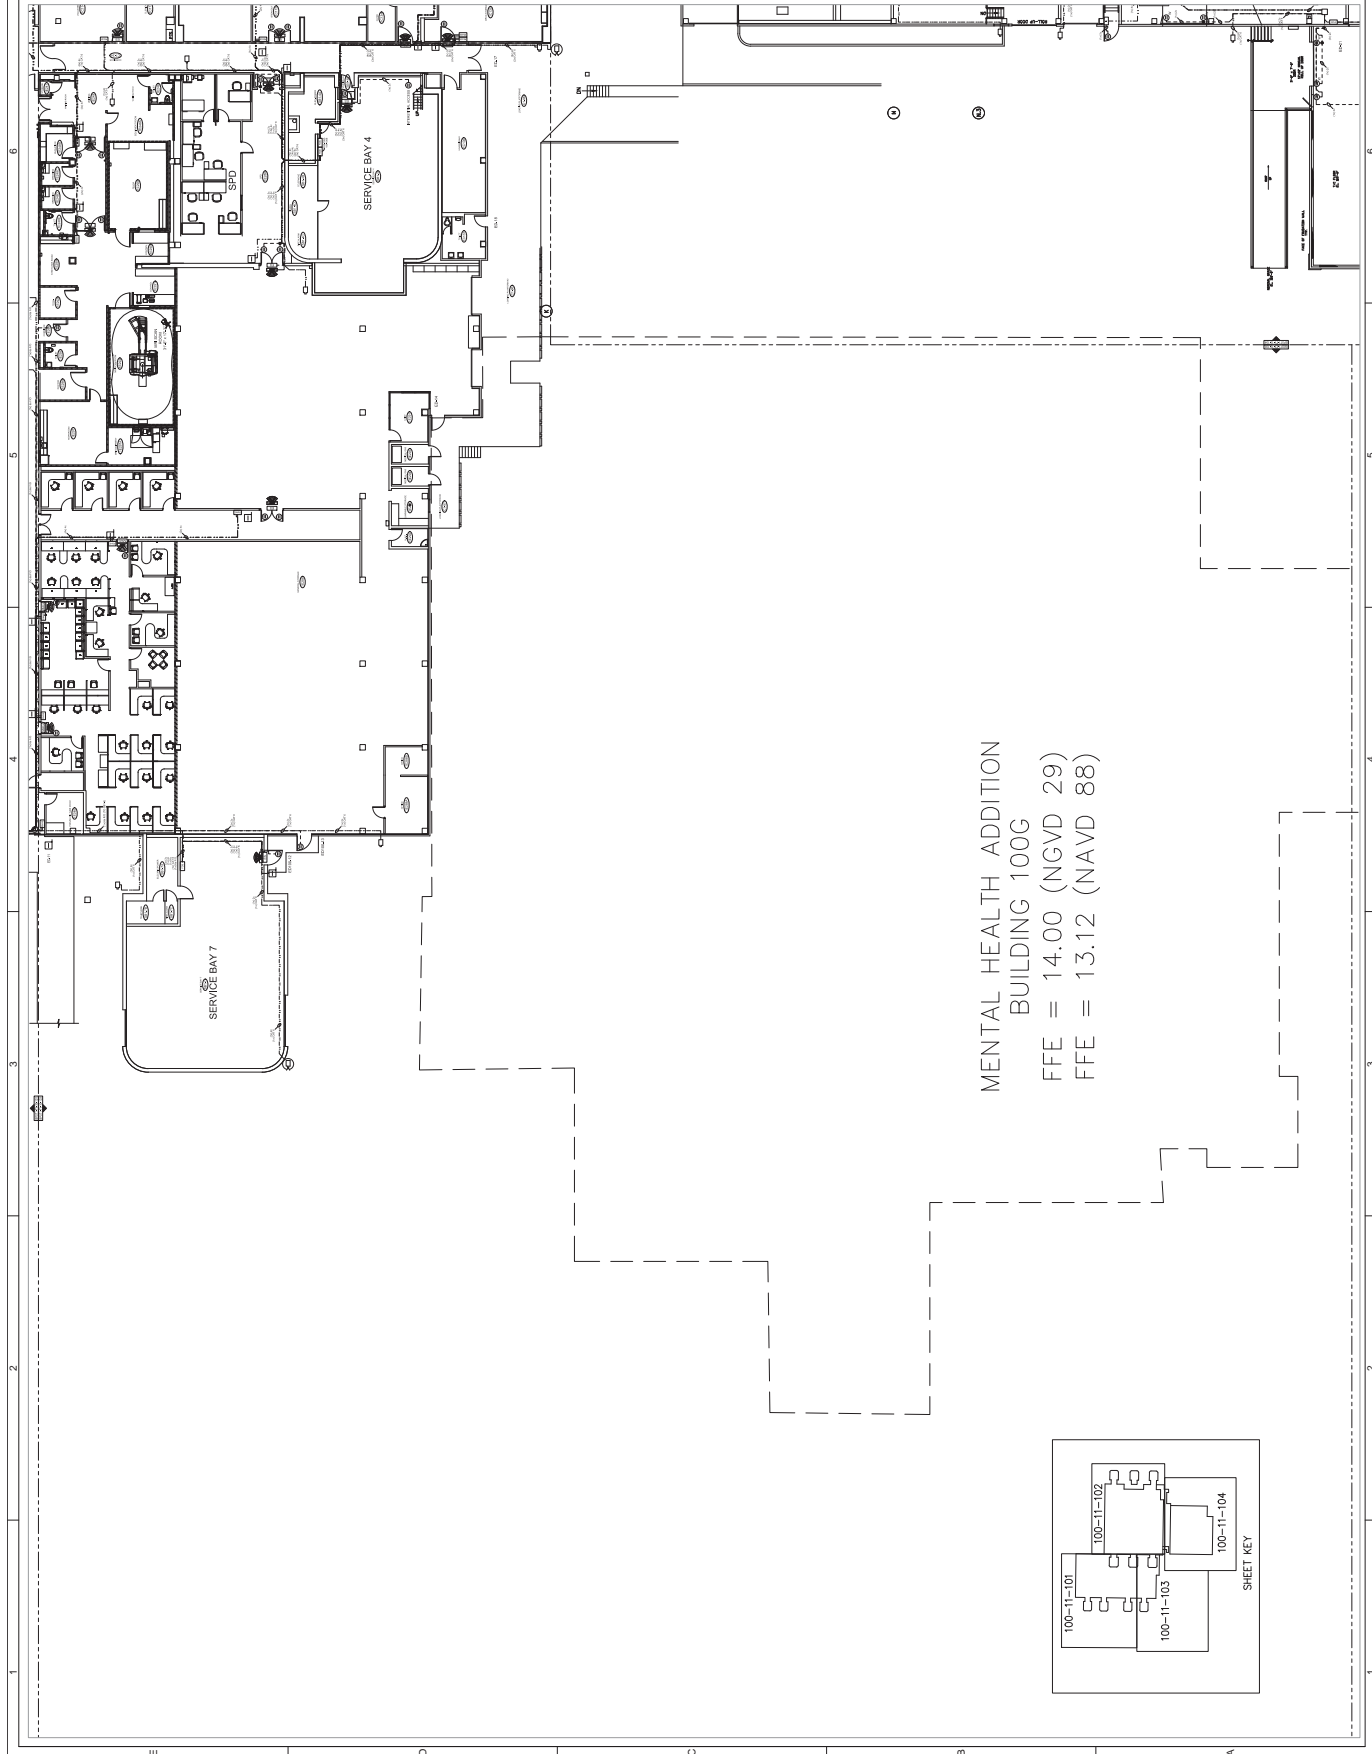

MENTAL HEALTH ADDITION
BUILDING 100G
FFE = 14.00 (NGVD 29)
FFE = 13.12 (NAVD 88)

