

**KEY PLAN**  
 NOTE: DEVICE SCHEDULES LOCATED ON PAGE BP101-TY-05-101



**UNIFIED CONSULTANTS GROUP, INC.**  
 111 HIGHLAND DRIVE  
 FAYETTEVILLE, GA 30214  
 PHONE: 770-892-1971  
 FAX: 678-817-9028

CLIENTE



**U.S. DEPARTMENT OF VETERANS AFFAIRS**  
 4300 DUHAME ROAD, SUITE 300  
 MADRIRA BEACH, FL 33708

PROJECT IDENTIFICATION

**BAY PINES VA HEALTHCARE FACILITY**  
**ELECTRONIC & PHYSICAL SECURITY UPGRADE**


AS-BUILT SET

REV	DATE	DESCRIPTION
E	11-15-2013	AS-BUILT

CONTRACT NUMBER	VA248-12-F-0157
CAD DWG FILE	BP102-TY-11-103
DESIGNED BY:	B. YOUNG
DRAWN BY:	I. MACFARLANE/S.LEVITT
CHECKED BY:	B. YOUNG
REVIEWED BY:	M. LAUDE
DATE:	MARCH 19, 2013



FOR OFFICIAL USE ONLY

SHEET TITLE  
**BUILDING 102**  
**BEDROOM UNIT "C"**  
**WIRE RUNS**

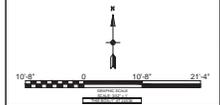

**BP102-TY-11-103**  
 SECTION - ELECTRICAL & CABLING  
 SHEET 10 OF 25

# BEDROOM UNIT "D"

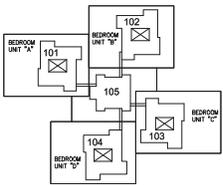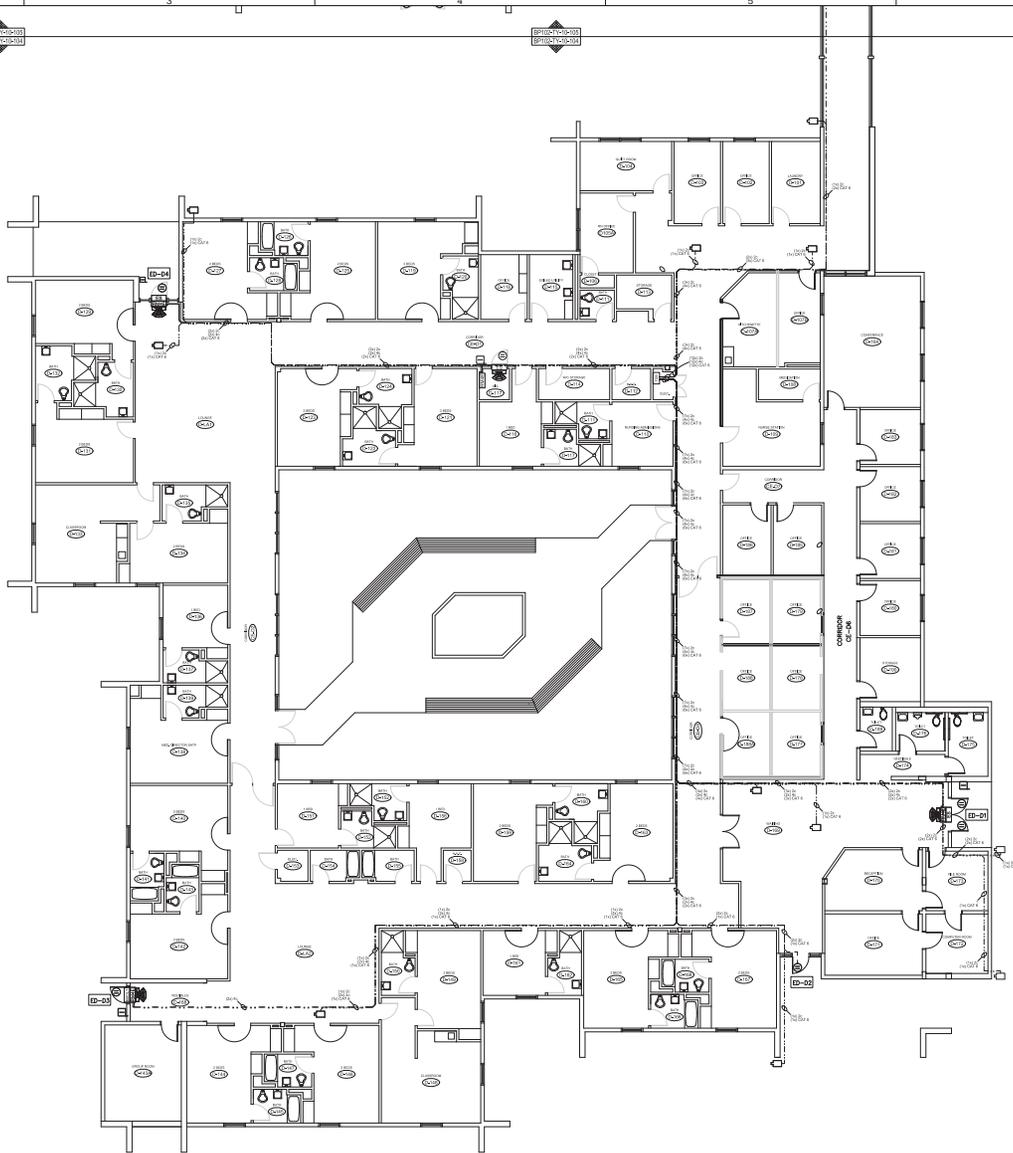

KEY PLAN

NOTE: DEVICE SCHEDULES LOCATED ON PAGES BP101-TY-05-101



**UNIFIED CONSULTANTS GROUP, INC.**  
 111 HIGHLAND DRIVE  
 FAYETTEVILLE, GA 30214  
 PHONE: 770-892-1971  
 FAX: 678-817-9028

CLIENTELE



**U.S. DEPARTMENT OF VETERANS AFFAIRS**  
 4300 DUHAME ROAD, SUITE 300  
 MADRIDA BEACH, FL 33708

PROJECT IDENTIFICATION

**BAY PINES VA HEALTHCARE FACILITY**  
**ELECTRONIC & PHYSICAL SECURITY UPGRADE**

AS-BUILT SET

REV E	11-15-2013	AS-BUILT


MARK	DATE	DESCRIPTION

CONTRACT NUMBER	VA248-12-F-0157
CAD DWG FILE	BP102-TY-11-104
DESIGNED BY:	B. YOUNG
DRAWN BY:	I. MACFARLANE/S.LEVITT
CHECKED BY:	B. YOUNG
REVIEWED BY:	M. LAUDE
DATE:	MARCH 19, 2013


FOR OFFICIAL USE ONLY

SHEET TITLE

**BUILDING 102**  
**BEDROOM UNIT "D"**  
**WIRE RUNS**

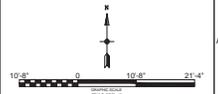


**BP102-TY-11-104**  
 SECTION - ELECTRICAL & CABLING  
 SHEET 11 OF 25

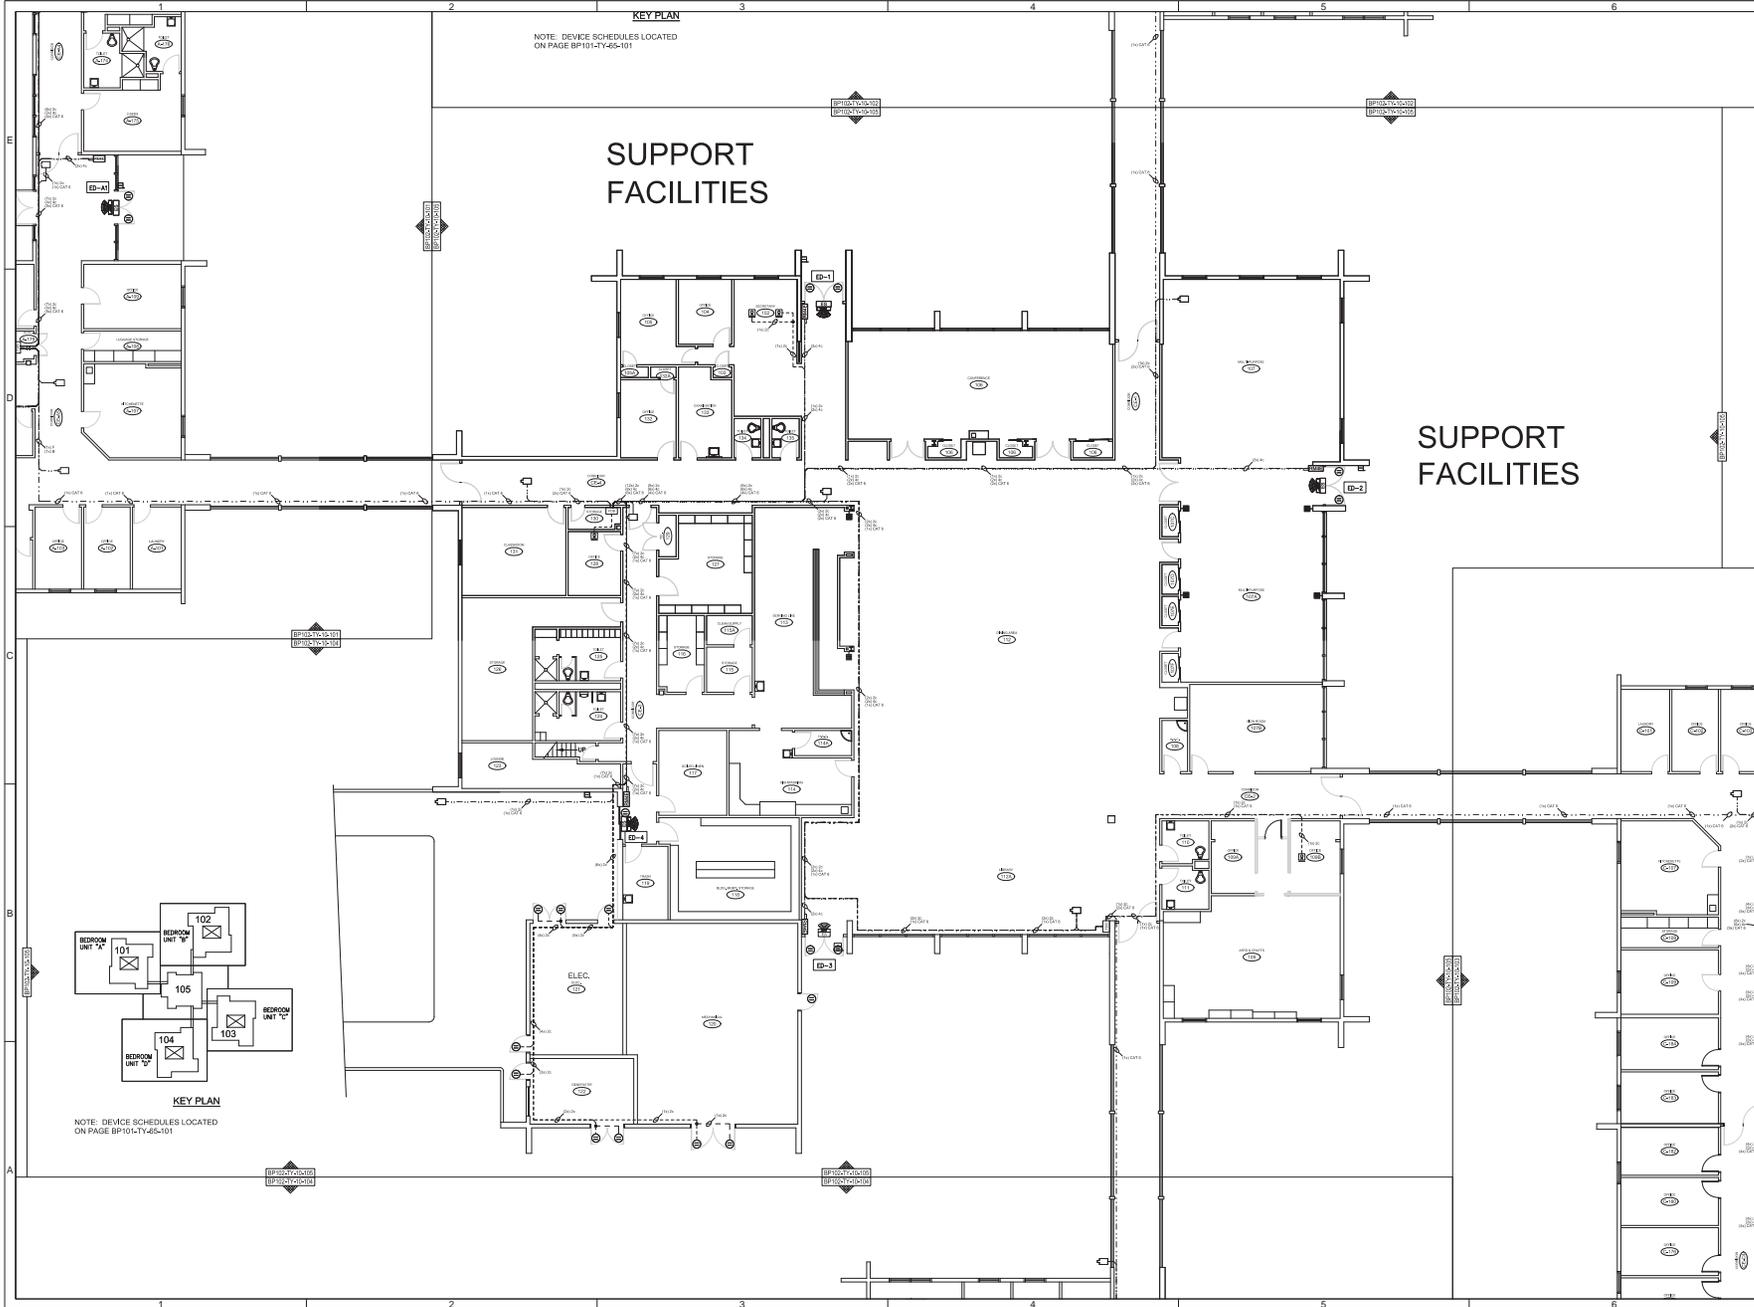

KEY PLAN  
NOTE: DEVICE SCHEDULES LOCATED ON PAGE BP101-TY-465-101

SUPPORT FACILITIES

SUPPORT FACILITIES

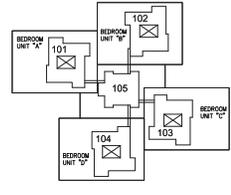

UNIFIED CONSULTANTS GROUP, INC.  
111 HIGHLAND DRIVE  
FAYETTEVILLE, GA 30214  
PHONE: 770-822-1971  
FAX: 678-817-9028



U.S. DEPARTMENT OF VETERANS AFFAIRS  
4300 DUHAME ROAD, SUITE 300  
MADIRA BEACH, FL 33708

PROJECT IDENTIFICATION  
**BAY PINES VA HEALTHCARE FACILITY**  
ELECTRONIC & PHYSICAL SECURITY UPGRADE

AS-BUILT SET


REV	DATE	DESCRIPTION
REV E	11-15-2013	AS-BUILT

MARK DATE DESCRIPTION

CONTRACT NUMBER VA248-12-F-0157  
 CAD DWG FILE BP102-TY-11-105  
 DESIGNED BY: B. YOUNG  
 DRAWN BY: I. MACFARLANE/S.LEVITT  
 CHECKED BY: B. YOUNG  
 REVIEWED BY: M. LAUDE  
 DATE: MARCH 19, 2013

FOR OFFICIAL USE ONLY

SHEET TITLE  
**BUILDING 102 SUPPORT FACILITIES WIRE RUNS**

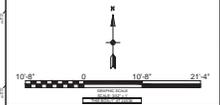

**BP102-TY-11-105**  
SECTION - ELECTRICAL & CABLING  
SHEET 12 OF 25