

RFI 88

DUCT WORK MODIFICATIONS

RTU NOTES:

09/14/2011

1. RELOCATE RTU-2 TOWARDS EAST ENOUGH TO CLEAR STRUCTURAL BEAM. ENSURE THAT SUPPLY FLENUM AND WRAP INSULATION CLEAR BEAM. MECHANICAL CONTRACTOR TO COORDINATE FIELD PRIOR TO ROUGH-IN.

KEYED NOTES

09/14/2011

09/14/2011

09/14/2011

- 1 30 X 30 SUPPLY AND RETURN AIR DUCTS UP TO ROOFTOP CONNECTION. PROVIDE TRANSITIONS AND FLEXIBLE CONNECTIONS AT UNIT.
- 2 22 X 34 SUPPLY AIR AND 32 X 34 RETURN AIR DUCTS UP TO ROOFTOP CONNECTION. PROVIDE TRANSITIONS AND FLEXIBLE CONNECTIONS AT UNIT.
- 3 36 X 12 SUPPLY AIR DUCT DOWN IN CHASE.
- 4 44 X 14 RETURN AIR DUCT DOWN IN CHASE.
- 5 14 X 14 EXHAUST DUCT DOWN IN CHASE.
- 6 18 X 12 EXHAUST DUCT UP TO FAN CONNECTION. PROVIDE TRANSITION AND FLEXIBLE CONNECTION AT FAN.
- 7 12 X 14 EXHAUST DUCT UP TO FAN CONNECTION. PROVIDE TRANSITION AND FLEXIBLE CONNECTION AT FAN.
- 8 14 X 12 SUPPLY AIR DUCT DOWN IN CHASE.
- 9 26 X 14 SUPPLY AIR DUCT DOWN IN CHASE.
- 10 32 X 18 RETURN AIR DUCT DOWN IN CHASE.
- 11 LOCATED CONDENSATE DRAIN LINE (FROM ROOF) DOWN IN WALL TO MOP SINK. END OF PIPE TO BE PROVIDED WITH 90° ELBOW (FACING DOWNWARDS). TERMINATE 6" ABOVE MOP SINK.
- 12 30"x30" CEILING ACCESS FOR EQUIPMENT SERVICE.
- 13 12 X 12 EXHAUST DUCT DOWN IN CHASE.
- 14 ROUTE SUPPLY DUCTWORK UP THRU TRUSS SYSTEM THEN BACK DOWN TO VAV 4-1.

- 7 FIRE DAMPERS TO BE RELOCATED AT FLOOR PENETRATIONS
- 8 HEAT TRACE NOT REQUIRED FOR CHILLED WATER PIPING. PIPE WILL BE INSULATED AND INSTALLED WITH METAL JACKET.
- 9 X210 CEILING FIRE DAMPER LOCATE TO EXHAUST DUCT PENETRATING WALL BETWEEN ROOM X210 & X204.


09/14/2011

KEEP TOP OF DUCT AS HIGH AS POSSIBLE THRU TRANSITION

2

DUCT TRANSITION DETAIL

NOT TO SCALE

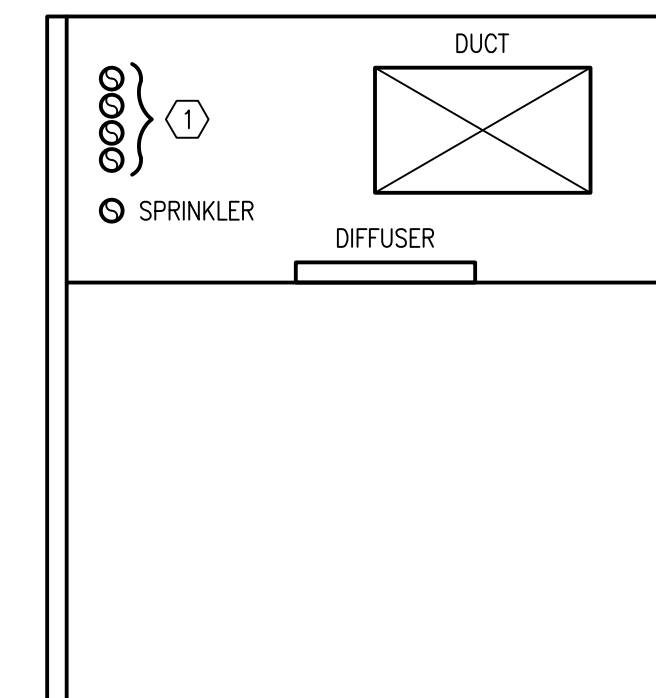

KEYED NOTES

- 1 STACK CHS/CHR & HVE/HWR VERTICALLY WHEN POSSIBLE OR RUN PIPE WITHIN TRUSS SYSTEM.

3



ELEVATION REFERENCE DETAIL

NOT TO SCALE

RECORD DRAWINGS

DATE: NOVEMBER 18, 2012

THESE AS-BUILT DOCUMENTS HAVE BEEN PREPARED BASED ON INFORMATION PROVIDED BY THE CONTRACTOR JORDAN GENERAL CONTRACTORS, LTD. THE ARCHITECT/ENGINEER HAS NOT VERIFIED THE ACCURACY AND/OR COMPLETENESS OF THIS INFORMATION AND SHALL NOT BE RESPONSIBLE FOR ANY ERRORS OR OMISSIONS THAT MAY BE INCORPORATED AS RESULT OF INCORRECT INFORMATION PROVIDED BY THE CONTRACTOR.

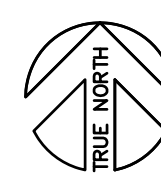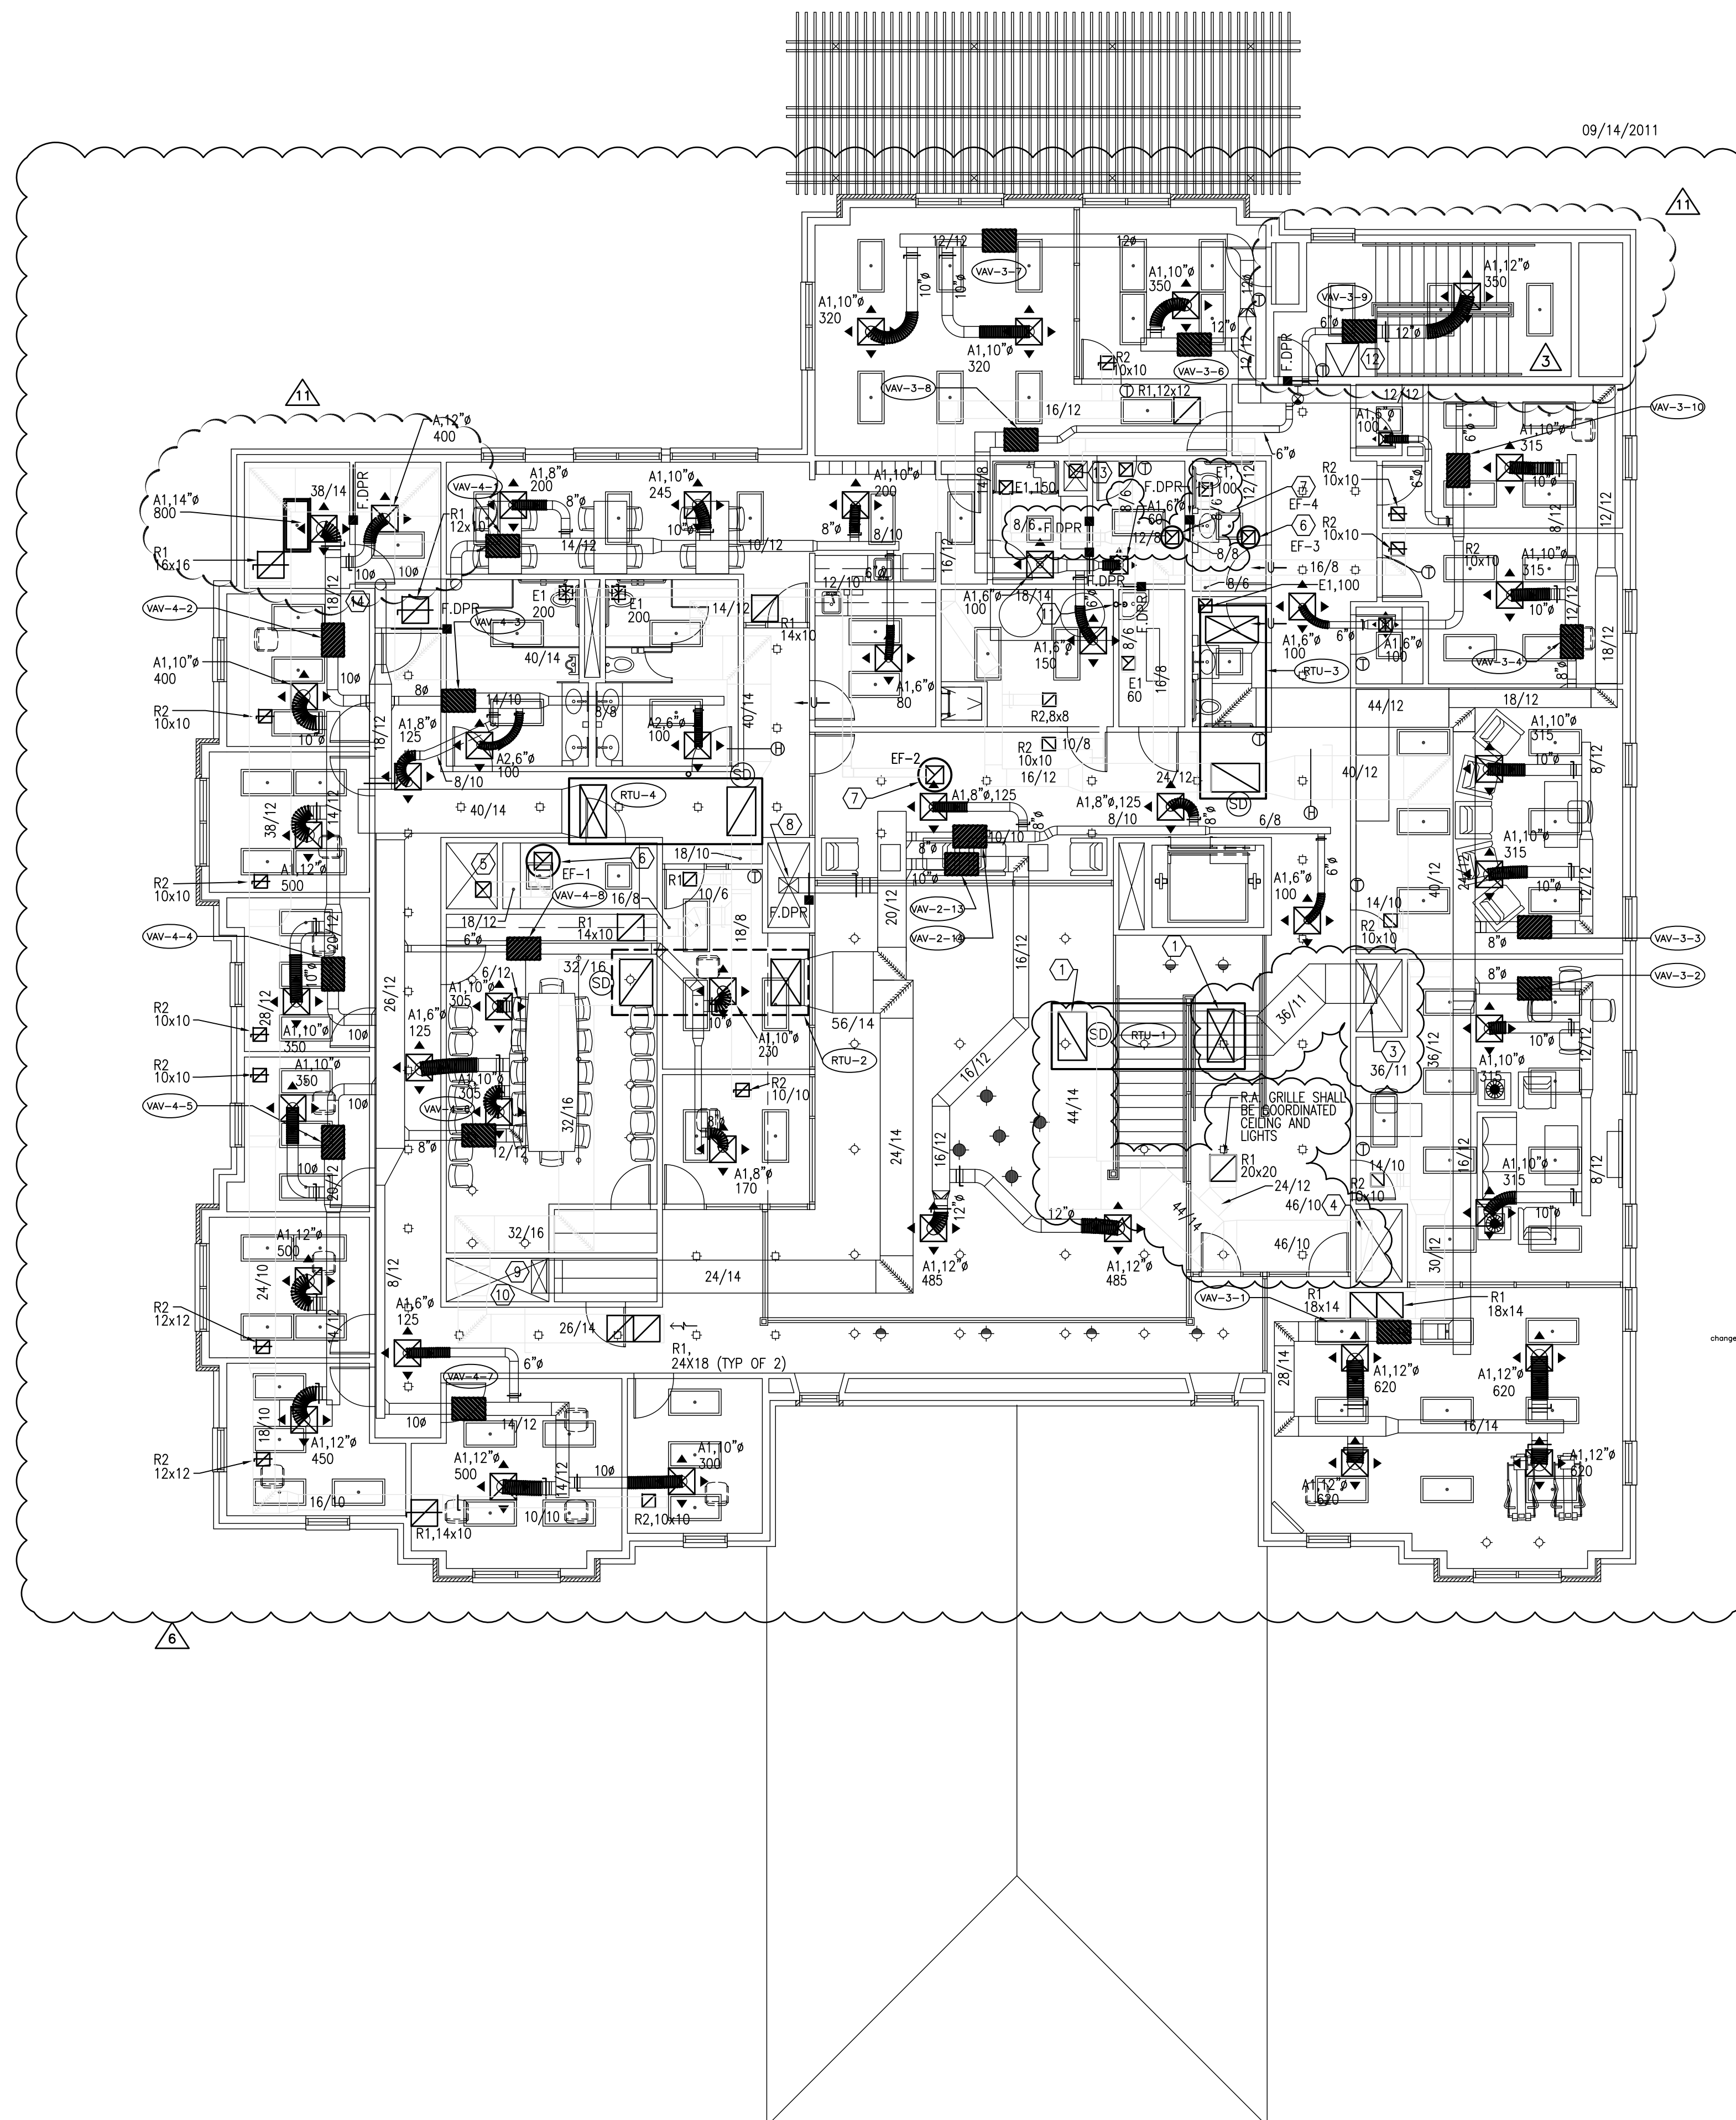

1

SECOND FLOOR MECHANICAL PLAN

SCALE: 1/8" = 1'-0"

ARCHITECT:

WESTEAST DESIGN GROUP



1617 E. COMMERCE ST., SUITE 7102, SAN ANTONIO, TEXAS 78205 USA
210.530.0755 FAX: 210.530.9427

These documents can not be copied or reproduced without written consent from WestEast Design Group

Drawing Title

SECOND FLOOR MECHANICAL PLAN

Approved: Project Director

Project Title

POLYTRAUMA
TRANSITIONAL
HOUSING

Location

Audie L. Murphy Memorial Veterans Hospital
San Antonio, Texas

Date

28 JULY 2010

Checked

Drawn

Project Number

671-237

Building Number

1

Drawing Number

MH1.2

Dwg. 3 of 10

Office of
Facilities
Management



AMENDMENT NO.	DATE
1	31/08/2010
2	04/04/11
3	04/04/11
CONSULTANTS:

TEXAS REGISTERED
ENGINEERING FIRM F-10487
700 N. ST. MARY'S
SUITE 1225
SAN ANTONIO, TX 78205
WWW.RDMENGINEERING.NET
PHONE: 210.299.4522
FAX: 210.299.4525

Revisions

RFI 137
RFI 088

Approved: Assistant Director

Approved: Service Chief

Approved: Chief, Bldg

Approved: Chief, IT

Approved: Chief, Safety

Approved: Chief of Staff

Approved: Service Chief

Approved: Chief, EMS

Approved: Chief, M & O

Approved: Chief

Approved: Chief, Engineering

Approved: Service Chief

Approved: Chief, Infection Control

Approved: Chief, Police

Approved: Chief