


- FIRE PROTECTION KEY
- UNRATED PARTITION
  - SMOKE PARTITION
  - 1 HOUR PARTITION
  - 2 HOUR PARTITION
  - 1 HOUR SMOKE PARTITION
  - 2 HOUR SMOKE PARTITION
  - SHIELDED PARTITION

Revisions		Date
RENOVATE METHADONE CLINIC		9/10/06
RENOVATE MENTAL HEALTH		11/20/01
RECORD DRAWING		3/25/94

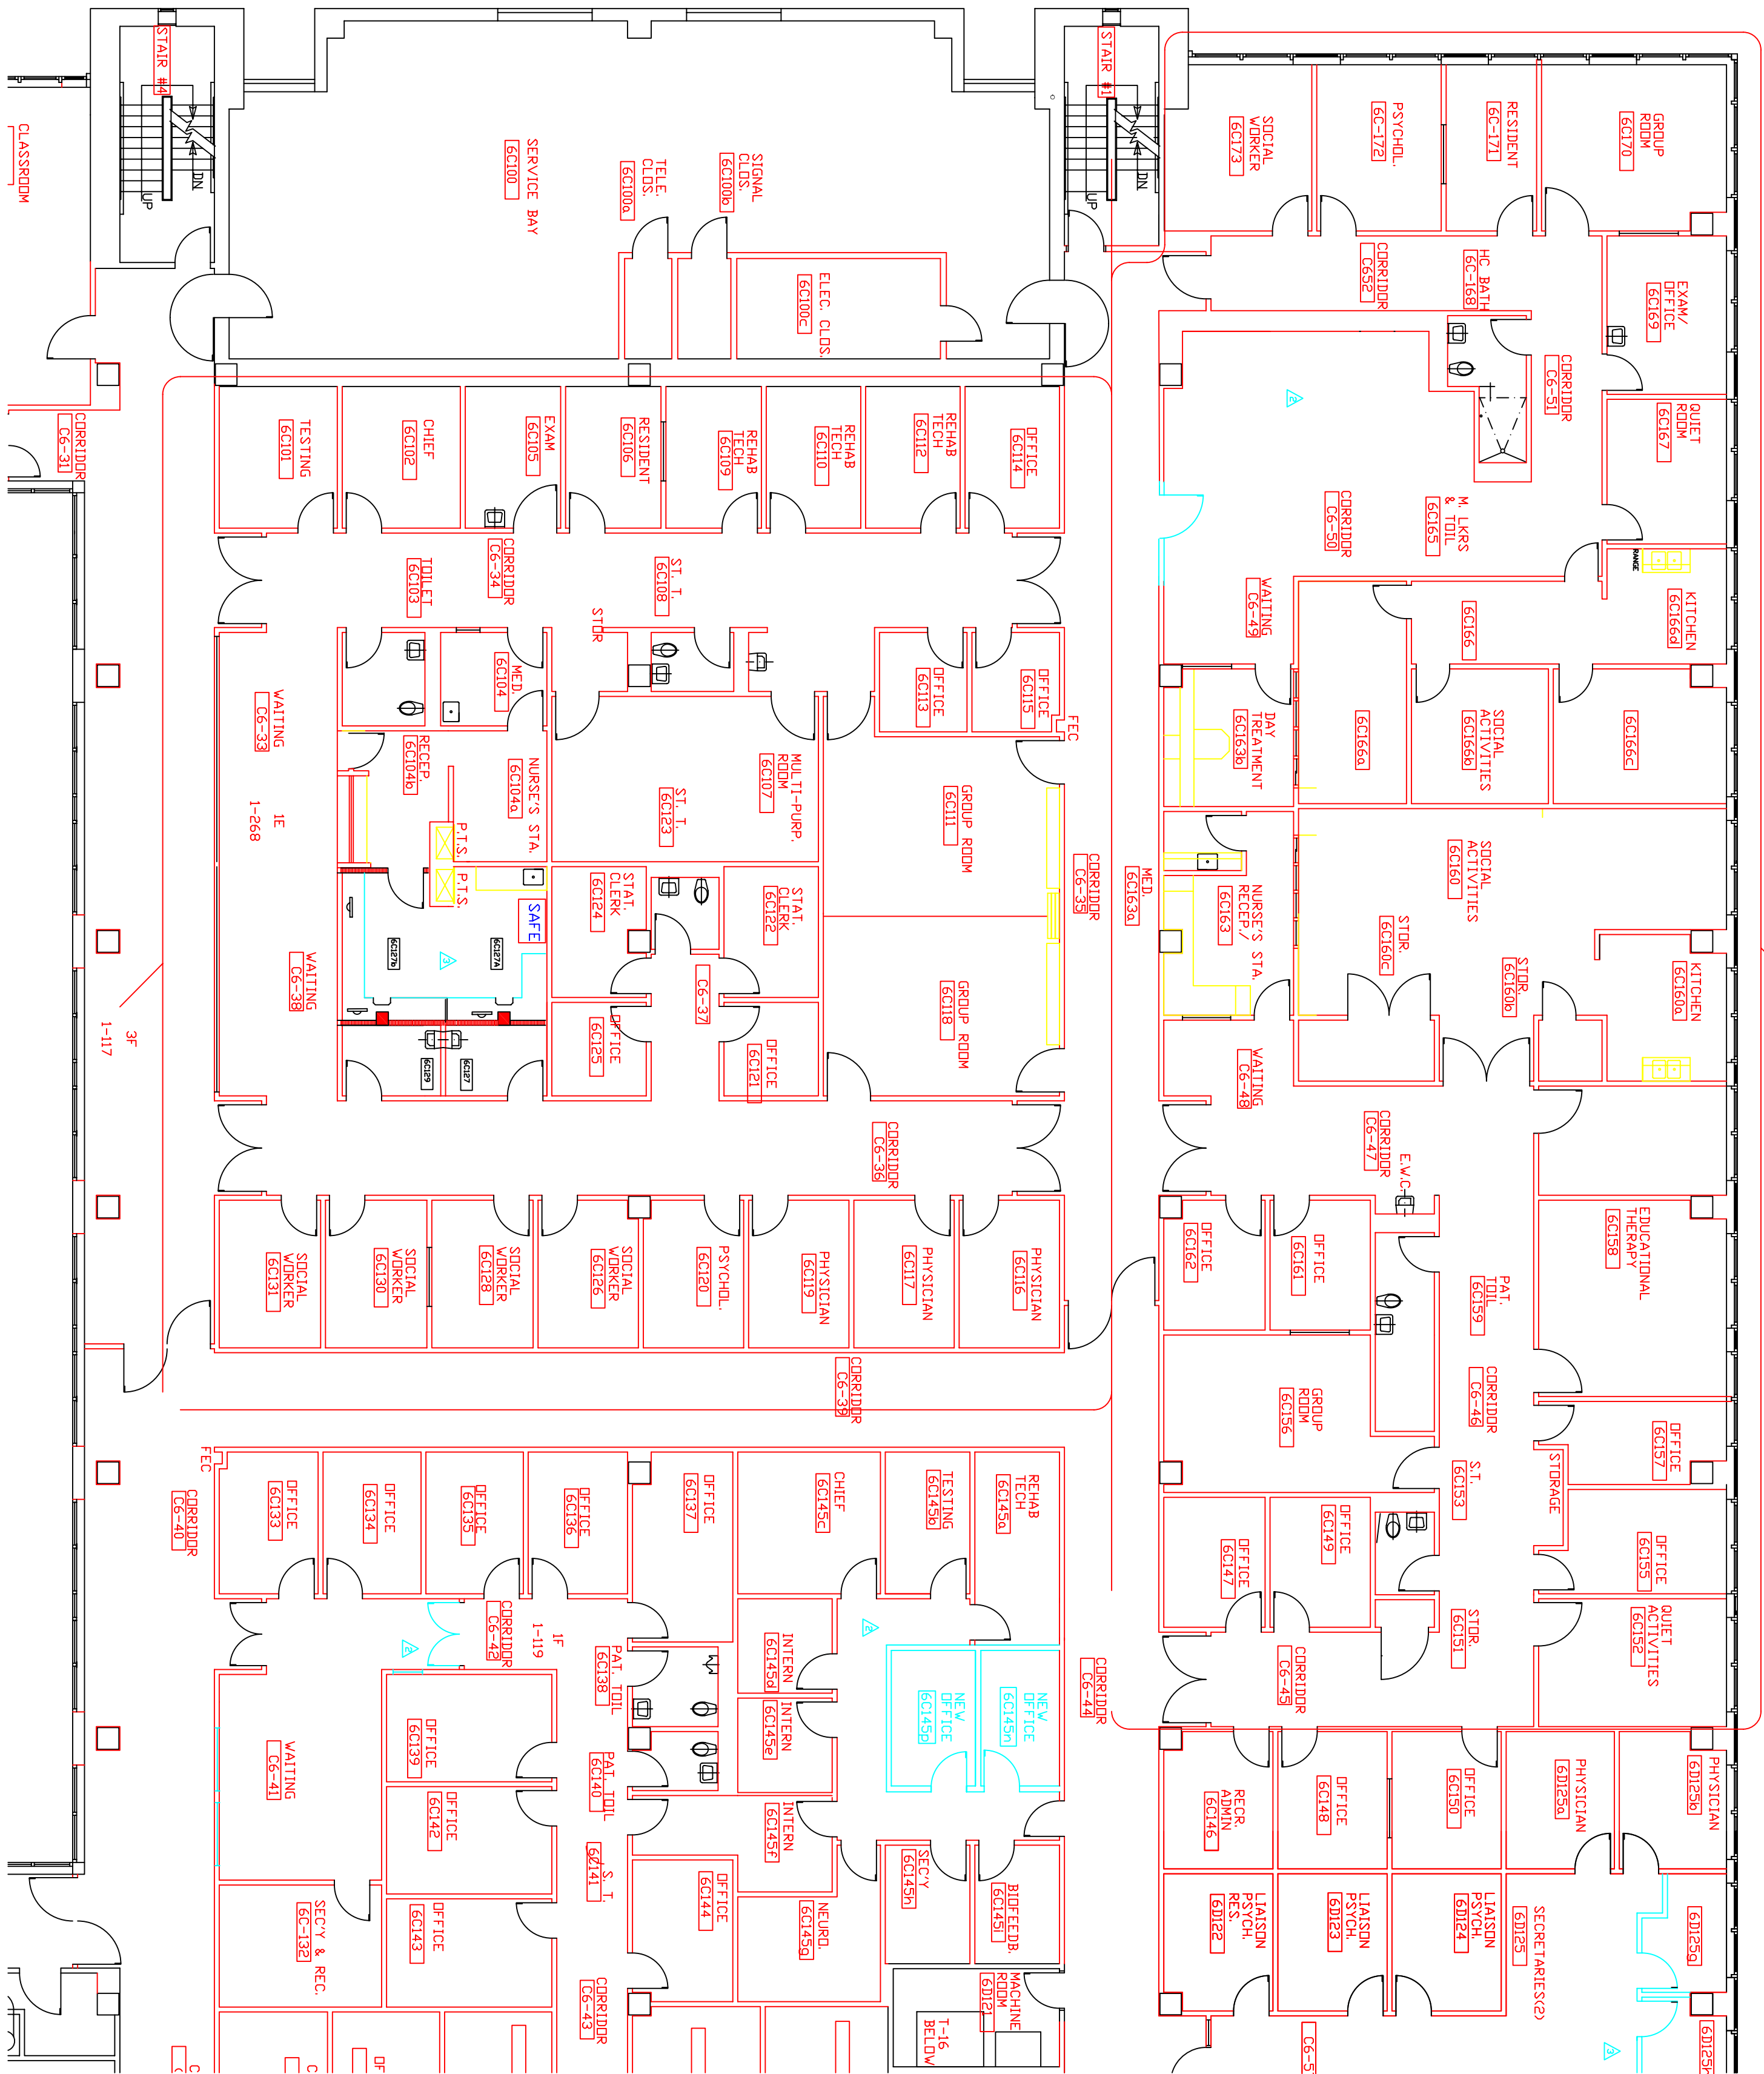

## SIXTH FLOOR QUAD C

FULLY SPRINKLERED

RTKL/CSO/HENRY ADAMSKY ARCHITECTS AND ENGINEERS 400 E. PRATT STREET BALTIMORE, MD 21202	Drawing Title SIXTH FLOOR AREA C	Project Title 324 - BED REPLACEMENT HOSPITAL-PHASE II	Date 9/1/88
Approved Project Director	Scale 1/8" = 1'-0"	Building Number VAMC-BALTIMORE, MD.	Project No. SII-001D
Drawn I-63	Checked	Location	Drawn I-63
Veterans Administration			