

A

B

C

D

E

F

A


B


C

D

E

F

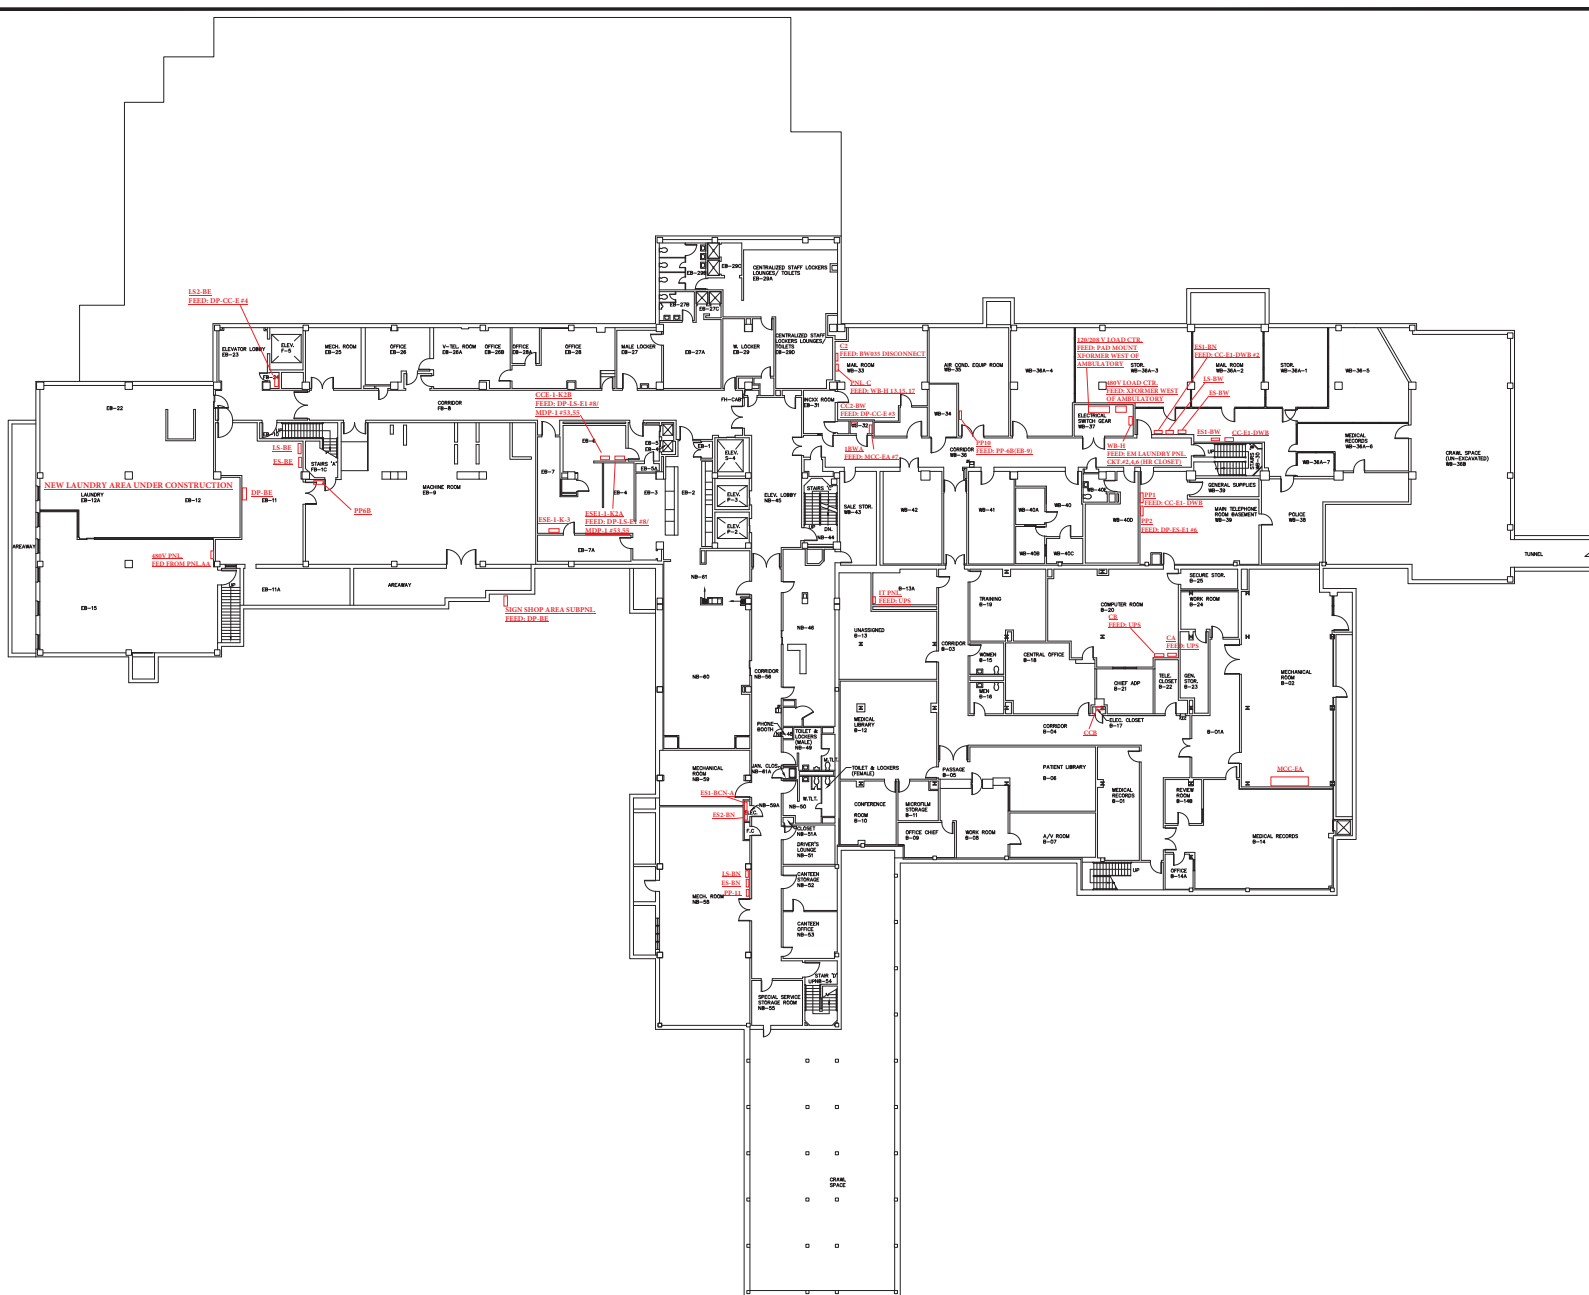

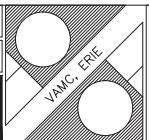Revisions		Date		Professional Seal		Drawing Title BASEMENT FLOOR PLAN ARCHITECTURAL		Project Title AS-BUILT DRAWINGS		Date 07-26-2005					
						Approved:		Building Number 01		Checked Drawn				Project No.	
						Approved:		Location VAMC, ERIE PENNSYLVANIA		Drawing No.					