


ROOM SCHEDULE

BA-100	ELECTRICAL	CB-2A	SERV ELEV LOBBY
BA-101	TELEPHONE	CB-3	CORRIDOR
CB-1	PASS. ELEV LOBBY	B-802	EXIST. WOMEN
CB-2	CORRIDOR	B-803	EXIST. DARKRM.

PLAN NOTES

- 20" SUPPLY UP AND 28" SUPPLY DOWN (1-AC34) SEE ELEVATOR PENHOUSE HVAC PLAN AREA-A SHEET 1-H38 AND SEVENTH FLOOR HVAC PLAN AREA-A SHEET 1-H37 FOR CONTINUATION.
- 26"X26" RETURN UP AND 26"X36" RETURN DOWN (1-RE39) SEE ELEVATOR PENHOUSE HVAC PLAN AREA-A SHEET 1-H38 AND SEVENTH FLOOR HVAC PLAN AREA-A SHEET 1-H37 FOR CONTINUATION.
- EXTEND 8"X4" RETURN THROUGH WALL AS SHOWN. PROVIDE BUG OVER OPENING. BALANCE TO 50 CFM. TYPICAL OF TWO.
- 6"X 7'-9" LINEAR BAR DIFFUSER. CENTER DIFFUSER IN BALK-HEAD AND STOP 3" SHORT ON BOTH ENDS. FIELD VERIFY EXACT LENGTH. PROVIDE BLANK-OFFS ON UNUSED PORTIONS.
- ROUTE 8"X AS SHOWN TO 12"X 12"X 12" BOOT. SPACE SPACE BOOTS EQUALLY ON DIFFUSER. EXTERNALLY INSULATE BOOT AND PAINT INTERIOR OF BOOTS FLAT BLACK. BALANCE TO 175 CFM. TYPICAL OF TWO.
- 10"X10" EXHAUST UP AND DOWN. SEE SHEETS 1-H37 AND 1-H32 FOR CONTINUATION.
- 10"X10" HOOD EXHAUST UP AND DOWN. SEE SHEETS 1-H37 AND 1-H32 FOR CONTINUATION.
- EXISTING POWER ROOF VENTILATOR TO REMAIN.

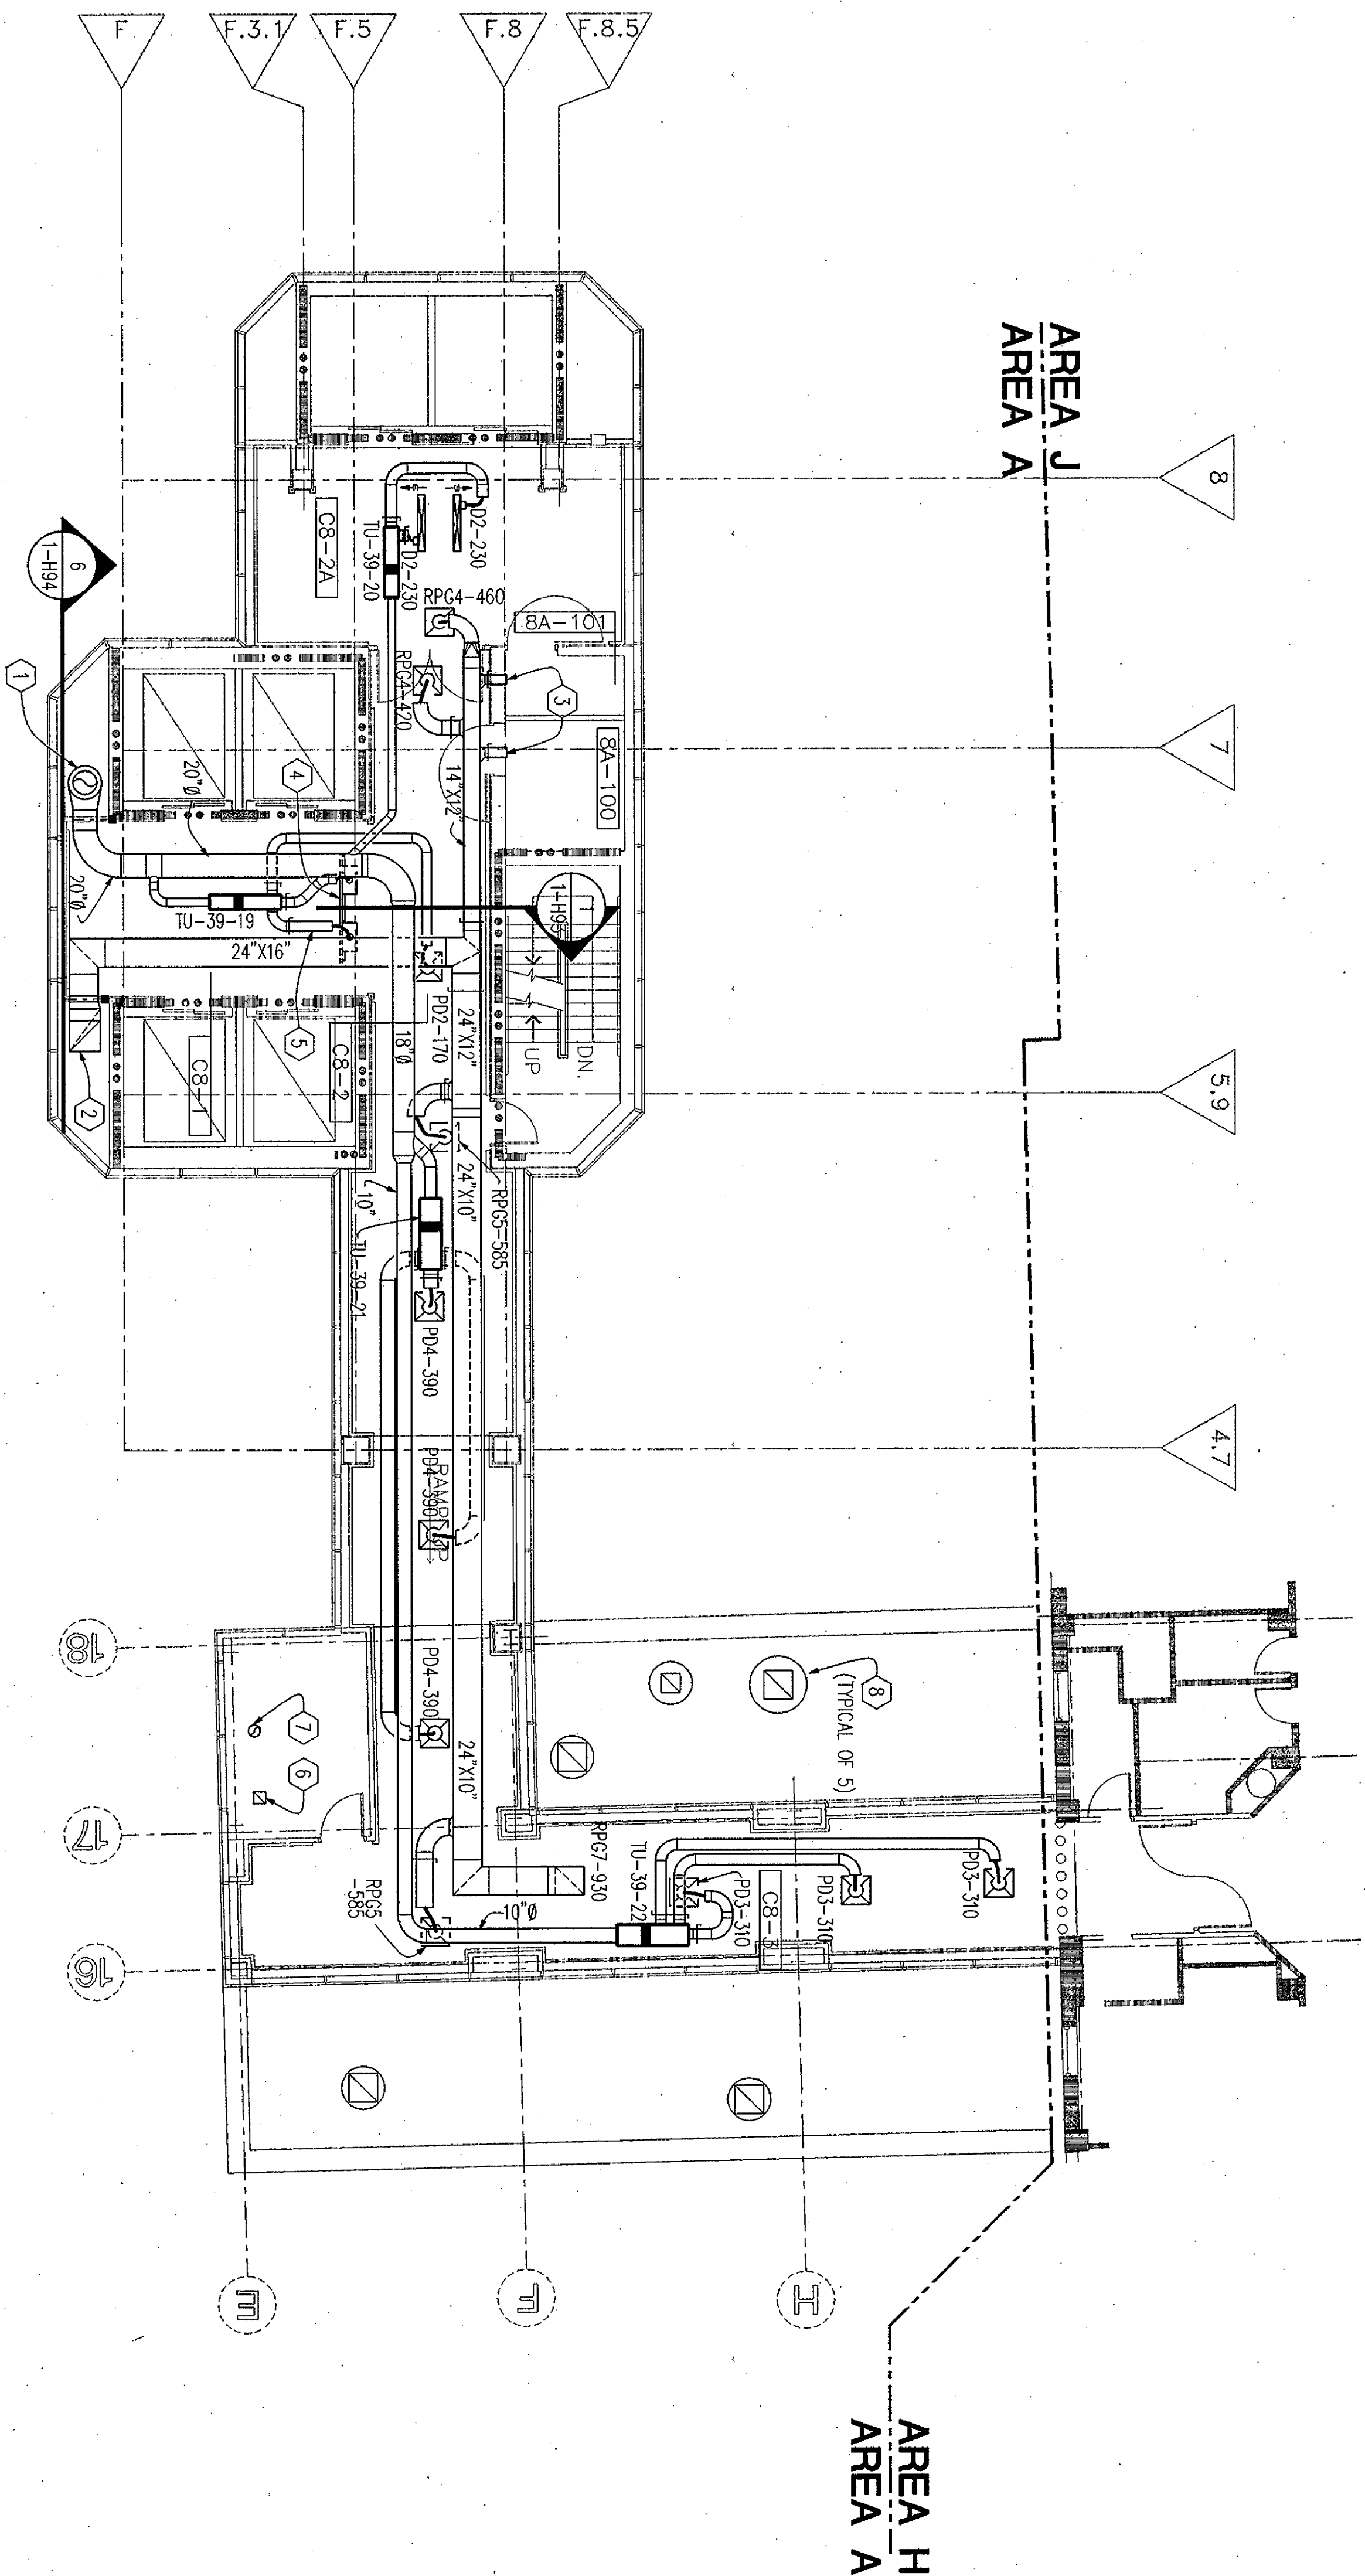

ORIGINAL  
**ASBUILT**

REFERENCE DRAWINGS ONLY  
NOT FOR CONSTRUCTION

DISCLAIMER

THIS DOCUMENT IS AN ORIGINAL ASBUILT DRAWING FROM WHICH THE MECHANICAL SYSTEM SHOWN WAS CONSTRUCTED. THIS DRAWING SHALL BE USED AS A REFERENCE DOCUMENT ONLY. SINCE THE TIME OF CONSTRUCTION SOME AREAS MAY HAVE BEEN RENOVATED, THEREFORE IT IS YOUR RESPONSIBILITY TO FIELD VERIFY ALL AREAS OF CONCERN TO VALIDATE THE MOST CURRENT ACCURACY PRIOR TO MODIFYING OR MAKING ANY CHANGES TO THE SYSTEM.

KEY PLAN

8-1-2-1564

FULLY PROTECTED BY AUTOMATIC SPRINKLER SYSTEM

RECORD DRAWING

1/5/95

Revisions

Notes

042-PHASE4\_1-H38

Location  
WEST TENTH STREET

Building Number  
#1

PROJECT NUMBER  
583-12-159

Drawing Number  
H-9.0

XEV012

Dwg. 82 of 185

Engineering  
and Facilities  
Management  
Services