
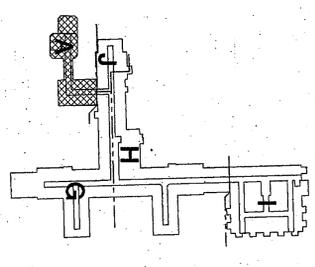


ROOM SCHEDULE	
7A-100	ELECTRICAL
7A-101	TELEPHONE
C7-1	PASS ELEV LOBBY
C7-2	CORRIDOR
C7-2A	SERV ELEV LOBBY

**PLAN NOTES**

- ① 1-1/2" RHW, AND RHWER DOWN AND 1-1/4" RHW, RHWER UP. SEE SHEETS 1-H72 AND 1-H70 FOR CONTINUATION.

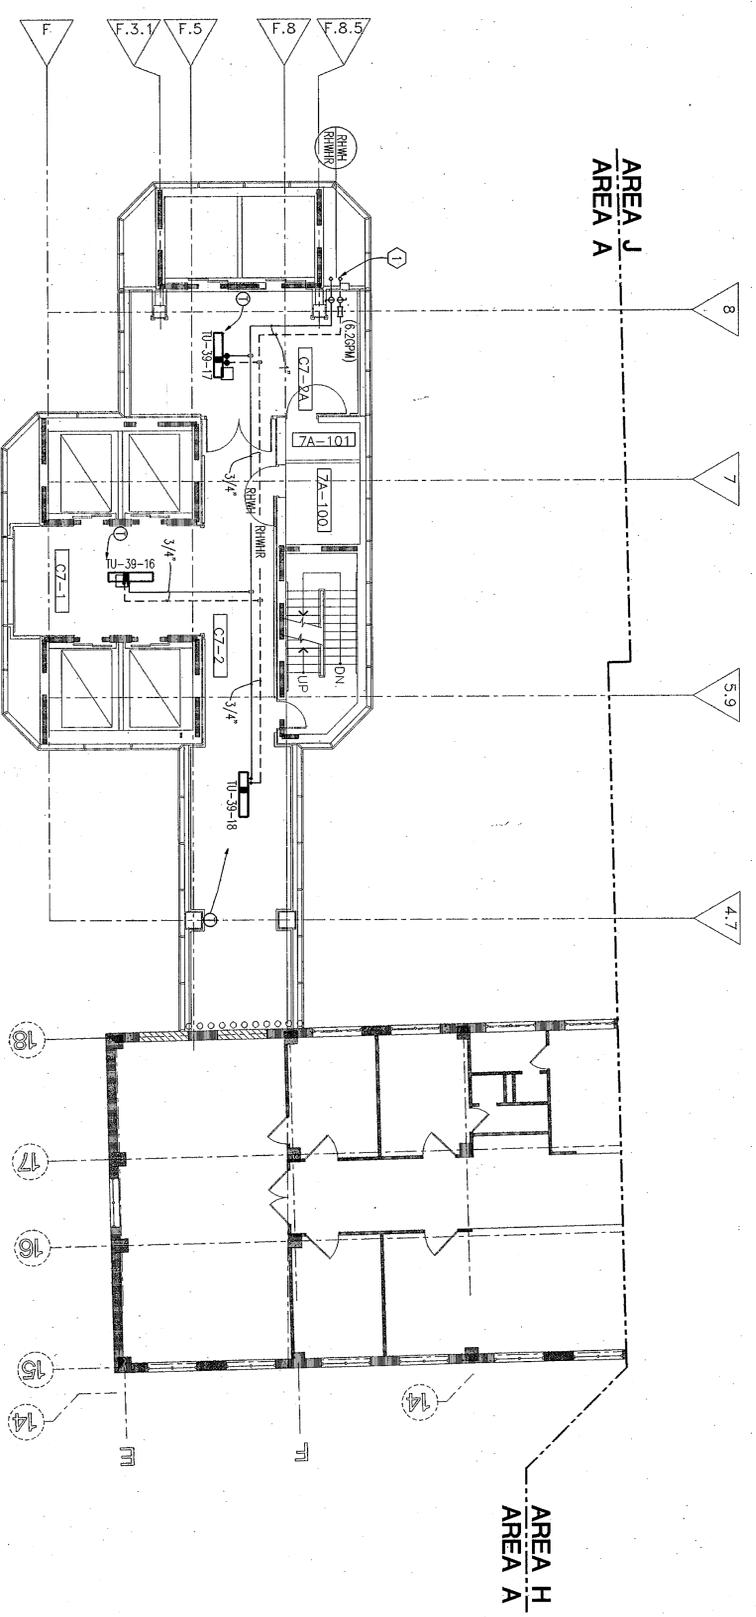

**KEY PLAN**

8-1-2-1600

FULLY PROTECTED BY AUTOMATIC SPRINKLER SYSTEM

**DISCLAIMER**  
 THIS DOCUMENT IS AN ORIGINAL ASBUILT DRAWING FROM WHICH THE MECHANICAL SYSTEM SHOWN WAS CONSTRUCTED. THIS DRAWING SHALL BE USED AS A REFERENCE DOCUMENT ONLY, SINCE THE TIME OF CONSTRUCTION SOME AREAS MAY HAVE BEEN REVISED. THERE FOR IT IS YOUR RESPONSIBILITY TO FIELD VERIFY ALL AREAS OF CONCERN TO VALIDATE THE MOST CURRENT ACCURACY PRIOR TO MODIFYING OR MAKING ANY CHANGES TO THE SYSTEM.

**ORIGINAL ASBUILT**  
 REFERENCE DRAWINGS ONLY  
 NOT FOR CONSTRUCTION

RECORD DRAWING	1/3/95
Revisions	Date

042-PHASE4\_1-H71

Drawing Title  
**SEVENTH FLOOR  
 HVAC PIPING PLAN  
 AREA A**

Location	WEST TENTH STREET	Engineering and Facilities Management Services
Building Number	#1	
PROJECT NUMBER	583-12-159	
Drawing Number	H-82	
	XEV012	
Drawn by	RS	