


PLAN NOTES

- 1 EXISTING TERMINAL UNIT AND ASSOCIATED DUCTWORK TO REMAIN.
- 2 EXISTING EXHAUST DUCTWORK TO REMAIN.
- 3 EXISTING LOW EXHAUST GRILLE TO REMAIN.
- 4 VERIFY SIZE AND EXTEND SAME SIZE DUCT TO RELOCATED DIFFUSER.
- 5 RELOCATE EXISTING SUPPLY DUCT TO WHERE SHOWN. EXISTING DIFFUSER TO BE RELOCATED. SEE NEW PLAN ON THIS SHEET. VERIFY CFM PRIOR TO DEMOLITION.
- 6 CONNECT NEW 16"X8" EXHAUST TO EXISTING 10"8 WHERE SHOWN. PROVIDE SQUARE TO ROUND FITTING AND VOLUME DAMPER.
- 7 BALANCE NEW EXHAUST GRILLE (EG4) TO CFM RECORDED PRIOR TO DEMOLITION.

ORIGINAL
ASBUILT

REFERENCE DRAWINGS ONLY
NOT FOR CONSTRUCTION


DISCLAIMER
THIS DOCUMENT IS AN ORIGINAL ASBUILT DRAWING FROM WHICH THE MECHANICAL SYSTEM SHOWN WAS CONSTRUCTED. THIS DRAWING SHALL BE USED AS A REFERENCE DOCUMENT ONLY. SINCE THE TIME OF CONSTRUCTION SOME AREAS MAY HAVE BEEN REVISED. THEREFORE IT IS YOUR RESPONSIBILITY TO FIELD VERIFY ALL AREAS OF CONCERN TO VALIDATE THE MOST CURRENT ACCURACY PRIOR TO MODIFYING OR MAKING ANY CHANGES TO THE SYSTEM.

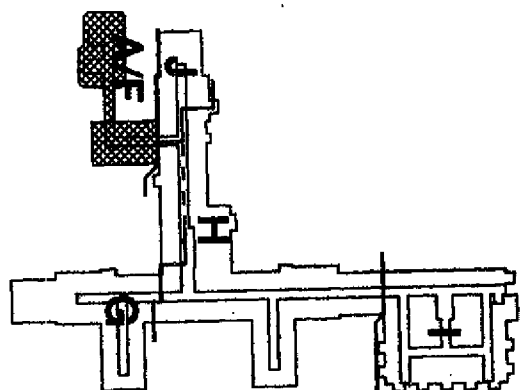

KEY PLAN NORTH

PLAN NOTES

- 1 EXISTING TERMINAL UNIT AND ASSOCIATED DUCTWORK TO REMAIN.
- 2 EXISTING EXHAUST DUCTWORK TO REMAIN.
- 3 EXISTING LOW EXHAUST GRILLE TO REMAIN.
- 4 REMOVE EXISTING SUPPLY DUCT TO WHERE SHOWN. EXISTING DIFFUSER TO BE RELOCATED. SEE NEW PLAN ON THIS SHEET. VERIFY CFM PRIOR TO DEMOLITION.
- 5 REMOVE COMPLETE EXISTING LOW EXHAUST GRILLE. VERIFY EXISTING CFM PRIOR TO DEMOLITION.
- 6 REMOVE EXISTING EXHAUST DUCT TO WHERE SHOWN. SEE NEW PLAN ON THIS SHEET FOR RECONNECTION AND NEW ROUTING.
- 7 EXISTING THERMOSTATS TO BE RELOCATED. SEE PLAN ON SHEET 1-H77 FOR NEW LOCATION.

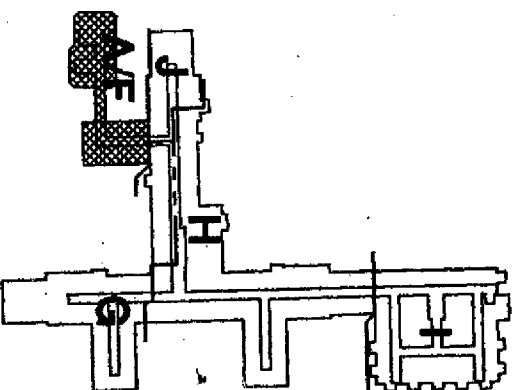

KEY PLAN NORTH

FULLY PROTECTED BY AUTOMATIC SPRINKLER SYSTEM

AS-BUILT REVISIONS	10/26/98
RECORD DRAWINGS	05/19/99
DATE	

Drawing Title
SEVENTH FLOOR HVAC
DEMOLITION AND NEW PLANS
AREA F

042-PHASE5_1-H53

Location	WEST TENTH STREET	Engineering and Facilities Management Services
Building Number	#1	
PROJECT NUMBER	588-12-159	
Drawing Number	H-83	
Dwg	XEV012	
Shd. of	85	