


ORIGINAL
ASBUILT
REFERENCE DRAWINGS ONLY
NOT FOR CONSTRUCTION

DISCLAIMER
THIS DOCUMENT IS AN ORIGINAL ASBUILT DRAWING FROM WHICH THE MECHANICAL SYSTEM SHALL BE USED AS A REFERENCE DOCUMENT ONLY. SINCE THE TIME OF CONSTRUCTION SOME AREAS MAY HAVE BEEN REVISED. THEREFORE IT IS YOUR RESPONSIBILITY TO FIELD VERIFY ALL AREAS OF CONCERN TO VALIDATE THE MOST CURRENT ACCURACY. PRIOR TO MODIFYING OR MAKING ANY CHANGES TO THE SYSTEM.

RECORD DRAWING 1/5/95
Date

042-PHASE4_1-H73

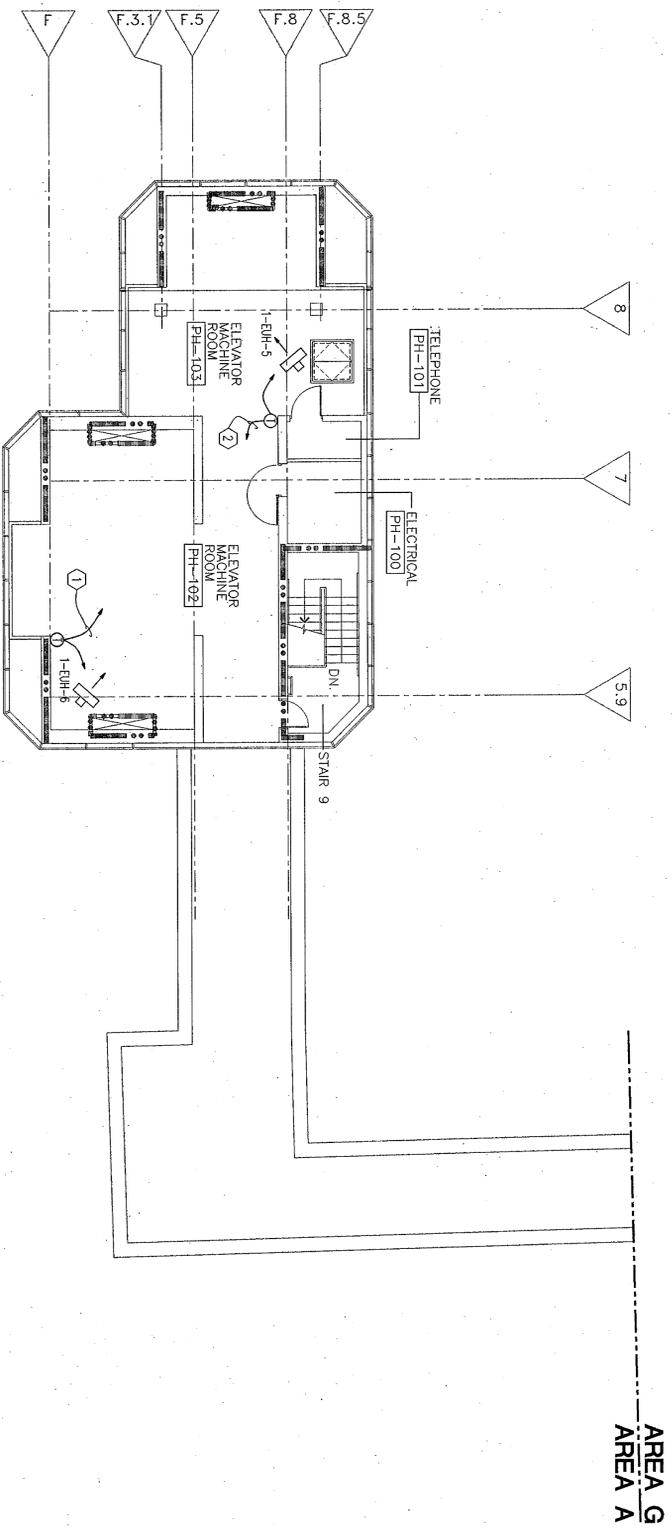


AREA G
AREA A

Drawing Title
**NINTH FLOOR
HVAC PIPING PLAN
AREA A**

FULLY PROTECTED BY AUTOMATIC SPRINKLER SYSTEM

8-1-2-1602

KEY PLAN

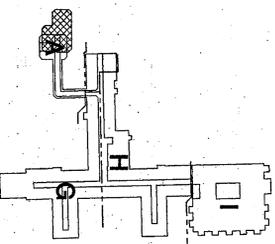

PLAN NOTES
① FOR 10-34-23, SEE SHEET 1-439 FOR LOCATION.
② FOR 10-34-24, SEE SHEET 1-439 FOR LOCATION.

Location
WEST TENTH STREET
Building Number #1
PROJECT NUMBER 583-12-159
Drawing Number 100
XFTY012
Dwg. 95 of 165

Engineering and Facilities Management Services
Department of Transportation