


ROOM SCHEDULE		
7A-100	ELECTRICAL	C7-2
7A-101	TELEPHONE	C7-2A
C7-1	PASS ELEV LOBBY	SENV. ELEV LOBBY

PLAN NOTES

- ① 26" x 8" SUPPLY UP AND DOWN (1-AC39). SEE EIGHTH FLOOR HVAC PLAN AREA A SHEET 1-H38 AND SIXTH FLOOR HVAC PLAN AREA A SHEET 1-H36 FOR CONTINUATION.
- ② 26" x 36" RETURN UP AND 26" x 42" RETURN DOWN (1-R39). SEE EIGHTH FLOOR HVAC PLAN AREA A SHEET 1-H38 AND SIXTH FLOOR HVAC PLAN AREA A SHEET 1-H36 FOR CONTINUATION.
- ③ EXTEND 8"x4" RETURN THROUGH WALL AS SHOWN. PROVIDE ENG OVER OPENING. BALANCE TO 50 CFM. TYPICAL OF TWO.
- ④ 6"x7"-91" LINEAR BAR DEFROSTER. CENTER ON BURHEAD AND STOP SHORT 3" ON BOTH ENDS. FIELD VENT EXACT LENGTH. PROVIDE BLANK-CRYS ON UNUSED PORTIONS.
- ⑤ ROUTE # 8 AS SHOWN TO 12"x11"x21"x24" BOOT. SPACE BOOTS EQUALLY ON DEFROSTER. EXTERNALLY INSULATE BOOT AND PAINT INTERIOR OF BOOTS FLAT BLACK. BALANCE TO 175 CFM. TYPICAL OF TWO.
- ⑥ EXTEND 10" Ø HOOD EXHAUST FROM WHERE SHOWN AND UP SEE SHEET 1-H39 FOR CONTINUATION, FIELD VENT EXACT SIZE AND LOCATION.
- ⑦ EXTEND 10"x10" EXHAUST UP. SEE SHEET 1-H38 FOR CONTINUATION. FIELD VENT EXACT SIZE AND LOCATION.

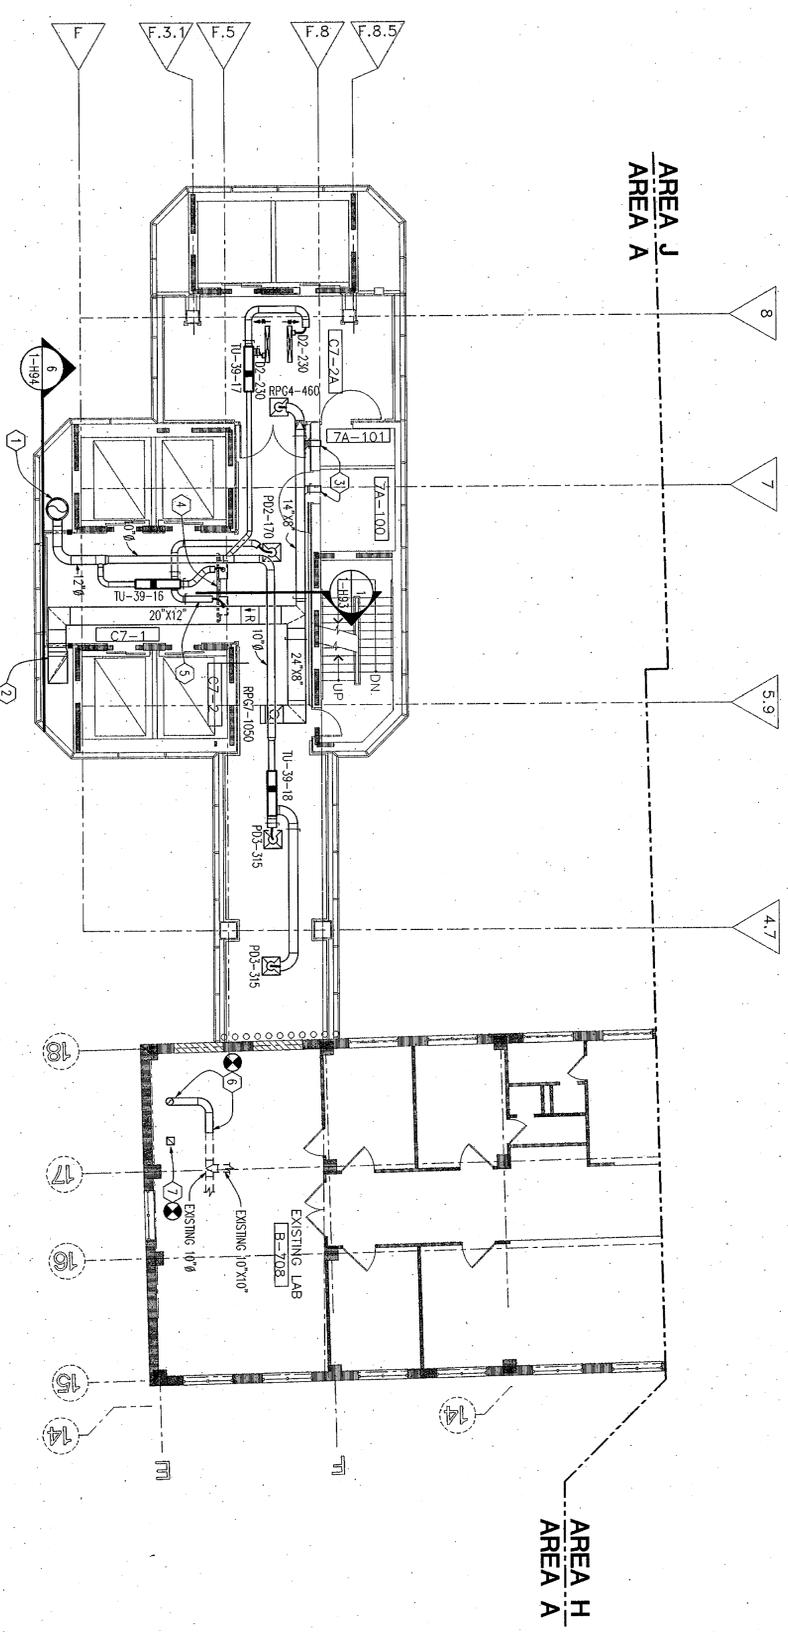

ORIGINAL
ASBUILT

REFERENCE DRAWINGS ONLY
NOT FOR CONSTRUCTION

DISCLAIMER

THIS DOCUMENT IS AN ORIGINAL ASBUILT DRAWING FROM WHICH THE MECHANICAL SYSTEM SHOWN WAS CONSTRUCTED. THIS DRAWING SHALL BE USED AS A REFERENCE DOCUMENT ONLY SINCE THE TIME OF CONSTRUCTION SOME AREAS MAY HAVE BEEN REISED. THEREFORE IT IS YOUR RESPONSIBILITY TO FIELD VERIFY ALL AREAS OF CONCERN TO VALIDATE THE MOST CURRENT ACCURACY. PRIOR TO MODIFYING OR MAKING ANY CHANGES TO THE SYSTEM.

RECORD DRAWING
1/5/95
Date

042-PHASE4_1-H37

Drawing Title
**SEVENTH FLOOR
HVAC PLAN
AREA A**

FULLY PROTECTED BY AUTOMATIC SPRINKLER SYSTEM

Location
WEST TENTH STREET

Building Number #1
PROJECT NUMBER 583-12-159
Drawing Number H-81
XFY012
Dwg. 80 of 165

Engineering and Facilities Management Services
Department of Water Affairs

